


ALPENGLOW AT BIG SKY

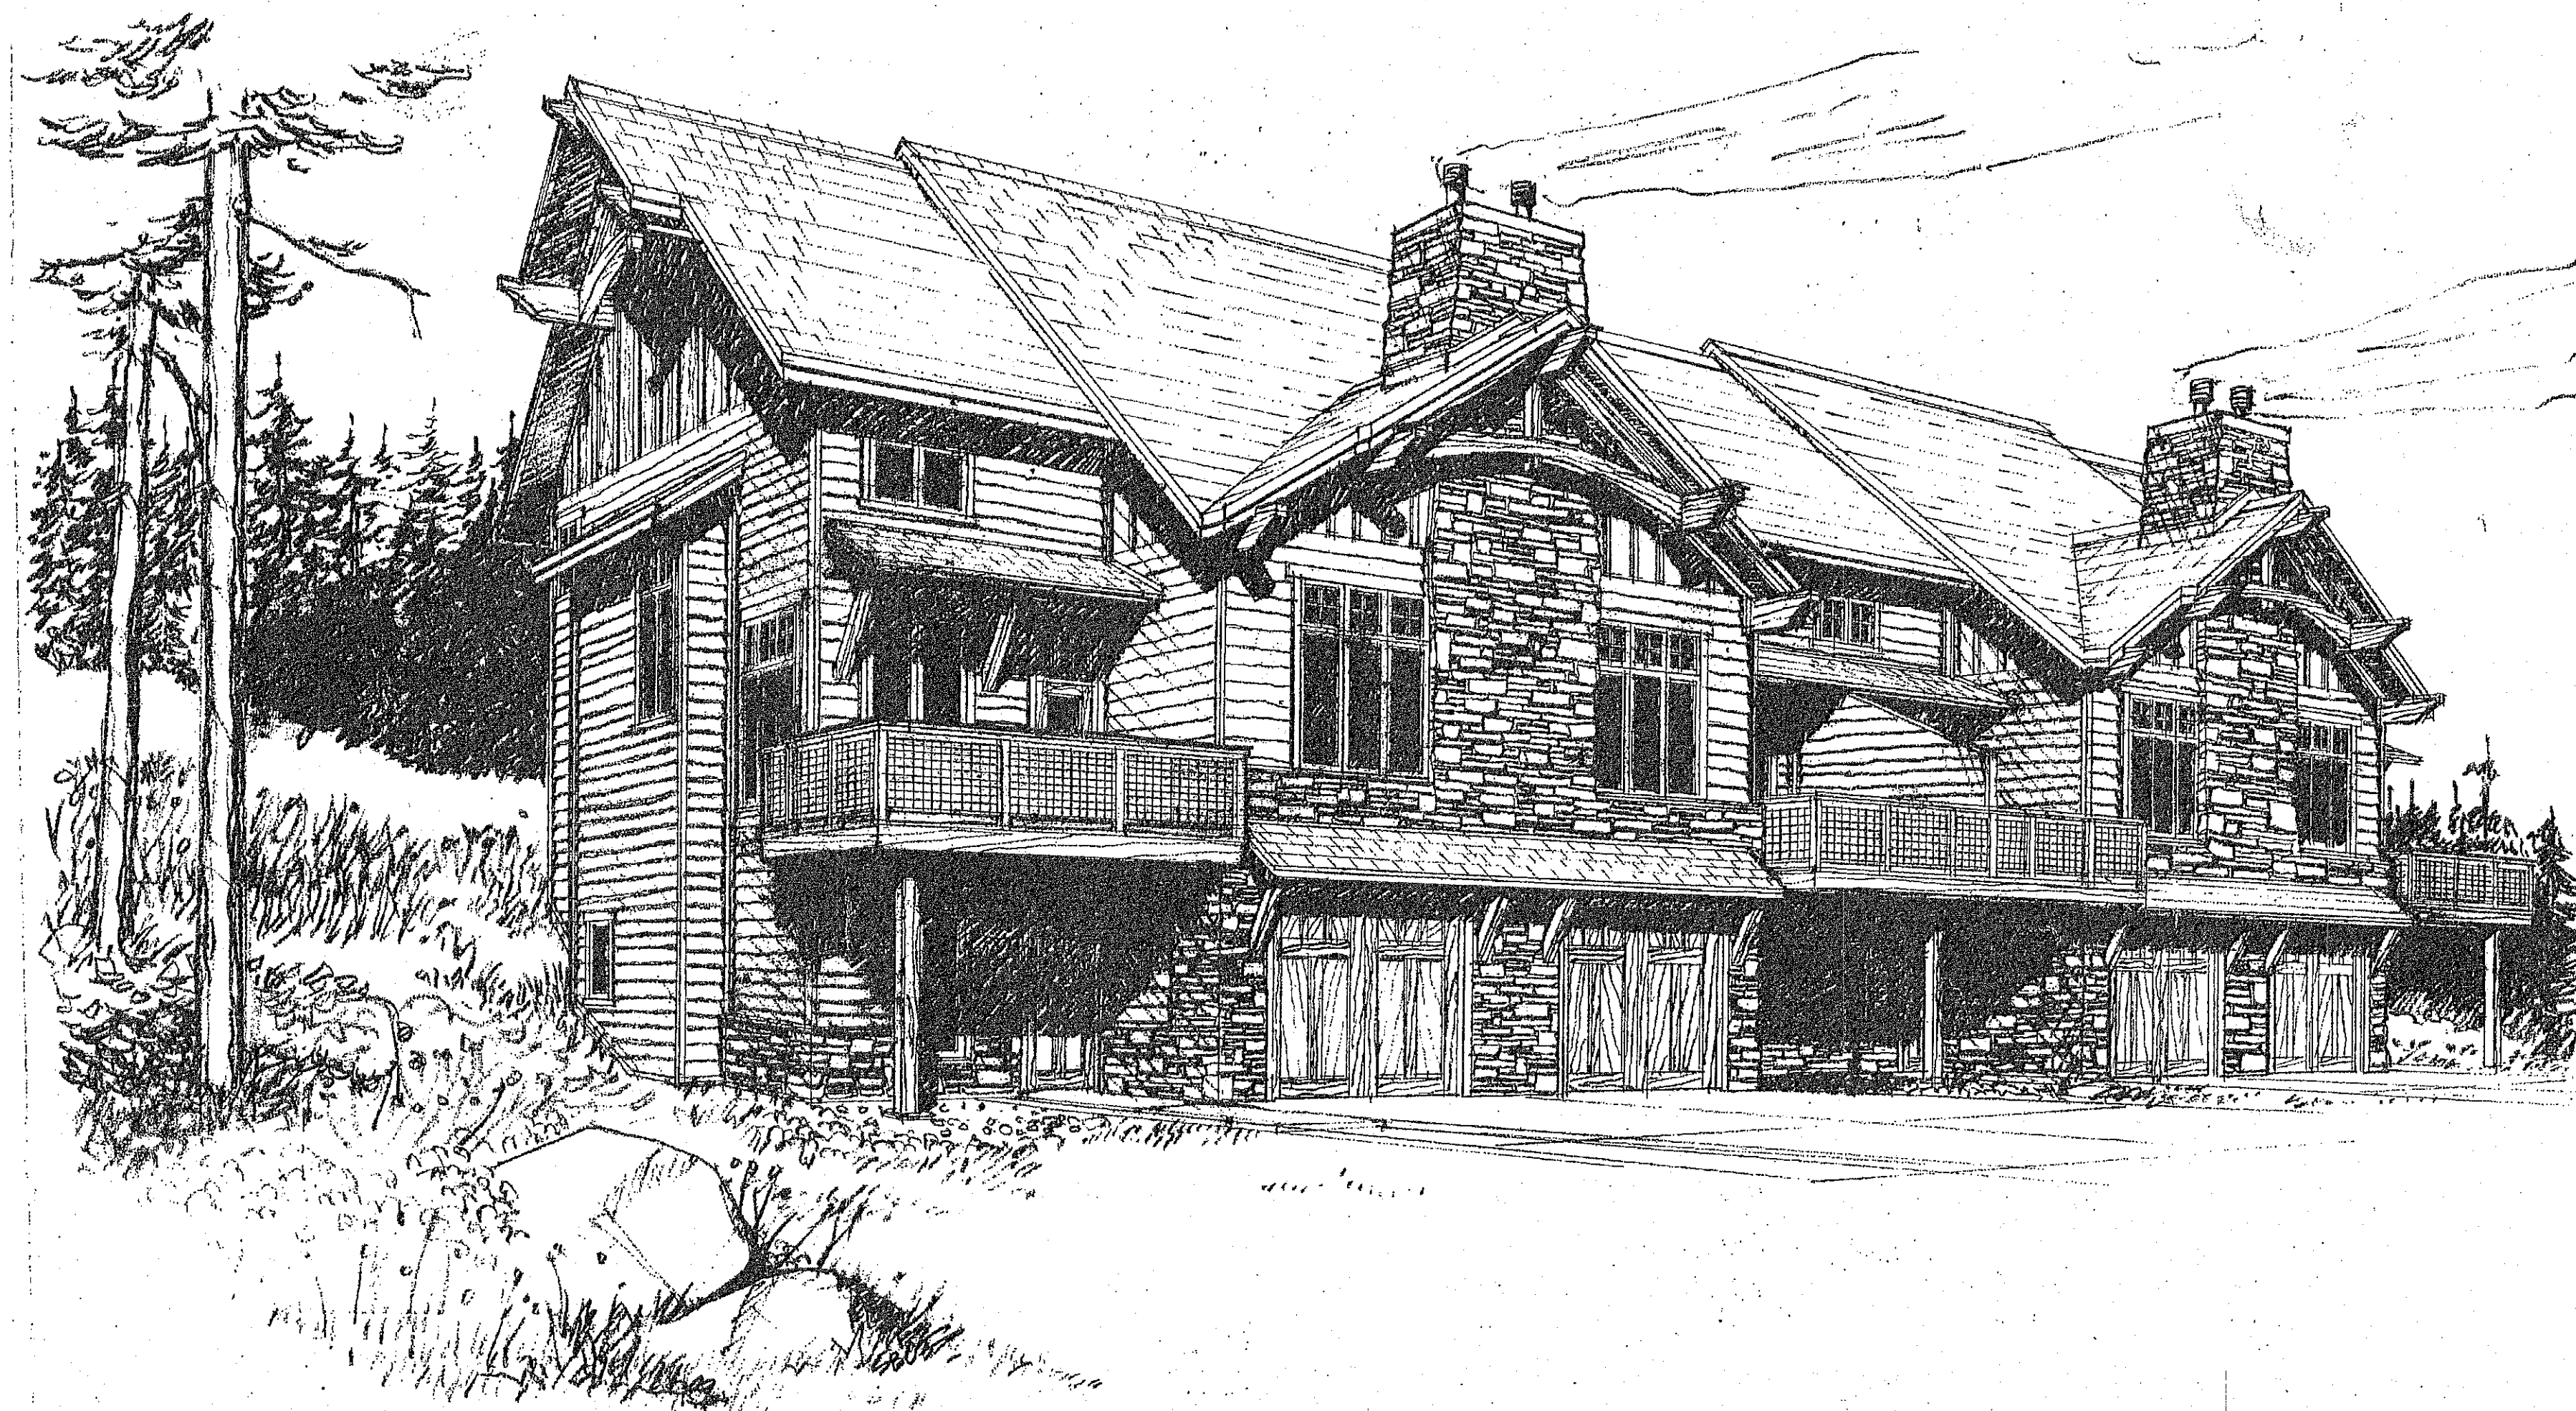

SHEET INDEX

A101	1ST FLOOR PLAN
A102	2ND FLOOR PLAN
A103	3RD FLOOR PLAN
A104	ROOF PLAN
A201	EXTERIOR ELEVATIONS
A301	BUILDING & WALL SECTIONS
A302	BUILDING SECTION
A501	1ST FLOOR FINISH PLAN
A502	2ND FLOOR FINISH PLAN
A503	3RD FLOOR FINISH PLAN
A601	DOOR & WINDOW SCHEDULES
A801	INTERIOR ELEVATIONS
S001	STRUCTURAL GENERAL NOTES
S002	SCHEDULES
S101	FOUNDATION PLAN
S102	2ND FLOOR FRAMING PLAN
S103	3RD FLOOR/LOWER ROOF FRAMING PLAN
S104	UPPER ROOF FRAMING PLAN
S201	FOUNDATION DETAILS
S202	FOUNDATION & FRAMING DETAILS
S203	FRAMING DETAILS
S204	FRAMING DETAILS
S301	STRUCTURAL ELEVATIONS

CODE INFORMATION

GENERAL

IBC 2000
TYPE 5B CONSTRUCTION
R-2 OCCUPANCY
FULLY SPRINKLED
ALLOWABLE FLOORS (2+1 SPRINKLERS)=3
• ONE-HOUR OCCUPANCY SEPARATION BETWEEN UNITS IS REQUIRED.
• ONE-HOUR SEPARATION IS REQUIRED BETWEEN THE GARAGE AND THE LIVING UNIT AT THE WALL AND IF LIVING SPACE IS ABOVE AT THE CEILING.
• EGRESS WINDOWS ARE REQUIRED FOR SLEEPING ROOMS.

UPHILL UNIT

ALLOWABLE AREA CALCULATION:
BASE ALLOWABLE AREA- 7000 SF
SPRINKLER INCREASE- +14,000 SF = 21,000 SF
MULTIPLE FLOORS (3)- 21,000 SF X 3 = 62,000 SF
TOTAL ALLOWABLE AREA- 62,000 SF

UPHILL UNIT AREA CALCULATION
MAIN 4572
SECOND 4572
THIRD 2428
TOTAL 11572 OK


25 ABCD



UPHILL UNIT

CTA
ARCHITECTS
ENGINEERS

BILLINGS • MISSOULA
BOISE • GREAT FALLS
HELENA • KALISPELL
SPOKANE • JACKSON
BOZEMAN

10180 COTTONWOOD RD
BOZEMAN, MONTANA 59718
PHONE (406) 556-7100
FAX (406) 556-3031
PROJECT NO. MAUS
APRIL 7, 2003

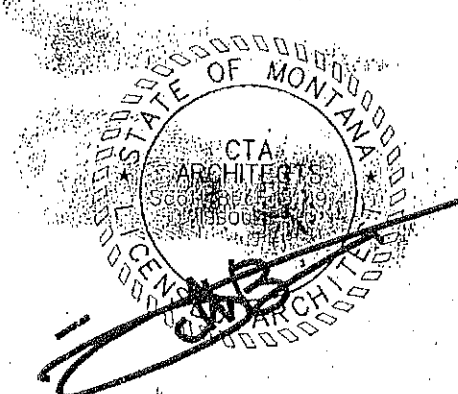

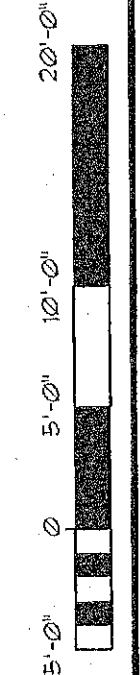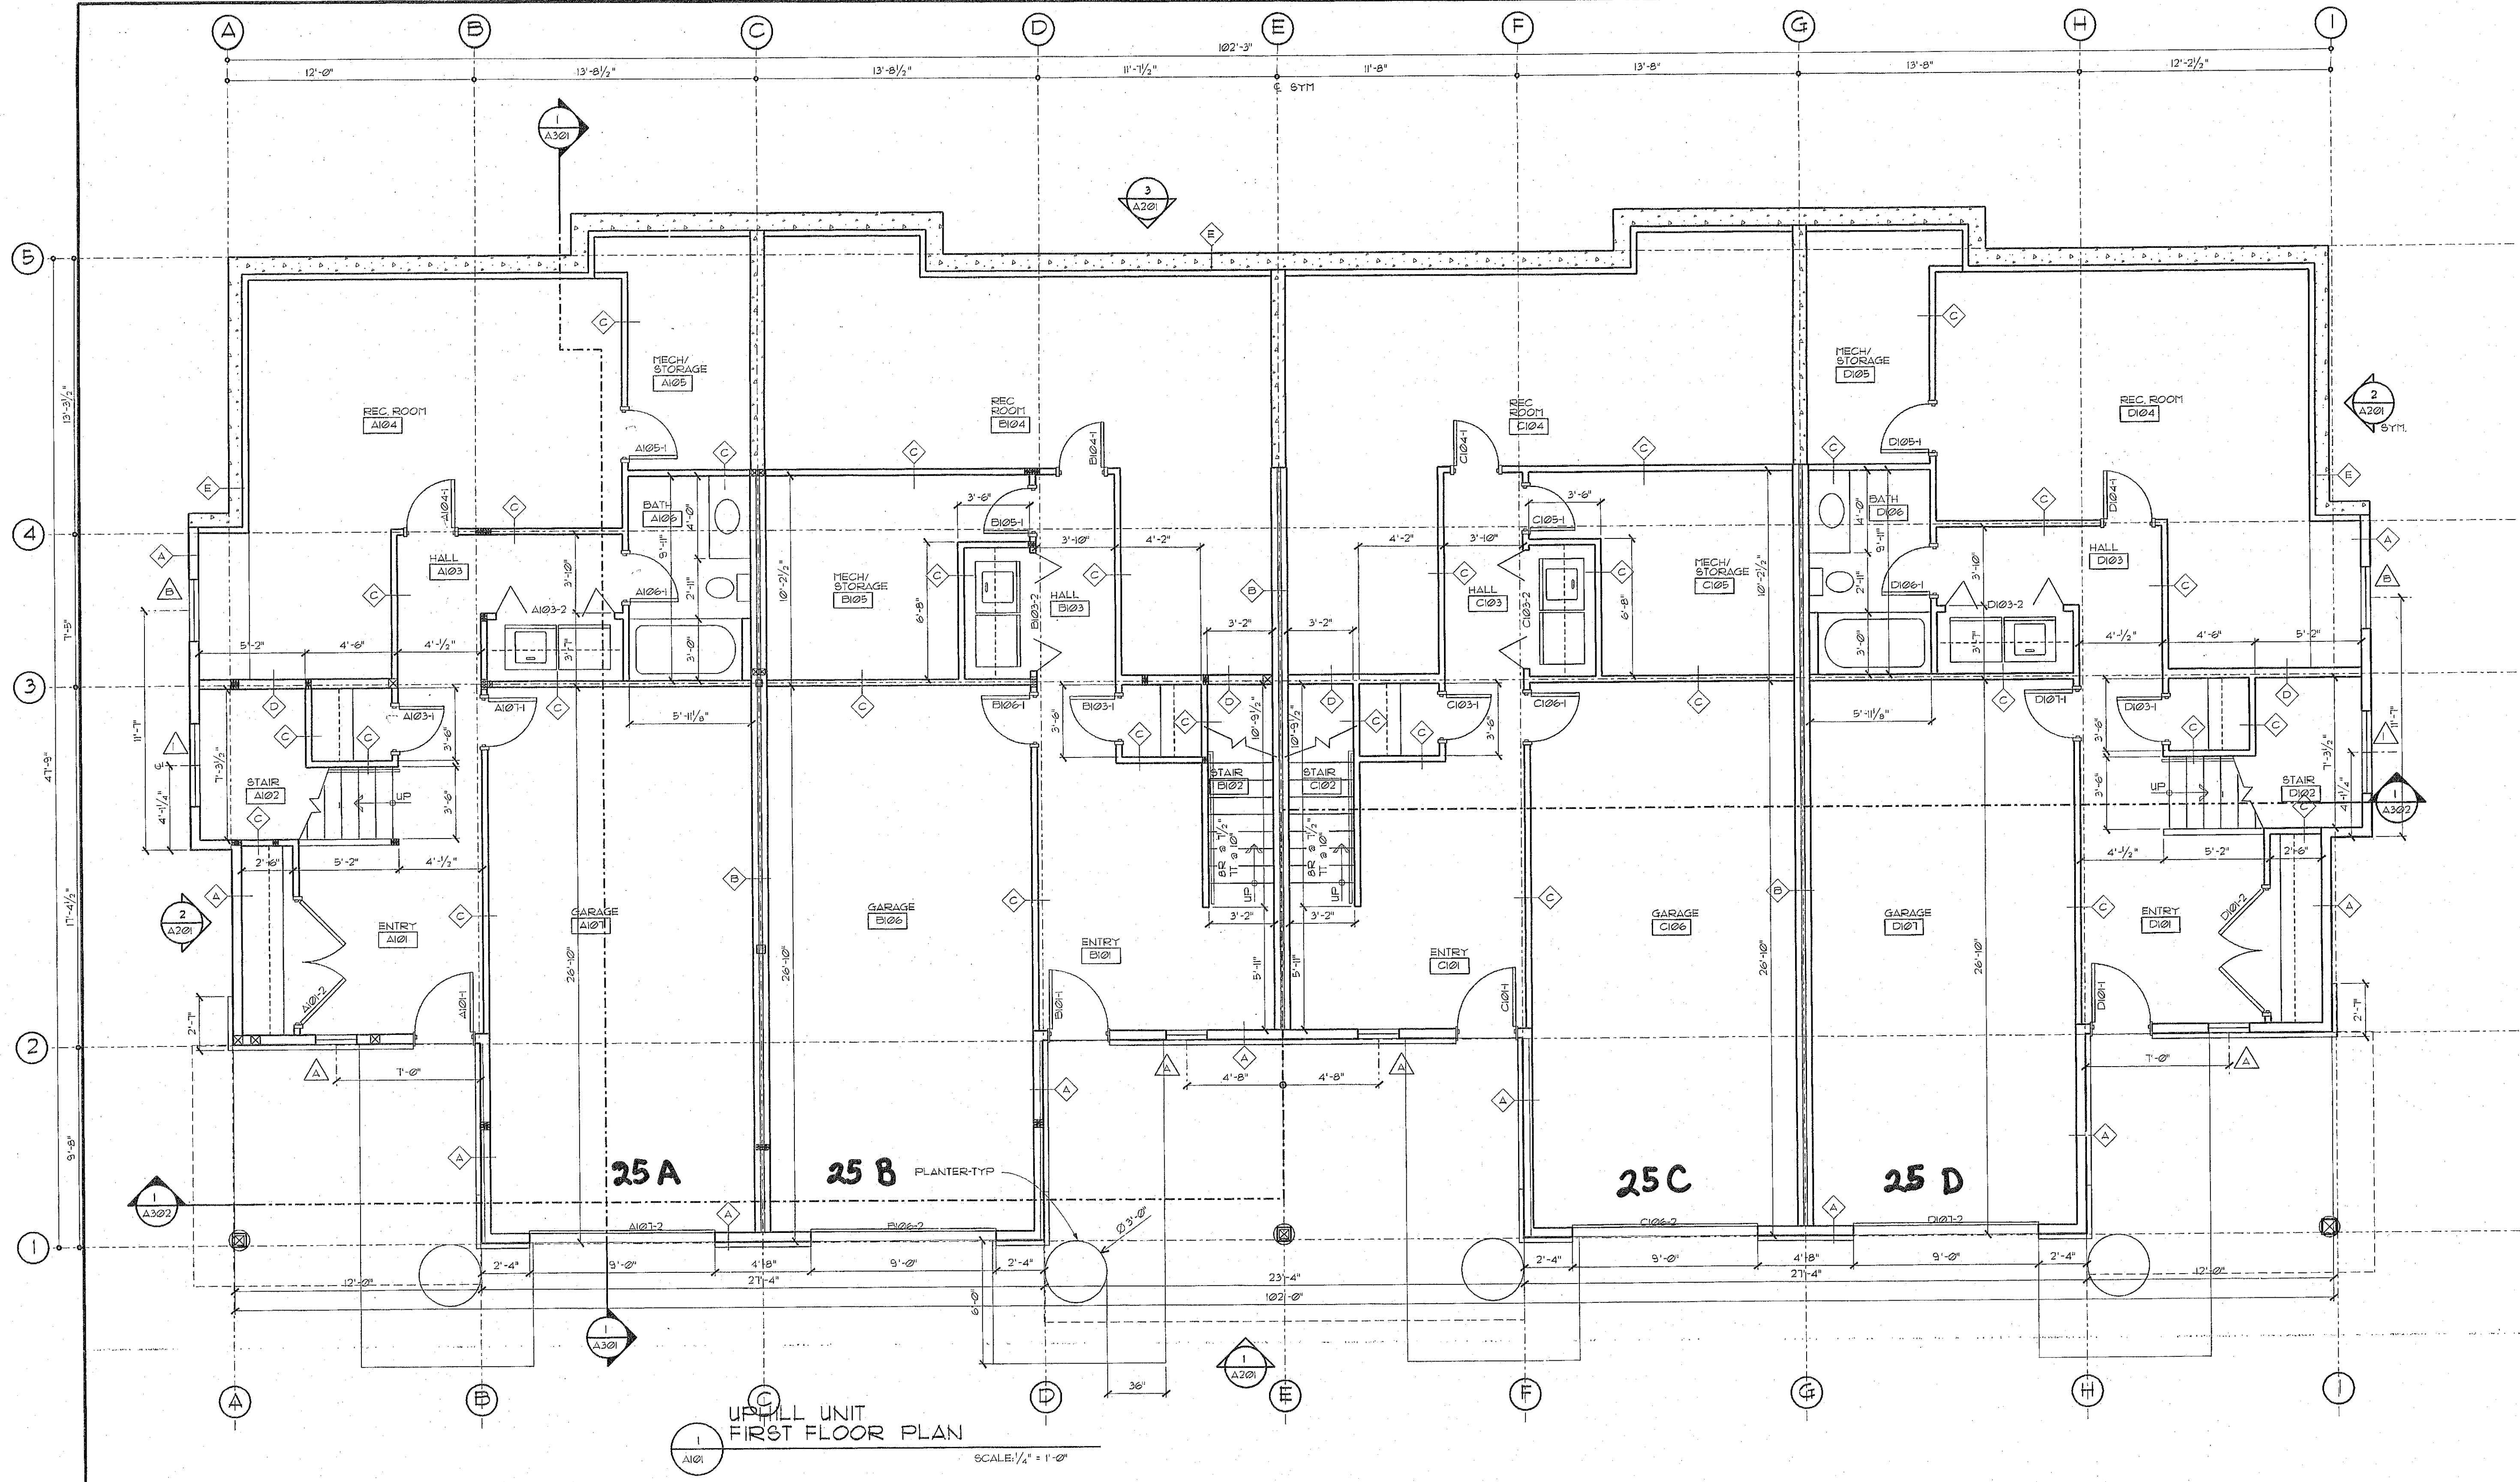

ALL SLABS WILL HAVE
RADON VENTING THROUGH ROOF.

THIS BUILDING IS FULLY
SPRINKLED.

REVISIONS
1
2
3
4
5

ALPENGLOW at Big Sky
BIG SKY, MT
Uphill Unit

AS-BUILTS


COPYRIGHT 2003
CTA
ARCHITECTS
ENGINEERS
BILLINGS • MISSOULA
BOISE • GREAT FALLS
HELENA • KANSPELL
SPOKANE
ALL RIGHTS RESERVED

DRAWN BY: ECR
CHECKED BY: BDB
DATE: 1-20-03
CTA #: MAUS
CADD FILE: UP0101A
DIR: KANTALON

CTA
ARCHITECTS
ENGINEERS
BILLINGS • MISSOULA
BOISE • GREAT FALLS
HELENA • KANSPELL
SPOKANE

**UPHILL
UNIT
1ST FLOOR**

SHEET
A101 OF _____

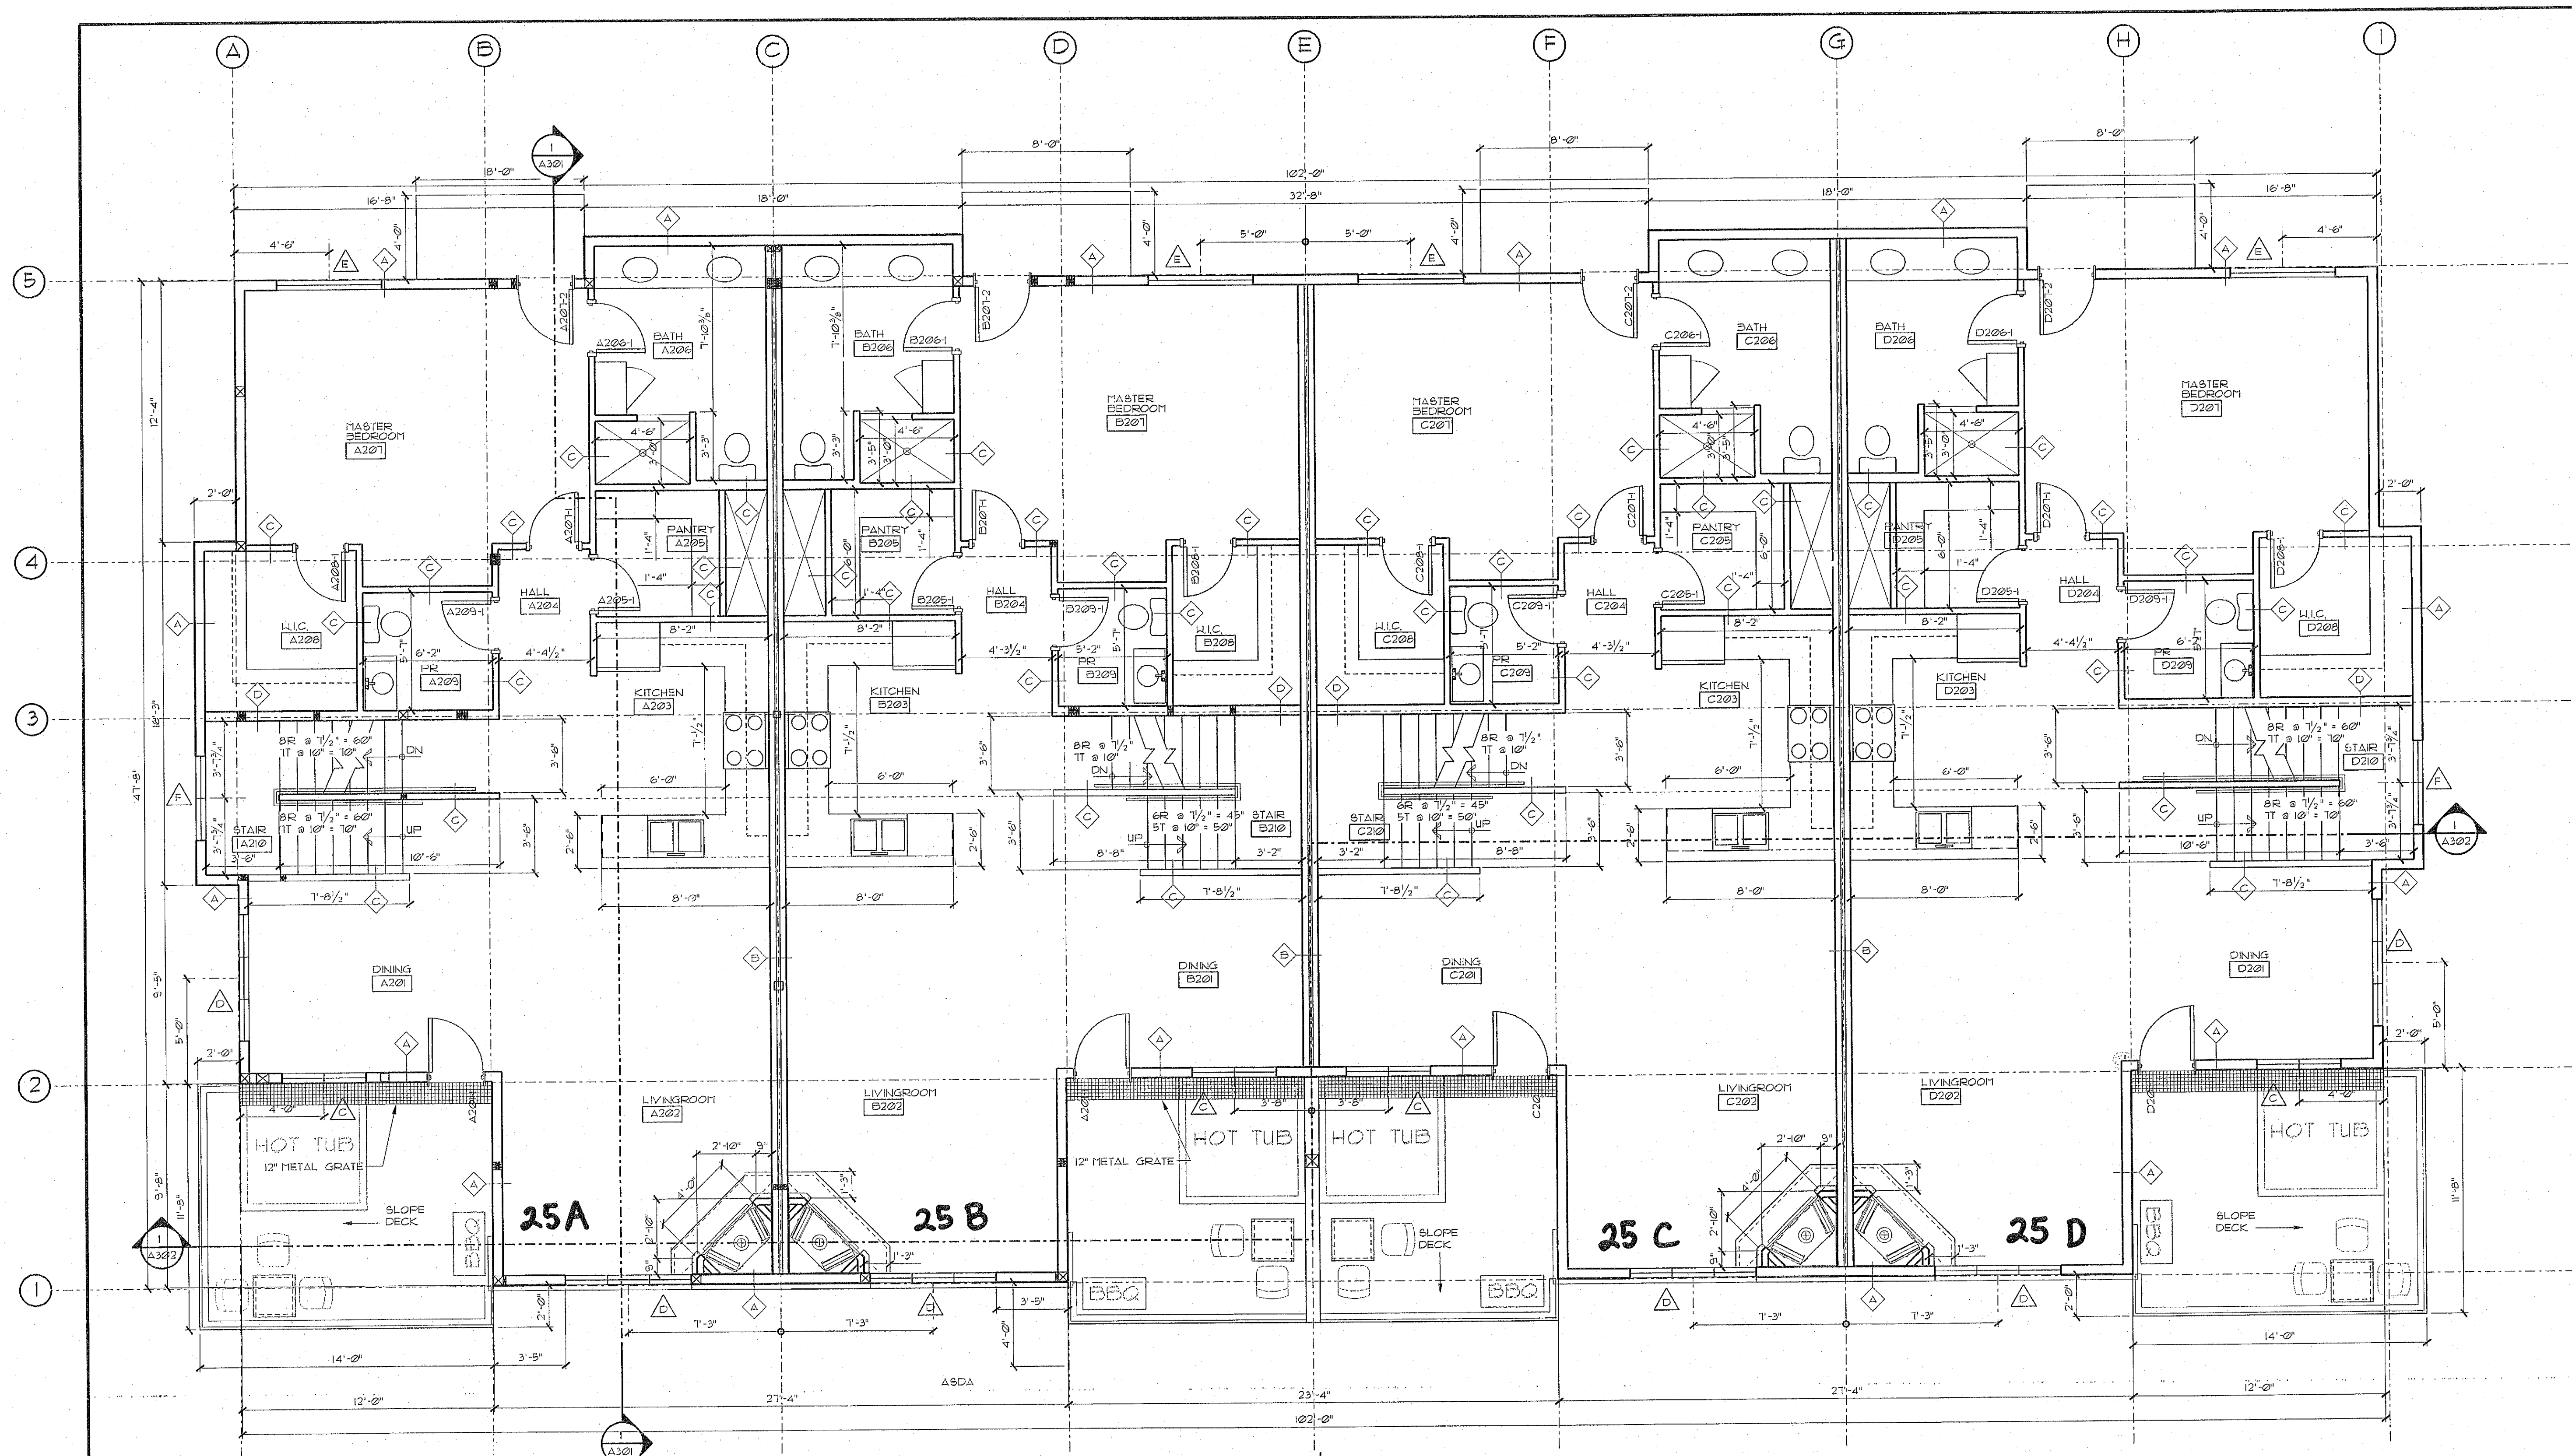

UPHILL UNIT
SECOND FLOOR PLAN
SCALE: 1/4" = 1'-0"
A102

3876
528
36
36
32
32

4862
36
966

Setback Per floor
Setback

Per floor 4540
Total 17,186
- Garage 1467
\$2680 per

10719 total D' finished

REVISIONS:

STAR	REVISION 1/20/03

ALPENGLOW at Big Sky
BIG SKY, MT
Uphill Unit

AS-BUILTS


COPYRIGHT 2003
CTA
ARCHITECTS
ENGINEERS
BILLINGS • MISSOULA
BOISE • GREAT FALLS
HELENA • KALISPELL
SPOKANE
ALL RIGHTS RESERVED

DRAWN BY: ECR
CHECKED BY: SB
DATE: 9-1-04
CTA #: MAUS
CADD FILE: UPA102-AB
DIR: KAMAUS

CTA
ARCHITECTS
ENGINEERS
BILLINGS • MISSOULA
BOISE • GREAT FALLS
HELENA • KALISPELL
SPOKANE

UPHILL
UNIT
2ND FLOOR

SHEET
A102 OF

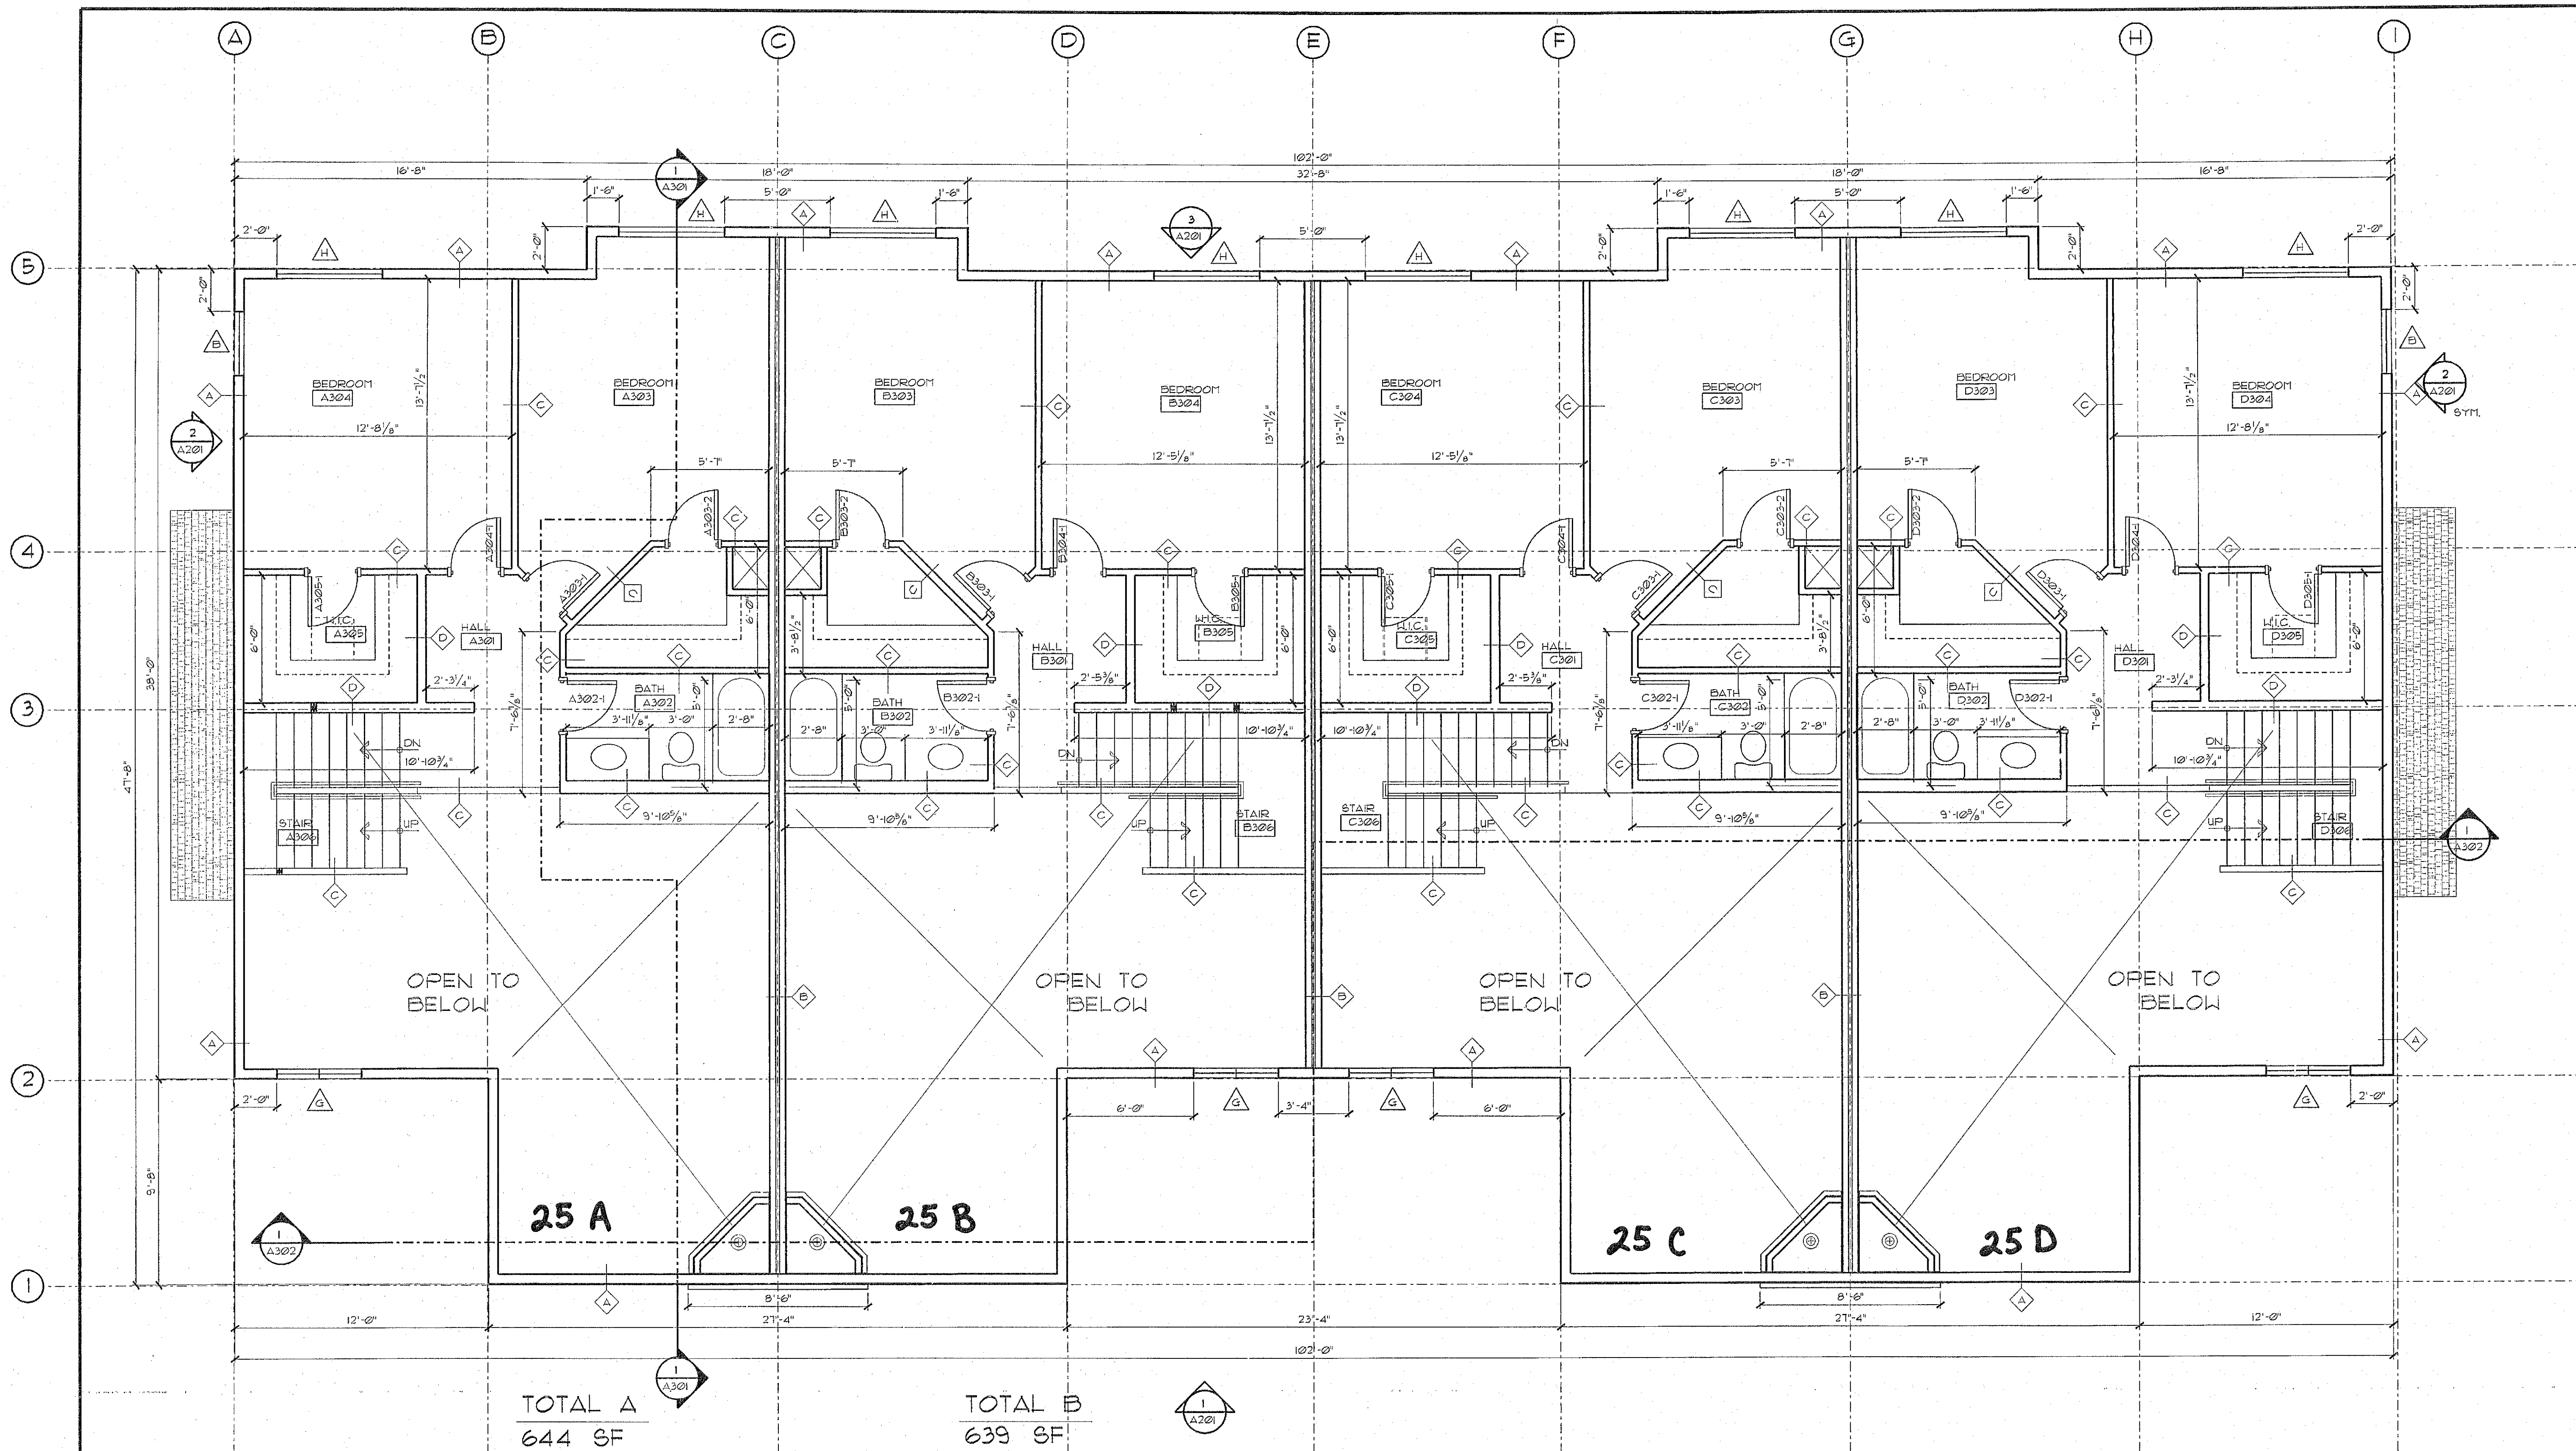

ALPENGLOW at Big Sky
BIG SKY, MT
Uphill Unit

AS-BUILTS

COPYRIGHT 2003
CTA
ARCHITECTS
ENGINEERS
BILLINGS • MISSOULA
BOISE • GREAT FALLS
HELENA • KALISPELL
SPOKANE
ALL RIGHTS RESERVED

DRAWN BY: ECR
CHECKED BY: SB
DATE: 09-10-04
CTA # MAUS
CADD FILE: UPA103-AB
DIR: KAMAUBA

CTA
ARCHITECTS
ENGINEERS
BILLINGS • MISSOULA
BOISE • GREAT FALLS
HELENA • KALISPELL
SPOKANE


UPHILL
UNIT
3RD FLOOR

SHEET

A103 OF


3034
36
36
310601

3876
528
72
2449
72

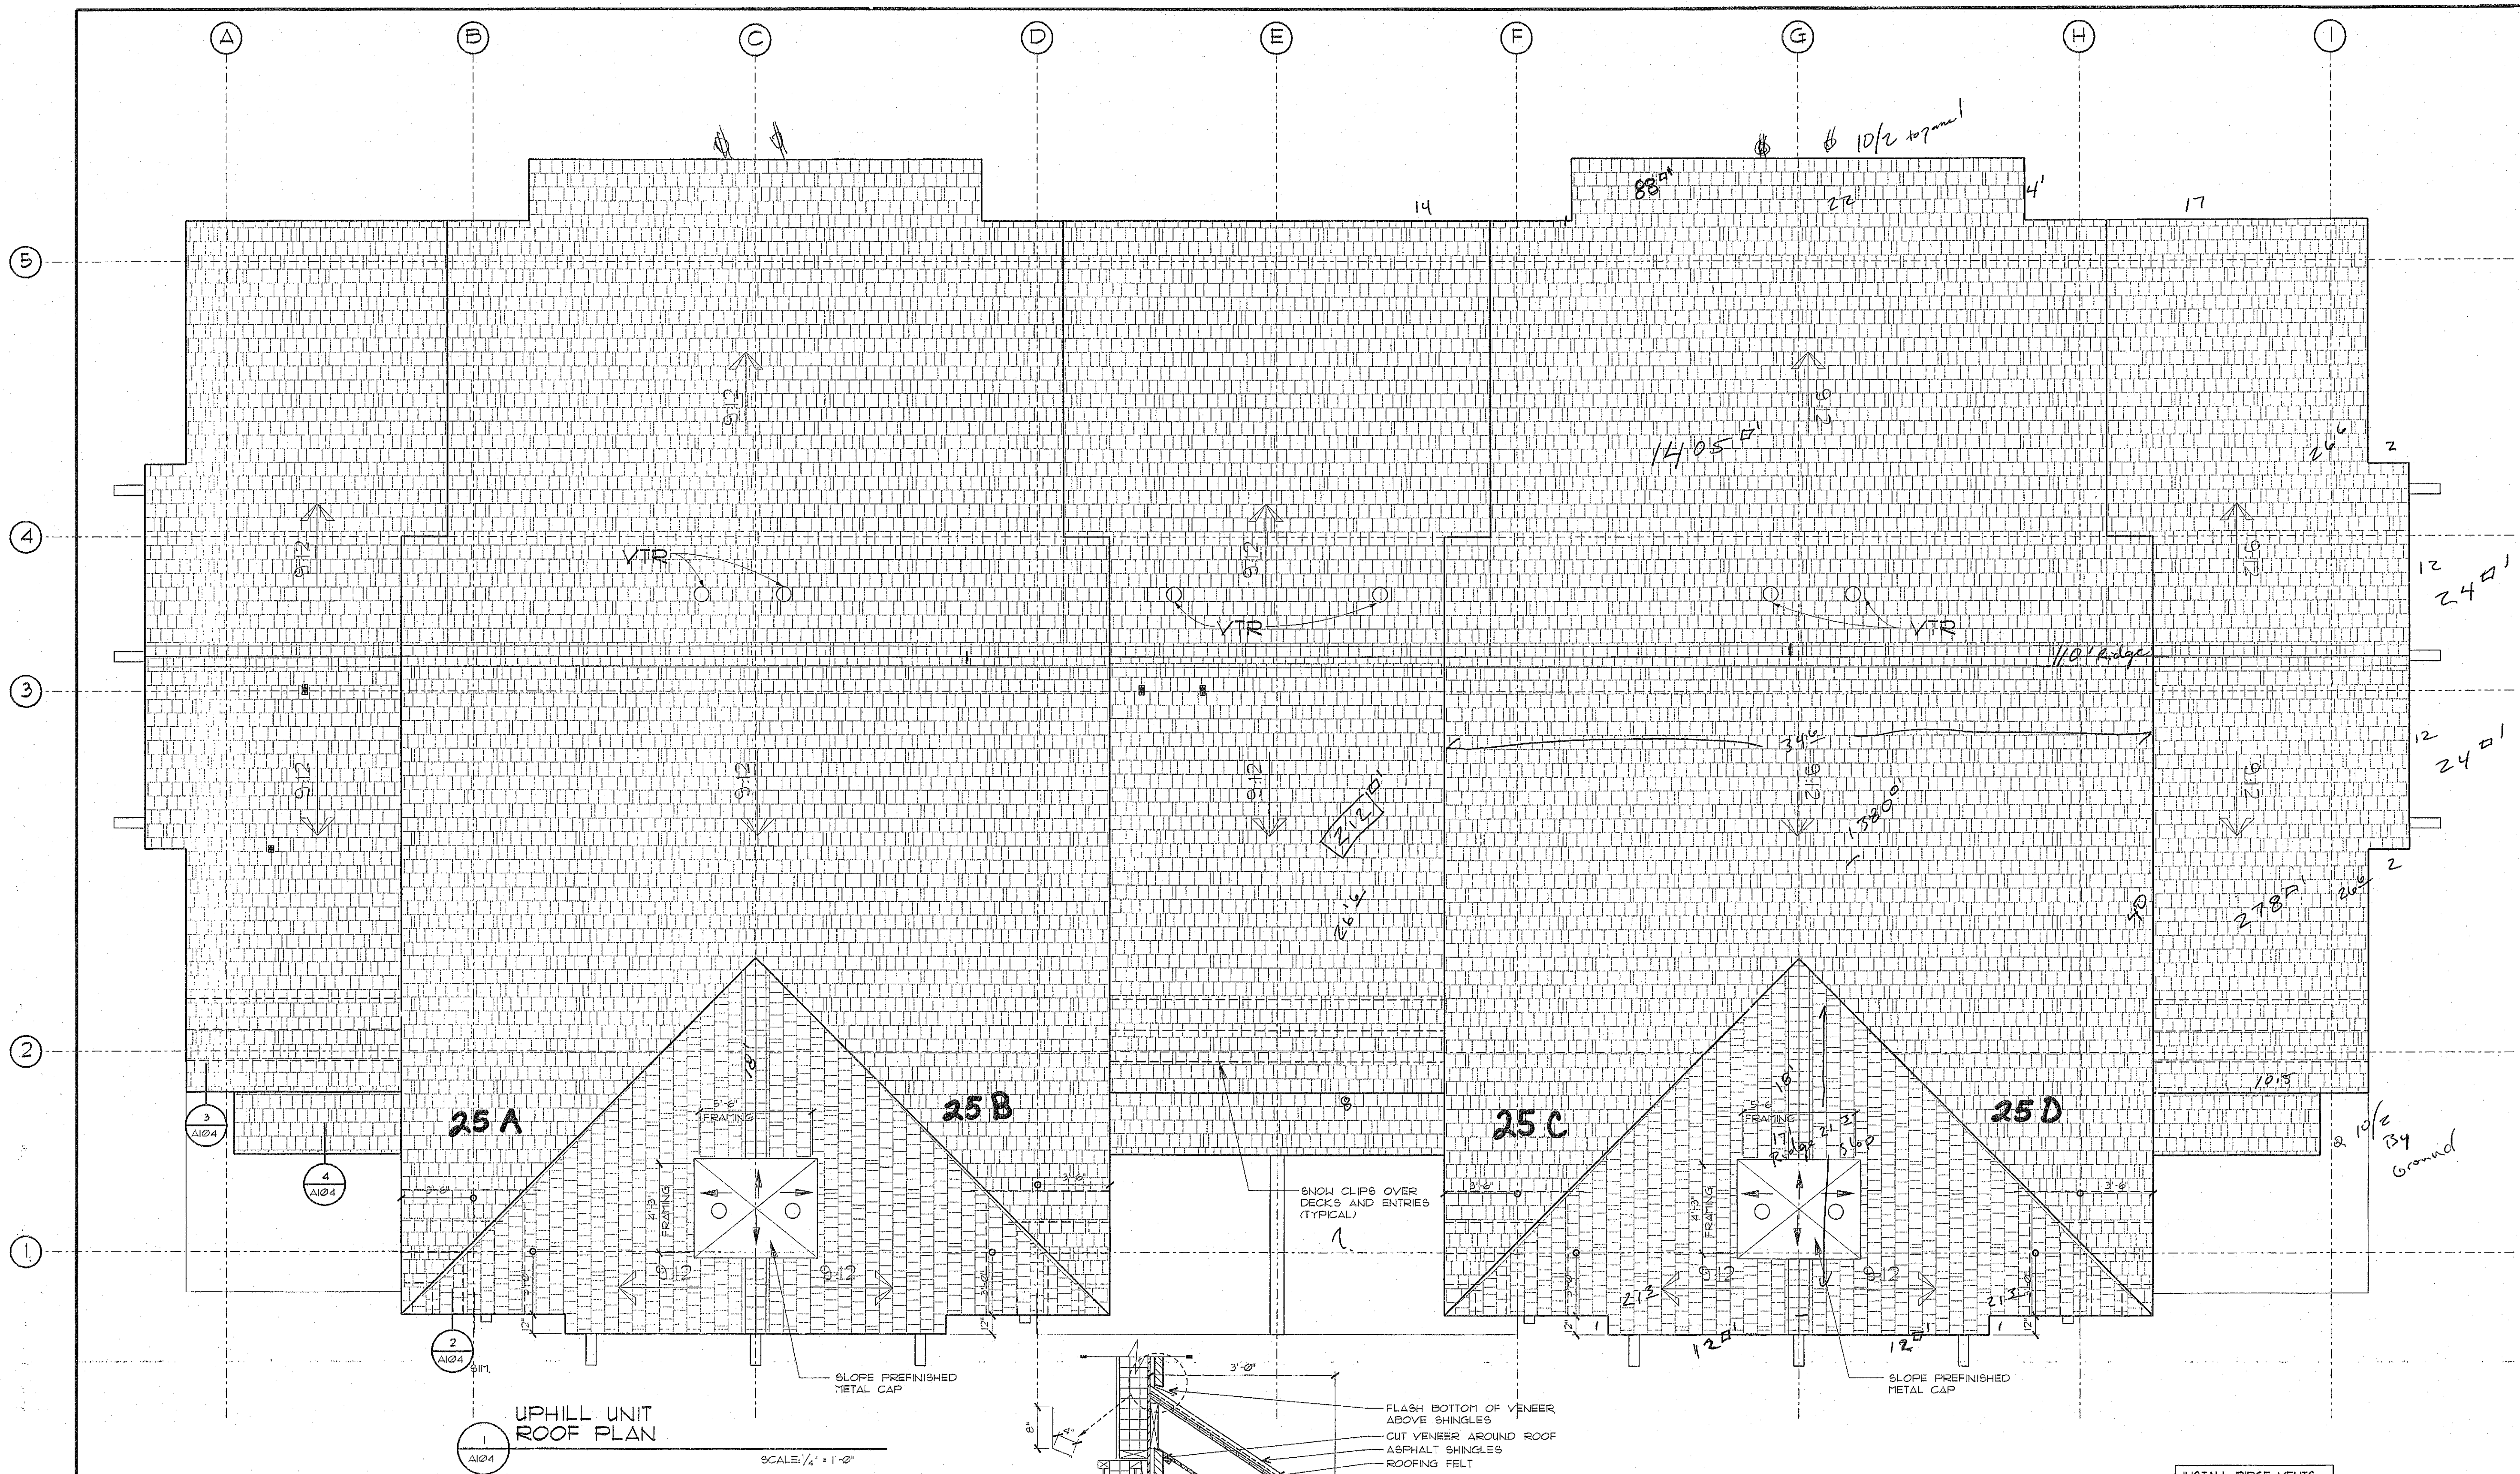


UPHILL UNIT
ROOF PLAN

SCALE: 1/4" = 1'-0"

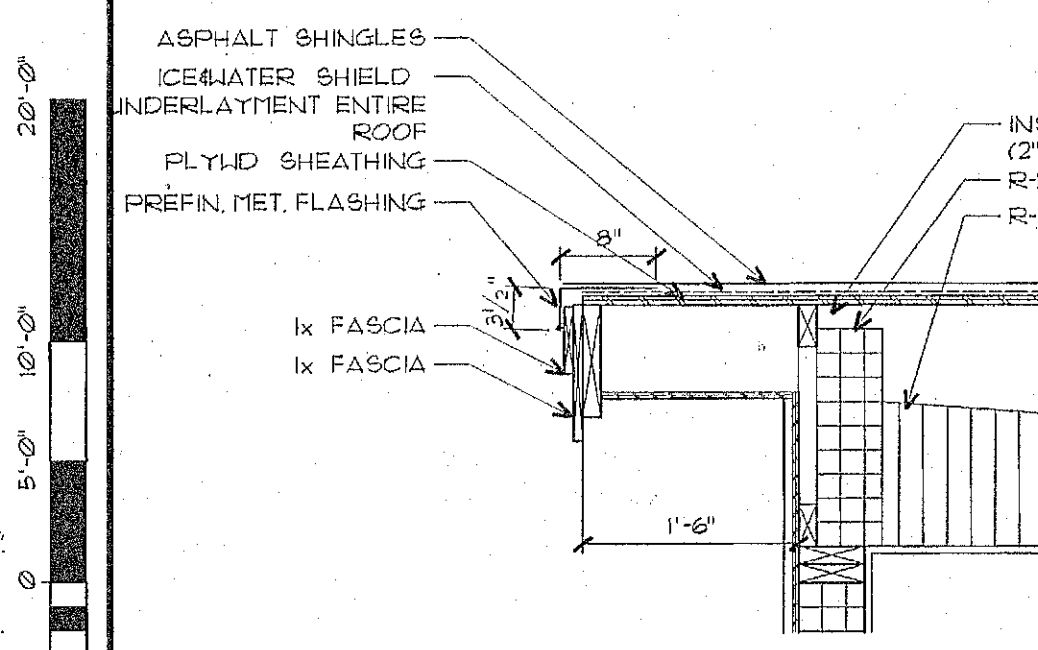


2 TYPICAL RAKE DETAIL

SCALE: 3/4" = 1'-0"

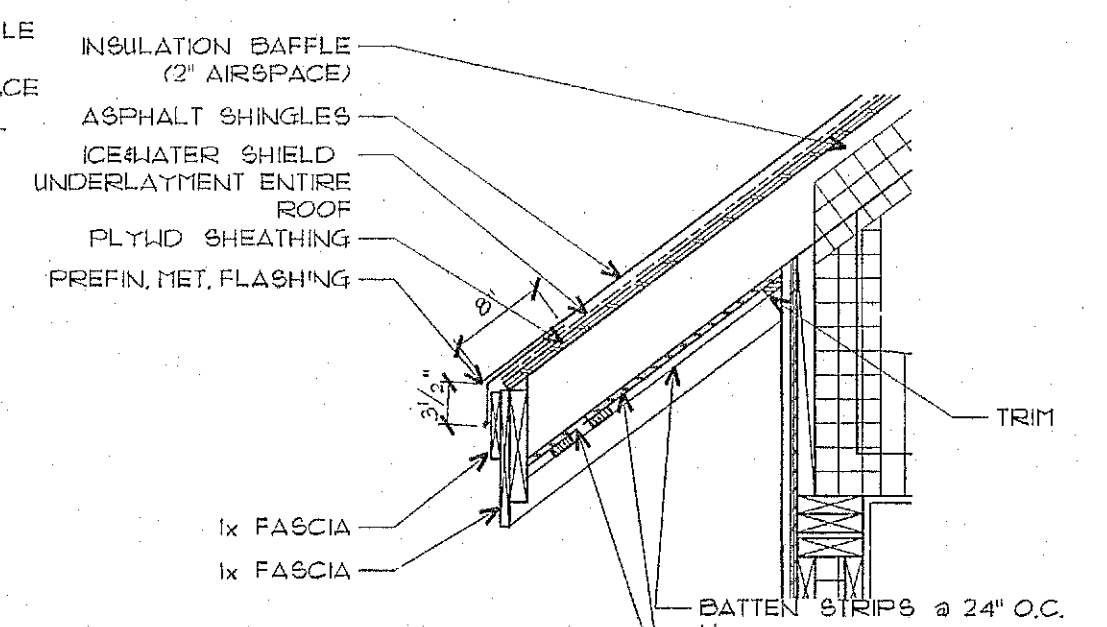

3 TYPICAL EAVE DETAIL

SCALE: 3/4" = 1'-0"

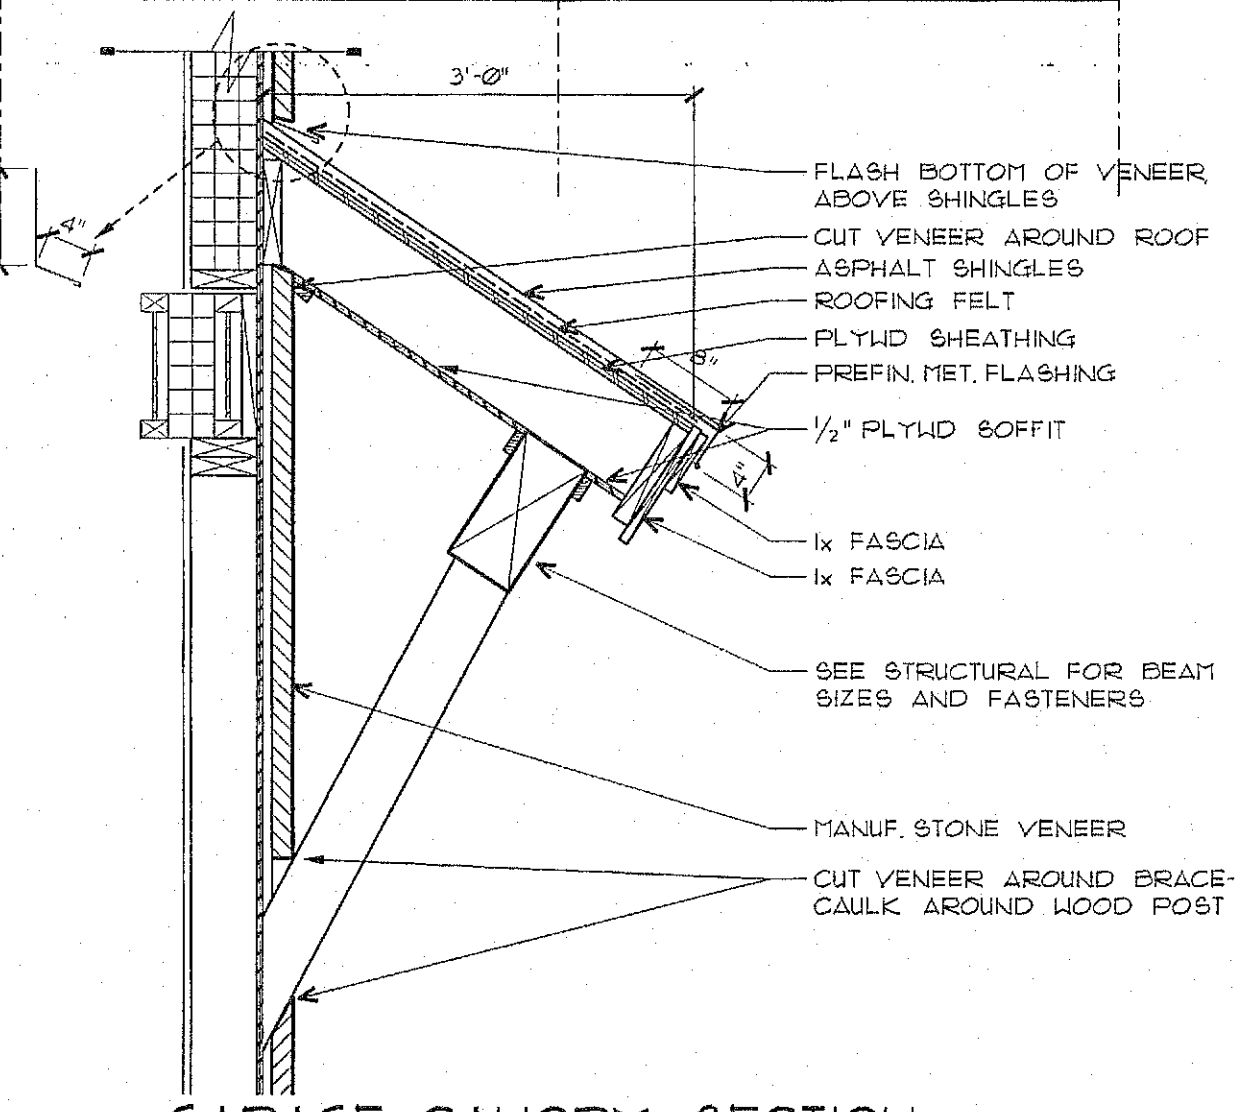

4 GARAGE CANOPY SECTION
(OTHER CANOPIES SIMILAR)

SCALE: 3/4" = 1'-0"

182
264
3435
3935

INSTALL RIDGE VENTS
AT ALL RIDGES

INSTALL 2\"/>

7316 DI
X 146 Ridge
7462 830

REVISIONS

ALPENGLOW at Big Sky
BIG SKY, MT
Uphill Unit

AS-BUILTS


COPYRIGHT 2003
CTA
ARCHITECTS
ENGINEERS
BILLINGS • MISSOULA
BOISE • GREAT FALLS
HELENA • KANSPELL
SPOKANE
ALL RIGHTS RESERVED

DRAWN BY: ECR
CHECKED BY: SPS
DATE: 9-1-04
CTA #: MAUS
CADD FILE: UPA104-AB
DIR: KANTAU


CTA
ARCHITECTS
ENGINEERS
BILLINGS • MISSOULA
BOISE • GREAT FALLS
HELENA • KANSPELL
SPOKANE

UPHILL
UNIT
ROOF PLAN

SHEET
A104 OF

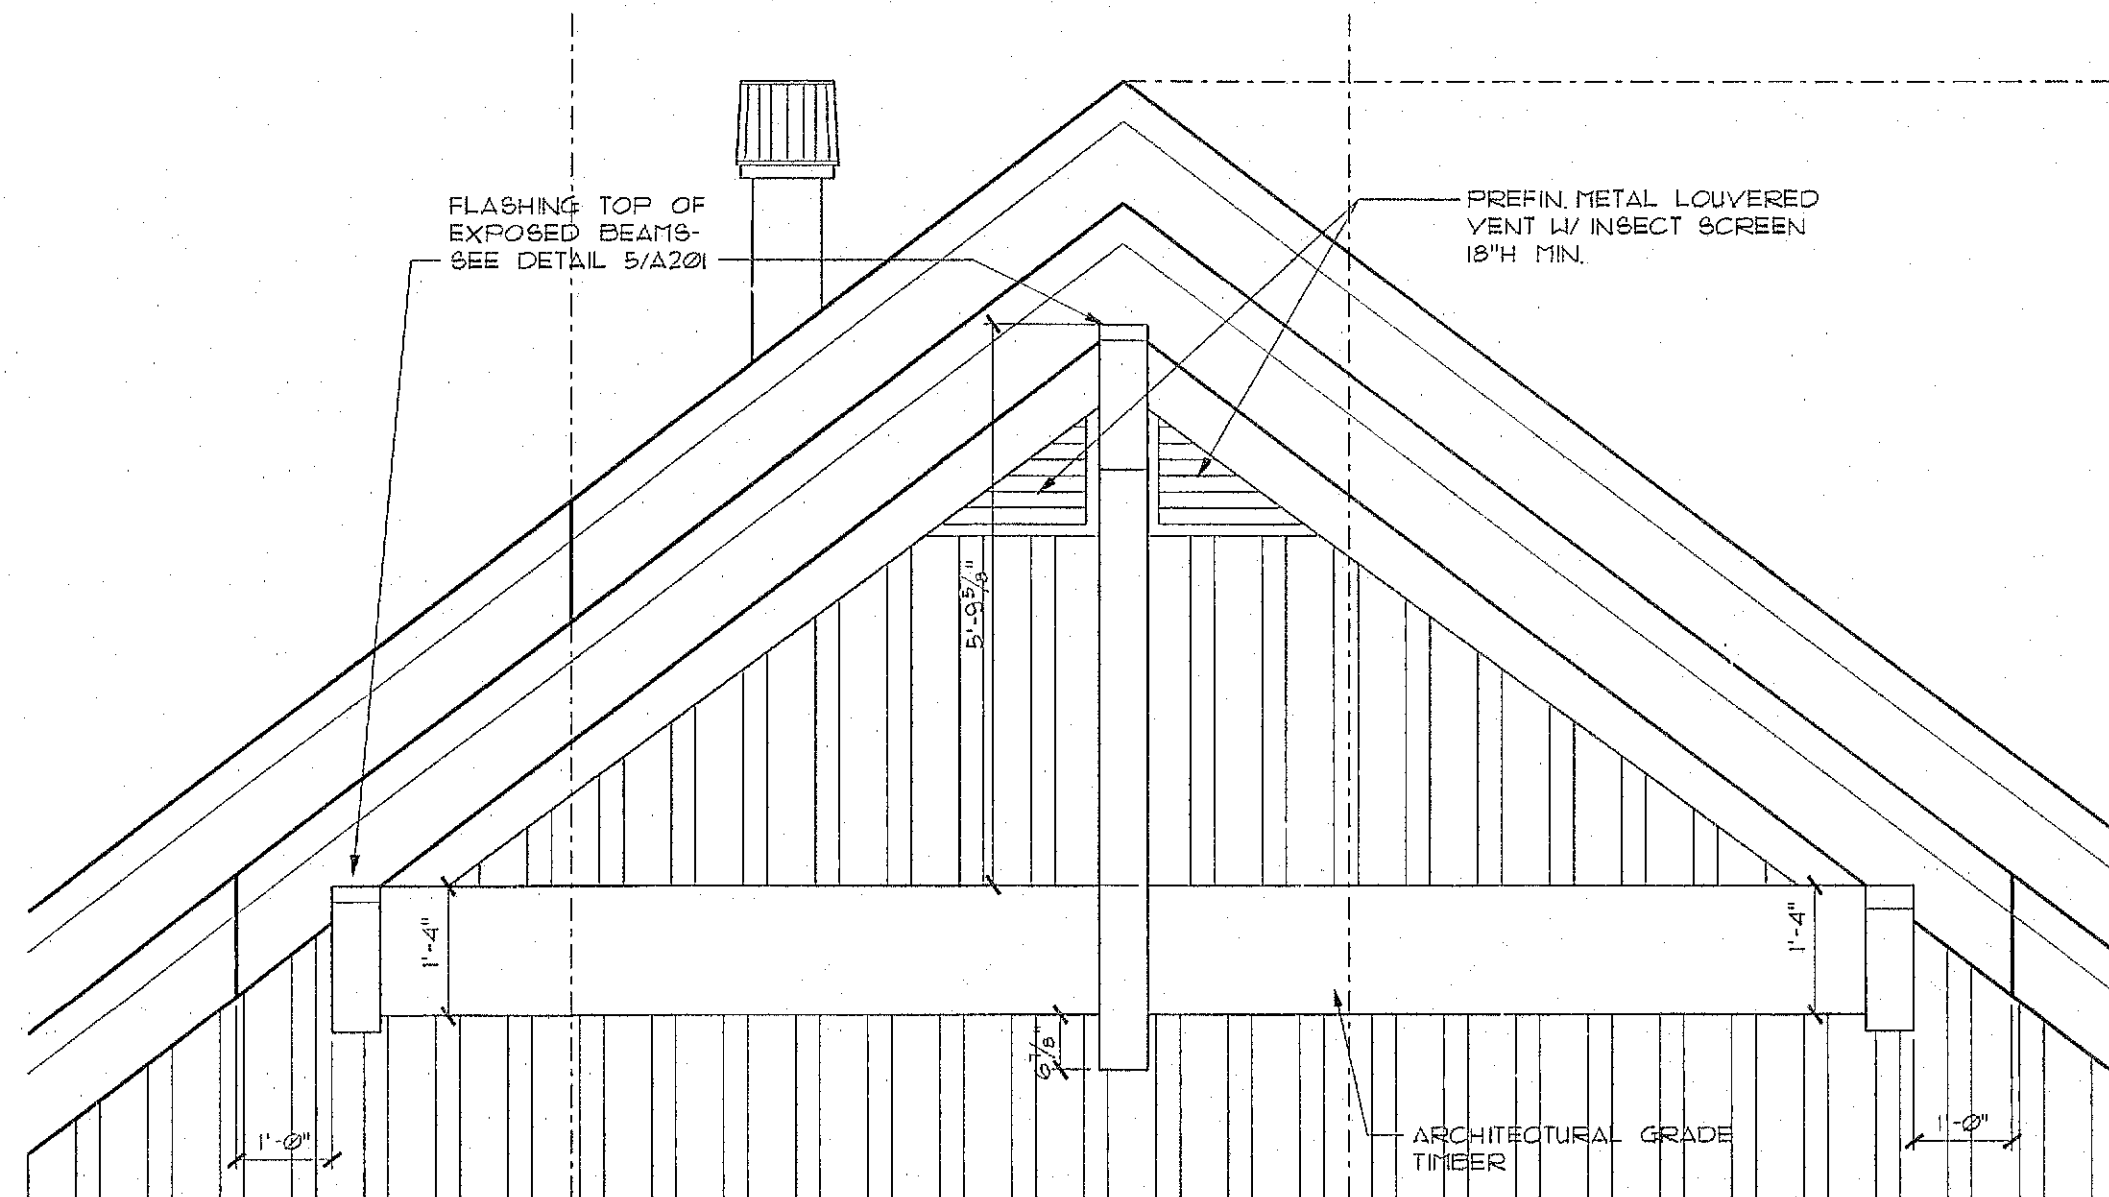


4
A201
UPHILL UNIT
BEAM & LOUVER DETAIL
SCALE: 1/2" = 1'-0"

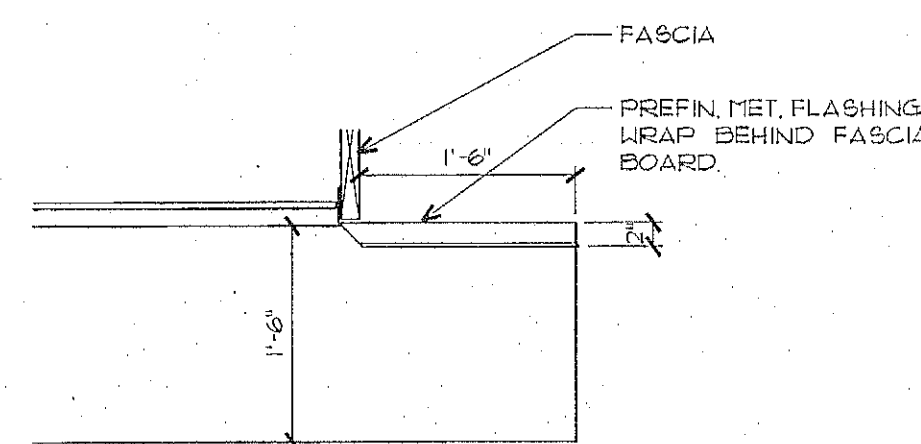


5
A201
TYPICAL
BEAM CUT & FLASHING
SCALE: 3/4" = 1'-0"



1
A201
UPHILL UNIT
FRONT ELEVATION
SCALE: 1/8" = 1'-0"

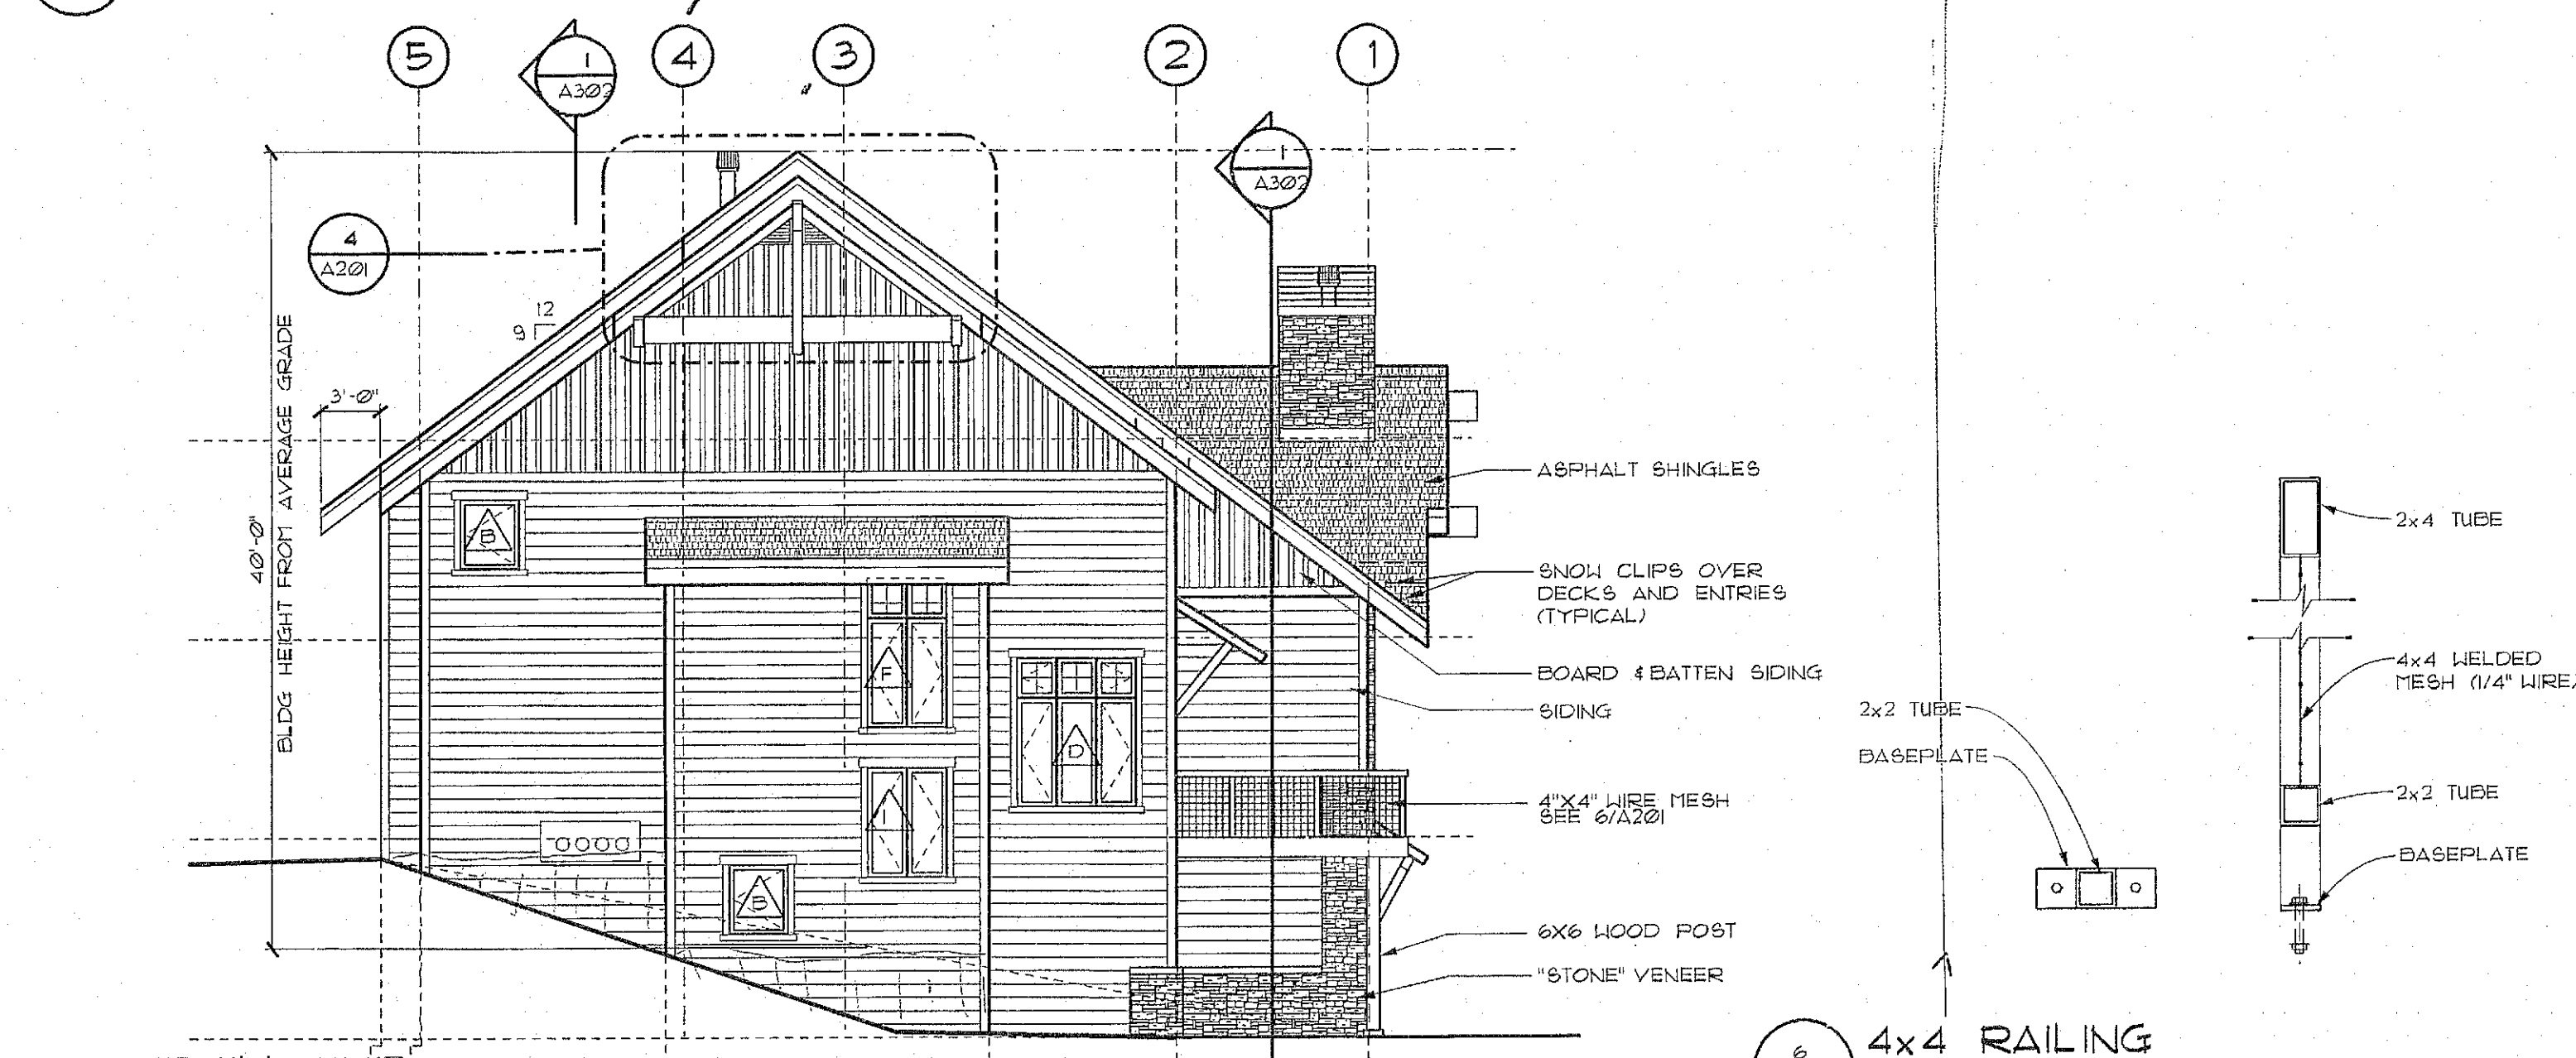

2
A201
UPHILL UNIT
SIDE ELEVATION
SCALE: 1/8" = 1'-0"

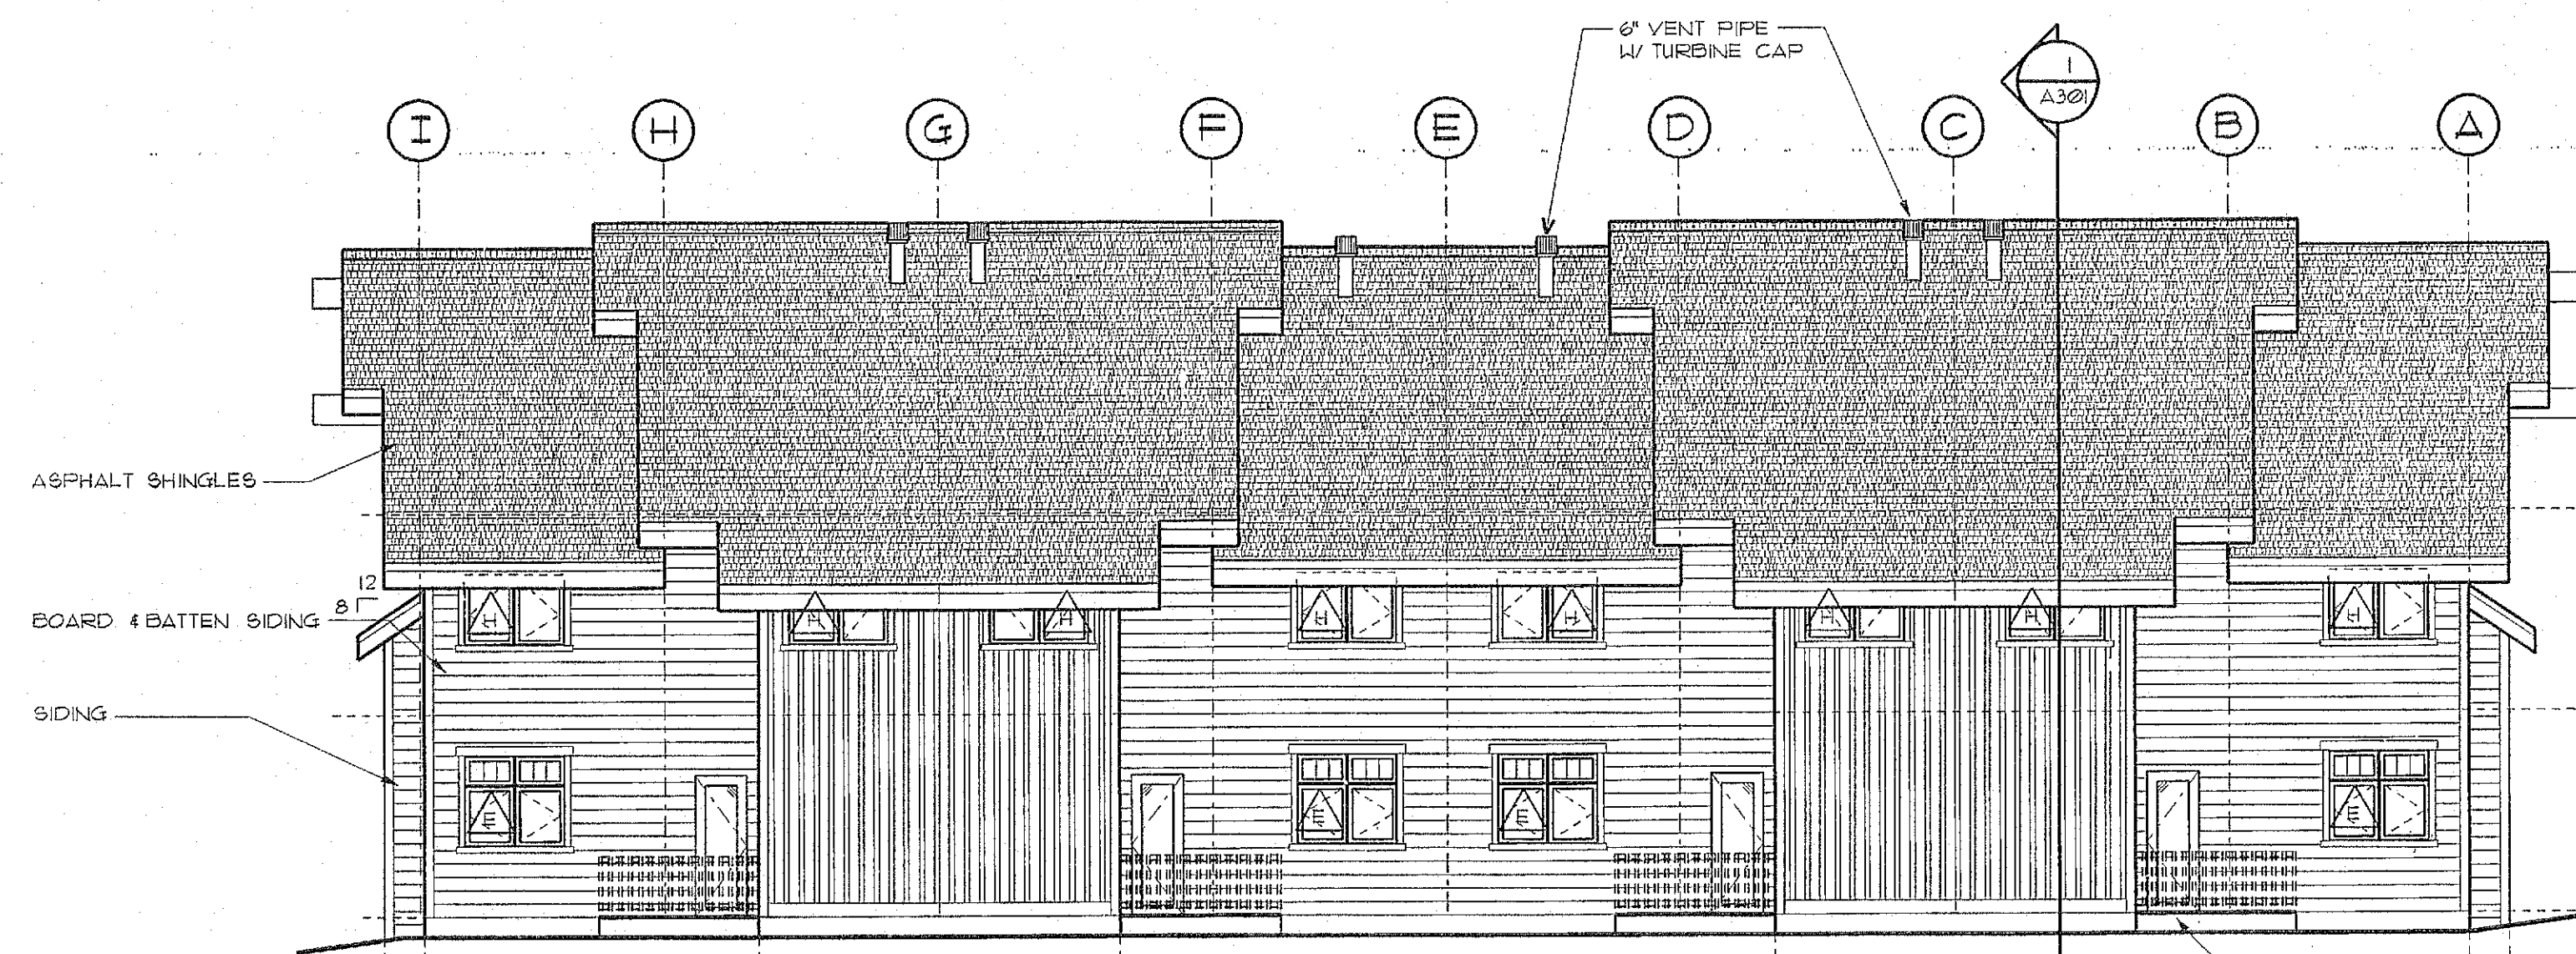

3
A201
UPHILL UNIT
BACK ELEVATION
SCALE: 1/8" = 1'-0"

MATERIALS LEGEND

SIDING - HEATHER-TITE WANED-EDGE PINE LAP SIDING
STAIN - MESHERS ALASKAN LOG FINISH NATURAL CEDAR
ROOFING - TATKO MOUNTAIN SLATE
WINDOWS - NORCO BRONZE
STONE - CORONADO STONES IDAHO DRYSTACK ASPEN

REVISIONS:

ALPENGLOW at Big Sky
BIG SKY, MT
Uphill Unit

AS-BUILTS

COPYRIGHT 2003
CTA
ARCHITECTS
ENGINEERS
BILLINGS • MISSOULA
BOISE • GREAT FALLS
HELENA • KALISPELL
SPOKANE
ALL RIGHTS RESERVED

DRAWN BY: ECR
CHECKED BY: SB
DATE: 1-20-03
CTA # MAUS
CADD FILE: UPA201-AB
DIR: KMAUS




CTA
ARCHITECTS
ENGINEERS
BILLINGS • MISSOULA
BOISE • GREAT FALLS
HELENA • KALISPELL
SPOKANE

UPHILL
UNIT
ELEVATIONS

SHEET

A201 OF

20'-0"
10'-0"
5'-0"
0

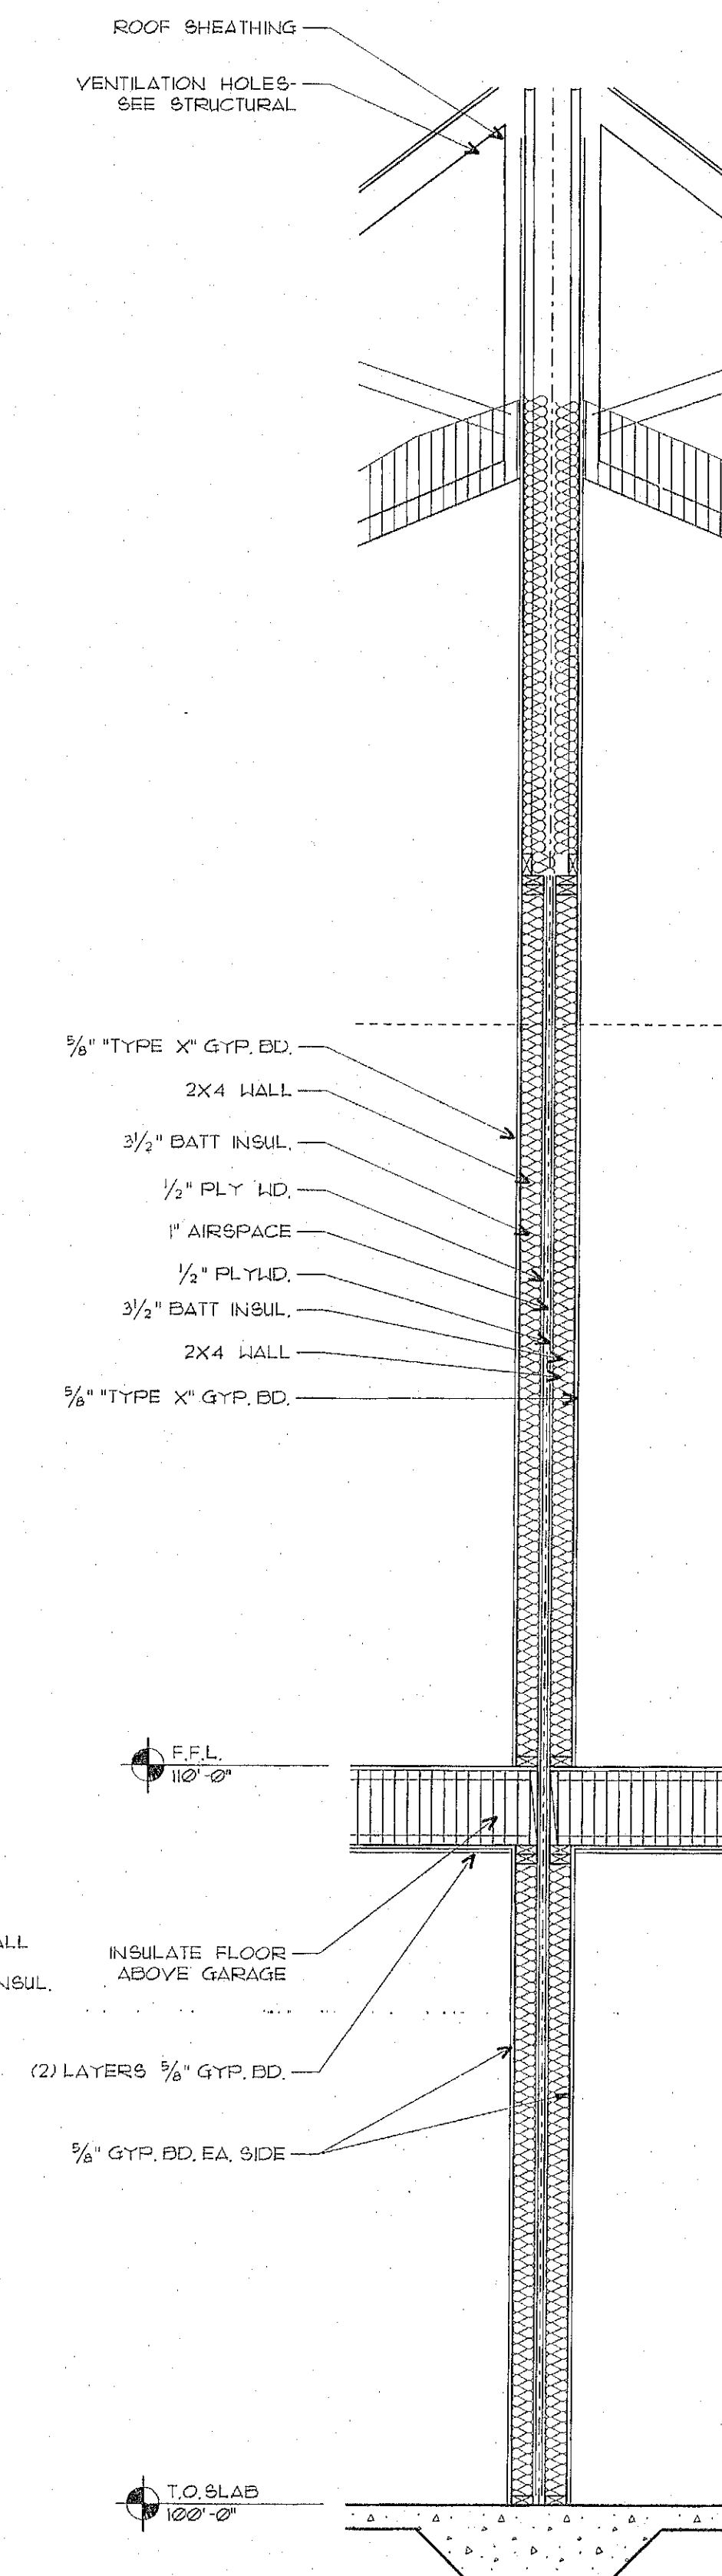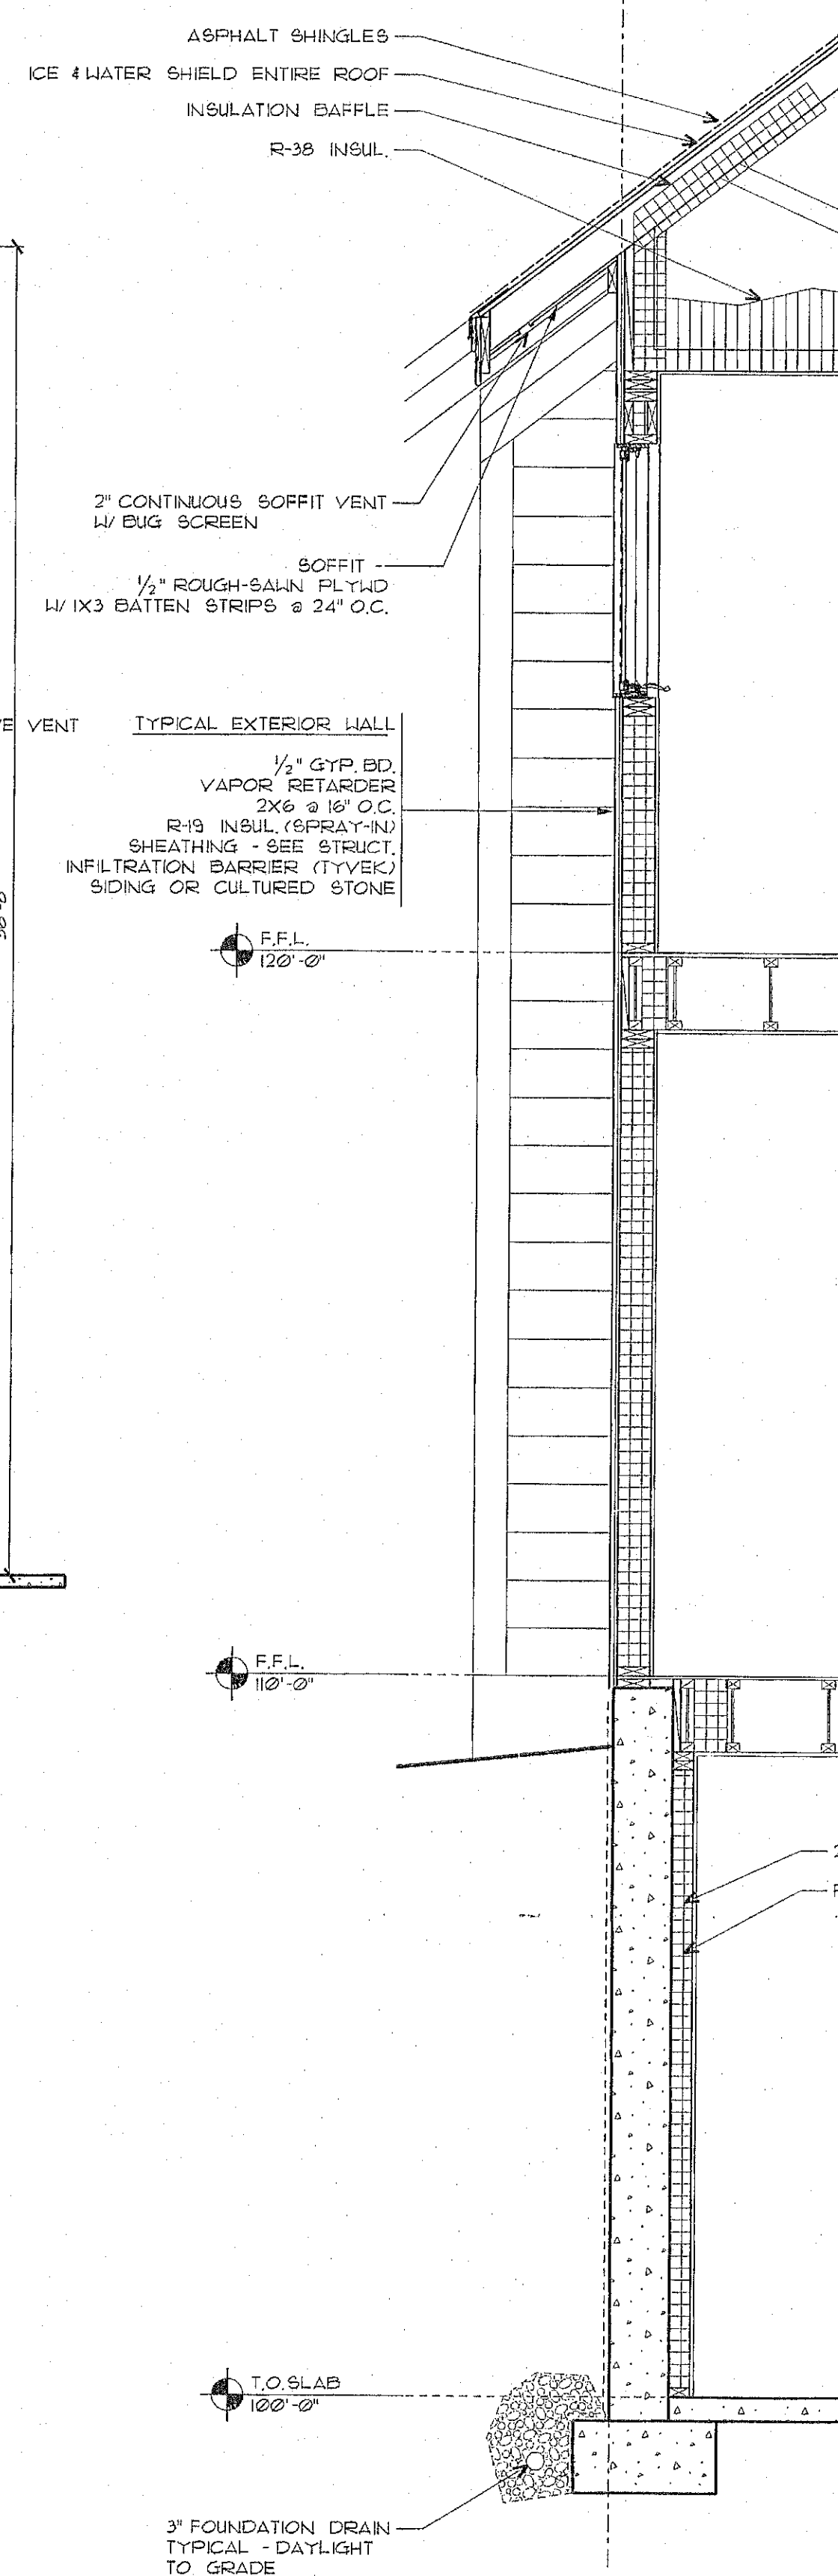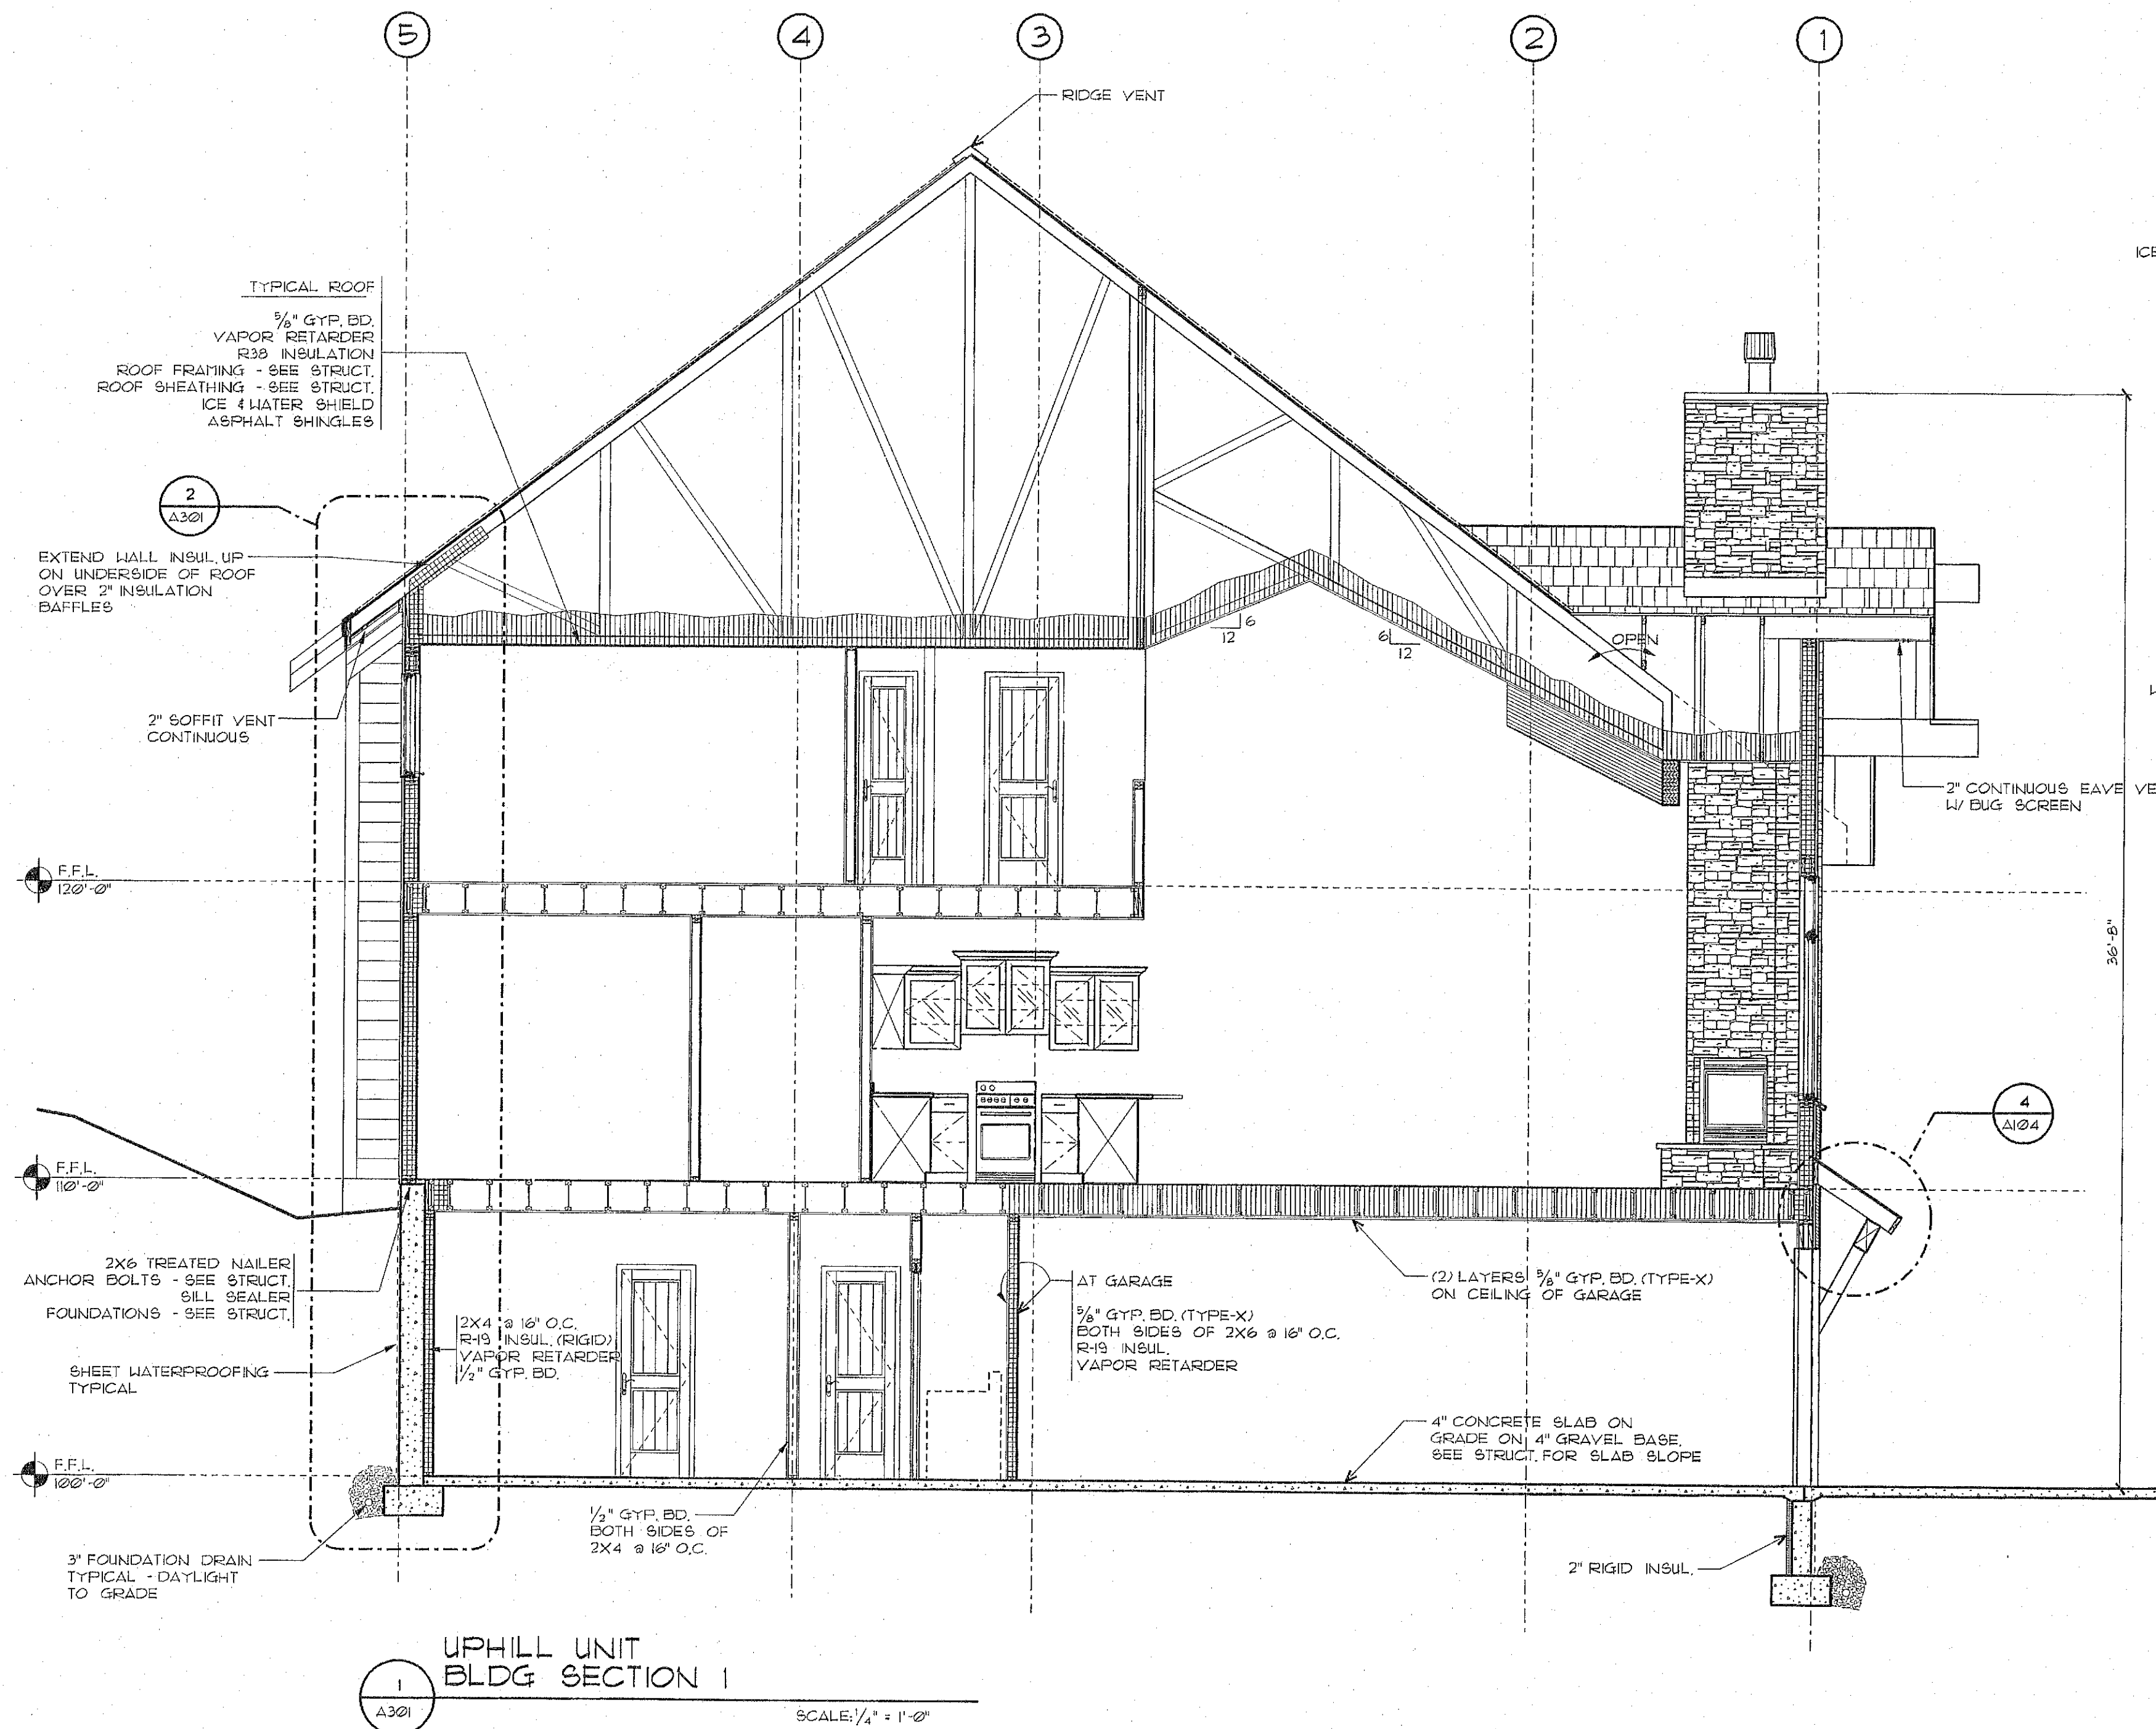

REVISIONS:

ALPENGLOW at Big Sky
 BIG SKY, MT
 Uphill Unit

AS-BUILTS

COPYRIGHT 2003
 CTA
 ARCHITECTS
 ENGINEERS
 BILLINGS • MISSOULA
 BOISE • GREAT FALLS
 HELENA • KAUPELL
 SPOKANE
 ALL RIGHTS RESERVED

DRAWN BY: JFP
 CHECKED BY: JEB
 DATE: 9-1-04
 CTA # MAUS
 CADD FILE: UP301
 DIR: K:\MAUS

CTA
 ARCHITECTS
 ENGINEERS
 BILLINGS • MISSOULA
 BOISE • GREAT FALLS
 HELENA • KAUPELL
 SPOKANE

UPHILL
 UNIT
 SECTION

SHEET

A301 OF

REVISIONS	DATE	BY	APP'D
STAR REVISION 5/20/03			

ALPENGLOW at Big Sky BIG SKY, MT Uphill Unit

AS-BUILTS

COPYRIGHT 2003
CTA
ARCHITECTS
ENGINEERS
BILLINGS • MISSOULA
BOISE • GREAT FALLS
HELENA • KALISPELL
SPOKANE


ALL RIGHTS RESERVED

DRAWN BY: JPP
CHECKED BY: SB
DATE: 9-1-04
CTA #: MAUS
CADD FILE: UPA302
DIR: KANTAU

CTA
ARCHITECTS
ENGINEERS
BILLINGS • MISSOULA
BOISE • GREAT FALLS
HELENA • KALISPELL
SPOKANE


**UPHILL
UNIT
SECTION**

SHEET
A302 OF _____

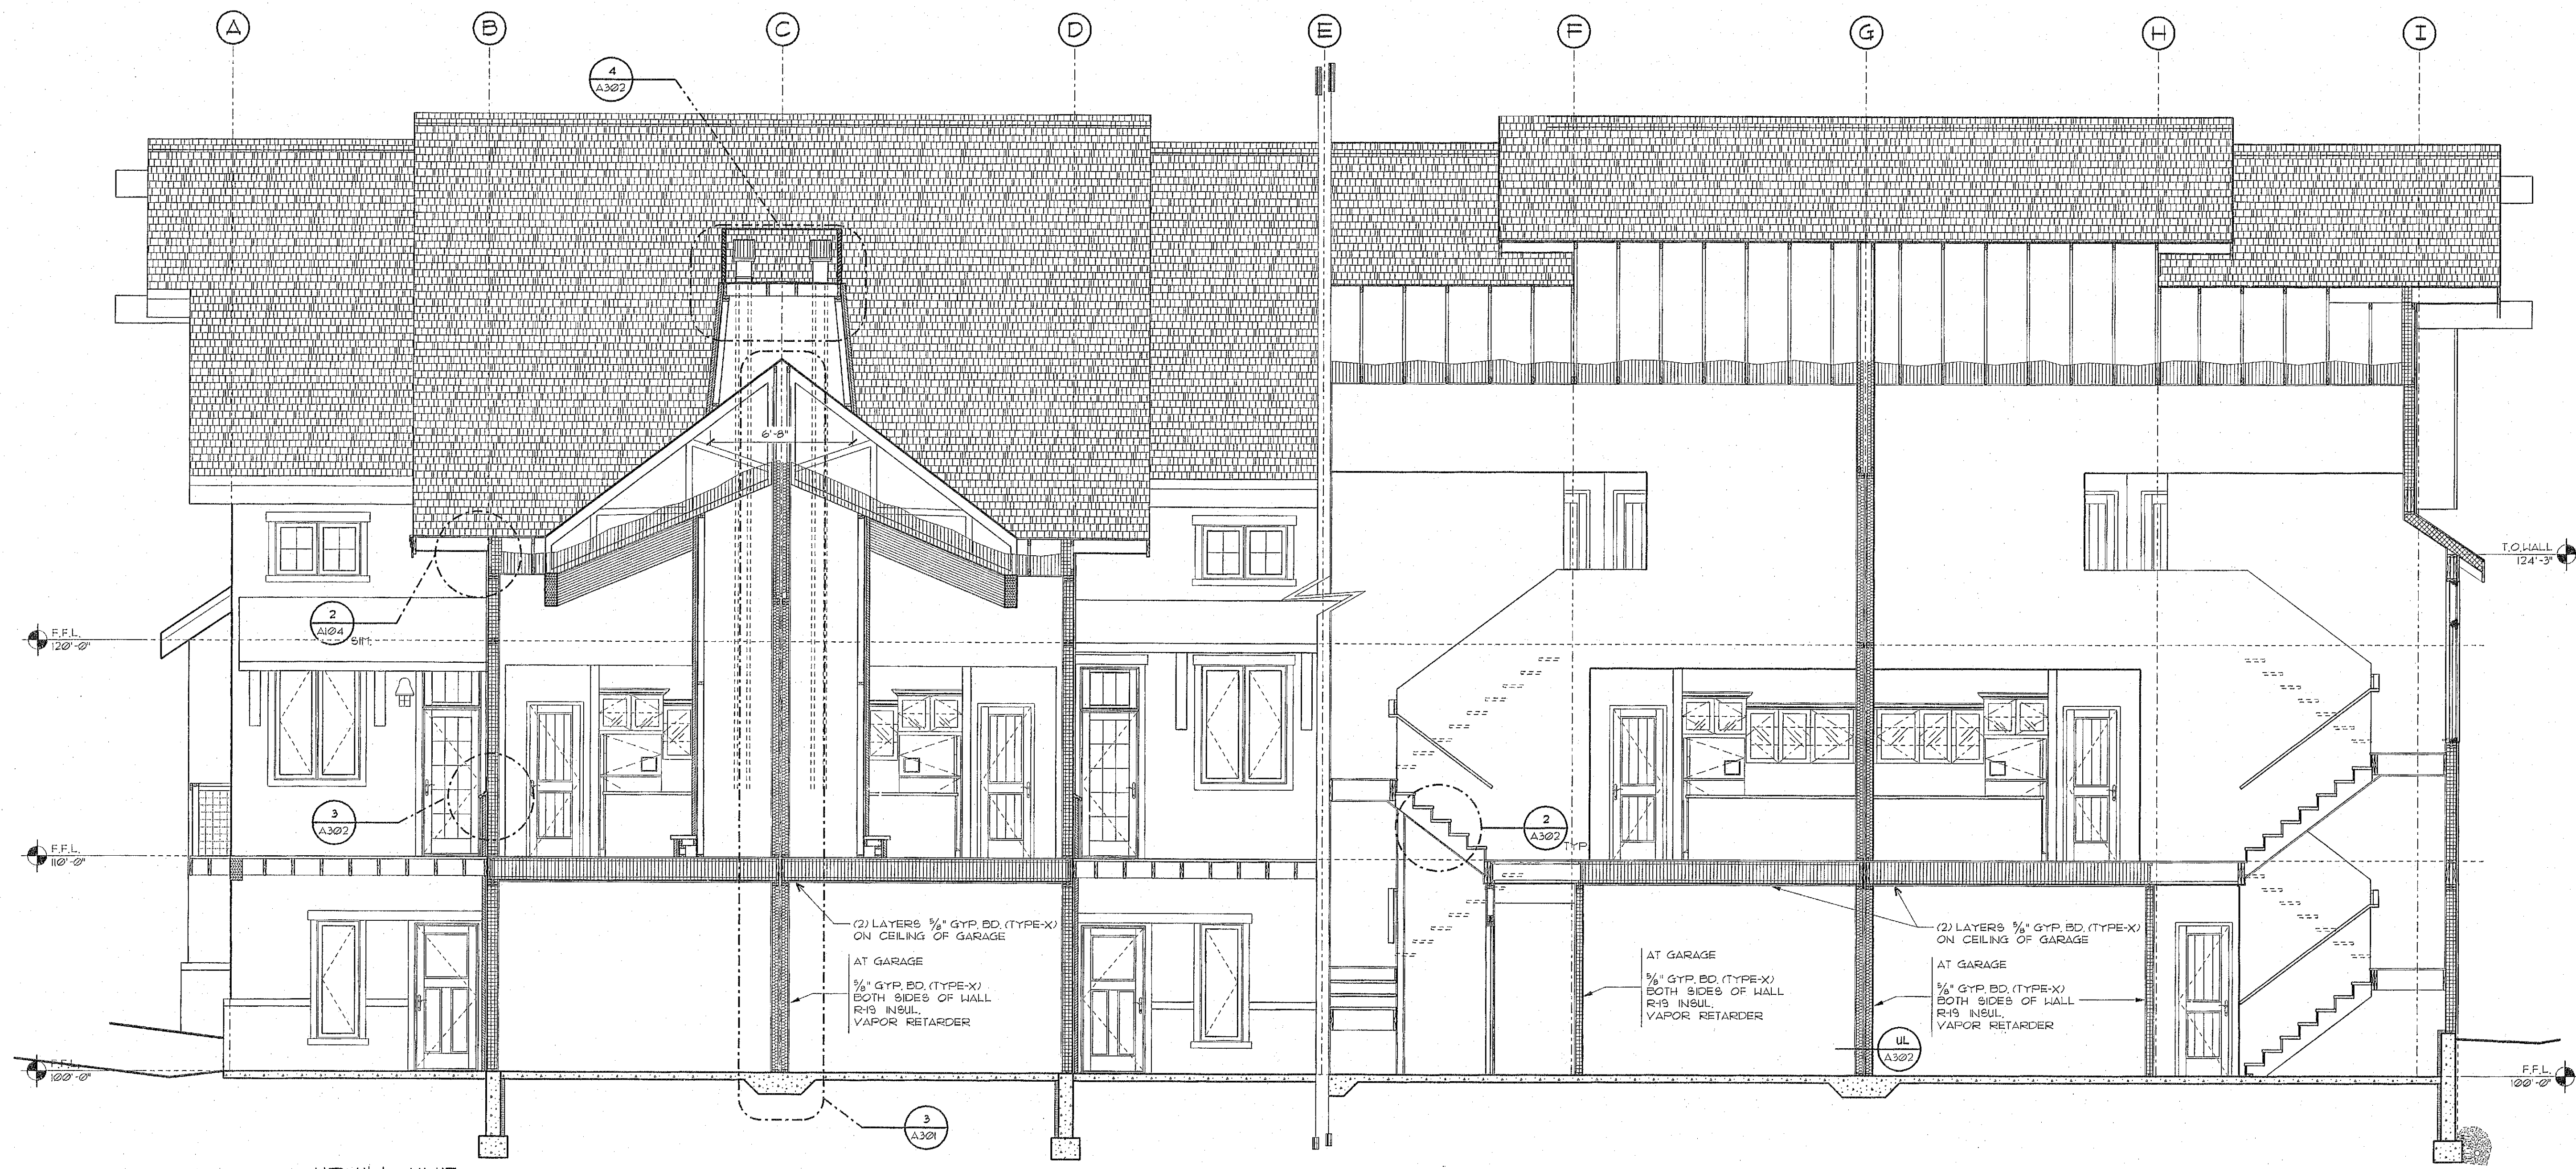


1 UPHILL UNIT
BLDG SECTION 2
SCALE: 1/4" = 1'-0"


20'-0"
10'-0"
5'-0"
0

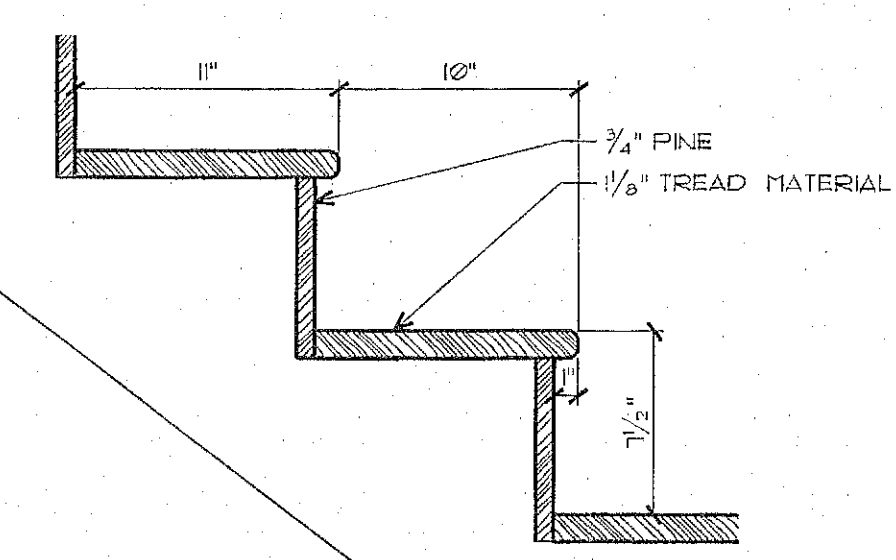


2 TYPICAL STAIR SECTION
SCALE: 1/2" = 1'-0"

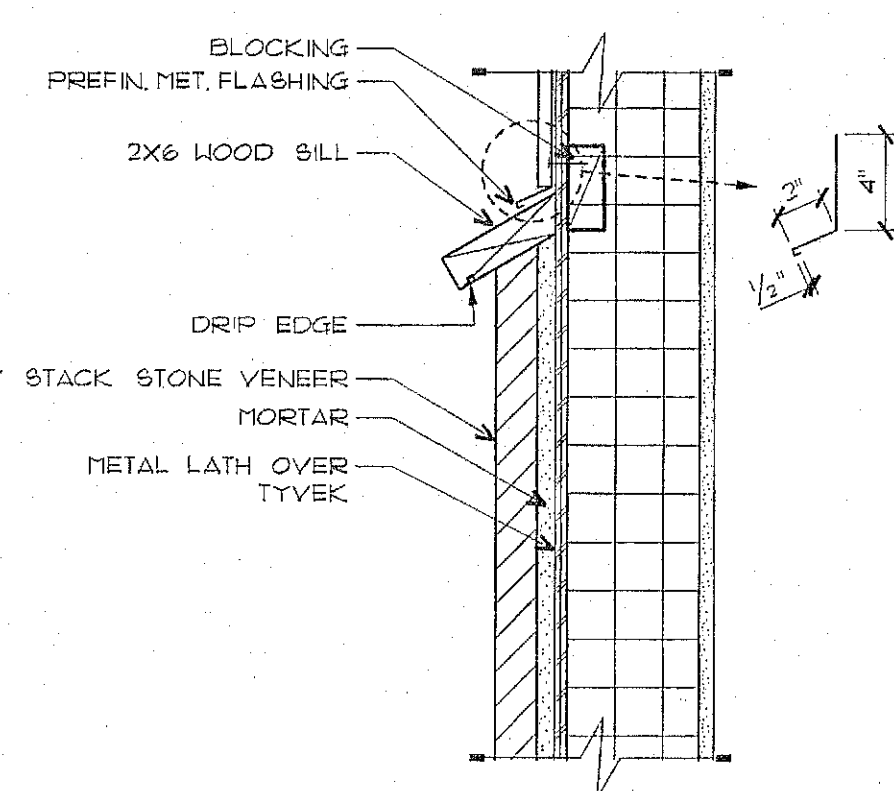

3 TYPICAL WOOD SILL
& DRY STACK VENEER
SCALE: 1/2" = 1'-0"

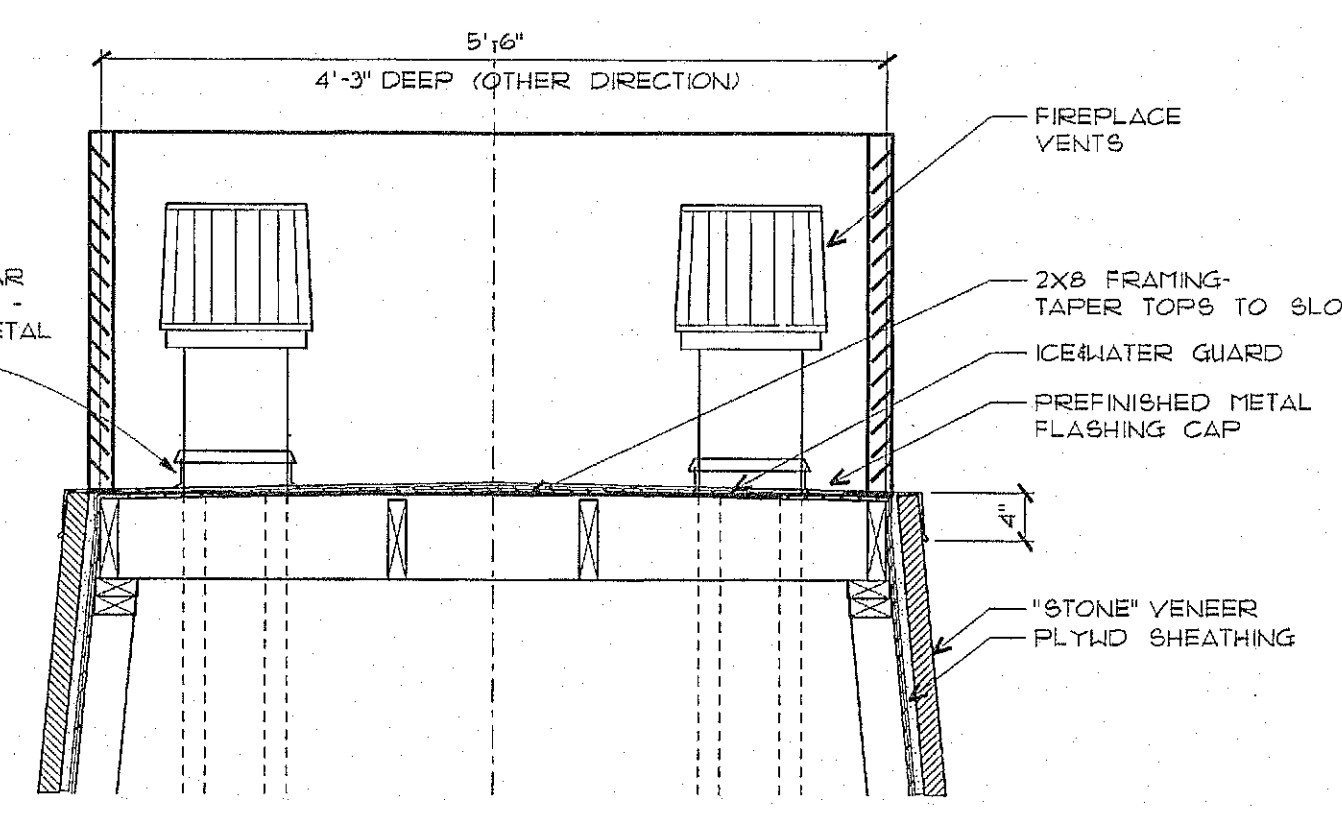

4 SECTION THRU VENT STACK
SCALE: 3/4" = 1'-0"

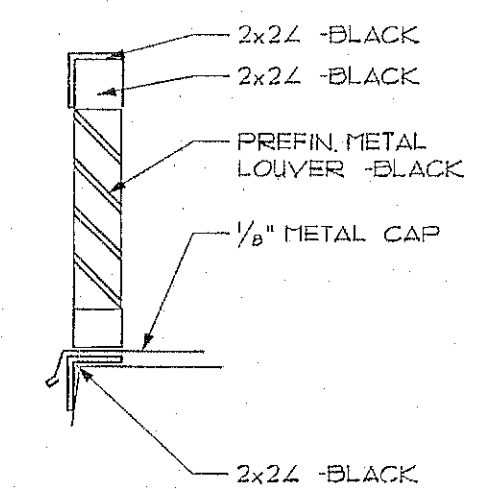

UL UL 1-HOUR ASSEMBLY
SCALE: N/A

UPHILL UNIT
Drawing No. UPA
Revised 9/1/04
Project No. 03-001
Scale: 1/4" = 1'-0"

1. Wood framing shall be 2x4 or 2x6 as indicated on drawings. All framing shall be kiln-dried to a maximum moisture content of 19%.

2. All exterior walls shall be constructed of 2x4 or 2x6 framing with 1/2 inch mineral wool insulation. All interior walls shall be constructed of 2x4 or 2x6 framing with 1/2 inch mineral wool insulation.

3. All exterior walls shall be finished with 1/2 inch stucco over 1/2 inch metal lath. All interior walls shall be finished with 1/2 inch drywall.

4. All exterior walls shall be finished with 1/2 inch stone veneer over 1/2 inch metal lath. All interior walls shall be finished with 1/2 inch drywall.

5. All exterior walls shall be finished with 1/2 inch stone veneer over 1/2 inch metal lath. All interior walls shall be finished with 1/2 inch drywall.

6. All exterior walls shall be finished with 1/2 inch stone veneer over 1/2 inch metal lath. All interior walls shall be finished with 1/2 inch drywall.


7. All exterior walls shall be finished with 1/2 inch stone veneer over 1/2 inch metal lath. All interior walls shall be finished with 1/2 inch drywall.

8. All exterior walls shall be finished with 1/2 inch stone veneer over 1/2 inch metal lath. All interior walls shall be finished with 1/2 inch drywall.

9. All exterior walls shall be finished with 1/2 inch stone veneer over 1/2 inch metal lath. All interior walls shall be finished with 1/2 inch drywall.

10. All exterior walls shall be finished with 1/2 inch stone veneer over 1/2 inch metal lath. All interior walls shall be finished with 1/2 inch drywall.

5'-0" 0 5'-0" 10'-0" 20'-0"

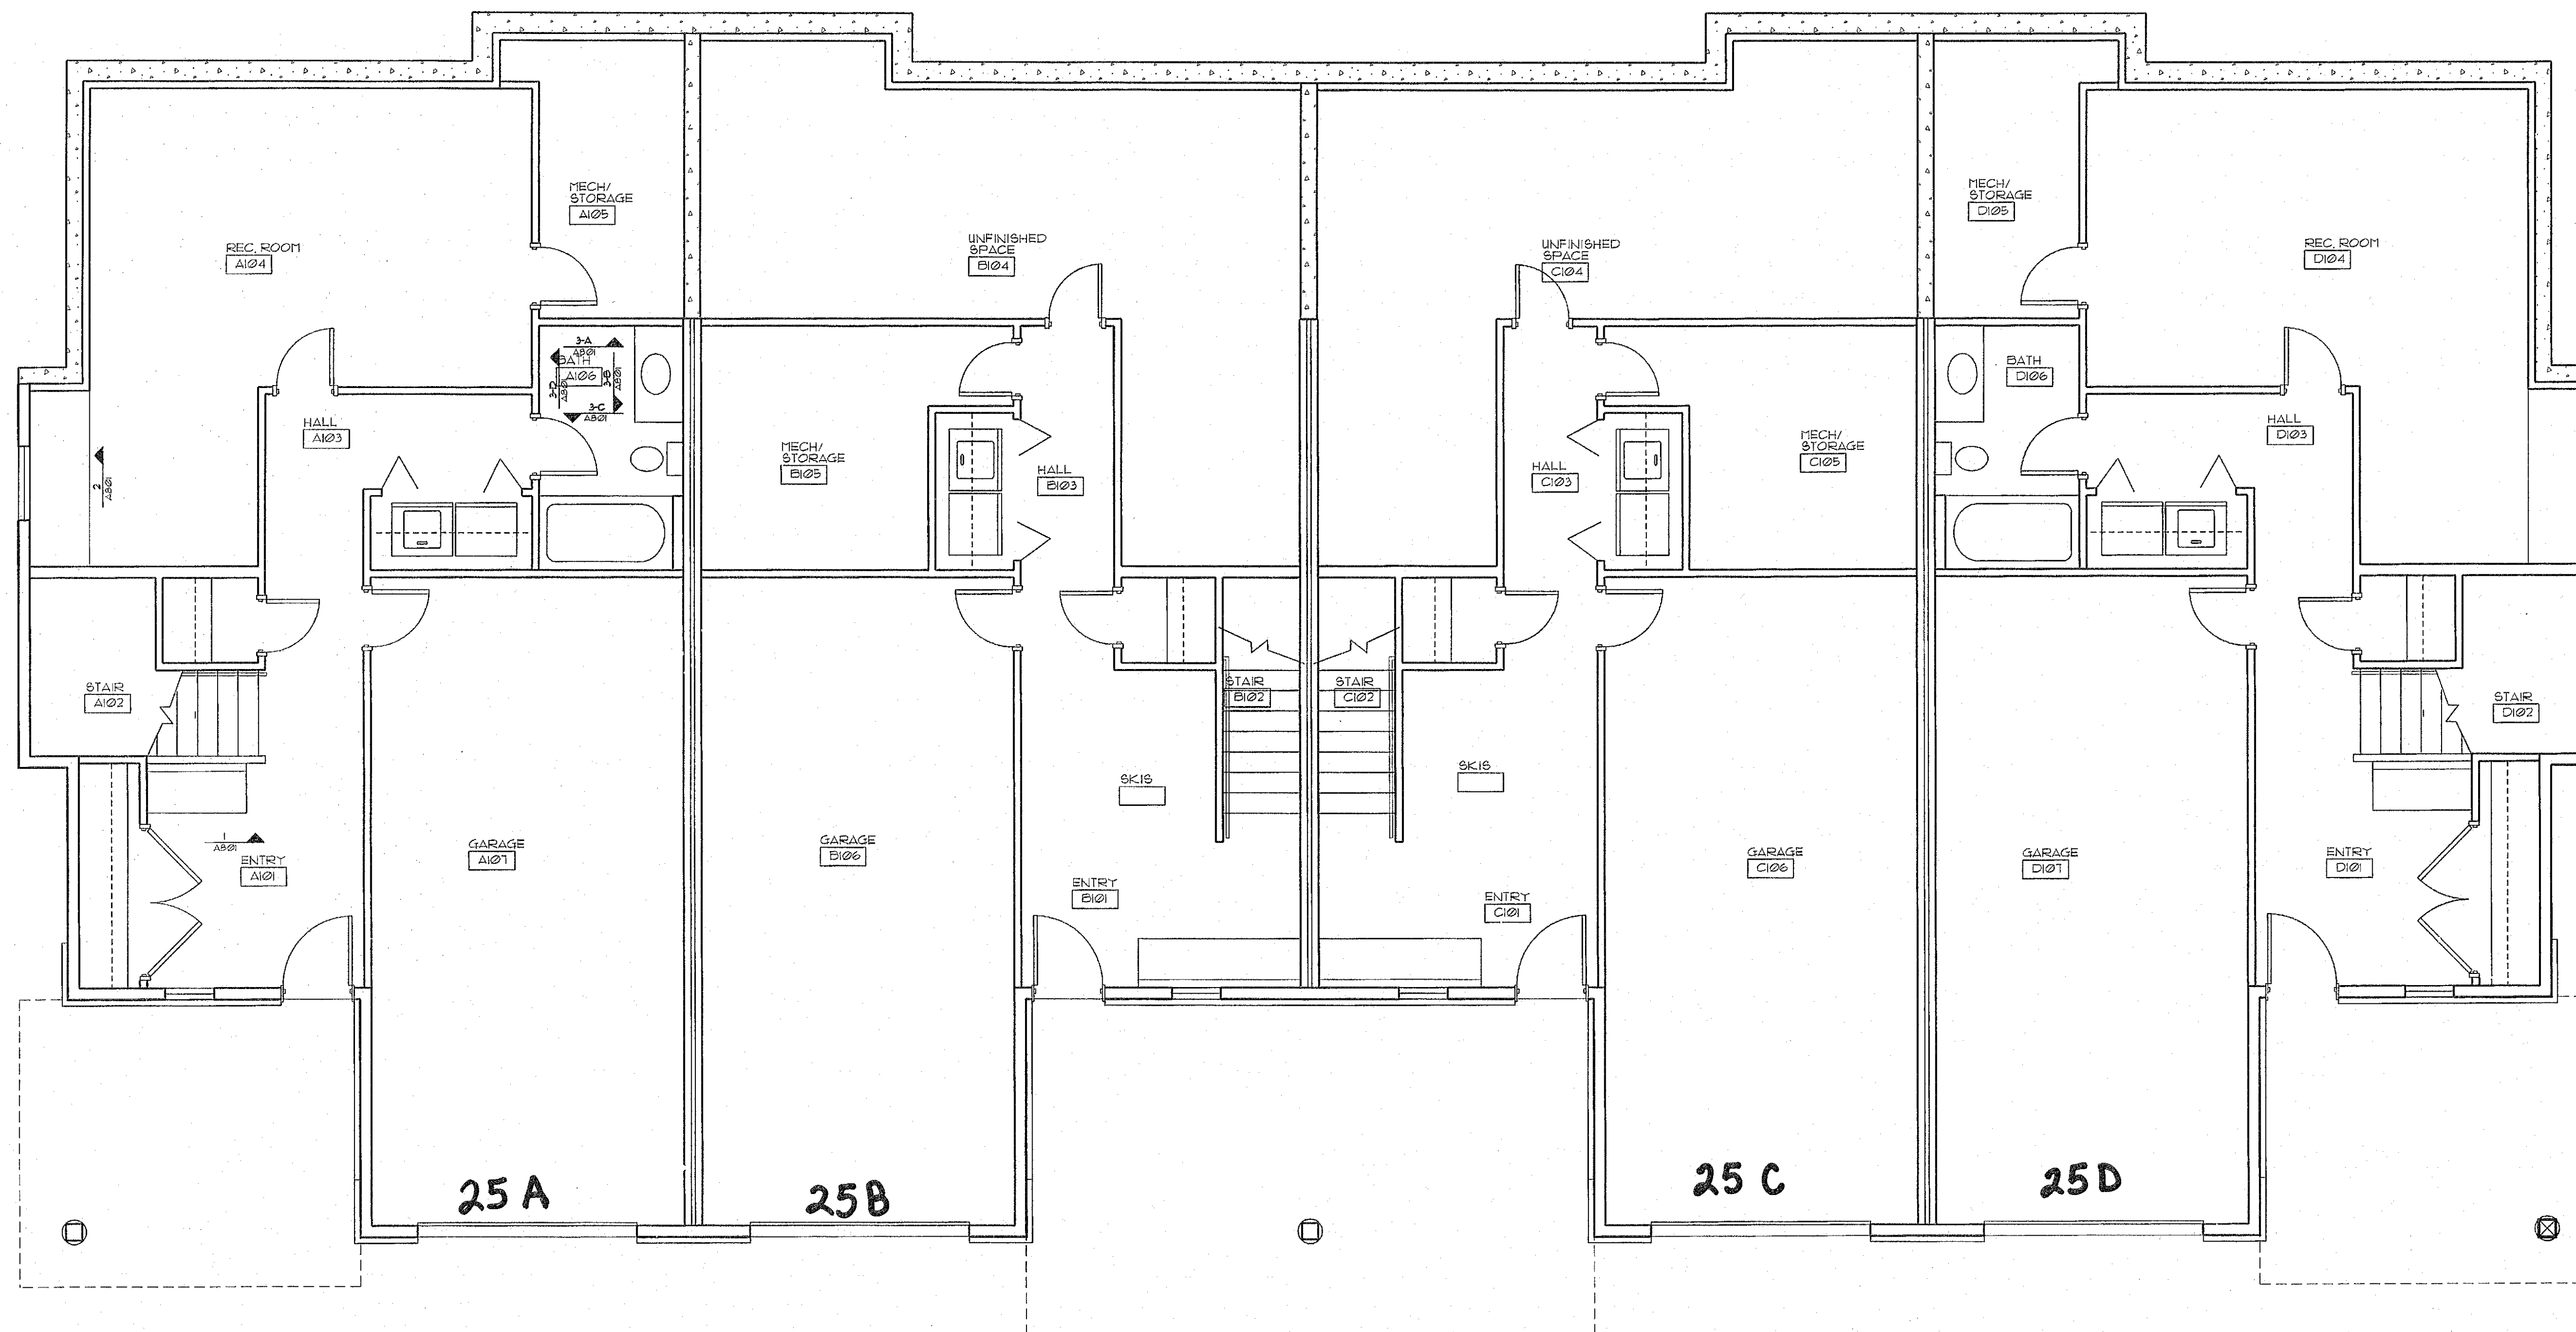

UPHILL UNIT
FIRST FLOOR FINISH PLAN
SCALE: 1/8" = 1'-0"

REVISIONS:

ALPENGLOW at Big Sky
BIG SKY, MT
Uphill Unit

AS-BUILTS

COPYRIGHT 2003
CTA
ARCHITECTS
ENGINEERS
BILLINGS • MISSOULA
BOISE • GREAT FALLS
HELENA • KALISPELL
SPOKANE
ALL RIGHTS RESERVED

DRAWN BY: JFP
CHECKED BY: SB
DATE: 9-1-04
CTA # MAUS
CADD FILE: UPAS01
DIR: KAMAUB


CTA
ARCHITECTS
ENGINEERS
BILLINGS • MISSOULA
BOISE • GREAT FALLS
HELENA • KALISPELL
SPOKANE

UPHILL
UNIT
1ST FLOOR
FINISH PLAN

SHEET

A501 OF

5'-0" 0 5'-0" 10'-0" 20'-0"

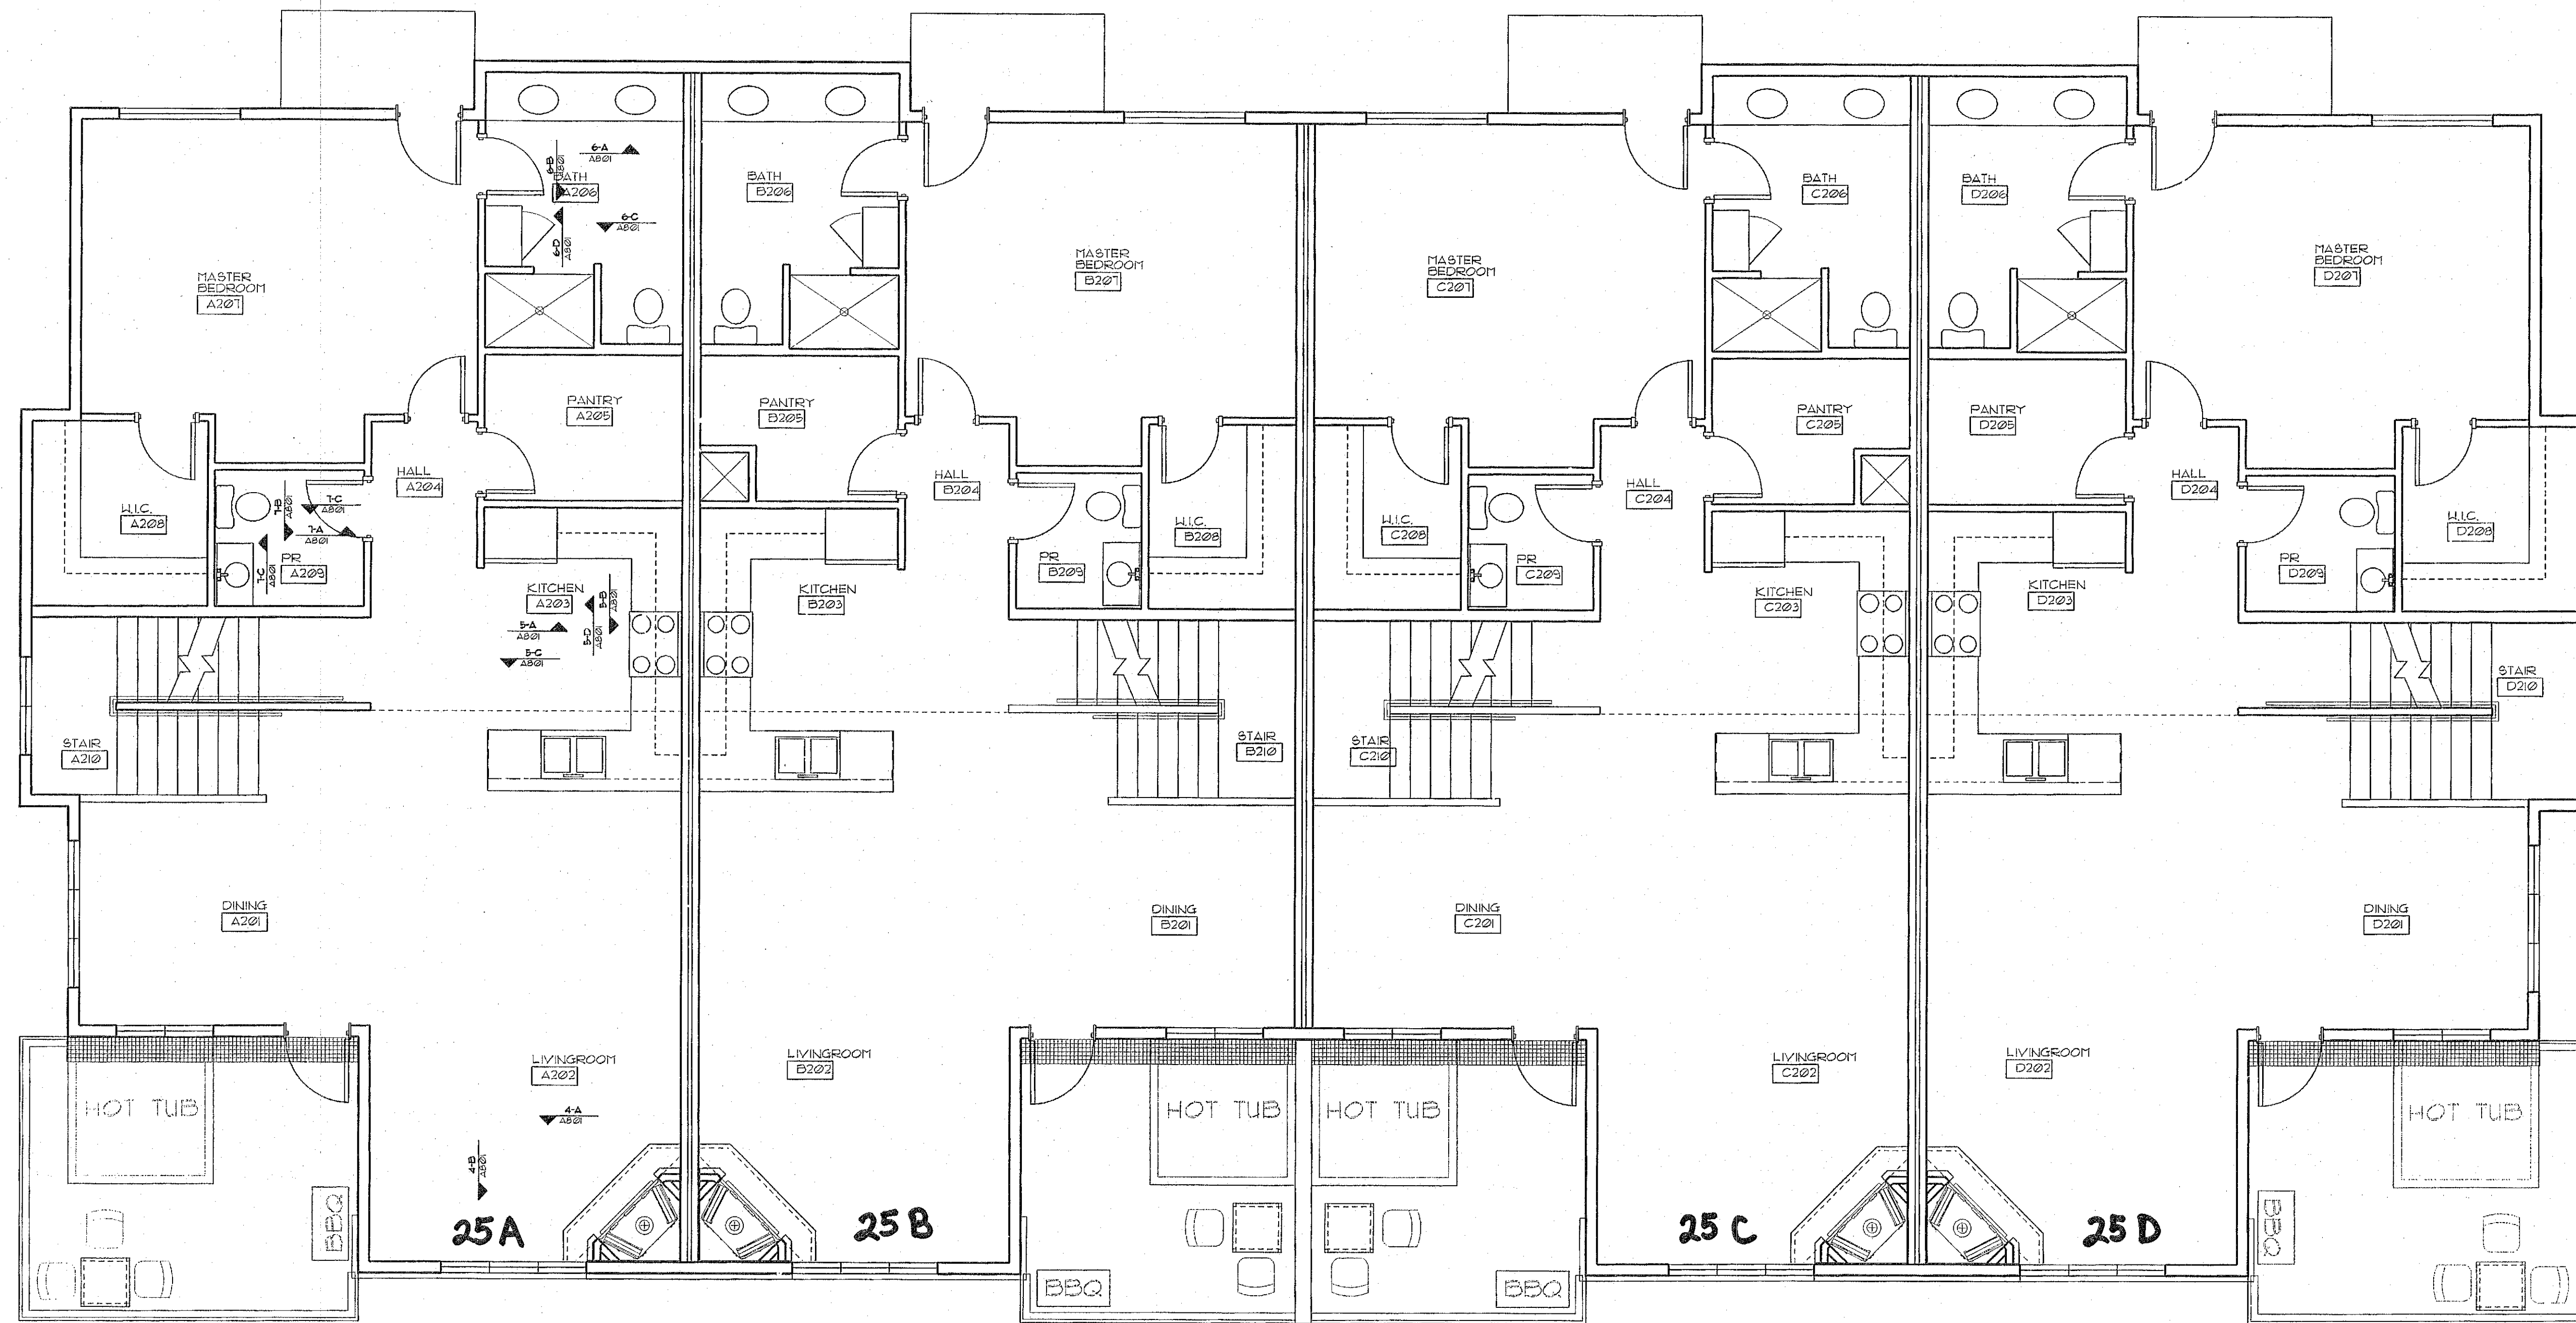

UPHILL UNIT
SECOND FLOOR FINISH PLAN
SCALE: 1/8" = 1'-0"

REVISIONS:

ALPENGLOW at Big Sky
BIG SKY, MT
Uphill Unit

AS-BUILTS

COPYRIGHT 2003
CTA
ARCHITECTS
ENGINEERS
BILLINGS • MISSOULA
BOISE • GREAT FALLS
HELENA • KALISPELL
SPOKANE
ALL RIGHTS RESERVED


DRAWN BY: JFP
CHECKED BY: SB
DATE: 9-1-04
CTA #: MAUS
CADD FILE: UPAS02
DIR: KMAUS

CTA
ARCHITECTS
ENGINEERS
BILLINGS • MISSOULA
BOISE • GREAT FALLS
HELENA • KALISPELL
SPOKANE

UPHILL
UNIT
2ND FLOOR
FINISH PLAN

SHEET

A502 OF

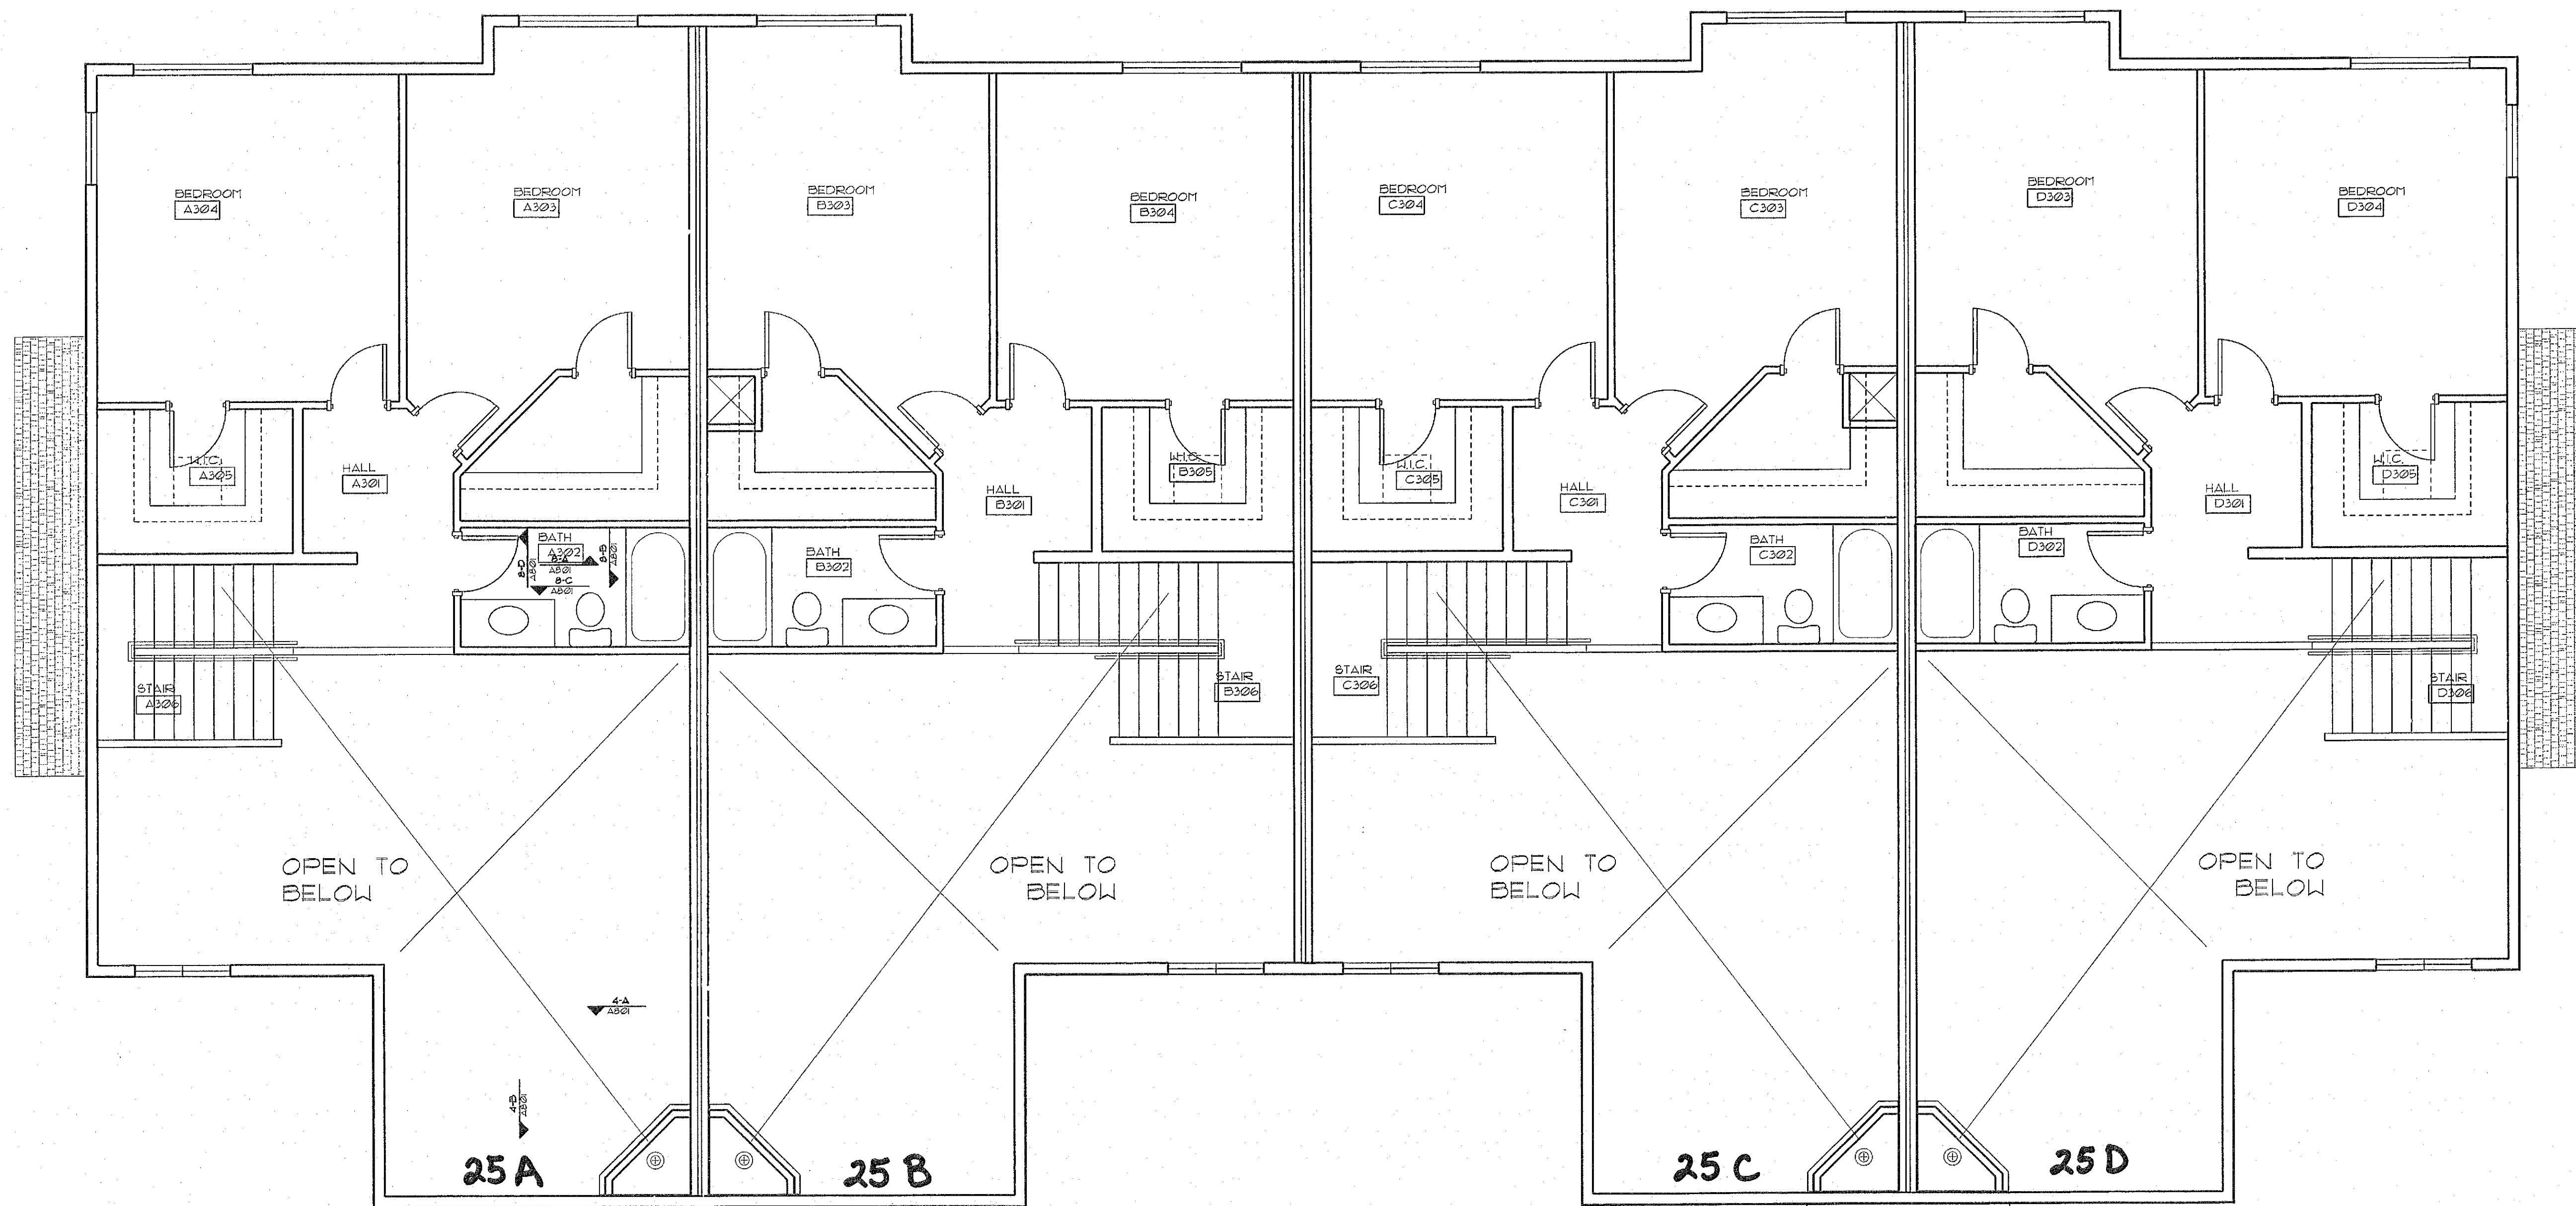

1
A503

UPHILL UNIT
THIRD FLOOR FINISH PLAN

SCALE: 1/8" = 1'-0"



REVISIONS:

ALPENGLOW at Big Sky
BIG SKY, MT
Uphill Unit

AS-BUILTS

COPYRIGHT 2003
CTA
ARCHITECTS
ENGINEERS
BILLINGS • MISSOULA
BOISE • GREAT FALLS
HELENA • KALISPELL
SPOKANE
ALL RIGHTS RESERVED

DRAWN BY: JFP
CHECKED BY: SB
DATE: 9-1-04
CTA # 14115
CADD FILE: UPAS03
DIR: K:\14115\

CTA
ARCHITECTS
ENGINEERS
BILLINGS • MISSOULA
BOISE • GREAT FALLS
HELENA • KALISPELL
SPOKANE

UPHILL
UNIT
3rd FLOOR
FINISH PLAN

SHEET

A503 OF

5'-0" 0 5'-0" 10'-0" 20'-0"

DOOR, FRAME, HARDWARE SCHEDULE

DOOR NUMBER	DOOR NUMBER	DOOR NUMBER	DOOR NUMBER	ROOM NAME	DOOR								FRAME					NOTES	FIRE RATING	HARDWARE													
					SIZE			MTL	TYPE	GLASS	NOTES	MTL	TYPE	GLASS	DETAILS					NOTES	THRES	HINGE	LOCK	CYLIND	PUSH PULL	CLOSE	STOP HOLD	MISC	LTHR	NOTES	KEY		
					W	H	T								HEAD	JAMB	SILL																
A101-1	B101-1	C101-1	D101-1	ENTRY	3'-0"	6'-8"	1 3/4"									/	/	/															
A101-2			D101-2	ENTRY	6'-0"	6'-8"	1 3/4"									/	/	/															
A103-1	B103-1	C103-1	D103-1	HALL	2'-6"	6'-8"	1 3/4"									/	/	/															
A103-2	B103-2	C103-2	D103-2	HALL	5'-8"	6'-8"	1 3/4"									/	/	/															
A104-1	B104-1	C104-1	D104-1	REC/ UNFINISH	2'-6"	6'-8"	1 3/4"									/	/	/															
A105-1	B105-1	C105-1	D105-1	MECH/ STORAGE	2'-6"	6'-8"	1 3/4"									/	/	/															
A106-1			D106-1	BATHROOM	2'-6"	6'-8"	1 3/4"									/	/	/															
A107-1	B106-1	C106-1	D107-1	GARAGE	3'-0"	6'-8"	1 3/4"				1					/	/	/		6011					X			X					
A107-2	B106-2	C106-2	D107-2	GARAGE	3'-0"	6'-0"	1 3/4"									/	/	/															
A201-1	B201-1	C201-1	D201-1	DINING	2'-8"	6'-8"	1 3/4"									/	/	/															
A205-1	B205-1	C205-1	D205-1	PANTRY	2'-6"	6'-8"	1 3/4"									/	/	/															
A206-1	B206-1	C206-1	D206-1	BATHROOM	2'-6"	6'-8"	1 3/4"									/	/	/															
A207-1	B207-1	C207-1	D207-1	MASTER BED	2'-6"	6'-8"	1 3/4"									/	/	/															
A207-2	B207-2	C207-2	D207-2	MASTER BED	3'-0"	6'-8"	1 3/4"									/	/	/															
A208-1	B208-1	C208-1	D208-1	WALK-IN	2'-6"	6'-8"	1 3/4"									/	/	/															
A209-1	B209-1	C209-1	D209-1	POWDER ROOM	2'-6"	6'-8"	1 3/4"									/	/	/															
																/	/	/															
A302-1	B302-1	C302-1	D302-1	BATHROOM	2'-6"	6'-8"	1 3/4"									/	/	/															
A303-1	B303-1	C302-1	D302-1	BEDROOM	2'-6"	6'-8"	1 3/4"									/	/	/															
A303-2	B303-2	C303-2	D303-1	BEDROOM	2'-6"	6'-8"	1 3/4"									/	/	/															
A304-1	B304-1	C304-1	D304-1	BEDROOM	2'-6"	6'-8"	1 3/4"									/	/	/															
A305-1	B305-1	C305-1	D305-1	WALK-IN	2'-6"	6'-8"	1 3/4"									/	/	/															
							1 3/4"									/	/	/															

DOOR SCHEDULE NOTES:

1. 1-HOUR RATED W/ SMOKE SEALS & SPRING HINGES

WINDOW SCHEDULE

WINDOW NUMBER	CATALOG NUMBER	WINDOW TYPE	# OF EACH	ROUGH OPENING		ROUGH OPENING/ HEAD HT. A.F.F.	DETAIL NUMBER			HARDWARE	REMARKS
				WIDTH	HEIGHT		HEAD	JAMB	SILL		
A.	2466-1	NORCO	4.	2'-0 3/4"	5'-0 1/2"	7'-0 1/2"	/	/	/		
B.	3642-1	NORCO	4.	3'-0 3/4"	3'-6 1/2"	7'-0 1/2" *	/	/	/		* 1ST FLOOR WINDOWS HEAD HEIGHT TO BE 8'-3 1/2" AT ROOMS 104.
C.	2466-2	NORCO	4.	4'-0 3/4"	5'-0 1/2"	9'-0 1/2"	/	/	/		
D.	2424-3 2466-3	NORCO	6.	6'-0 3/4"	7'-6 1/2"	9'-0 1/2" *	/	/	/		* HEAD HEIGHT TO BE 10'-6" AT LIVING ROOMS.
E.	3018T-2 3036-2	NORCO	4.	5'-0 3/4"	4'-6 1/2"	8'-0 1/2"	/	/	/		
F.	2424-2 2466-2	NORCO	2.	4'-0 3/4"	7'-6 1/2"	*	/	/	/		* HEAD HEIGHT TO BE 8'-6" ABOVE STAIR LANDING.
G.	2430-2	NORCO	4.	4'-0 3/4"	2'-6 1/2"	15'-6 1/2"	/	/	/		
H.	3642-2	NORCO	8.	5'-0 3/4"	3'-6 1/2"	7'-0 1/2"	/	/	/		

ALL WINDOWS TO BE NORCO SITELINE CLAD CASEMENT WINDOW, HIGH ALTITUDE, LOW E, SGL W/ 5 3/8" JAMB & NAILING PIN.
COLOR TO BE SELECTED BY OWNER.

REVISIONS:

ALPENGLOW at Big Sky
BIG SKY, MT
Uphill Unit

AS-BUILTS

COPYRIGHT 2003
CTA
ARCHITECTS
ENGINEERS
BILLINGS • MISSOULA
BOISE • GREAT FALLS
HELENA • KALISPELL
SPOKANE

ALL RIGHTS RESERVED

DRAWN BY: JPF
CHECKED BY: SB
DATE: 9-1-04
CTA # MAUS
CADD FILE: UP460
DIR: K:\MAUS\

CTA
ARCHITECTS
ENGINEERS
BILLINGS • MISSOULA
BOISE • GREAT FALLS
HELENA • KALISPELL
SPOKANE

UPHILL
UNIT
WINDOW &
DOOR TYPES

SHEET

A601 OF

REVISIONS:

ALPENGLOW at Big Sky
BIG SKY, MT
Uphill Unit

AS-BUILTS

COPYRIGHT 2003
CTA
ARCHITECTS
ENGINEERS
BILLINGS • MISSOULA
BOISE • GREAT FALLS
HELENA • KALISPELL
SPOKANE
ALL RIGHTS RESERVED


DRAWN BY: JPP
CHECKED BY: SB
DATE: 9-1-04
CTA # MAJUS
CADD FILE: UPAB01
DIR: KATAUSA

CTA
ARCHITECTS
ENGINEERS
BILLINGS • MISSOULA
BOISE • GREAT FALLS
HELENA • KALISPELL
SPOKANE


UPHILL
UNIT
INTERIOR
ELEVATIONS

SHEET


A801 OF

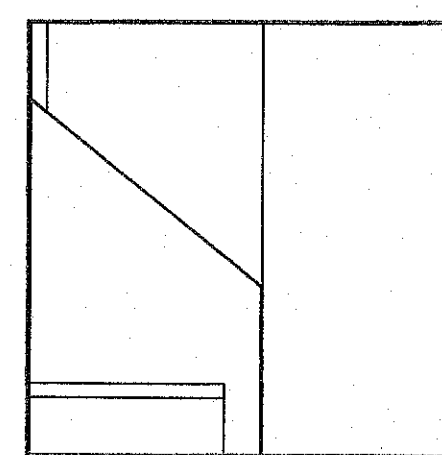





1 ENTRY
A801 A201 SCALE: 1/4" = 1'-0"

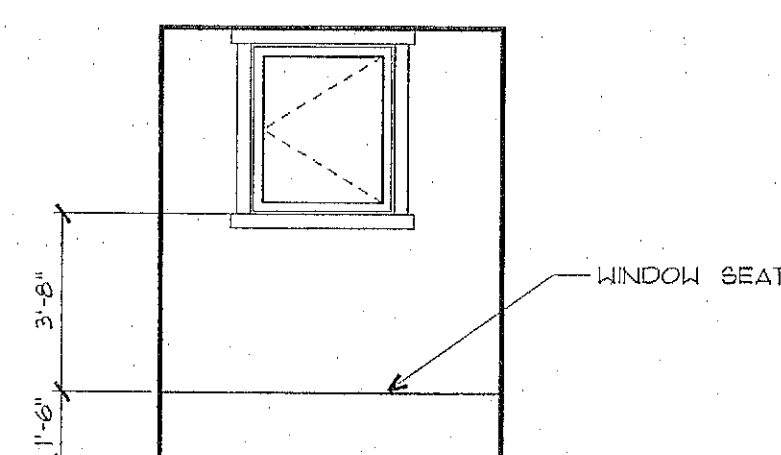



2 REC ROOM
A801 A206 SCALE: 1/4" = 1'-0"

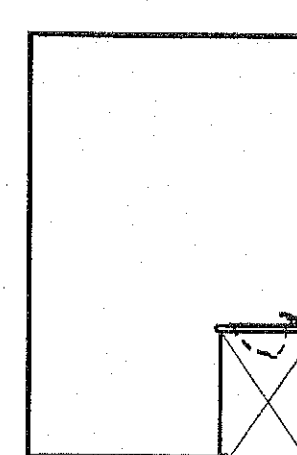





3 BATHROOM
A801 A206 SCALE: 1/4" = 1'-0"

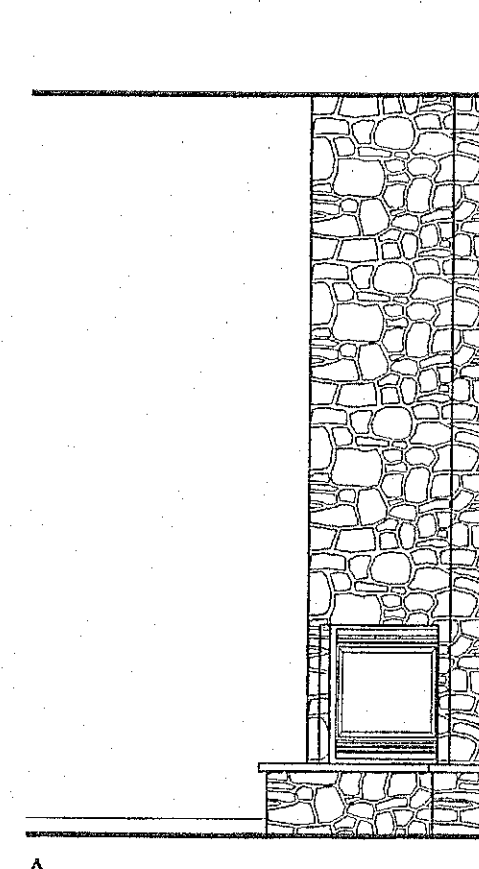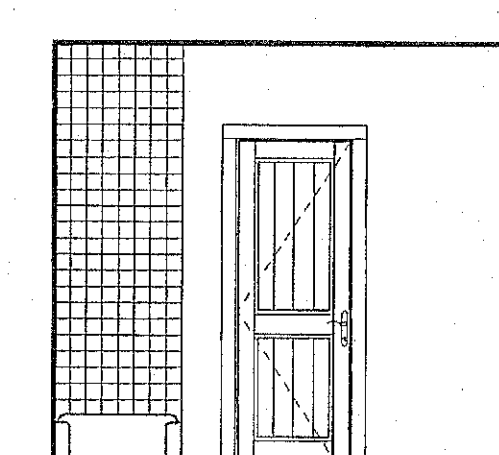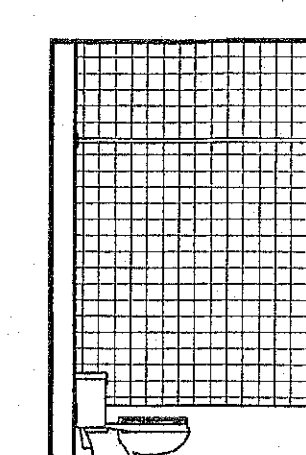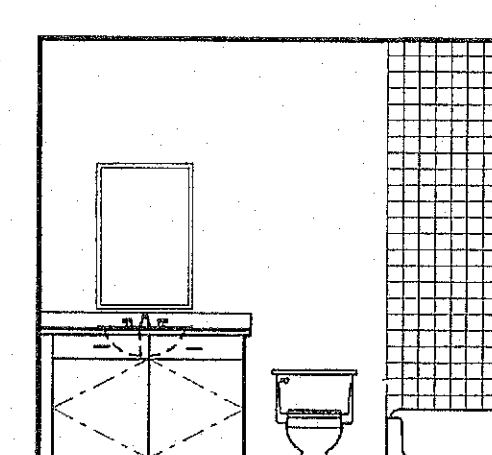








4 LIVING
A801 A202 SCALE: 1/4" = 1'-0"

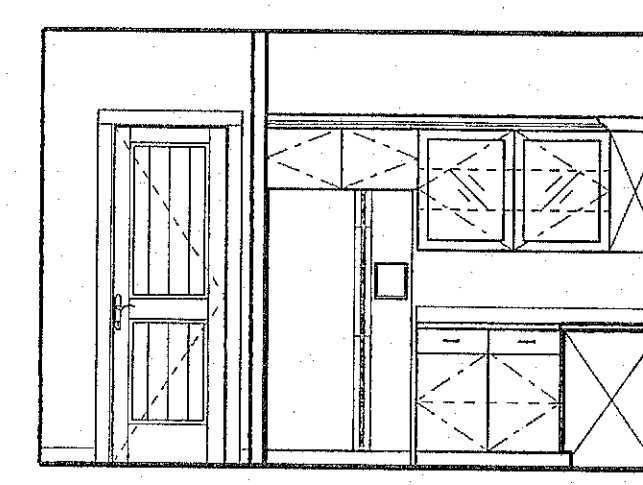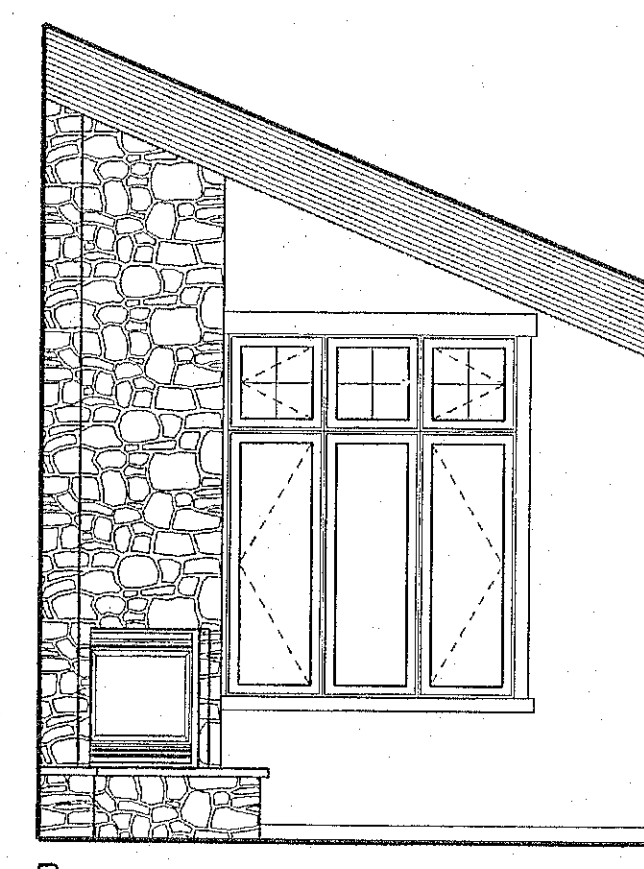


5 KITCHEN
A801 A203 SCALE: 1/4" = 1'-0"

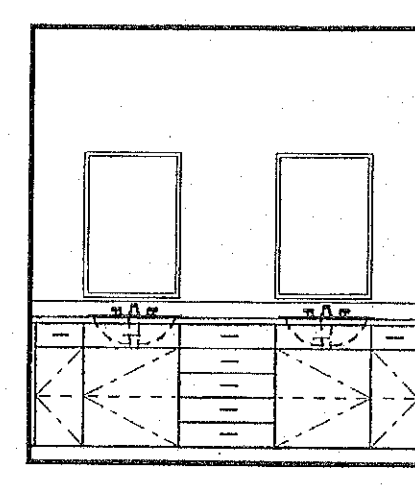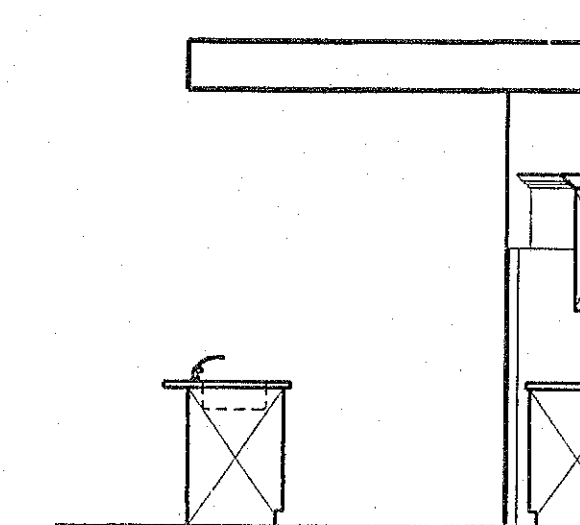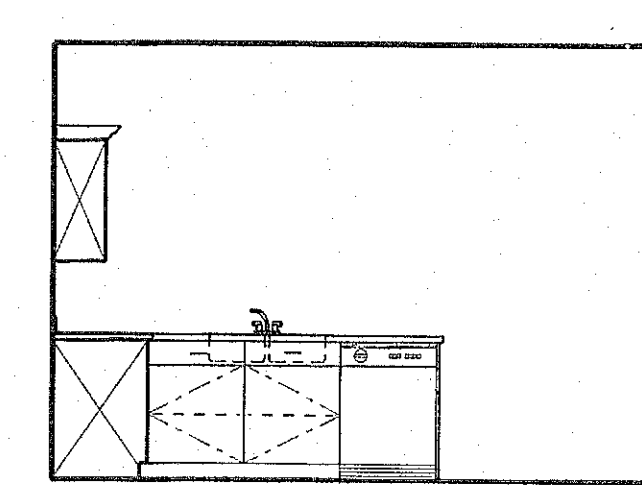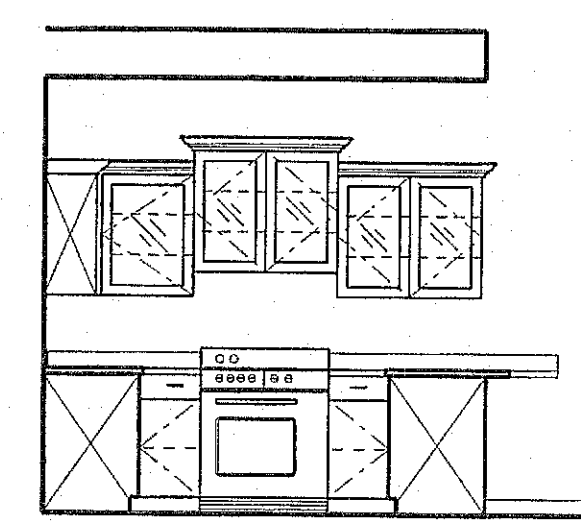




6 BATHROOM
A801 A206 SCALE: 1/4" = 1'-0"

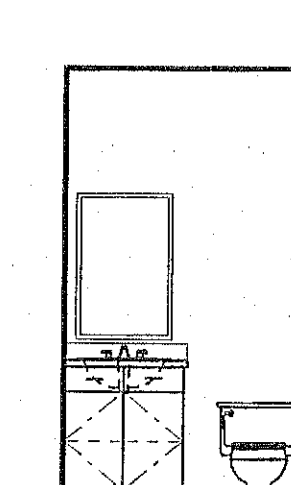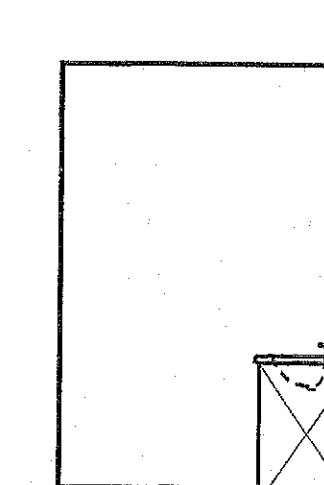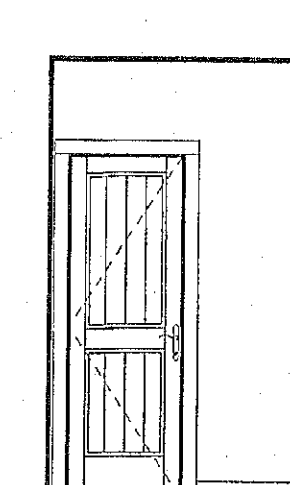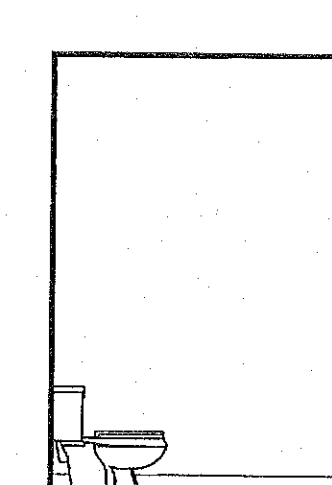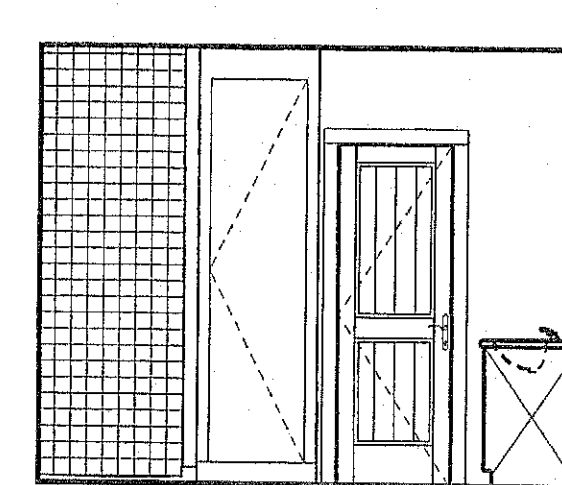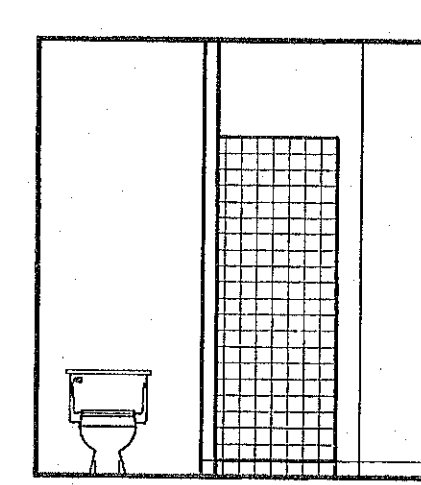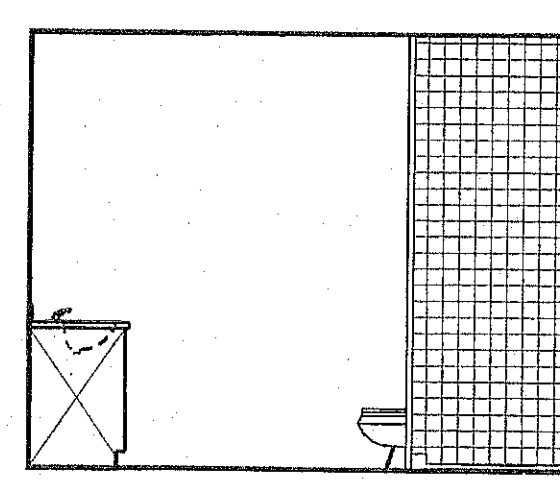

7 BATHROOM
A801 A206 SCALE: 1/4" = 1'-0"

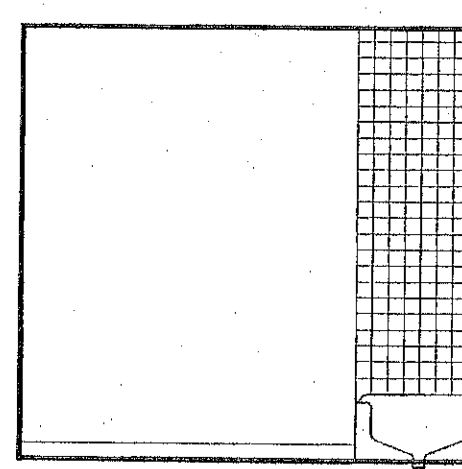

8 BATHROOM
A801 A202 SCALE: 1/4" = 1'-0"

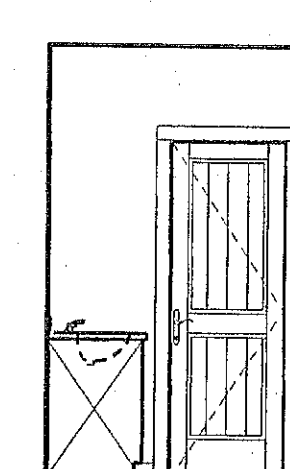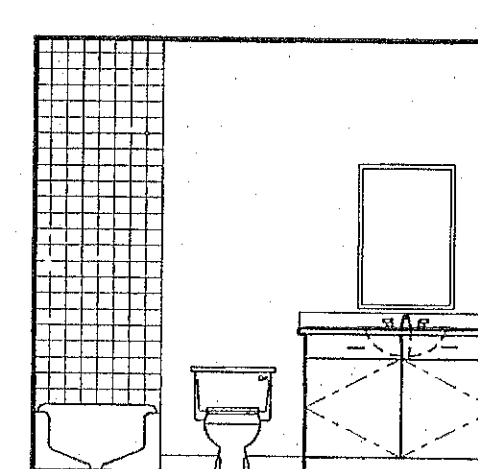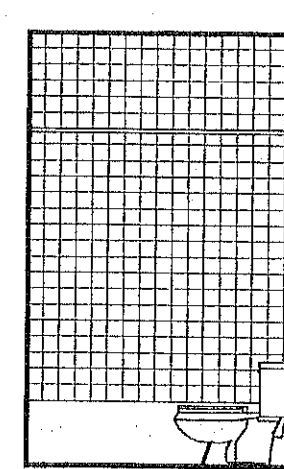

A. GOVERNING CODES

- 1) INTERNATIONAL BUILDING CODE (IBC), 2000 EDITION
- 2) BUILDING CODE REQUIREMENTS FOR STRUCTURAL CONCRETE, ACI 318-02
- 3) LRFD DESIGN SPECIFICATIONS FOR STRUCTURAL STEEL BUILDINGS, AISC 1995 EDITION
- 4) NATIONAL DESIGN SPECIFICATION FOR WOOD CONSTRUCTION, NDS 1995 EDITION.

B. DESIGN LOADS AND CRITERIA

1) GRAVITY LOADS (PSF):

ROOF DEAD LOAD SNOW LOAD
15 155 + DRIFT

SNOW CRITERIA: GROUND SNOW LOAD = 151 PSF, $S_g = 1.00$
EXPOSURE FACTOR $C_e = .7$, $C_t = 1.00$

FLOOR DEAD LOAD LIVE LOAD
10 40

DECK 5# 155 + DRIFT

000 IBC, * INCLUDE HOT TUB HEIGHT SEPARATELY

2) WIND CRITERIA:

3 SEC GUST WIND SPEED = 100 MPH
FASTEST MILE WIND SPEED = 80 MPH
BUILDING CATEGORY: ENCLOSED
III = 1.00 / EXPOSURE C
INTERNAL PRESSURE COEFFICIENT: 0.10 +/-
20 PSF MINIMUM FOR EXTERNAL WALL COMPONENTS & CLADDING
10 PSF MINIMUM NET UPLIFT FOR STEEL ROOF JOIST

3) SEISMIC CRITERIA:

SITE CLASS D
 $S_{DS} = 0.811$ / $S_{D1} = 0.3603$
IE = 1.00 / USE GROUP I
DESIGN CATEGORY D
ANALYSIS PROCEDURE: EQUIVALENT LATERAL FORCE
DESIGN BASE SHEAR UPHILL UNIT: $V = 76$ KIPS
DESIGN BASE SHEAR DOWNHILL UNIT: $V = 54$ KIPS
LATERAL FORCE RESISTING SYSTEM:
WOOD SHEAR WALLS

4) FOOTING BEARING PRESSURE:

2000 PSF ON APPROVED SUBGRADE, SEE SECTION D.2

5) SOIL PROTECTION COEFFICIENT:

0.35

6) LATERAL SOIL PRESSURE:

45 PCF ACTIVE EQUIVALENT FLUID PRESSURE
60 PCF AT-REST EQUIVALENT FLUID PRESSURE
250 PCF PASSIVE EQUIVALENT FLUID PRESSURE
42 INCHES

7) FROST DEPTH:

42 INCHES

C. MATERIALS

1) CLASS A CONCRETE:

PORTLAND CEMENT ASTM C150 TYPE I/II
FLY ASH ASTM C618, 10% - 25% BY WEIGHT
WATER / CEMENT + FLY ASH = 0.45 MAXIMUM
28 DAY F'C = 4000 PSI
AIR CONTENT 4.5% - 7.0%
3/4" MAX NORMAL WEIGHT AGGREGATE

CLASS B CONCRETE:

PORTLAND CEMENT ASTM C150 TYPE I/II
FLY ASH ASTM C618, 10% - 25% BY WEIGHT
WATER / CEMENT + FLY ASH = 0.50 MAXIMUM
28 DAY F'C = 3000 PSI
AIR CONTENT 4.5% - 7.0% EXCEPT 3.0% MAX INTERIOR SLABS
3/4" MAX NORMAL WEIGHT AGGREGATE

2) REINFORCING BARS:

ASTM A615, GRADE 60 (WHERE INDICATED TO BE WELDED)
ASTM A106, GRADE 60 (WHERE INDICATED TO BE WELDED)
LENTON TAPERED, THREADED COUPERS AS PER ERICO
ASTM A195, PLAT SHEET MATERIAL - SMOOTH OR DEFORMED WIRE
ASTM F1554 GRADE 36 OR 55 W/ ASTM A563 HEAVY HEX NUTS
ASTM C1107, NON-METALLIC NON-SHRINK, 3 DAY F'C = 4000 PSI

3) STRUCTURAL STEEL:

W 4 HIT SHAPES
OTHER ROLLED SHAPES
ASTM A36, FY = 36 KSI
ASTM A36, FY = 36 KSI
ASTM A500, GRADE B, FY = 46 KSI
ASTM A500, GRADE B, FY = 42 KSI
ASTM A500, GRADE B, FY = 42 KSI

4) HIGH STRENGTH BOLTS:

ASTM A325 TYPE 1 UNCOATED; STEEL TO STEEL CONNECTIONS

5) BOLTS:

ASTM A307, WOOD, WOOD TO STEEL CONNECTIONS OR ERECTION ONLY

6) EXPANSION ANCHORS:

ASTM A36 SHANK W/ EXPANSION CONE SUCH AS HILTI Kwik Bolt II
OR AS APPROVED

7) ADHESIVE ANCHORS:

ASTM A36 ALL THREAD ROD W/ CHISEL POINT & INJECTABLE ADHESIVE
SUCH AS HILTI HIT HY-150 FOR CONCRETE & SOLID MASONRY OR
HIT HY-20 W/ SCREEN TUBES FOR HOLLOW MASONRY OR AS APPROVED

8) GLUE LAMINATED TIMBER:

ANSI/AITC A190.1 COMBINATION SYMBOL 24F-V4-DF/DF

9) TIMBERSTRAND LSL:

NES REPORT NO. NER-481

10) PARALLAM PSL:

NES REPORT NO. NER-481

11) FABRICATED WOOD JOISTS:

NES REPORT NO. NER-481

12) FABRICATED WOOD TRUSSES:

NES REPORT NO. NER-200

13) DIMENSION LUMBER:

ANSI/TPI 1-1995

14) WOOD SHEATHING / PANELS:

GRADED BY WESTERN WOOD PRODUCTS ASSOCIATION (WWPA)
OR WEST COAST LUMBER INSPECTION BUREAU (WCLIB)
HEM-FIR #1 UNLESS NOTED OTHERWISE
HEM-FIR #2 STUD FRAMING, PLATES & BLOCKING
AMERICAN PLYWOOD ASSOCIATION (APA) RATED
"STRUCTURAL I" OR "SHEATHING" SUITED FOR SPAN & USE

D. FOUNDATIONS

- 1) FOUNDATIONS HAVE BEEN DESIGNED BASED ON INFORMATION PRESENTED IN THE "GEOTECHNICAL INVESTIGATION REPORT" BY XX NO. XX DATED XX 2001.
- 2) BORING LOGS AND LABORATORY TEST RESULTS ARE INCLUDED FOR REFERENCE IN THE PROJECT MANUAL.
- 3) PLACE FOOTINGS ON UNDISTURBED NATURAL SOILS OR ENGINEERED FILL PLACED OVER UNDISTURBED NATURAL SOILS. ENGINEERED FILL MATERIAL SHALL BE MINUS 2" GRADED GRANULAR, APPROVED BY THE GEOTECHNICAL ENGINEER. PLACE ENGINEERED FILL IN UNIFORM LIFTS AND COMPACT TO 95% STANDARD PROCTOR ACCORDING TO ASTM D698. PLAN LIMITS OF ENGINEERED FILL MUST EXTEND AT LEAST 2'-0" BEYOND ALL FOOTING EDGES. IF ENCOUNTERED, EXISTING FILL SHALL BE REMOVED TO AN APPROVED DEPTH AND REPLACED WITH ENGINEERED FILL AS DESCRIBED ABOVE, PLACED AND COMPACTED AS DESCRIBED ABOVE.
- 4) PLACE INTERIOR SLABS ON GRADE ON CRUSHED, MINUS 3/4" DRAINAGE COURSE, GRADED FOR CONTRACTION WITH LESS THAN 5% PASSING THE #200 SIEVE. PLACE DRAINAGE COURSE ON A VAPOR RETARDER, WHERE INDICATED ON PLAN, ON NATURAL SOILS OR ENGINEERED FILL PLACED OVER UNDISTURBED NATURAL SOILS, COMPACT SOILS UNDER SLABS (ABOVE FOOTINGS) TO 95% STANDARD PROCTOR ACCORDING TO ASTM D698.
- 5) DO NOT BACKFILL WALLS WITH UNBALANCED SOIL. LEVELS UNLESS ADEQUATELY SHORED OR PERMANENT FLOOR PLATES ARE INSTALLED AND CONNECTIONS ARE COMPLETE - THIS DOES NOT INCLUDE RETAINING WALLS. THE CONTRACTOR IS RESPONSIBLE FOR TEMPORARY SHORING DESIGN AND INSTALLATION.
- 6) BACKFILL AND COMPACT BURIED WALLS OR GRADE BEAMS EVENLY ON EACH SIDE TO AVOID UNBALANCED LOADS, COMPACT LAYERS TO 95% STANDARD PROCTOR ACCORDING TO ASTM D698 EXCEPT 92% UNDER NON-PAVED AREAS.
- 7) ALWAYS PROVIDE POSITIVE SURFACE WATER DRAINAGE AWAY FROM THE STRUCTURE.

E. CONCRETE

- 1) PERFORM CONCRETE WORK IN ACCORDANCE WITH ACI 301-99 "STANDARD SPECIFICATION FOR STRUCTURAL CONCRETE" UNLESS MORE STRINGENT REQUIREMENTS ARE INDICATED.
- 2) MINIMUM REINFORCING BAR COVER FOR CAST-IN-PLACE CONCRETE:
3" AT UNFORMED SURFACES CAST AGAINST AND EXPOSED TO EARTH
2" AT FORMED SURFACES EXPOSED TO EARTH OR WEATHER FOR #6 AND LARGER
1 1/2" AT FORMED SURFACES, EXPOSED TO EARTH OR WEATHER FOR #3-#5 AND, NOT EXPOSED TO EARTH OR WEATHER FOR REINFORCEMENT OF BEAMS OR COLUMNS
1" AT SLABS OR WALLS NOT EXPOSED TO EARTH OR WEATHER
- 3) SPLICE REINFORCING BARS BY LAPPING ACCORDING TO THE SCHEDULE INDICATED. SPLICE W/IF SHEETS BY LAPPING AT LEAST ONE PANEL WIDTH (TWO LONGITUDINAL BARS IN CONTACT) OR 10 INCHES MINIMUM. PLACE MECHANICAL CONNECTORS WHERE SHOWN.
- 4) ADD #5X6'-0" DIAGONAL EACH FACE AT ALL OPENING CORNERS AND #5X6'-0" DIAGONAL MID-DEPTH AT ALL RE-ENTRANT SLAB CORNERS UNLESS SHOWN OTHERWISE.
- 5) SECURE ALL REINFORCING, INCLUDING W/IF, IN POSITION WITH CHAIRS BEFORE CONCRETE PLACEMENT. CONCRETE DOBIES MAY BE USED TO POSITION SLAB ON GRADE REINFORCEMENT.
- 6) TIE DOUBELS IN PLACE BEFORE PLACING CONCRETE. DO NOT STAB OR "HIT-SET" DOUBELS.
- 7) INSTALL AND SECURE EMBEDMENTS SUCH AS ANCHOR RODS AND EMBEDMENT PLATES WITHIN SPECIFIED TOLERANCES BEFORE CONCRETE PLACEMENT.
- 8) ROUND ISOLATION JOINTS SHOWN AT COLUMN LOCATIONS MAY BE SIMILAR SIZE DIAMOND SHAPED JOINTS AT THE CONTRACTOR'S DISCRETION.

- 9) WHERE TOP SURFACES OF CONCRETE SLABS ARE SHOWN TO BE RECESSED MORE THAN 1/2", THICKEN SLAB TO MAINTAIN INDICATED SLAB THICKNESS.
- 10) MECHANICALLY VIBRATE ALL CONCRETE PLACEMENTS EXCEPT SLABS LESS THAN 5" THICK.
- 11) WHERE SLAB CONTRACTION JOINTS ARE SHOWN ON THE DRAWINGS, CONTRACTION JOINTS MAY BE SUBSTITUTED TO ACCOMMODATE THE CONTRACTOR'S PLACEMENT STRATEGY.
- 12) FREE WATER ON THE SLAB SURFACE DURING FINISHING OPERATIONS IS PROHIBITED. SOFT CUT CONTRACTION JOINTS AS SOON AS POSSIBLE - GENERALLY WITHIN 6 HOURS AFTER FINISHING.
- 13) PROTECT AND CURE ALL CONCRETE SURFACES. BEGIN CURING WALLS IMMEDIATELY AFTER STRIPPING FORMS AND FLATWORK IMMEDIATELY AFTER FINISHING.
- 14) CONCRETE SURFACES TO RECEIVE GROUT UNDER COLUMN BASEPLATES MUST BE PREPARED BY LIGHT BRUSH HAIRING (1/4" AMPLITUDE) THE GROUTED AREA AND PRE-SOAKING.

F. STRUCTURAL STEEL

- 1) DETAIL, FABRICATE AND ERECT STRUCTURAL STEEL IN ACCORDANCE WITH THE 3RD EDITION LRFD "MANUAL OF STEEL CONSTRUCTION" AND 2000 "CODE OF STANDARD PRACTICE" BY AISC.
- 2) ALL STEEL-TO-STEEL BOLTED CONNECTIONS SHALL CONFORM WITH THE 2000 RCSC "SPECIFICATIONS FOR STRUCTURAL JOINTS USING ASTM A325 BOLTS" AS ENDORSED BY AISC.
- 3) PERFORM SHOP AND FIELD WELDING IN ACCORDANCE WITH THE AMERICAN WELDING SOCIETY'S STRUCTURAL WELDING CODE. SHOP OR FIELD WELDS AT NON-BOLTED CONNECTIONS THAT ARE NOT SPECIFICALLY DETAILED SHALL BE 3/16" CONTINUOUS FILLETS AT EACH CONTACT EDGE OR SURFACE.
- 4) ALL WELDERS SHALL HAVE EVIDENCE OF PASSING THE AWS STANDARD QUALIFICATION TEST FOR THE TYPE OF WORK BEING PERFORMED.
- 5) NON-DESTRUCTIVE WELD TESTS MAY BE PERFORMED. DEFICIENT WELDS WILL BE CORRECTED BY THE CONTRACTOR AND RE-TESTED AT THEIR EXPENSE.
- 6) THE ERECTOR SHALL NOT EMPLOY FIT-UP MEANS BEYOND THE USE OF DRIFT PINS OR MINOR HOLE REAMING. CORRECTION OF FIT-UP ERRORS OR MODIFICATIONS TO THE DESIGN OF ANY MEMBER SHALL BE DISCUSSED WITH THE FABRICATOR AND ENGINEER AND METHODS APPROVED BY THEM BEFORE ACTIONS ARE TAKEN.
- 7) GROUT UNDER COLUMN BASEPLATES AFTER THE STRUCTURE IS ERECT AND PLUMB BUT BEFORE PLACEMENT OF ELEVATED SLABS OR ROOFING.

G. WOOD FRAMING

- 1) PREFABRICATED WOOD TRUSSES SHALL CONFORM TO THE TRUSS PLATE INSTITUTE DESIGN SPECIFICATION FOR METAL-PLATE CONNECTED WOOD TRUSSES (ANSI/TPI 1-1995). TRUSSES SHALL BE DESIGNED BY THE MANUFACTURER TO SUPPORT ALL SUPERIMPOSED LOADS INDICATED IN SECTION "B" AND LOADS TRANSFERRED BY FRAMING MEMBERS (IE, OVERLAPPING STRUCTURAL FASCIA, ...) INDICATED ON ROOF FRAMING PLAN 5) AND ANY ADDITIONAL LOADS REQUIRED.
- 2) ENGINEERED WOOD PRODUCTS (WOOD I-JOISTS & PARALLEL STRAND LUMBER) SHOWN ON THE DRAWINGS ARE THE PRODUCTS OF TRUS JOIST MANUFACTURERS AND ARE DESIGNATED BY THE MANUFACTURER'S STANDARD PRODUCT NUMBERS. THE INTENT OF THE DESIGN IS FOR THESE ITEMS TO BE ATTACHED TO EACH OTHER AND TO THE SURROUNDING STRUCTURE TO BEHAVE AS A SYSTEM WHETHER SHOWN OR NOT. PROVIDE ACCESSORY ITEMS (BLOCKS, CLIPS, STIFFENERS, STRAPS, ETC.) DESIGNATED BY THE MANUFACTURER, FOR A COMPLETE SYSTEM. FOLLOW ALL MANUFACTURER'S RECOMMENDATIONS FOR INSTALLATION AND USE.
- 3) FRAMING CONNECTORS, ANCHORS, AND HANGERS SHOWN ON THE DRAWINGS ARE THE PRODUCTS OF SIMPSON STRONG-TIE COMPANY, SAN LEANDRO, CALIFORNIA AND ARE DESIGNATED BY MANUFACTURER'S STANDARD PRODUCT NUMBERS. FOLLOW ALL MANUFACTURER'S RECOMMENDATIONS FOR INSTALLATION AND USE. PRODUCTS WITH EQUIVALENT CAPACITY AND QUALITY MAY BE SUBSTITUTED AFTER A SUBSTITUTION SUBMITTAL HAS BEEN PROVIDED BY THE GENERAL CONTRACTOR AND FINAL APPROVAL BY STRUCTURAL ENGINEER.
- 4) NOTE: "USE" LUMBER CONNECTORS ARE PRIOR APPROVED FOR DIRECT SUBSTITUTION OF SIMPSON PRODUCTS USING THE "USE" REFERENCE NUMBERS WHERE A DIRECT SUBSTITUTION IS NOT AVAILABLE IN THE INDEX, PROVIDE A SUBSTITUTION SUBMITTAL FOR PROPOSED PRODUCT SUBSTITUTION.
- 5) FLOOR AND ROOF SHEATHING:
LAY PLYWOOD PANELS WITH FACE GRAIN PERPENDICULAR TO SUPPORTS. STAGGER ALL END JOINTS AND PLACE AS INDICATED IN "CASE 1" OF 2000 IBC TABLE 2306.2.1.

LOCATION	MATERIAL	NAILING
FLOOR	3/4" CDX T&G, 48/20 MIN. SPAN RATING	0.131" @ 6" O.C. AT ALL SUPPORTED PANEL EDGES 0.131" @ 12" O.C. AT INTERMEDIATE SUPPORTS
ROOF	3/4" CDX, 48/24 MIN. SPAN RATING	0.131" @ 6" O.C. AT ALL SUPPORTED PANEL EDGES 0.131" @ 12" O.C. AT INTERMEDIATE SUPPORTS

- 5) ALL LAG BOLTS SHALL HAVE LEAD HOLES DRILLED THE SAME DIAMETER FOR THE SHANK AND 50% OF THE SHANK DIAMETER FOR THE THREADED PORTION. LUBRICATE THREADS BEFORE INSTALLATION.
- 6) PROVIDE HEADERS FOR ALL OPENINGS AS SCHEDULED. WHERE NOT INDICATED, INSTALL 2-2X6 WITH PLATES TOP AND BOTTOM MATCHING STUD WIDTH. INSULATE ALL BOX HEADERS.
- 7) DOUBLE TOP PLATES SHALL HAVE A MINIMUM LAP LENGTH OF 8 FEET. FASTEN WITH 2 ROWS OF 16D NAILS @ 6" UNLESS INDICATED OTHERWISE.
- 8) INSTALL WOOD SHEATHING PANELS WITH FACE GRAIN PERPENDICULAR TO SUPPORTS. STAGGER ALL END JOINTS 32" MINIMUM. FASTEN PANELS TO SUPPORTING FRAMING AND BLOCKING AS INDICATED. (SEE SHEAR WALL SCHEDULE AND FRAMING PLAN 5) FOR CRITICAL NAILING.)
- 9) NO PANELS LESS THAN 12 INCHES WIDE SHALL BE USED.
- 10) FASTENERS ALONG SHEAR PANEL EDGES SHALL NOT BE LESS THAN 3/8" FROM PANEL EDGE.
- 11) NAIL HEADS SHALL NOT PENETRATE BEYOND A FLUSH CONDITION WITH FACE OF SHEATHING.
- 12) NAILING REQUIREMENTS NOT SPECIFIED ON THE CONSTRUCTION DOCUMENTS SHALL BE IN ACCORDANCE WITH THE FASTENING SCHEDULE, TABLE 2304.9.1 IN THE 2000 IBC.

H. PRE-INSTALLATION CONFERENCES

- 1) SCHEDULING AND CONDUCTING PRE-INSTALLATION CONFERENCES ARE THE CONTRACTORS RESPONSIBILITY. MEETING ATTENDERS AND FORMAT ARE OUTLINED IN THE SPECIFICATIONS. COORDINATE TIME AND AGENDA ITEMS WITH THE ENGINEER. CONDUCT PRE-INSTALLATION CONFERENCES FOR THE FOLLOWING ACTIVITIES RELATED TO STRUCTURAL SYSTEMS.

CAST-IN-PLACE CONCRETE
ROUGH CARPENTRY (WOOD FRAMING)

I. SPECIAL INSPECTIONS

- 1) SPECIAL INSPECTIONS DESCRIBED BELOW WILL BE PERFORMED UNDER SEPARATE CONTRACT BY AGENCIES RETAINED BY THE PROJECT OWNER. THE CONTRACTOR IS RESPONSIBLE FOR KEEPING THE ENGINEER APPRISED OF WORK PROGRESS AS IT PERTAINS TO SPECIAL INSPECTIONS AND ENSURING THAT NO WORK REQUIRING SPECIAL INSPECTIONS IS CONCEALED BEFORE SPECIAL INSPECTIONS OCCUR. SEE PROJECT SPECIFICATIONS FOR OTHER INSPECTIONS AND MATERIALS TESTING REQUIREMENTS.

REINFORCING STEEL:	INSPECT BEFORE CONCRETE OR GROUT PLACEMENT. (INCLUDES SLABS-ON-GRADE AND ELEVATED SLABS)
REINFORCED CONCRETE:	CONTINUOUS INSPECTION DURING CONCRETE PLACEMENT EXCEPT PERIODIC INSPECTION FOR SLABS-ON-GRADE AND ELEVATED SLABS. (INCLUDES VERIFICATION OF PROPER MIX DESIGN AND CURING METHODS)
ANCHOR RODS:	INSPECT ALL BEFORE CONCRETE PLACEMENT.
ADHESIVE ANCHORS:	PERIODIC INSPECTION DURING INSTALLATION.
STRUCTURAL STEEL:	PERIODIC INSPECTION DURING OR AFTER INSTALLATION.
WELDING:	PERIODIC INSPECTION OF ALL WELDS. INCLUDES STRUCTURAL STEEL, STEEL JOIST AND DECK, HEADED ANCHOR STUDS, STAIRS & RAILINGS

J. ABBREVIATIONS LIST - (SOME OF THE LISTED ABBREVIATIONS MAY NOT APPEAR ON THE DRAWINGS)

ANC	ANCHOR
ALT	ALTERNATE
BLDG	BUILDING
BRG	BEARING
BTJN	BETWEEN
CSJT	CONSTRUCTION JOINT
CAUT	CONTRACTION JOINT
CL	CENTERLINE
CLR	CLEAR
CHU	CONCRETE MASONRY UNIT
COL	COLUMN
CONN	CONNECTION / CONNECTOR
CONT	CONTINUE / CONTINUOUS
DBA	DEFORMED BAR ANCHOR
EXP	EXPANSION
HAS	HEADED ANCHOR STUD / SHEAR STUDS
HORZ	HORIZONTAL
HSS	HOLLOW STRUCTURAL SECTION (TUBE STEEL)
ISJT	ISOLATION JOINT
LONG	LONGITUDINAL
LF	LINEAL FOOT
REINF	REINFORCEMENT / REINFORCING
PROJ	PROJECTION
REQ	REQUIRED
SPA	SPACE / SPACES
SIM	SIMILAR
STR	STRIP
STIFF	STIFFENER
THK	THICK / THICKNESS
TRANS	TRANSVERSE
TYP	TYPICAL
UNO	UNLESS NOTED OTHERWISE
VERT	VERTICAL

K. DEFERRED SUBMITTALS

DOCUMENTATION, SUCH AS DETAIL DRAWINGS AND CALCULATIONS, FOR DEFERRED ITEMS WILL BE REVIEWED BY THE ENGINEER WHEN AVAILABLE AND FORWARDED TO THE BUILDING OFFICIAL.

1) PRE-ENGINEERED WOOD TRUSSES

L. MISCELLANEOUS

- 1) REFERENCE CIVIL DRAWINGS FOR BUILDING LOCATION AND ORIENTATION ON THE SITE.
- 2) DRAWING ELEVATION REFERENCE 100'-0" = 77' CIVIL DATUM.
- 3) DETAIL MARKS ANNOTATED ON PLANS ARE INTENDED TO INDICATE SPECIFIC CONFIGURATION(S) AND INFORMATION - FOR PLAN CLARITY, EVERY LOCATION WHERE A SPECIFIC DETAIL MAY APPLY IS NOT ANNOTATED. CONTACT THE ENGINEER IF CLARIFICATION IS NEEDED.
- 4) COORDINATE OPENINGS AND EMBEDDED ITEMS IN CONCRETE AND MASONRY WORK WITH ALL TRADES.
- 5) NOTIFY THE ENGINEER OF ANY DISCREPANCIES DISCOVERED WITH OTHER TRADES.
- 6) CONSTRUCTION LOADS SHALL NOT BE GREATER THAN THE DESIGN LOADS INDICATED IN SECTION B.1 UNLESS REVIEWED AND APPROVED BY THE ENGINEER.
- 7) EQUIPMENT OPENINGS AND PENETRATIONS INDICATED ARE FOR REFERENCE ONLY. COORDINATE EXACT LOCATIONS, DIMENSIONS AND DETAILS WITH EQUIPMENT MANUFACTURERS AND TRADES.
- 8) TEMPORARILY BRACE THE STRUCTURE TO RESIST ALL LOADS OR COMBINATIONS OF LOADS UNTIL ALL PERMANENT ELEMENTS ARE IN PLACE AND ALL CONNECTIONS ARE COMPLETE AS SHOWN.

REVISIONS:

ALPENGLOW at Big Sky
BIG SKY, MT
Uphill Unit

AS-BUILTS

COPYRIGHT 2003

CTA

ARCHITECTS

ENGINEERS

BUILDING • MISSOULA

BOISE • GREAT FALLS

HELENA • KALISPELL

SPRINGFIELD

ALL RIGHTS RESERVED

DRAWN BY: BTL

CHECKED BY: BTL

DATE: 9-1-04

CTA # MAUS

CADD FILE: MAUS002

DIR: KALISPELL

CTA
ARCHITECTS
ENGINEERS
BUILDINGS • MISSOULA
BOISE • GREAT FALLS
HELENA • KALISPELL
SPRINGFIELD

STRUCTURAL
GENERAL
NOTES

SHEET

S001 OF 12

WALL TYPE	SHEATHING TYPE & THICKNESS	LOCATION	BLOCKED (ALL JOINTS)	MIN. BLOCKING SIZE	MIN. STUD SIZE	NAILING		HOLD-DOWN (EACH END)	ANCHOR AT PLATES (WHERE NOT SPECIFIED, SEE DETAILED OTHERWISE) (7" MIN EMBEDMENT FOR ANCHOR BOLTS)	POSTS REQ'D AT SHEAR WALL ENDS	REMARKS
						PANEL EDGES	INTERMEDIATE				
<u>S1A</u>	PLYWOOD/OSB 1/2"	1-SIDE	NO		2X	8d @ 6"	8d @ 12"	SEE NOTE #5 BELOW	1/2"Ø ANCH BOLT @ 32" (8d @ 4" AT FLOORS)	SEE PLAN	
<u>S1B</u>	PLYWOOD/OSB 1/2"	1-SIDE	NO		2X	8d @ 4"	8d @ 12"	SEE NOTE #5 BELOW	1/2"Ø ANCH BOLT @ 32" (8d @ 4" AT FLOORS)	SEE PLAN	--
<u>S1C</u>	PLYWOOD/OSB 1/2"	1-SIDE	YES		2X	8d @ 4"	8d @ 12"	SEE NOTE #5 BELOW	1/2"Ø ANCH BOLT @ 16" (2 ROWS-16d @ 4" AT FLOOR)	4X MIN	--
<u>S1D</u>	PLYWOOD/OSB 1/2"	2-SIDE	YES		2X	8d @ 4"	8d @ 10"	NOTE #6 APPLIES	1/2"Ø ANCH BOLT @ 12" (2 ROWS-16d @ 2" STAGGERED AT FLOOR)	4X MIN	--
<u>S1E</u>	PLYWOOD/OSB 1/2"	2-SIDE	YES		2X	8d @ 3"	8d @ 10"	NOTE #6 APPLIES	3/4"Ø ANCH BOLT @ 12" (2 ROWS-16d @ 2" STAGGERED AT FLOOR)	SEE PLAN	--
<u>S1F</u>	PLYWOOD/OSB 1/2"	2-SIDE	YES		2X	10d @ 2"	10d @ 10"	NOTE #6 APPLIES	3/8"Ø ANCH BOLT @ 9"	SEE PLAN	OFFSET JOINTS IN PLYWOOD AT BOTH FACES OF WALL.

EXTENT OF SHEAR WALL
AS INDICATED ON FRAMING PLANS

ROOF FRAMING

SEE PLAN FOR DETAIL

INTERMEDIATE NAILING TO FRAMING, SEE SCHEDULE.

2
5021

POST, SEE SCHEDULE

SEE SHEAR WALL SCHEDULE FOR PANEL EDGE NAILING

1
5021

TOP OF CONC

3
5021

BLOCK SOLD AT SHEATHING JOINTS

MARK	TYPE
(A) ☐	HD5A
(B) ☐	HD8A
(C) ☐	HD10A
(D) ☐	HD20A

CONNECTION	NAILING
1. JOIST TO BILL OR GIRDER, TOENAIL	3-6d
2. BRIDGING TO JOIST, TOENAIL EACH END	2-6d
3. 1"x6" (25mm)x(152mm) SUBFLOOR TO EACH JOIST, FACE NAIL	2-6d
4. LIDER THAN 1"x6" (25mm)x(152mm) SUBFLOOR TO EACH JOIST, FACE NAIL	3-6d
5. 2" (51mm) SUBFLOOR TO JOIST OR GIRDER BLIND AND FACE NAIL	2-6d
6. SOLE PLATE TO JOIST OR BLOCKING, TYPICAL FACE NAIL	16d @ 16" (406mm) OC
SOLE PLATE TO JOIST OR BLOCKING, AT BRACED WALL PANELS	3-16d PER 16" (406mm)
7. TOP PLATE TO STUD, END NAIL	3-16d
8. STUD TO SOLE PLATE	4-6d, TOENAIL OR 3-16d, END NAIL
9. DOUBLE STUDS, FACE NAIL	16d @ 24" (609mm) OC
10. DOUBLED TOP PLATES, TYPICAL FACE NAIL	16d @ 16" (406mm) OC
DOUBLE TOP PLATES, LAP SPICE	3-16d
11. BLOCKING BETWEEN JOIST OR RAFTERS TO TOP PLATE, TOENAIL	10d @ 4" (101mm) SIDE OR 2-10d @ 8" (203mm) BOTH SIDES
12. RM JOIST TO TOP PLATE, TOENAIL	10d @ 4" (152mm) OC
13. TOP PLATES, LAPS AND INTERSECTIONS, FACE NAIL	2-16d
14. CONTINUOUS HEADER, TWO PIECES	16d @ 16" (406mm) OC ALONG EA EDGE
15. CEILING JOISTS TO PLATE, TOENAIL	4-8d
16. CONTINUOUS HEADER TO STUD, TOENAIL	4-8d
17. CEILING JOISTS, LAPS OVER PARTITIONS, FACE NAIL	3-16d
18. CEILING JOISTS TO PARALLEL RAFTERS, FACE NAIL	3-16d
19. TRUSS TO PLATE, TOENAIL	4-10d
20. 1" (25mm)x(203mm) BRACE TO EACH STUD AND PLATE, FACE NAIL	2-8d
21. 1"x6" (25mm)x(152mm) SHEATHING OR LESS TO EACH BEARING, FACE NAIL	2-8d
22. LIDER THAN 1"x6" (25mm)x(152mm) SHEATHING TO EACH BEARING, FACE NAIL	3-8d
23. BUILT-UP CORNER STUDS	16d @ 24" (609mm) OC
24. BUILT-UP GIRDER AND BEAMS	20d @ 32" (813mm) OC AT TOP AND BOTTOM AND STAGGERED AT ENDS AND AT EA SPICE
25. 2" (51mm) PLANKS	2-16d AT EACH BEARING
26. WOOD STRUCTURAL PANELS AND PARTICLEBOARD, ² SUBFLOOR, ROOF AND WALL SHEATHING (TO FRAMING): (1/2-INCH = 25.4 mm) 1/2" AND LESS 1/2" - 3/4" 3/4" - 1" 1" - 1 1/4" COMINATION SUBFLOOR-UNDERLAYMENT (TO FRAMING): (1/2-INCH = 25.4 mm) 1/2" AND LESS 3/4" - 1" 1" - 1 1/4"	8d ^a 10d ^b 10d ^b 10d ^b 10d ^b OR 8d ^b 6d ^b 8d ^b 10d ^b OR 8d ^b
27. PANEL SIDING (TO FRAMING): 1/2" (13 mm) OR LESS 3/4" (19 mm)	8d ^b 8d ^b
28. FIBERBOARD SHEATHING: ¹ 1/2" (13 mm) 25/32" (20 mm)	NO. 10GA ^a 6d ^a NO. 10GA ^a 8d ^a NO. 10GA ^a
29. INTERIOR PANELING 1/4" 5/8" 3/4"	4d ^a 6d ¹¹
1. COTTON OR BOX NAILS MAY BE USED EXCEPT WHEREVER OTHERWISE STATED.	
2. NAILS SPACED AT 6 INCHES (152mm) ON CENTER AT EXTERIOR EDGES, 12 INCHES (305mm) AT INTERMEDIATE SUPPORTS EXCEPT 6 INCHES (152mm) AT ALL SUPPORTS WHERE SPANS ARE 48 INCHES (1219mm) OR MORE FOR NAILING OF WOOD STRUCTURAL PANEL AND PARTICLEBOARD.	
3. DIMENSIONS AND SHEAR WALLS, REFER TO SECTION 2303.5 AND 2303.6. NAILS FOR WALL SHEATHING MAY BE COTTON, BOX OR CASING.	
3. COTTON OR DEFORMED SHANK.	
4. COTTON.	
5. DEFORMED SHANK.	
6. CORROSION-RESISTANT SIDING OR CASING NAILS CONFORMING TO THE REQUIREMENTS OF SECTION 2304.3.	
7. FASTENERS SPACED 3 INCHES (76mm) ON CENTER AT EXTERIOR EDGES AND 6 INCHES (152 mm) ON CENTER AT INTERMEDIATE SUPPORTS.	
8. CORROSION-RESISTANT ROOFING NAILS WITH 7/8-INCH DIAMETER (19mm) HEAD AND 1/2-INCH (25mm) LENGTH FOR 1/2-INCH (13mm) SHEATHING AND 1 1/8-INCH (44mm) LENGTH FOR 25/32 INCH (20mm) SHEATHING CONFORMING TO THE REQUIREMENTS OF SECTION 2304.3.	
9. CORROSION-RESISTANT STAPLES WITH NOMINAL 7/16-INCH (11mm) CROWN AND 1/8-INCH (3mm) LENGTH FOR 1/2-INCH (13mm) SHEATHING AND 1/2-INCH (38mm) LENGTH FOR 25/32 INCH (20mm) SHEATHING CONFORMING TO THE REQUIREMENTS OF SECTION 2304.3.	
10. PANEL SUPPORTS AT 16 INCHES (406mm) [20 INCHES (508mm) IF STRENGTH AXIS IN THE LONG DIRECTION OF THE PANEL, UNLESS OTHERWISE MARKED]. CASING OR FINISH NAILS SPACED 6 INCHES (152mm) ON PANEL EDGES, 12 INCHES (305mm) AT INTERMEDIATE SUPPORTS.	
11. PANEL SUPPORTS AT 24 INCHES (609mm), CASING OR FINISH NAILS SPACED 6 INCHES (152mm) ON PANEL EDGES, 12 INCHES (305mm) AT INTERMEDIATE SUPPORTS.	

MASK	HEADER	# OF BEARING STUDS [UNLESS INDICATED OTHERWISE] ON PLAN	# OF CONT STUDS REQ'D (DON PLATE TO DON TOP PLATE) [UNLESS INDICATED OTHERWISE ON PLAN]
H1	3-2XB	1	1
H2	3-2XB	2	1- INT WALLS 2- EXT WALLS
H3	3-2XI2	2	1- INT WALLS 3- EXT WALLS
H4	2-LVL 3/4XB $\frac{1}{2}$	2	1- INT WALLS 2- EXT WALLS
H5	2-LVL 3/4XB $\frac{1}{2}$	2	3
H6	3-LVL 3/4XB $\frac{1}{2}$	2	2
H7	3-LVL 3/4XB $\frac{1}{2}$	2	4
H7	3-LVL 3/4XB $\frac{1}{2}$	4	1

Technical drawing of a beam-to-column connection. The drawing shows a cross-section of a beam with a central splice. The splice is made of two plates, each 5'-0" MIN. long, with a 5'-0" MIN. gap between them. The splice plates are labeled "TO TOP PLATE TO TOP PLATE" and "SPlice". The beam is supported by a column. The column has a central splice. The splice is made of two plates, each 5'-0" MIN. long, with a 5'-0" MIN. gap between them. The splice plates are labeled "TO TOP PLATE TO TOP PLATE" and "SPlice". The beam is supported by a column. The column has a central splice. The splice is made of two plates, each 5'-0" MIN. long, with a 5'-0" MIN. gap between them. The splice plates are labeled "TO TOP PLATE TO TOP PLATE" and "SPlice".

Labels and dimensions:

- 5'-0" MIN
- TO TOP PLATE TO TOP PLATE
- SPlice
- SPlice PLATE OVER STUD
- DEL PLATE, WHERE HEADER SPAN EXCEEDS 5'-0"
- FASTEN EA STUD TO ADJACENT W/ 2-ROWS 10# 8'-1"
- 3-16d
- SIMPSON A35 WHERE HEADER SPAN EXCEEDS 5'-0"
- HEADER
- BEARING STUDS (SEE SCHEDULE)
- CONT STUDS

MARK	STUD TYPE	STUD SIZE	STUD SPACING	REMARKS
W1	DOUGLAS FIR	2X4	1'-4"	UNLESS LARGER REQ'D BY ARCHITECTURAL
W2	DOUGLAS FIR	2X6	1'-4"	-
W3	DOUGLAS FIR	2X4	8"	STAGGER STUDS
W4	DOUGLAS FIR	2X6	1'-0"	-
	-	-	-	-
	-	-	-	-

REBAR SIZE	CONCRETE		MASONRY
	VERT & HORIZ	TOP BAR	
#3		1'-1"	
#4		2'-0"	
#5		2'-11"	
#6		3'-4"	
#7		4'-6"	
#8		5'-2"	
#9		5'-10"	
#10		6'-7"	

- 1) CONCRETE LAP LENGTHS ARE CLASS 'B' BASED ON F'CI=4000 PSLHUM COVER REQUIREMENTS INDICATED AND BAR SPACING AT LEAST THREE BAR DIAMETERS.
- 2) TOP BAR LAPS ARE HORIZONTAL LAPS WHERE MORE THAN 12" OF FRESH CONCRETE IS PLACED BELOW THE BARS.
- 3) TOP BAR LAP LENGTHS MAY BE USED AT ALL LOCATIONS IN CONCRETE AT THE CONTRACTOR'S DISCRETION.
- 4) MASONRY LAP LENGTHS ARE BASED ON F'HI=500 PSLHUM COVER REQUIREMENTS AND BRACING INDICATED.

AS-BUILTS

DRAWN BY: BML
CHECKED BY: SMB
DATE: 9-1-04
CTA # MAUS
CADD FILE: MAUS9002
DIR: KAMAUS

SCHEDULES

S002 OF 12

REVISIONS:
 1. STAR REVISION 5/20/03
 2. PRELIMINARY REVISION 5/1/04

ALPENGLOW at Big Sky
 BIG SKY, MT
 Uphill Unit

AS-BUILTS

COPYRIGHT 2003
 CTA
 ARCHITECTS
 ENGINEERS
 BILLINGS • MISSOULA
 BOISE • GREAT FALLS
 HELENA • KALISPELL
 SPOKANE
 ALL RIGHTS RESERVED


DRAWN BY: SHD
 CHECKED BY: SHD
 DATE: 9-1-04
 CTA #: MAUS
 CADD FILE: MAUP300
 DIR: KAMTAUS

CTA
 ARCHITECTS
 ENGINEERS
 BILLINGS • MISSOULA
 BOISE • GREAT FALLS
 HELENA • KALISPELL
 SPOKANE

UPHILL UNIT
 FOUNDATION PLAN

SHEET

S101 OF

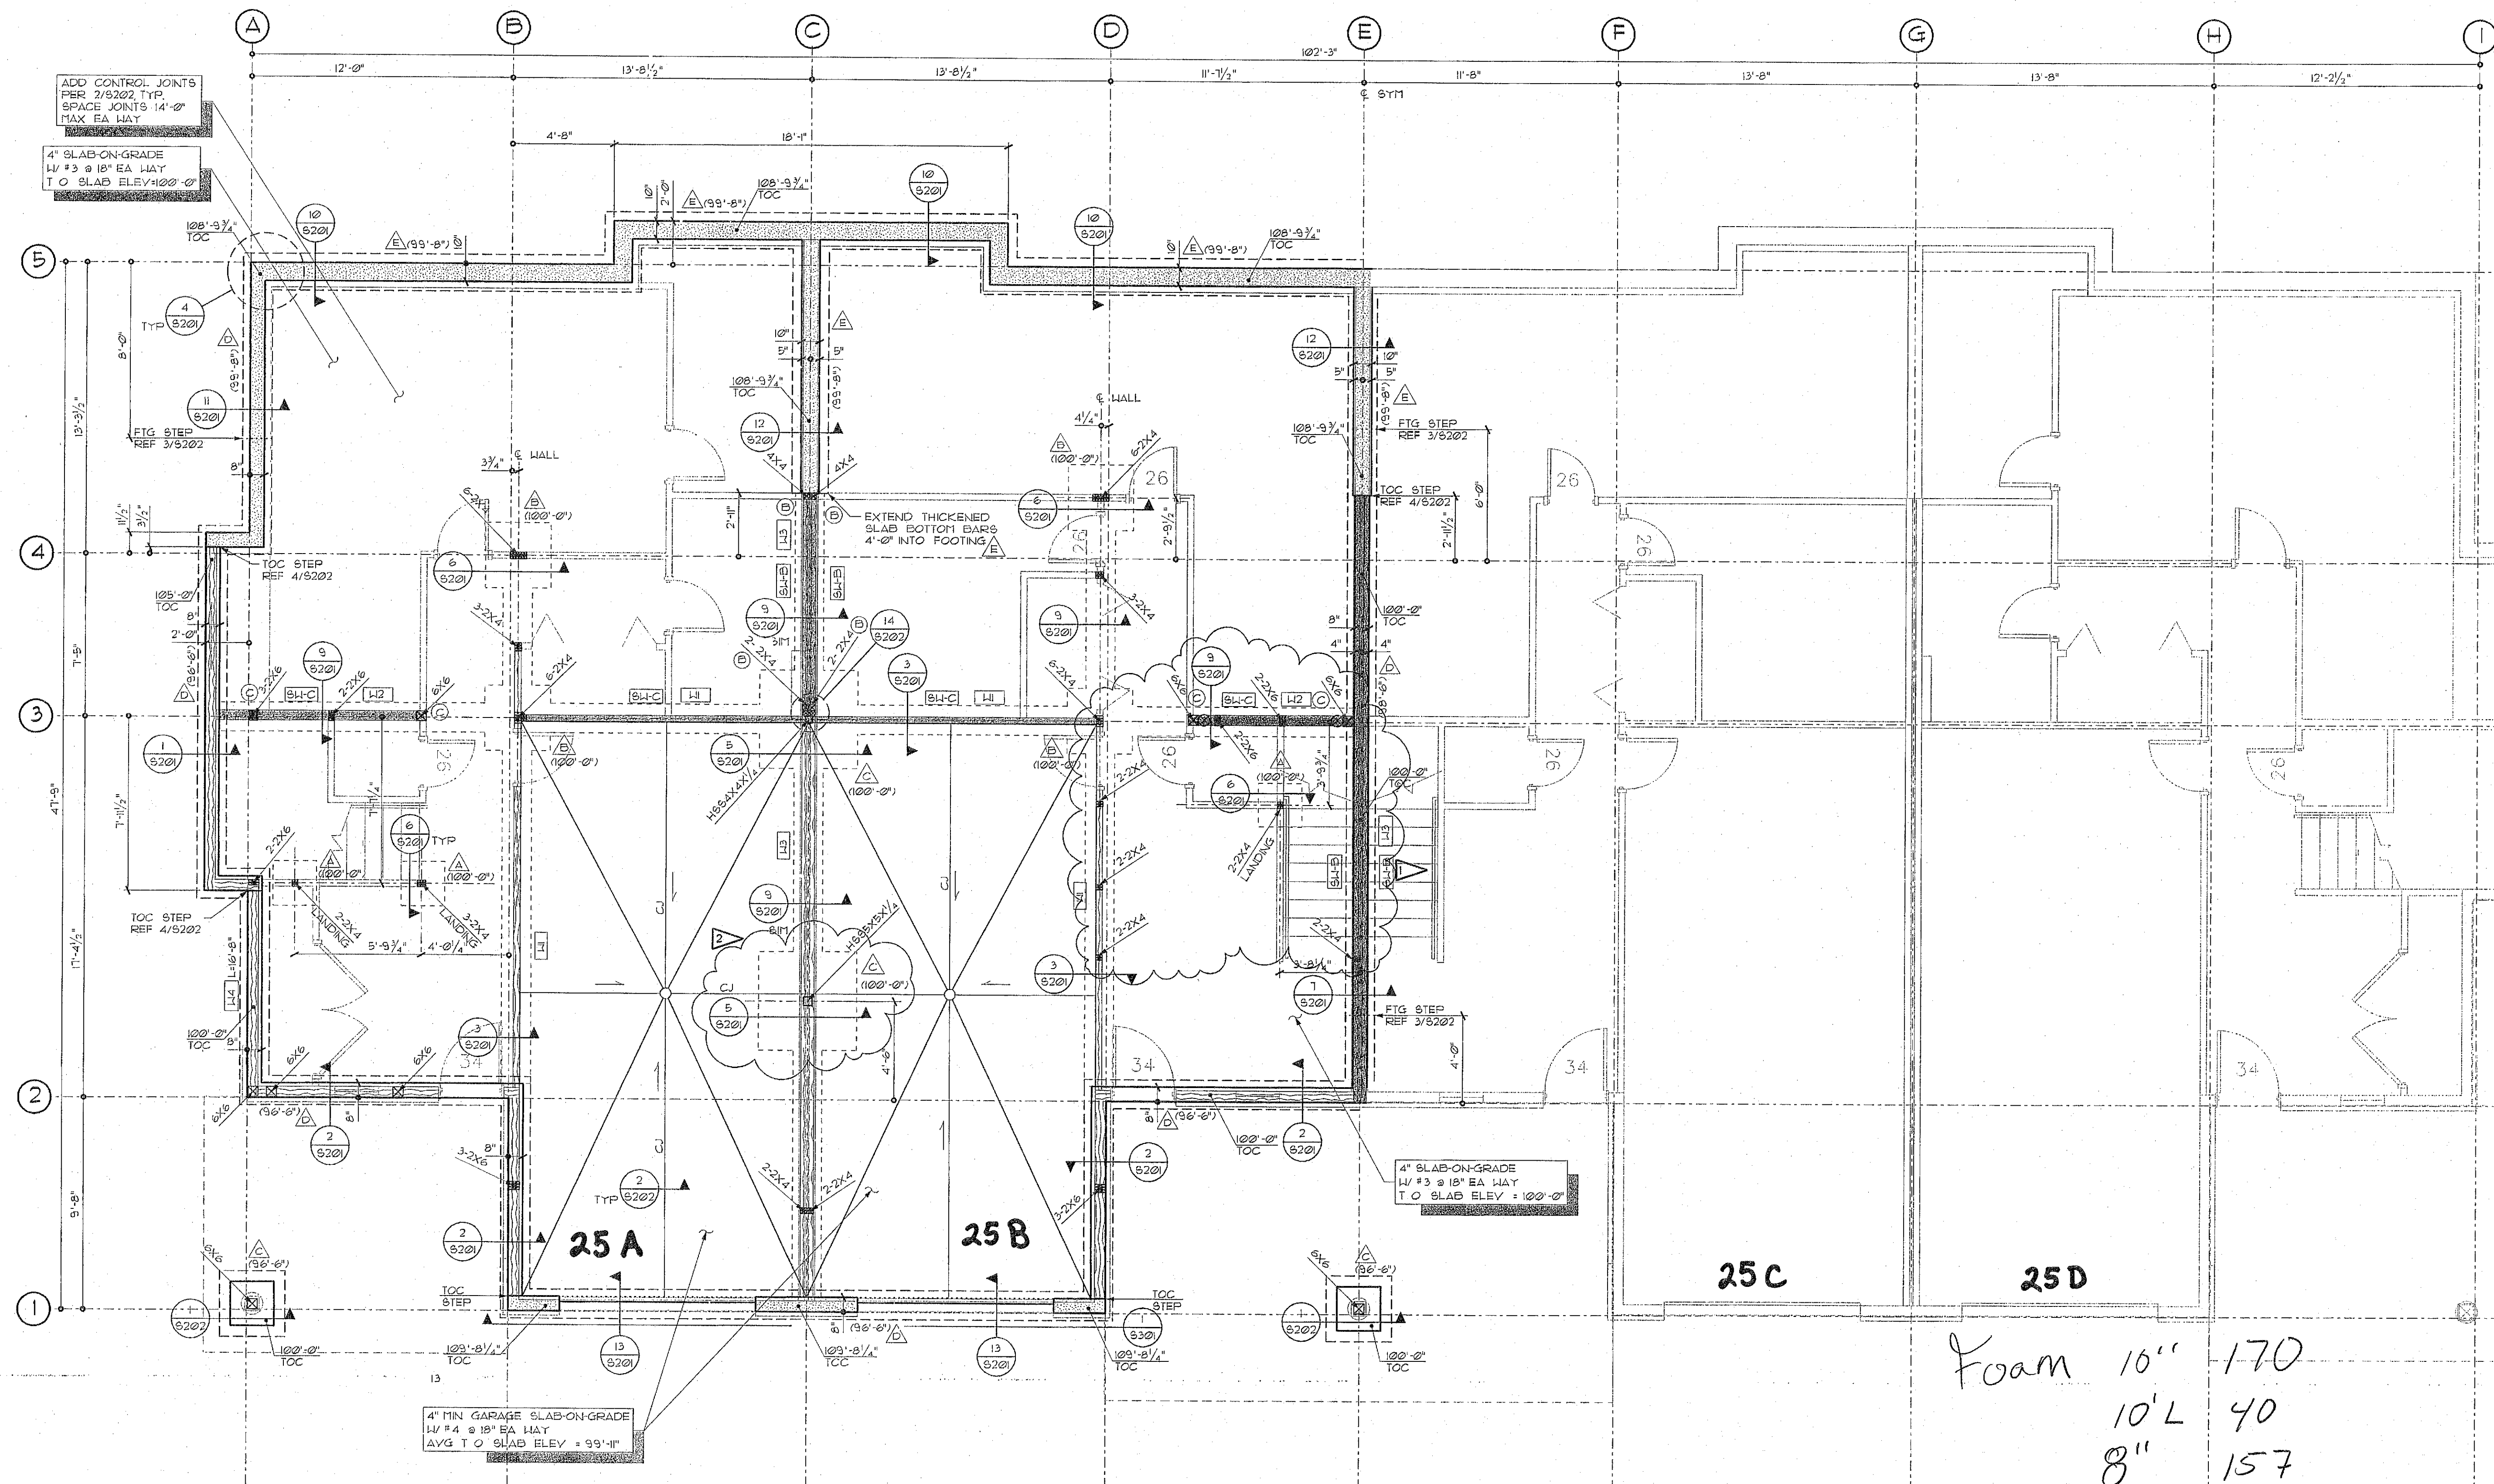

FOOTING SCHEDULE

MARK	SIZE(W X L X THK)	REINFORCING	REMARKS
△	2'-0"X2'-0"X1'-0"	2-#5 EA WAY	
△	3'-0"X3'-0"X1'-0"	3-#5 EA WAY	
△	4'-0"X4'-0"X1'-0"	4-#5 EA WAY	
△	1'-4"XCONTX1'-0"	3-#5 CONT	STRIP FOOTING
△	1'-8"XCONTX1'-0"	3-#5 CONT	STRIP FOOTING
△	3'-0"XCONTX1'-0"	3-#5 CONT LONG #5 @ 24" TRANS	STRIP FOOTING

UPHILL UNIT
 FOUNDATION PLAN

SCALE 1/4"=1'-0"


STRUCTURAL LEGEND

- XXX'-X" TOC INDICATES TOP OF CONCRETE WALL ELEVATION.
- △X INDICATES WALL TYPE, SEE SCHEDULE.
- △ INDICATES FOOTING, SEE SCHEDULE.
- (XXX'-X") INDICATES TOP OF FOOTING ELEVATION.
- HSS6X12X1/2 INDICATES HOLLOW STRUCTURAL STEEL COLUMN.
- INDICATES LOAD BEARING WALL.
- SL-X INDICATES SHEAR WALL, SEE SCHEDULE SHEET S202.
- X = INDICATES WALL TYPE.
- = INDICATES HOLD-DOWN LOCATION.
- (A) = INDICATES HOLD-DOWN TYPE, SCHEDULE SHEET S202.

STRUCTURAL PLAN NOTES

- ALL EXTERIOR WALLS TO BE TYPE [U2], TYPED.
- REFER TO DETAIL 4/5202 FOR STEP IN TOP OF CONCRETE FOUNDATION WALL.
- REFER TO DETAIL 3/5202 FOR STEP IN TOP OF FOOTING.
- BUILDING IS SYMMETRICAL ABOUT GRID (E).
- NOTE TO CONTRACTOR:
 ALL FOOTINGS AND SLABS-ON-GRADE:
 A 1'-0" OVER DIG AND IMPORTED STRUCTURAL FILL MIGHT BE REQUIRED.
 REFERENCE DETAIL 5/5202 FOR EXCAVATION REQUIREMENTS.

3'-0" 5'-0" 10'-0" 20'-0"

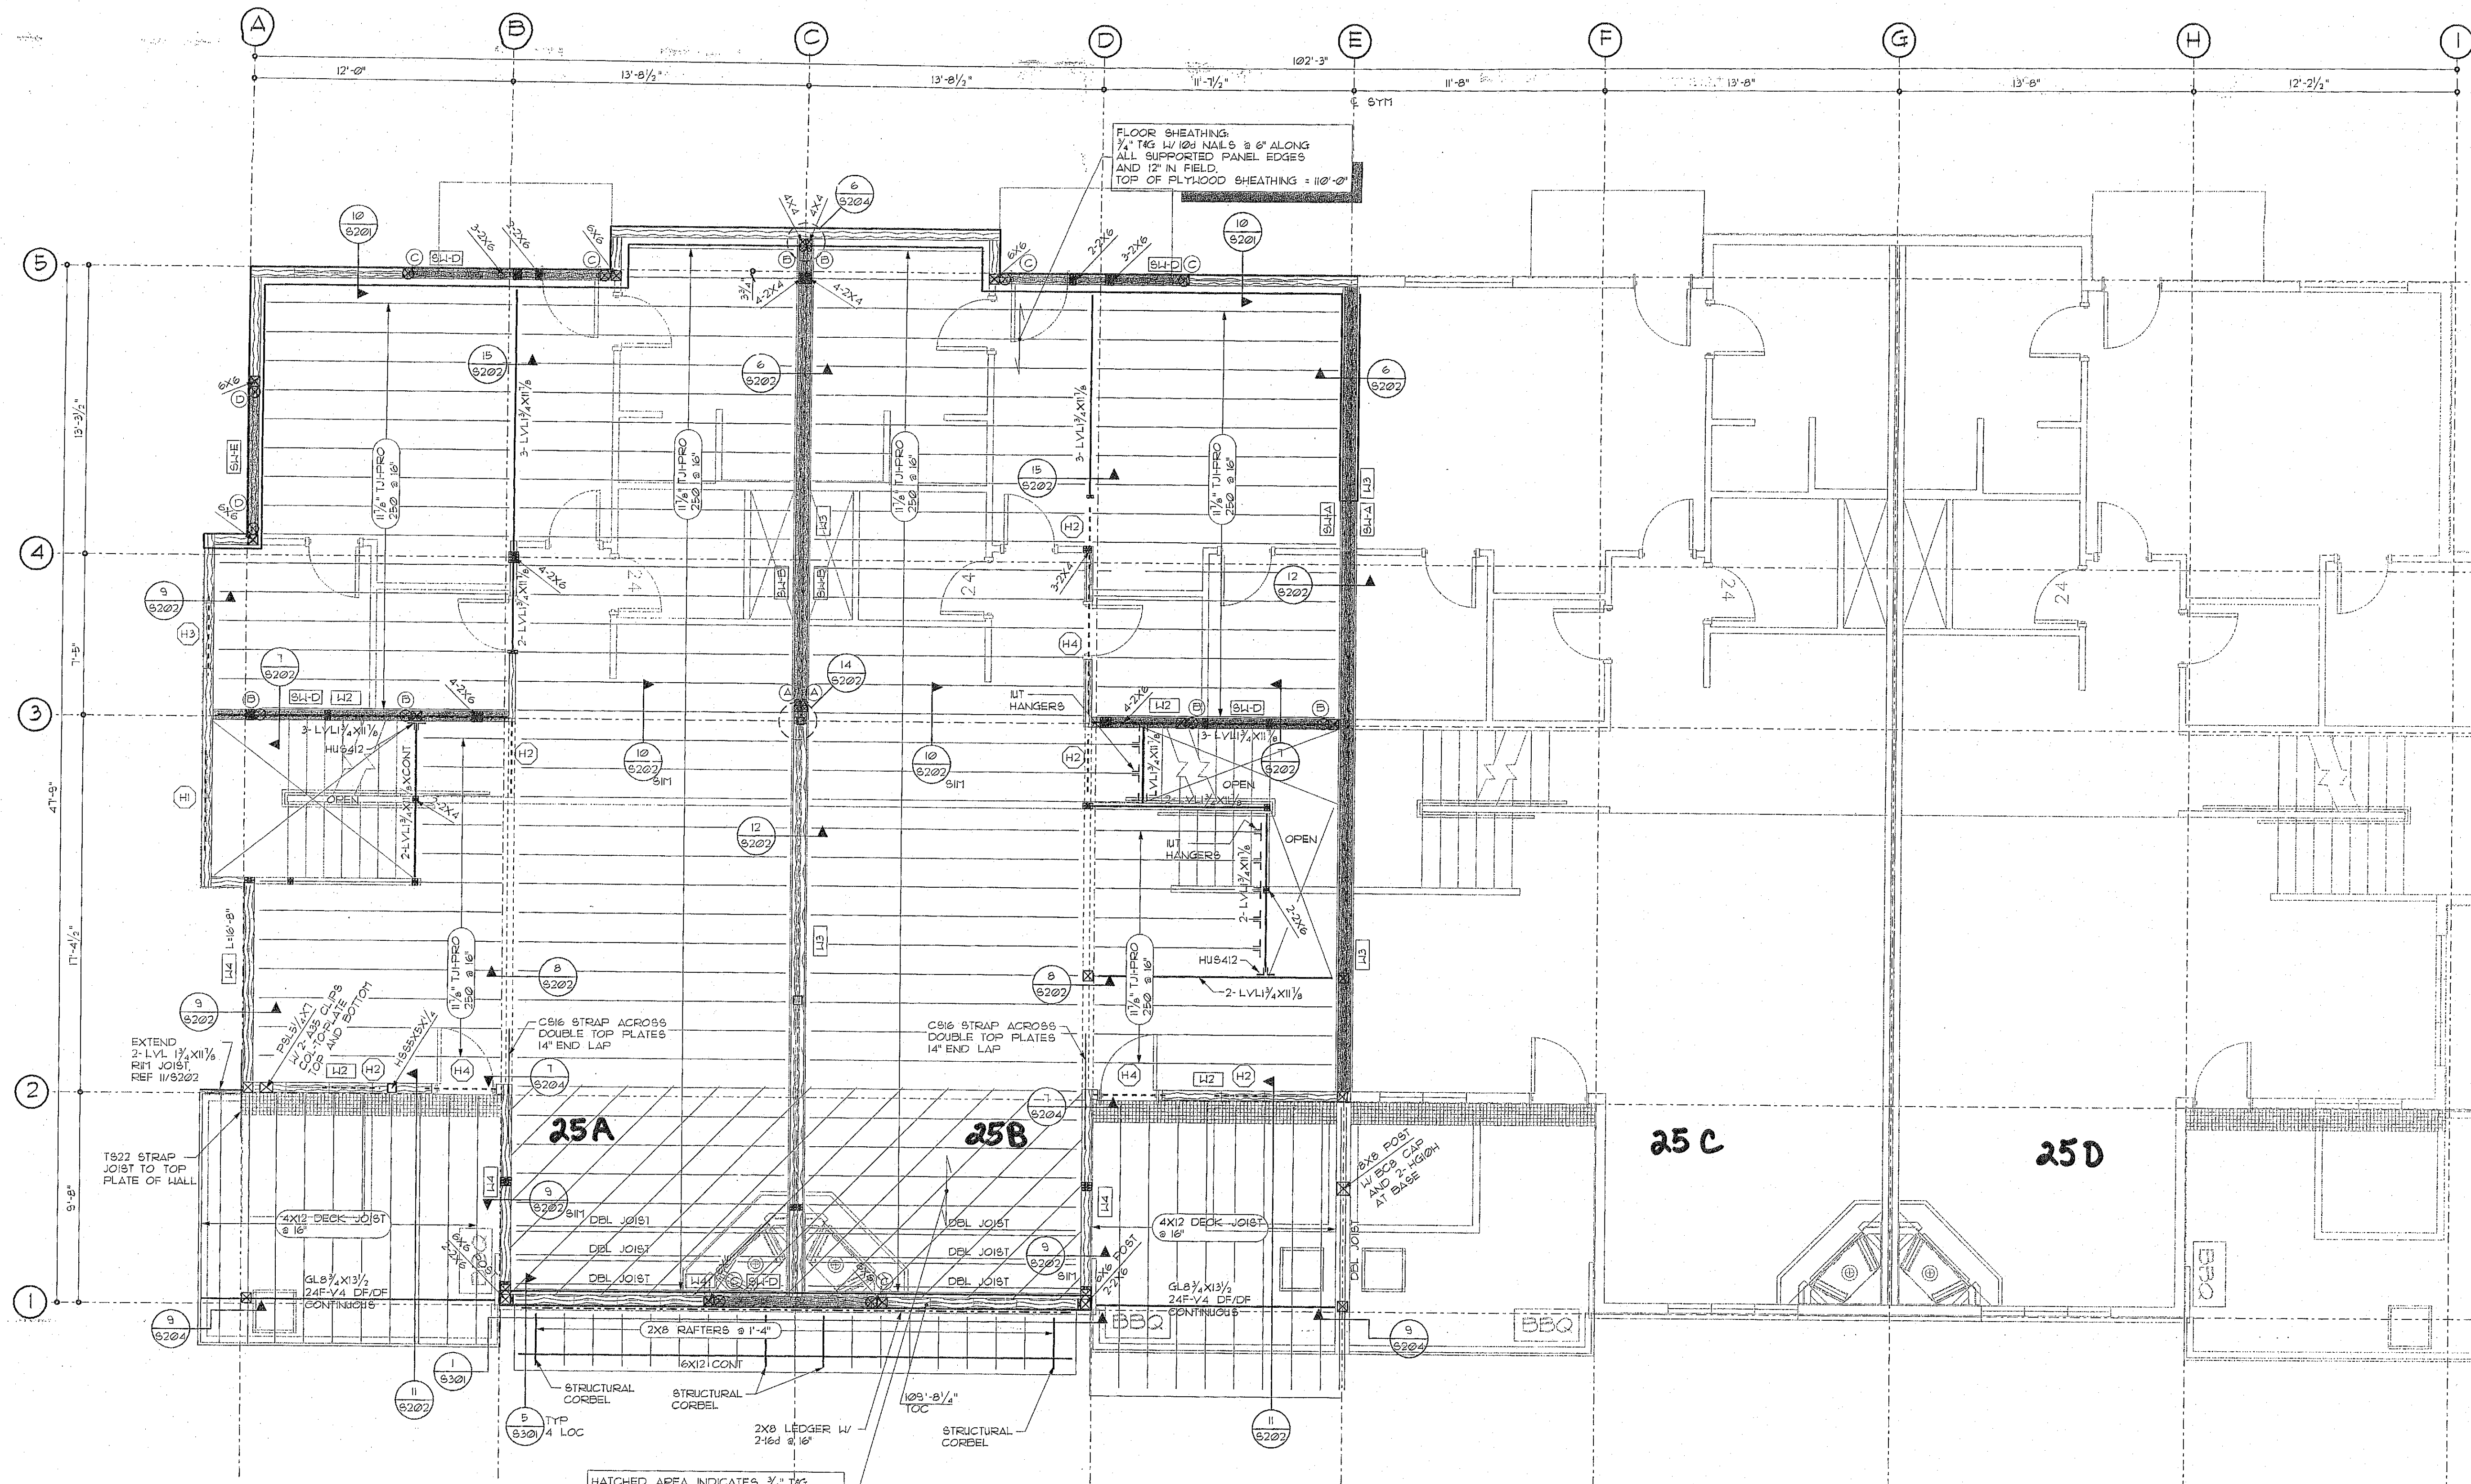

UPHILL UNIT
2ND FLOOR FRAMING PLAN
SCALE: 1/4" = 1'-0"

- STRUCTURAL LEGEND**
- [H2] INDICATES WALL TYPE, SEE SCHEDULE.
 - HSS10X10 INDICATES HOLLOW STRUCTURAL STEEL COLUMN.
 - INDICATES LOAD BEARING WALL.
 - [H4-X] INDICATES SHEAR WALL, SEE SCHEDULE SHEET S002.
 - X INDICATES HOLLOW WALL TYPE.
 - INDICATES HOLD-DOWN LOCATION.
 - ⓐ INDICATES HOLD-DOWN TYPE, SCHEDULE SHEET S002.
 - INDICATES SIMPSON HANGER (OR EQUIV).

- STRUCTURAL PLAN NOTES**
1. ALL EXTERIOR WALLS ARE TYPE [H2], TYP-UNO.
 2. BEARING WALLS SHOWN INDICATE WALLS ABOVE FRAMING.
 3. HEADERS SHOWN CORRELATE TO WINDOWS AND DOOR OPENINGS BELOW FRAMING.
 4. ALL HEADERS ARE (H1) TYP-UNO.
 5. BLOCK SOLID LEBBS OF DOUBLE JOISTS AT HANGERS, TYP.
 6. PROVIDE 1/4"x11/8" TIMBERSTRAND RIM AT ALL EXTERIOR WALLS, TYP-UNO.
 7. ALL JOIST HANGERS TO BE SIMPSON UTI (OR EQUIV), TYP-UNO.
 8. BUILDING IS SYMMETRICAL ABOUT GRID (E).

REVISIONS	
4/24/03	STAR REVISION 8/20/03
5/11/04	

ALPENGLOW at Big Sky
BIG SKY, MT
Uphill Unit


AS-BUILTS

COPYRIGHT 2003
CTA
ARCHITECTS
ENGINEERS
BILLINGS • MISSOULA
BOISE • GREAT FALLS
HELENA • KALISPELL
SPOKANE
ALL RIGHTS RESERVED

DRAWN BY: SLD
CHECKED BY: SLD
DATE: 1-20-05
CTA # MAUS
CADD FILE: MAUP5102
DIR: KAMAUSA

CTA
ARCHITECTS
ENGINEERS
BILLINGS • MISSOULA
BOISE • GREAT FALLS
HELENA • KALISPELL
SPOKANE

UPHILL UNIT
2ND FLOOR
FRAMING
PLAN

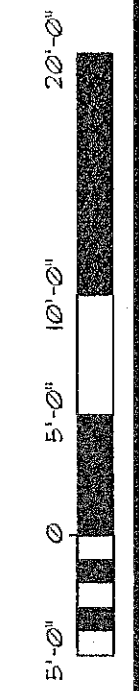


STRUCTURAL PLAN NOTES

1. ALL EXTERIOR WALLS ARE TYPE U2, TYP-UNO.
2. PROVIDE $1\frac{1}{4} \times 12 \times 8$ TIMBERSTRAND RM AT ALL FLOOR EDGES, TYPICAL - UNO.
3. ALL STAIR LANDING BEAMS TO BE 2- 2×12 (NOT SHOWN ON PLANS)
4. ALL JOIST HANGERS TO BE SIMPSON UH (OR EQUIV), TYP-UNO
5. BUILDING IS SYMMETRICAL ABOUT GRID (E).

SHEET

S103 OF _____

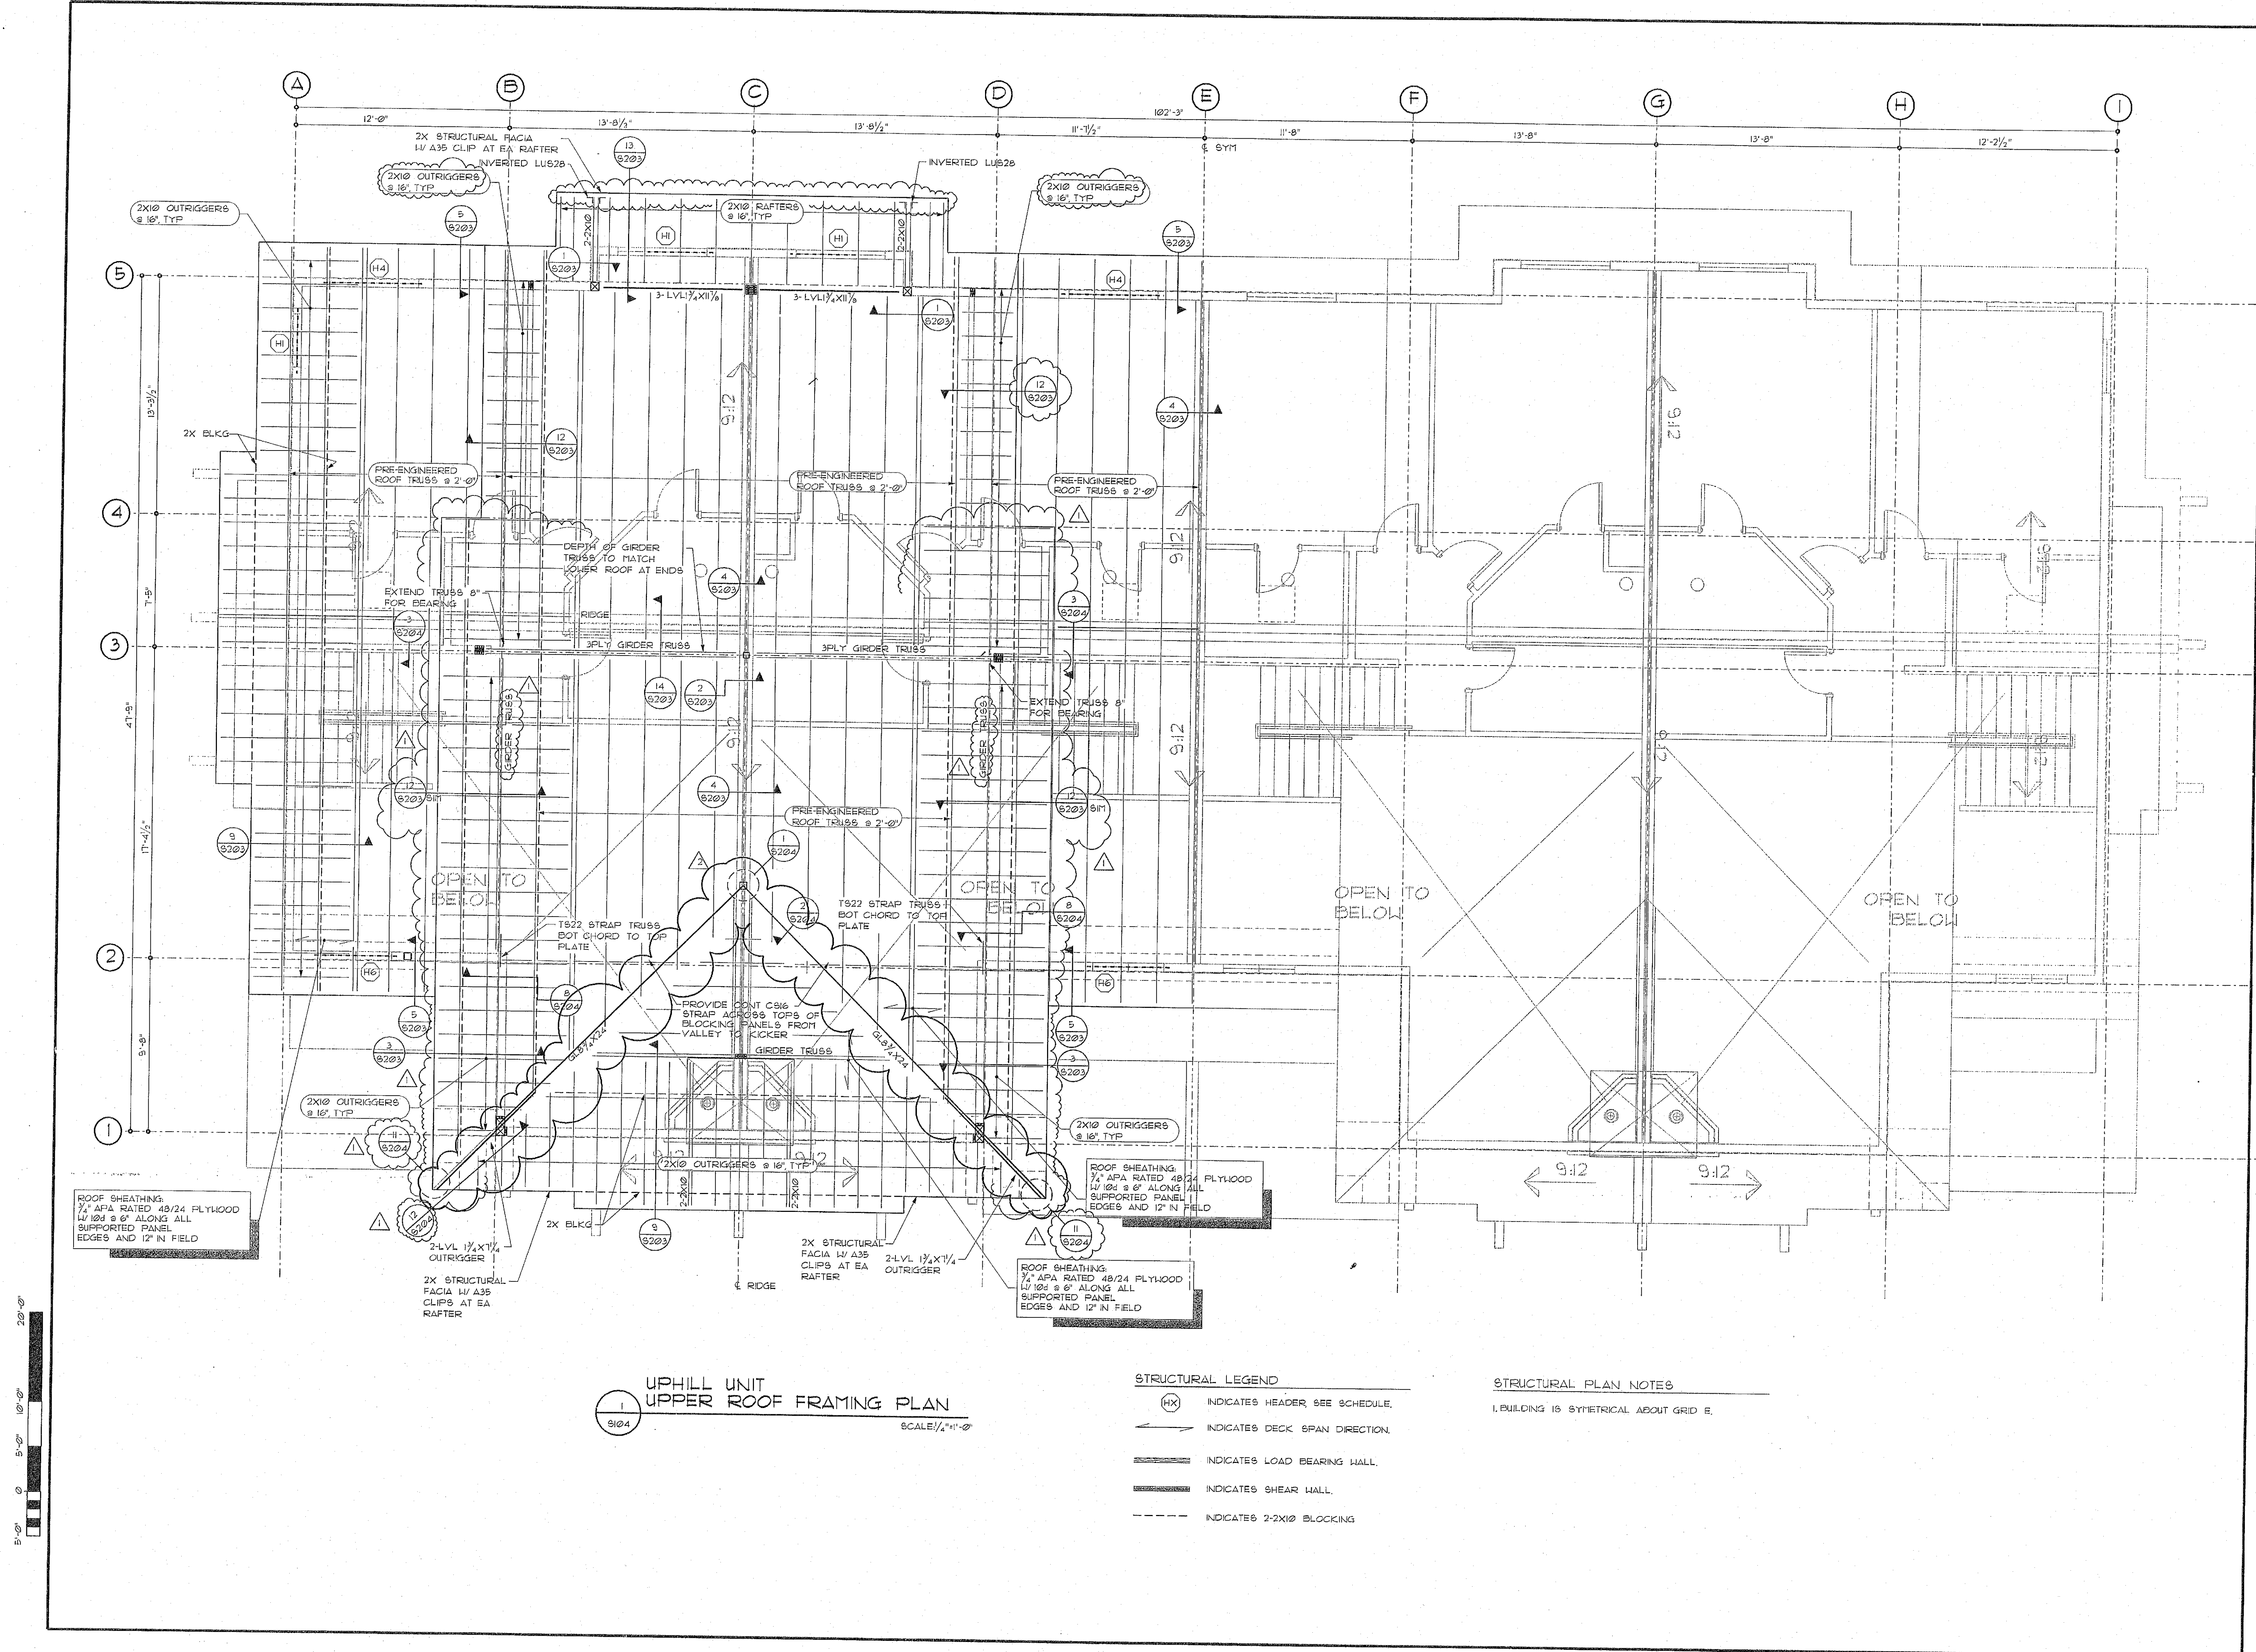

REVISIONS	
4-24-03	
5-15-04	

ALPENGLOW at Big Sky
BIG SKY, MT
Uphill Unit

AS-BUILTS

COPYRIGHT 2003
CTA
ARCHITECTS
ENGINEERS
BILLINGS • MISSOULA
BOISE • GREAT FALLS
HELENA • KALISPELL
SPOKANE
ALL RIGHTS RESERVED
DRAWN BY: SLID
CHECKED BY: SMH
DATE: 9-1-04
CTA # MAUS
CADD FILE: MAUP8404
DIR: K:\MAUS

CTA

ARCHITECTS
ENGINEERS
BILLINGS • MISSOULA
BOISE • GREAT FALLS
HELENA • KALISPELL
SPOKANE

UPHILL UNIT
UPPER ROOF
FRAMING
PLAN

SHEET
S104 OF

REVISIONS:

ALPENGLOW at Big Sky BIG SKY, MT Uphill Unit

AS-BUILTS

COPYRIGHT 2003
 CTA
 ARCHITECTS
 ENGINEERS
 BILLINGS • MISSOULA
 BOISE • GREAT FALLS
 HELENA • KALISPELL
 SPOKANE
 ALL RIGHTS RESERVED


DRAWN BY: BML
 CHECKED BY: SHB
 DATE: 9-1-04
 CTA # MAUS
 CADD FILE: MAUS020
 DTR: KAMAUS

CTA
 ARCHITECTS
 ENGINEERS
 BILLINGS • MISSOULA
 BOISE • GREAT FALLS
 HELENA • KALISPELL
 SPOKANE

STRUCTURAL DETAILS

SHEET

S201 OF 12

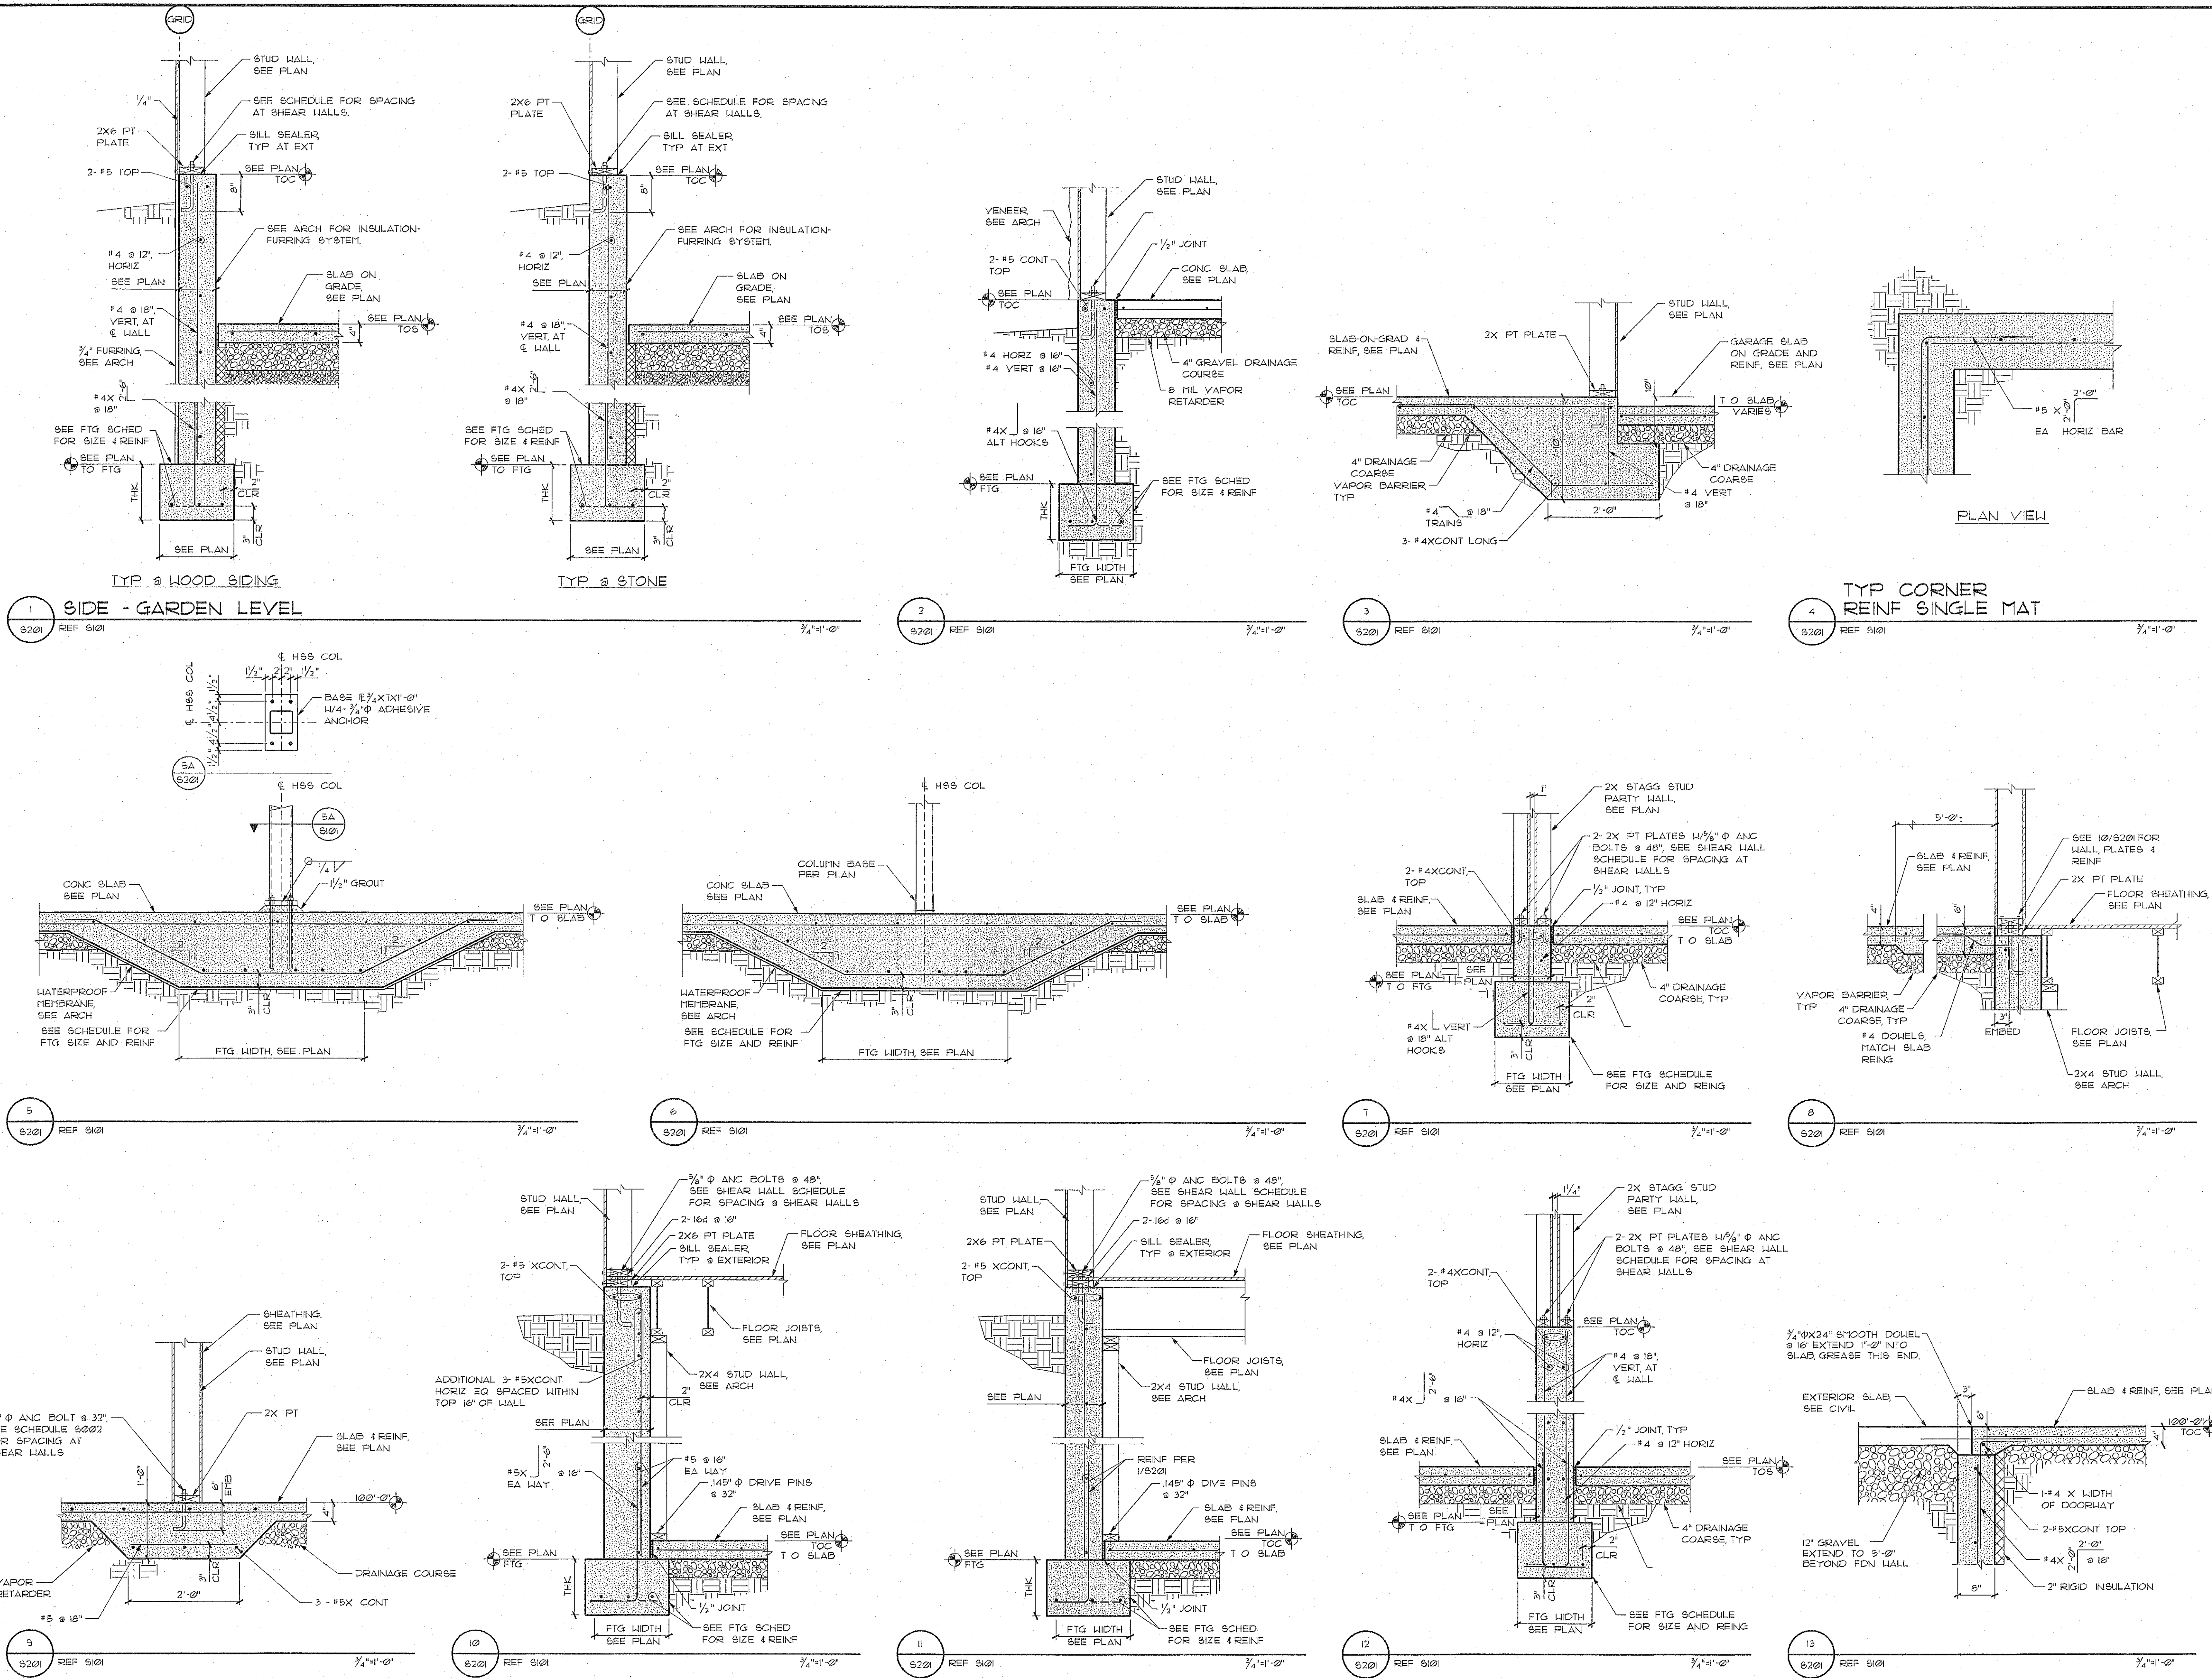

REVISIONS:

ALPENGLOW at Big Sky
BIG SKY, MT
Uphill Unit

AS-BUILTS

COPYRIGHT 2003
CTA
ARCHITECTS
ENGINEERS
BILLINGS • MISSOULA
BOISE • GREAT FALLS
HELENA • KANSAS
SPOKANE
ALL RIGHTS RESERVED


DRAWN BY: BML
CHECKED BY: GMD
DATE: 9-1-04
CTA # 11AUG
CADD FILE: 11AUG99202
DIR: KANSAS

CTA
ARCHITECTS
ENGINEERS
BILLINGS • MISSOULA
BOISE • GREAT FALLS
HELENA • KANSAS
SPOKANE


STRUCTURAL
DETAILS

SHEET


S202 OF 12

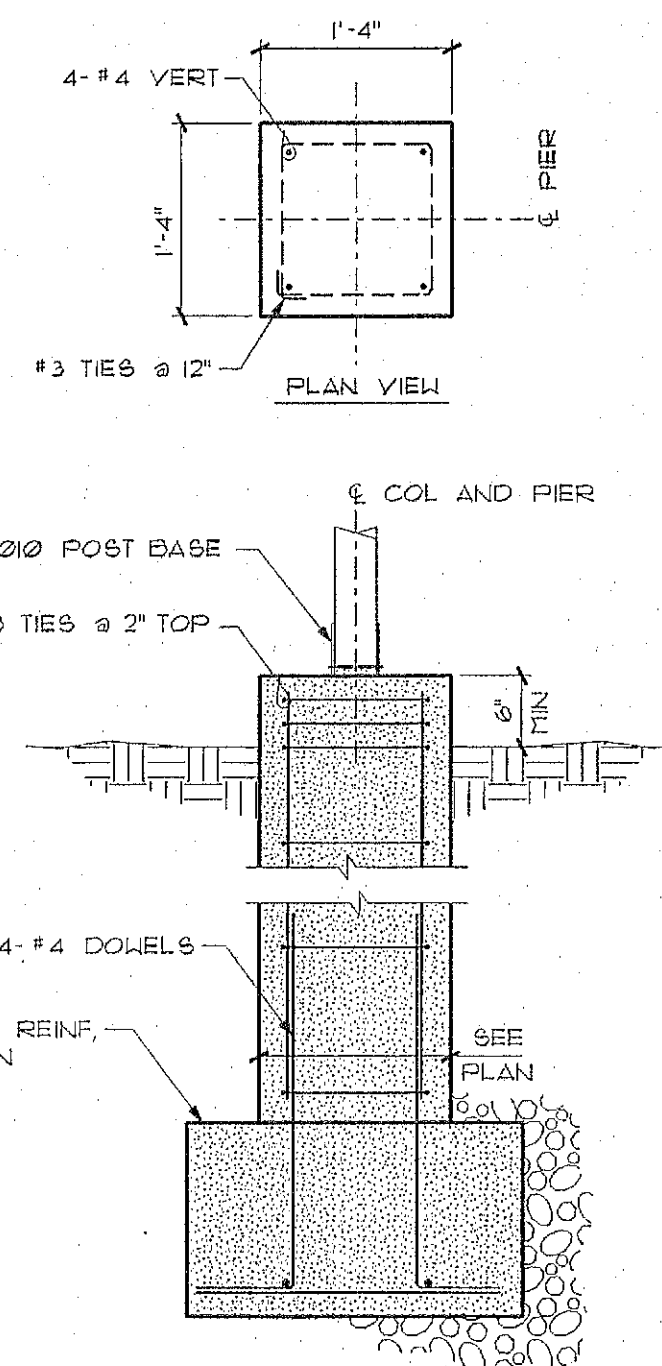


1
S202 REF S101
3/4"=1'-0"

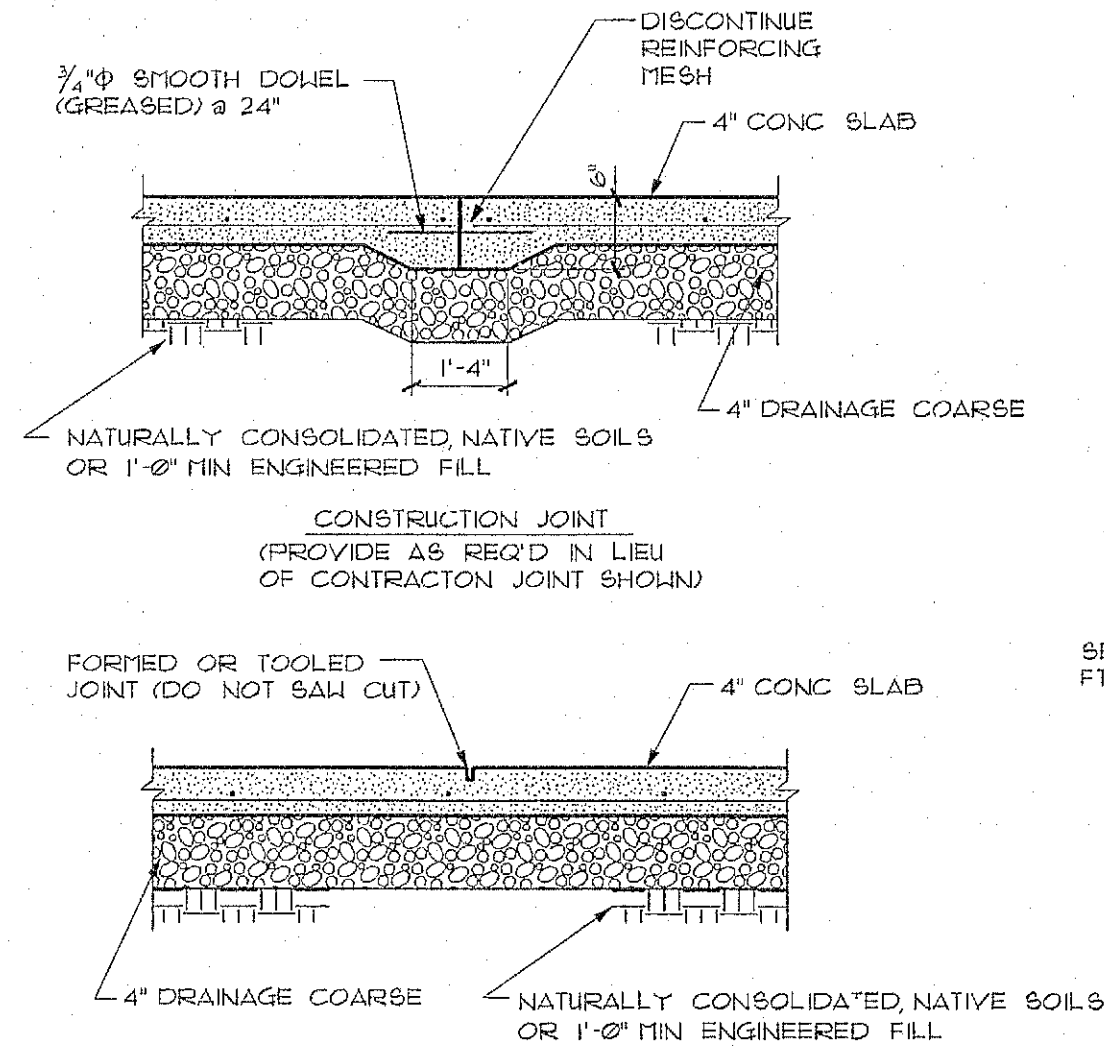


2 JOINT DETAILS
S202 REF S101
3/4"=1'-0"

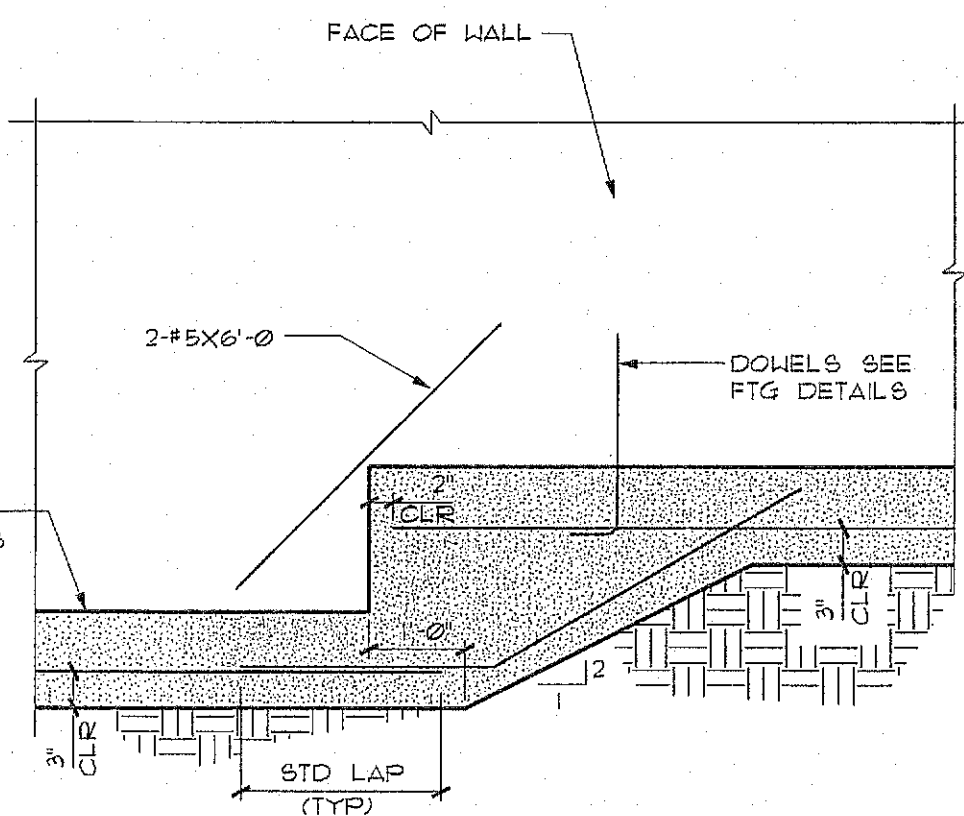


3 FOOTING STEP DETAIL
S202 REF S101
3/4"=1'-0"

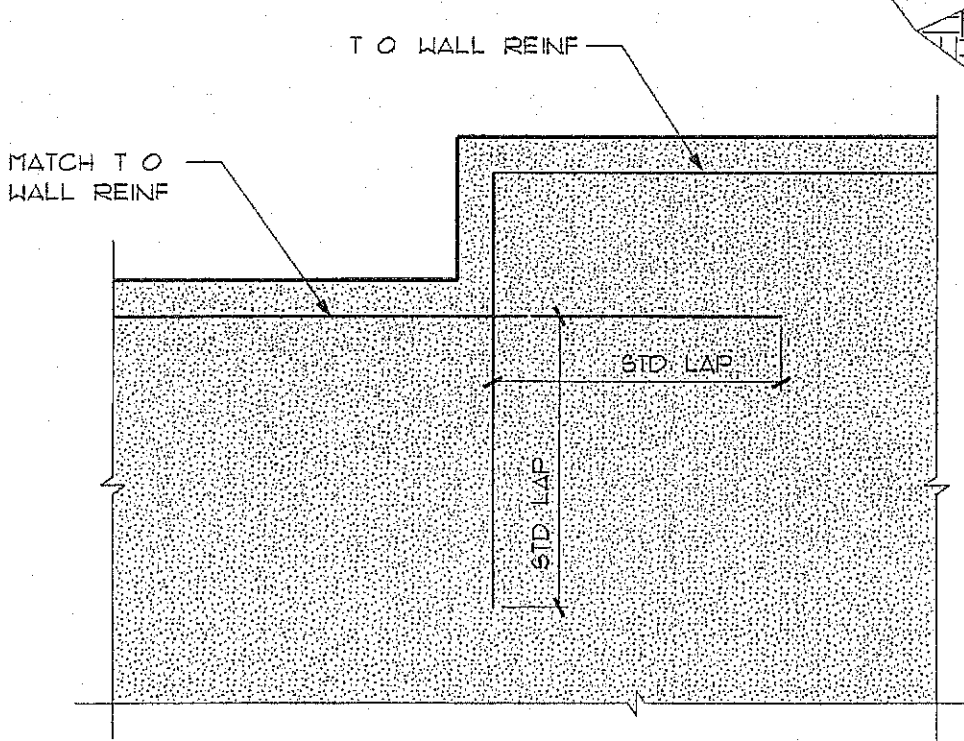


4 TOP OF WALL STEP DETAIL
S202 REF S101
3/4"=1'-0"

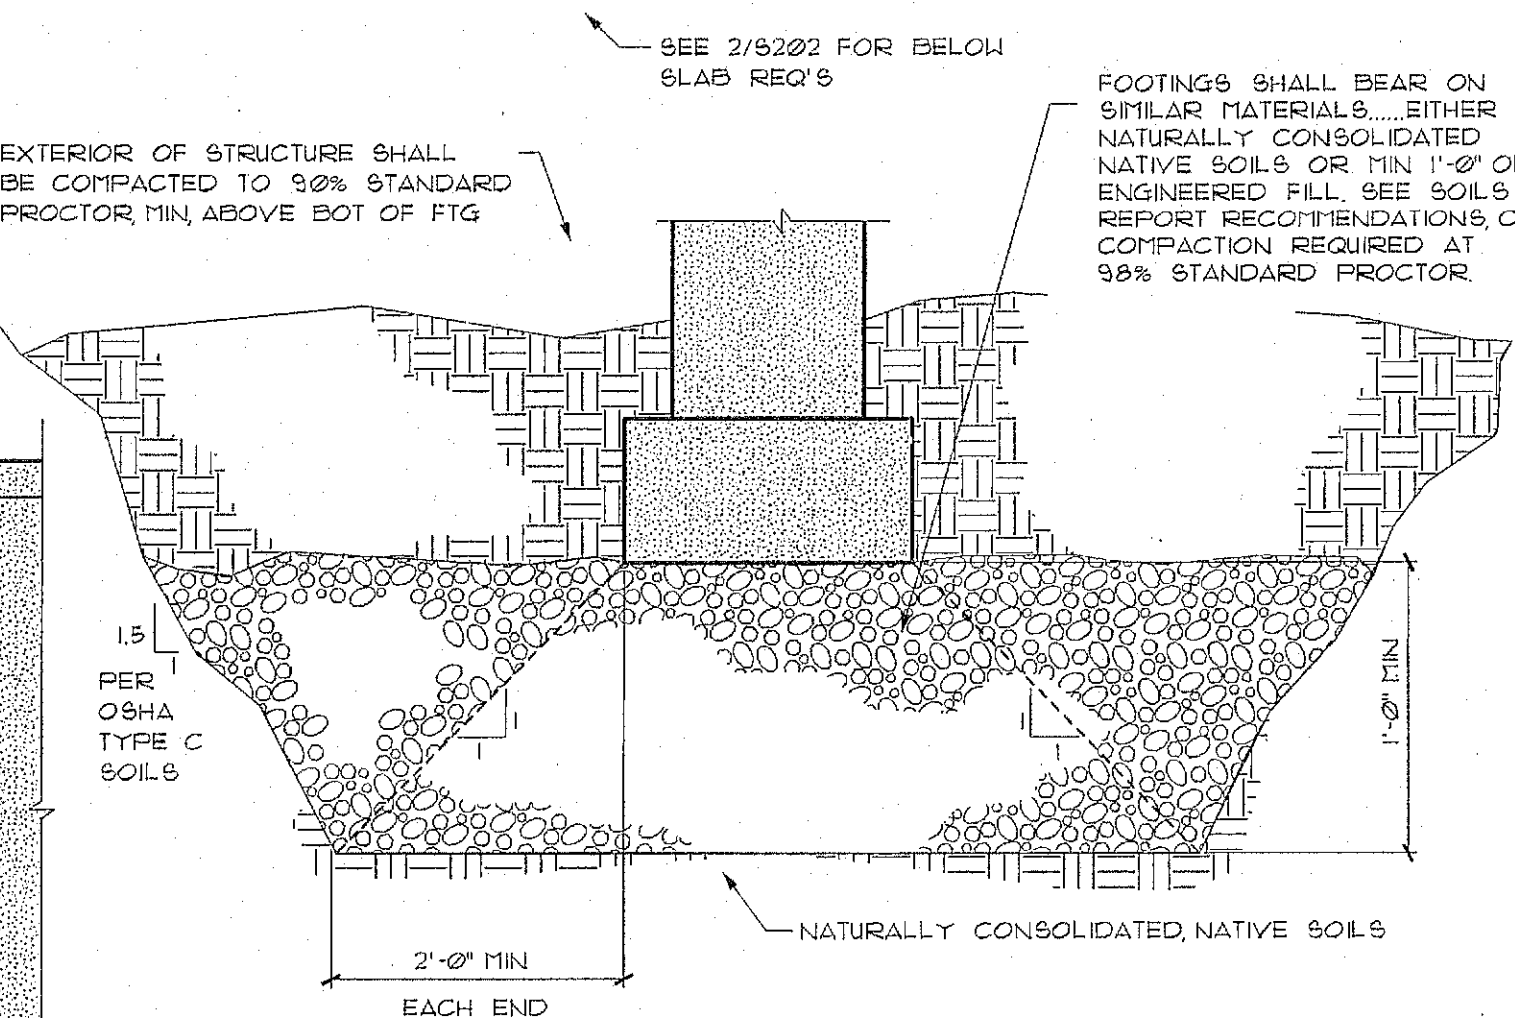


5 ENGINEERED SUB-GRADE SECTION
REQUIRED BELOW ALL FOOTINGS
S202 REF S101
NTS

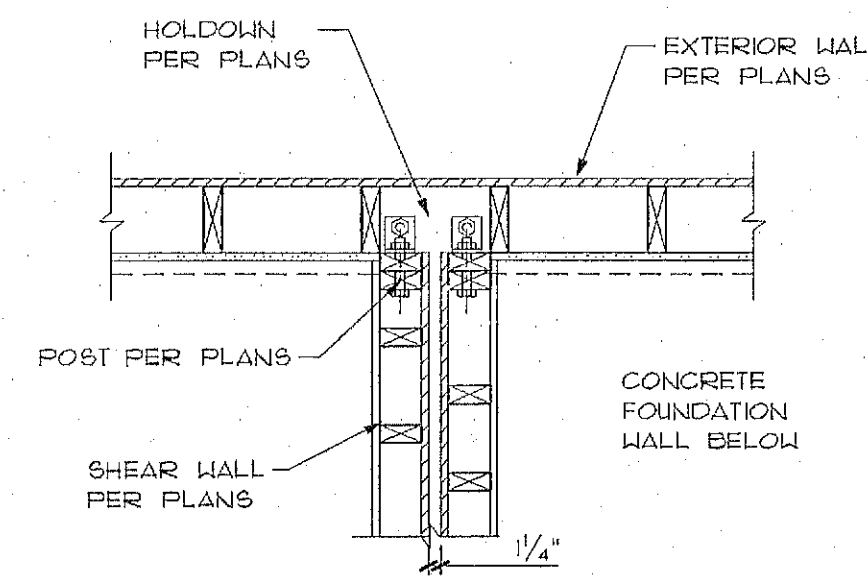


6
S202 REF S101 4 S102
3/4"=1'-0"

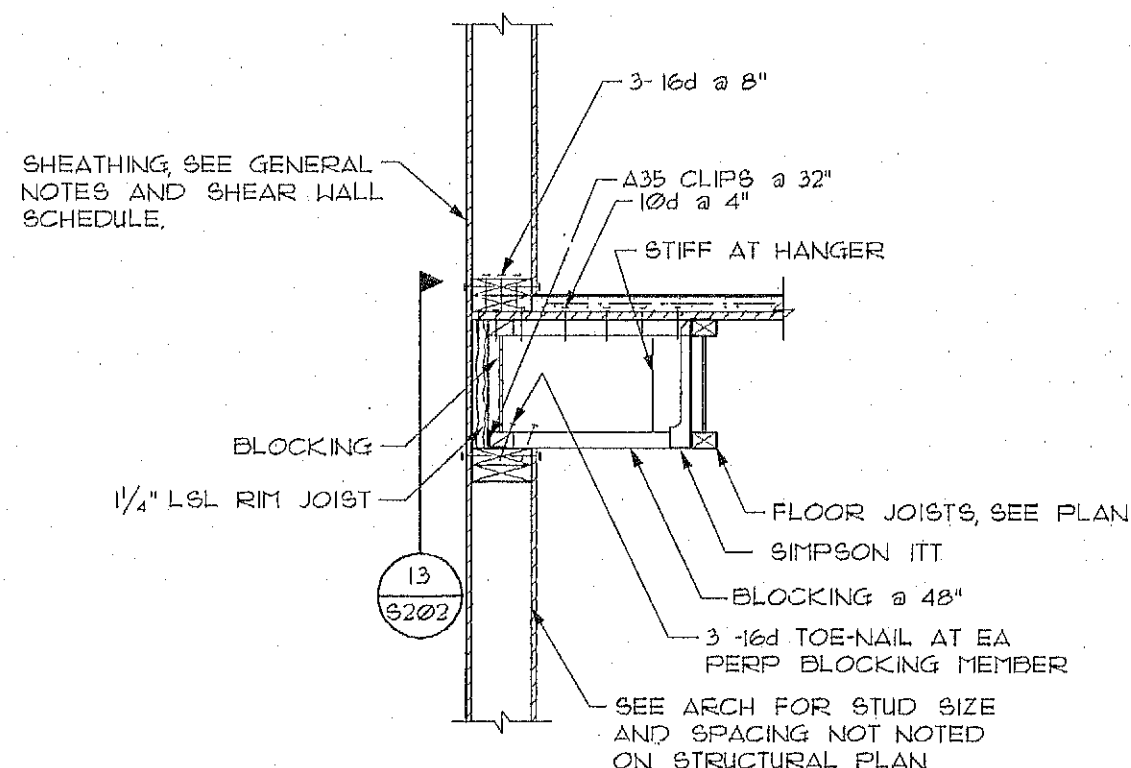


7
S202 REF S102
3/4"=1'-0"

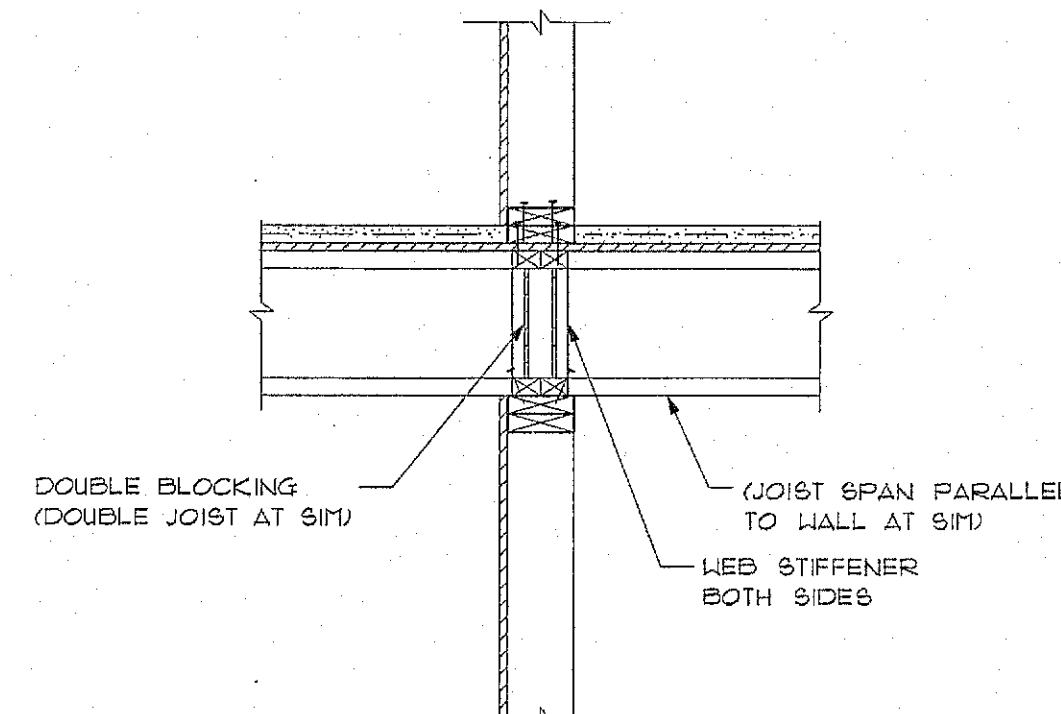


8
S202 REF S17
3/4"=1'-0"

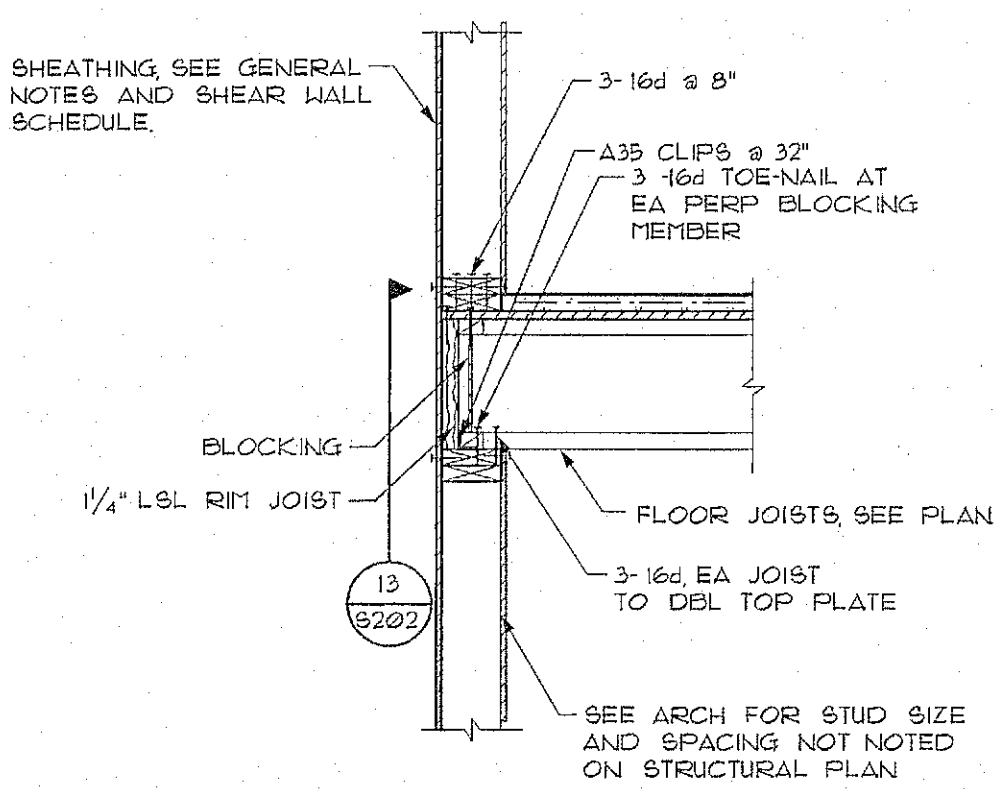


9
S202 REF S17
3/4"=1'-0"

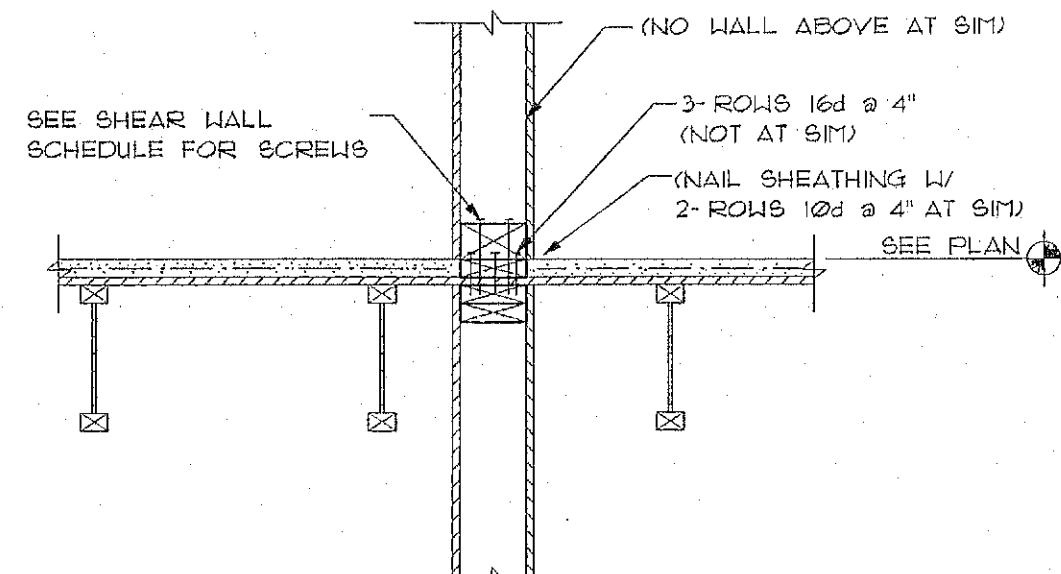


10
S202 REF S17
3/4"=1'-0"

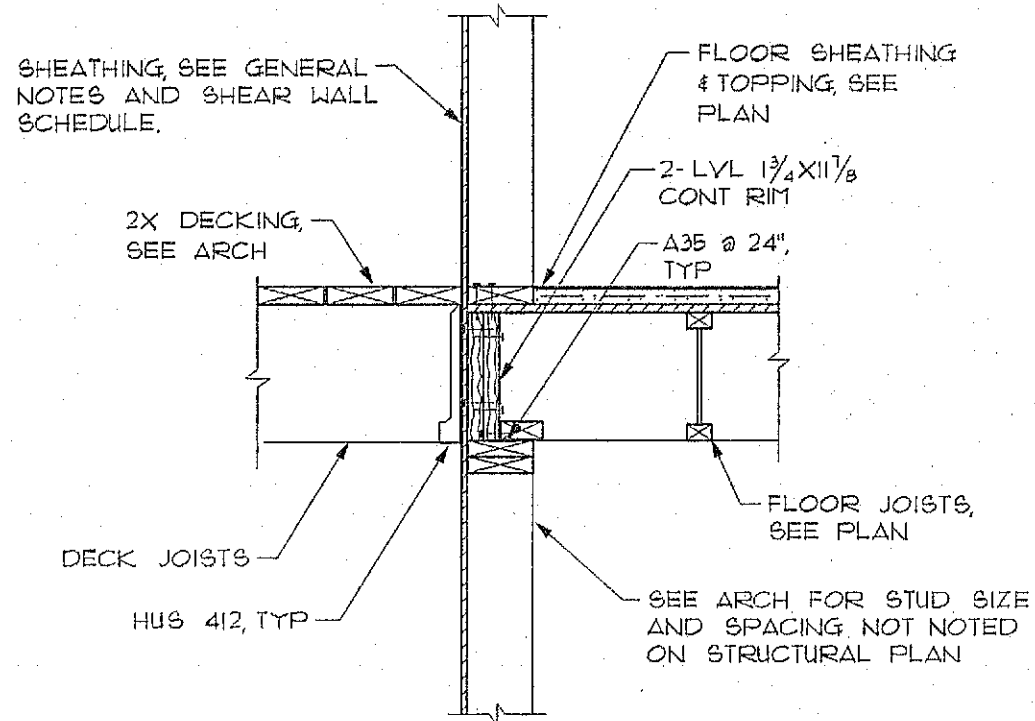


11
S202 REF S17
3/4"=1'-0"

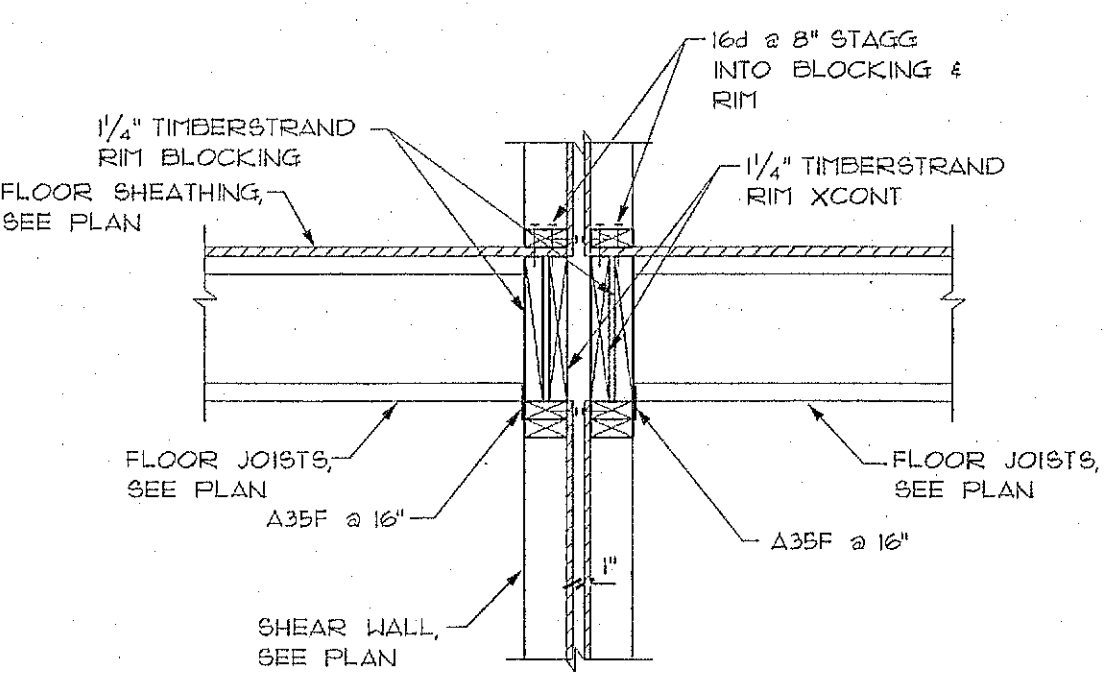


12
S202 REF S102 4 S103
3/4"=1'-0"

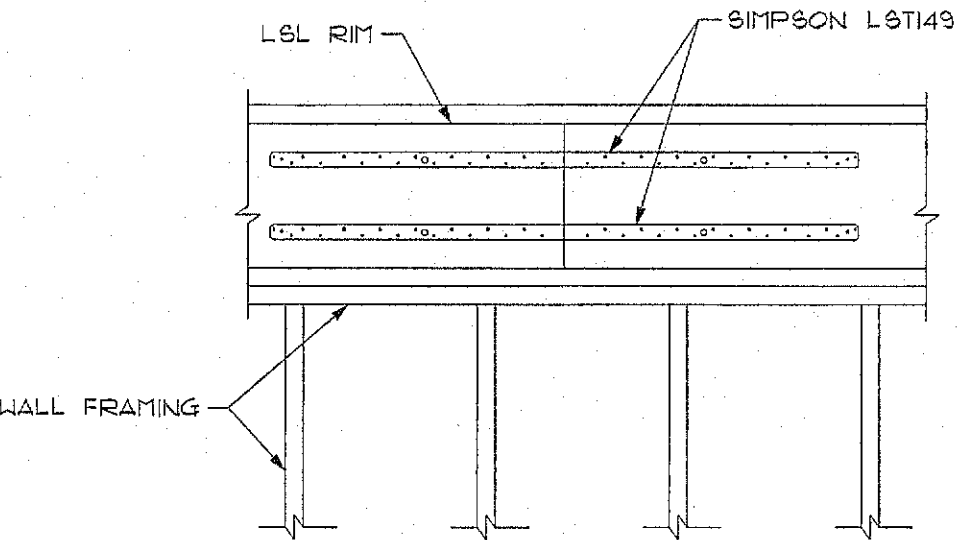

13 TYPICAL RIM BOARD SPLICE
S202 REF S102
3/4"=1'-0"

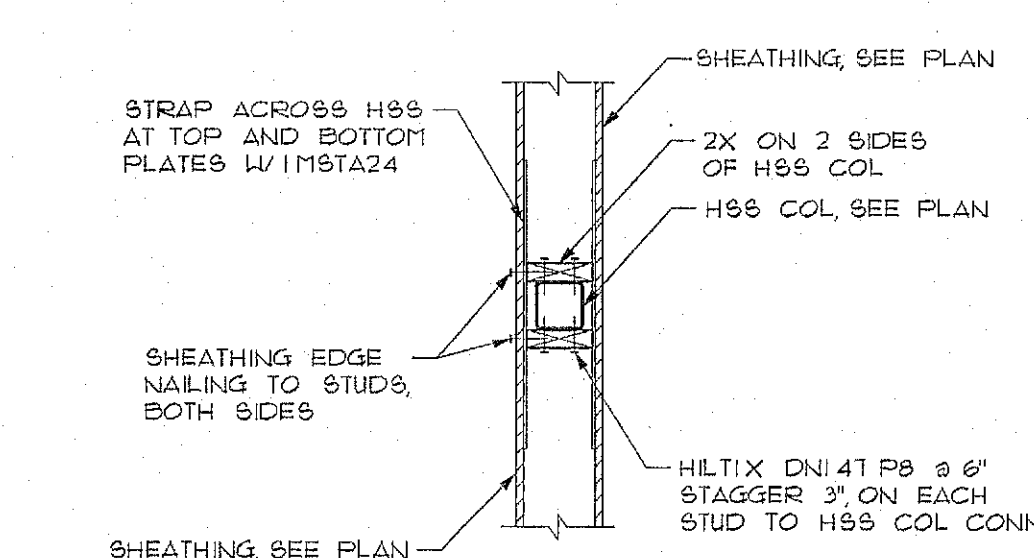

14
S202 REF S102
3/4"=1'-0"

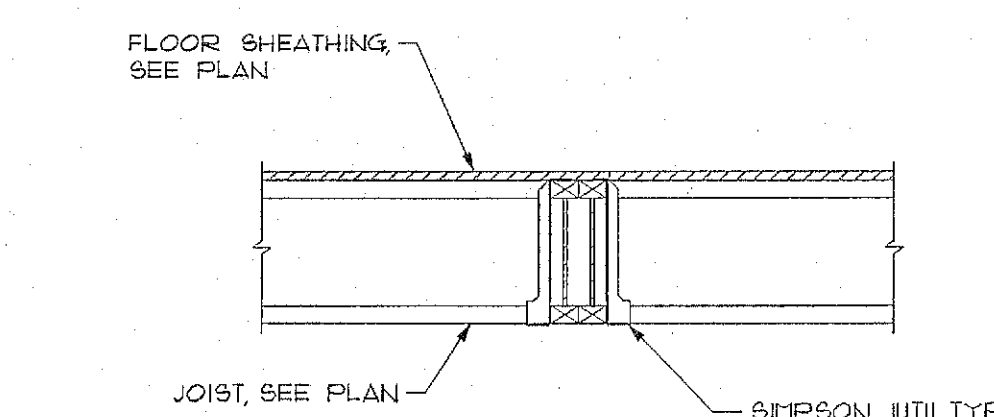

15
S202 REF S102
3/4"=1'-0"

20'-0"
10'-0"
5'-0"
0
5'-0"

REVISIONS:

ALPENGLOW at Big Sky BIG SKY, MT Uphill Unit

AS-BUILTS

COPYRIGHT 2003
CTA
ARCHITECTS
ENGINEERS
BILLINGS • MISSOULA
BOISE • GREAT FALLS
HELENA • KANSAS
SPOKANE
ALL RIGHTS RESERVED
















DRAWN BY: BML
CHECKED BY: SHB
DATE: 9-1-04
CTA # MAU09
CADD FILE: MAU09203
DIR: KAMAUS

CTA
ARCHITECTS
ENGINEERS
BILLINGS • MISSOULA
BOISE • GREAT FALLS
HELENA • KANSAS
SPOKANE

STRUCTURAL DETAILS




SHEET

S203 OF 12

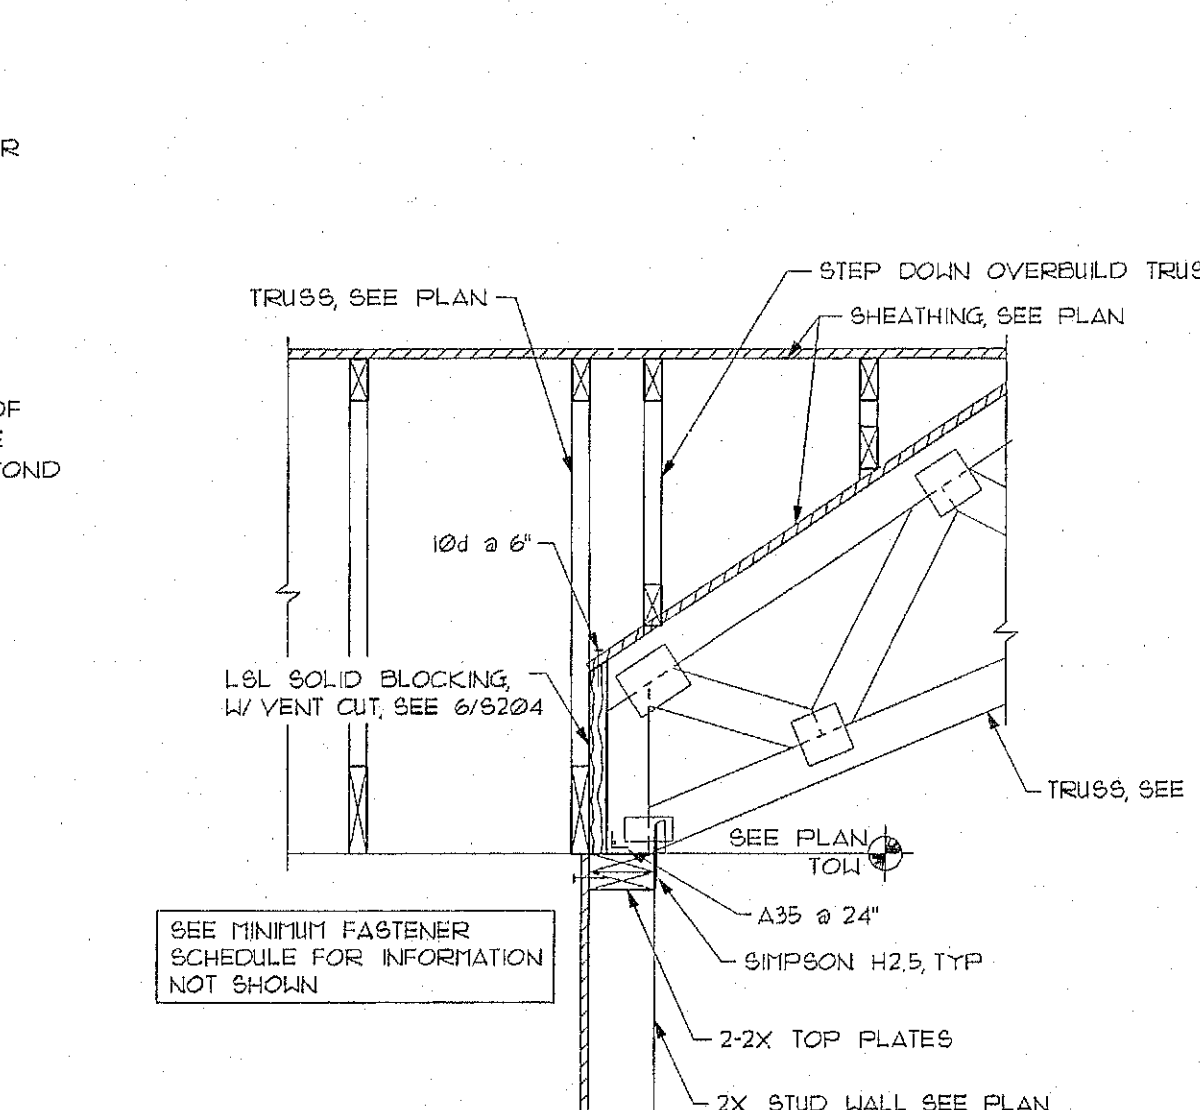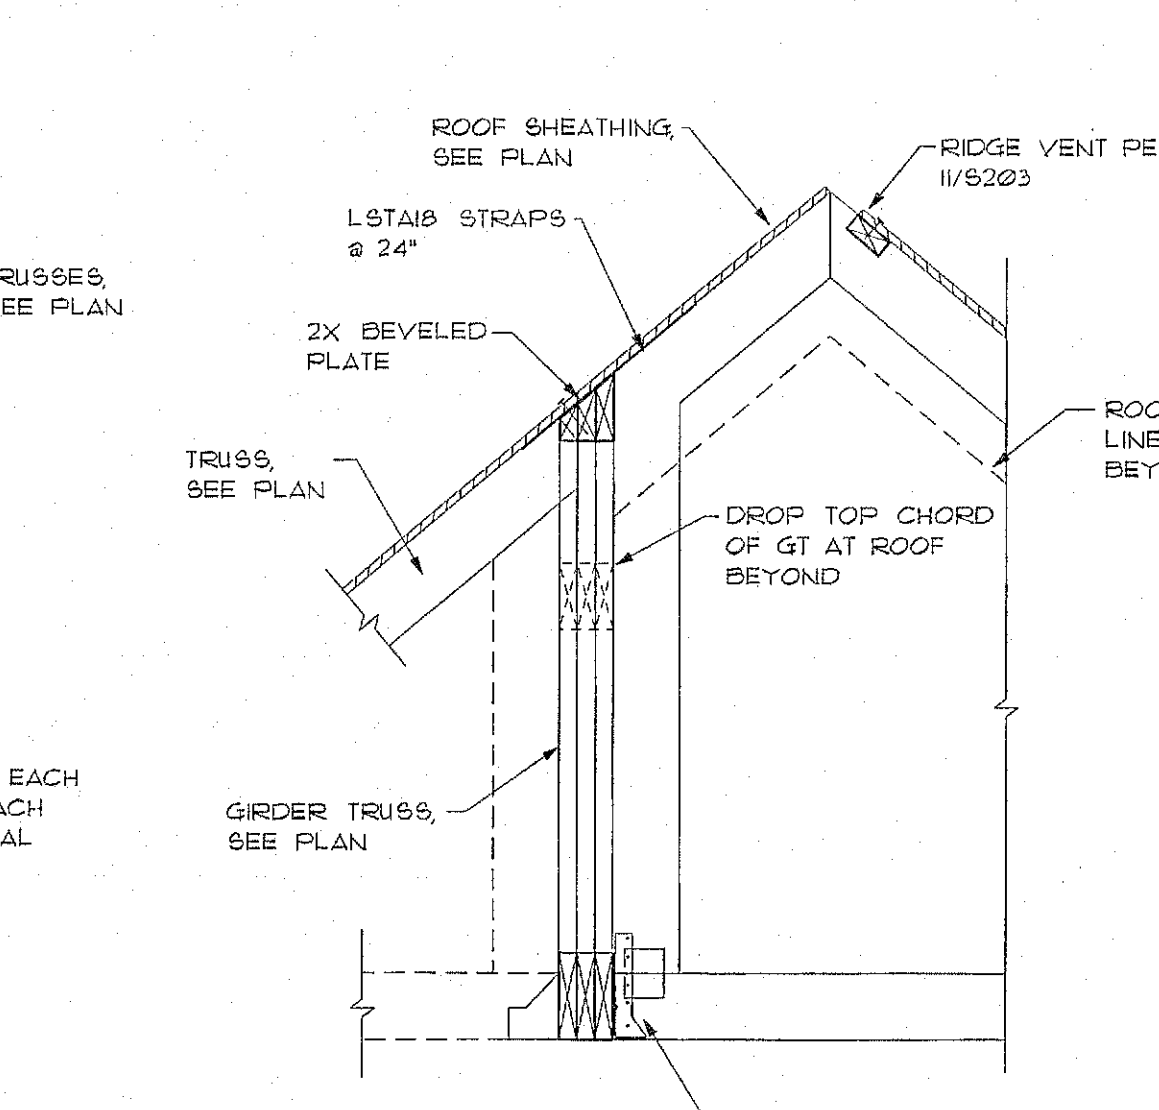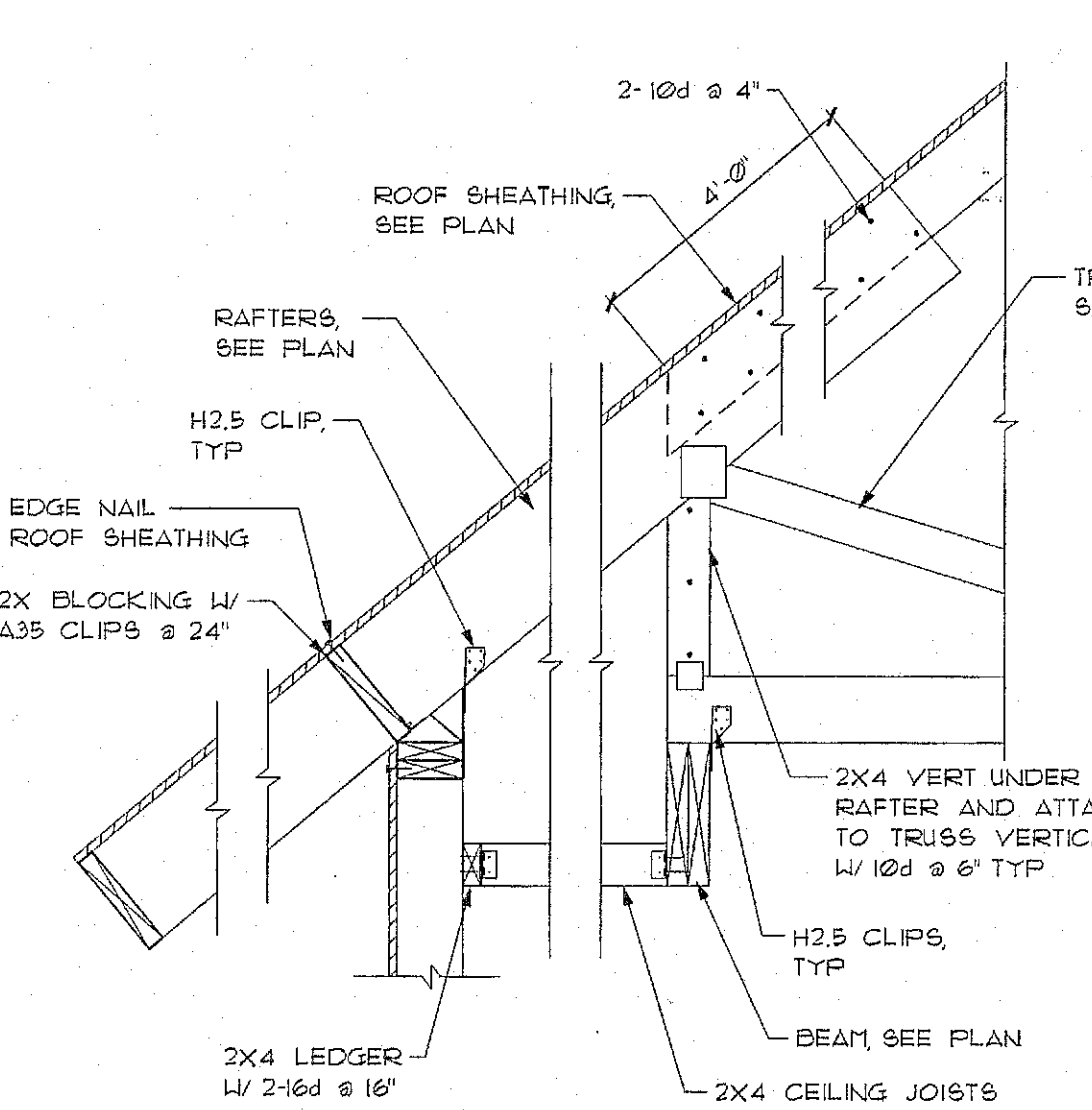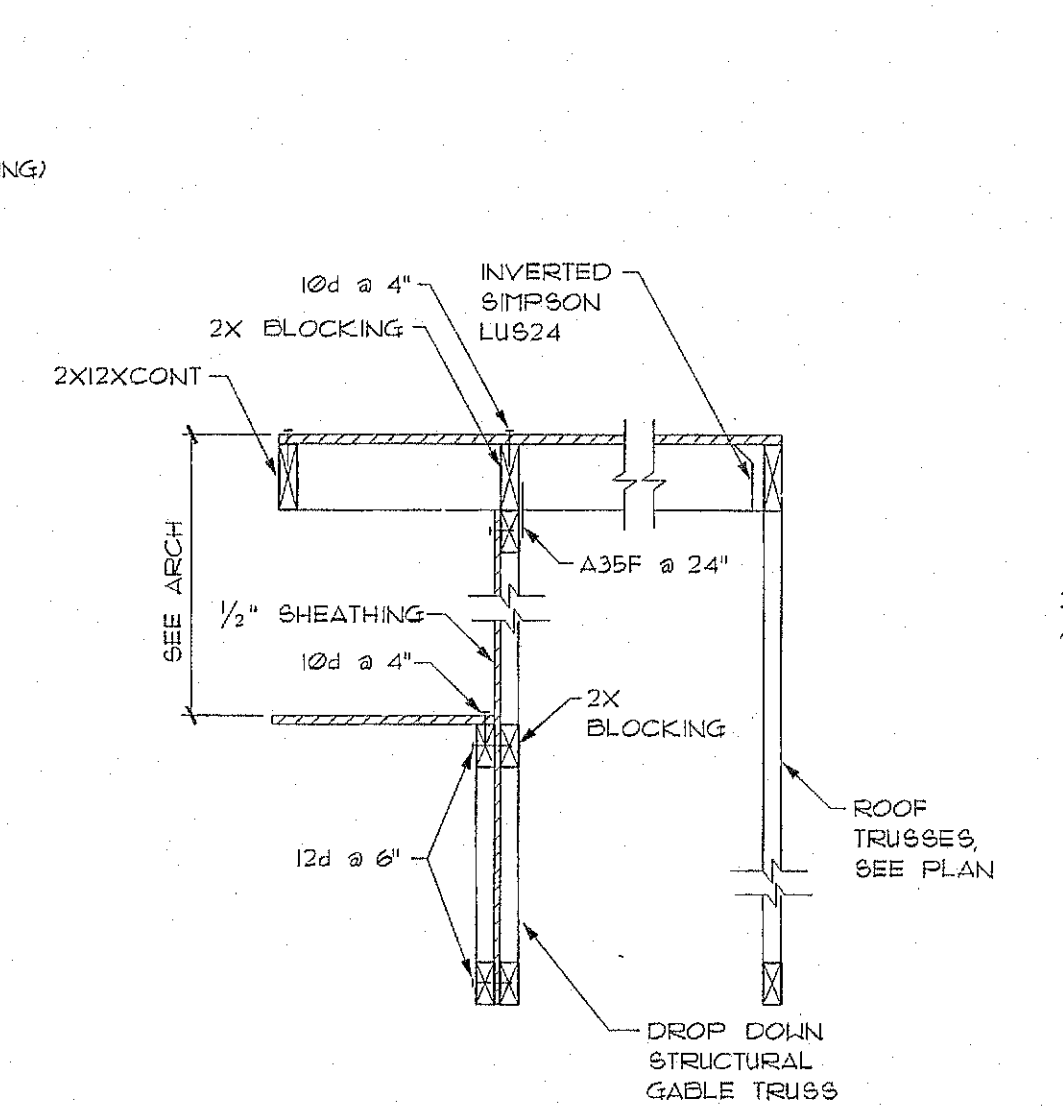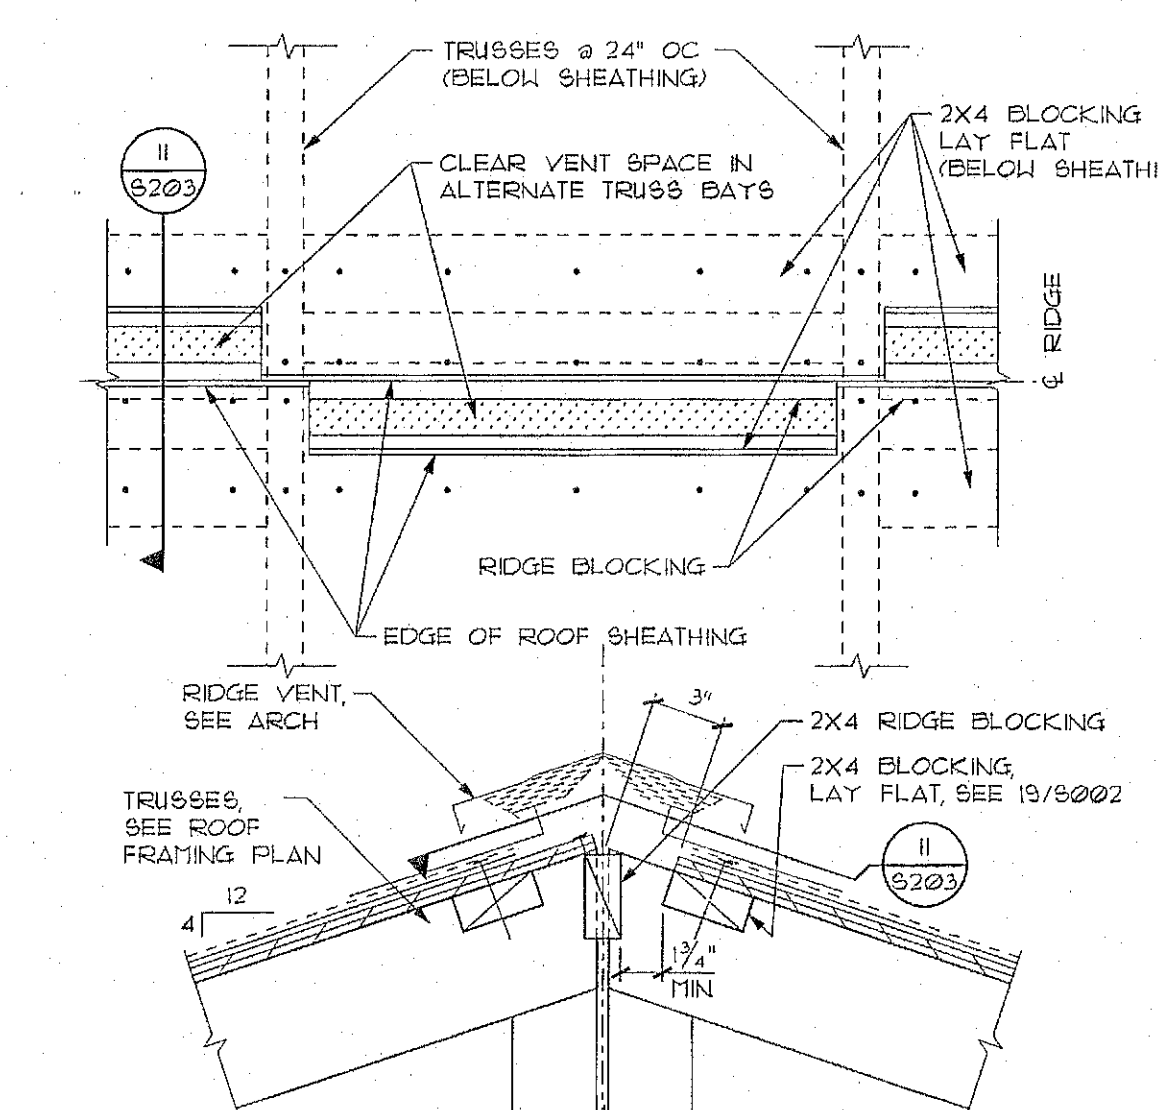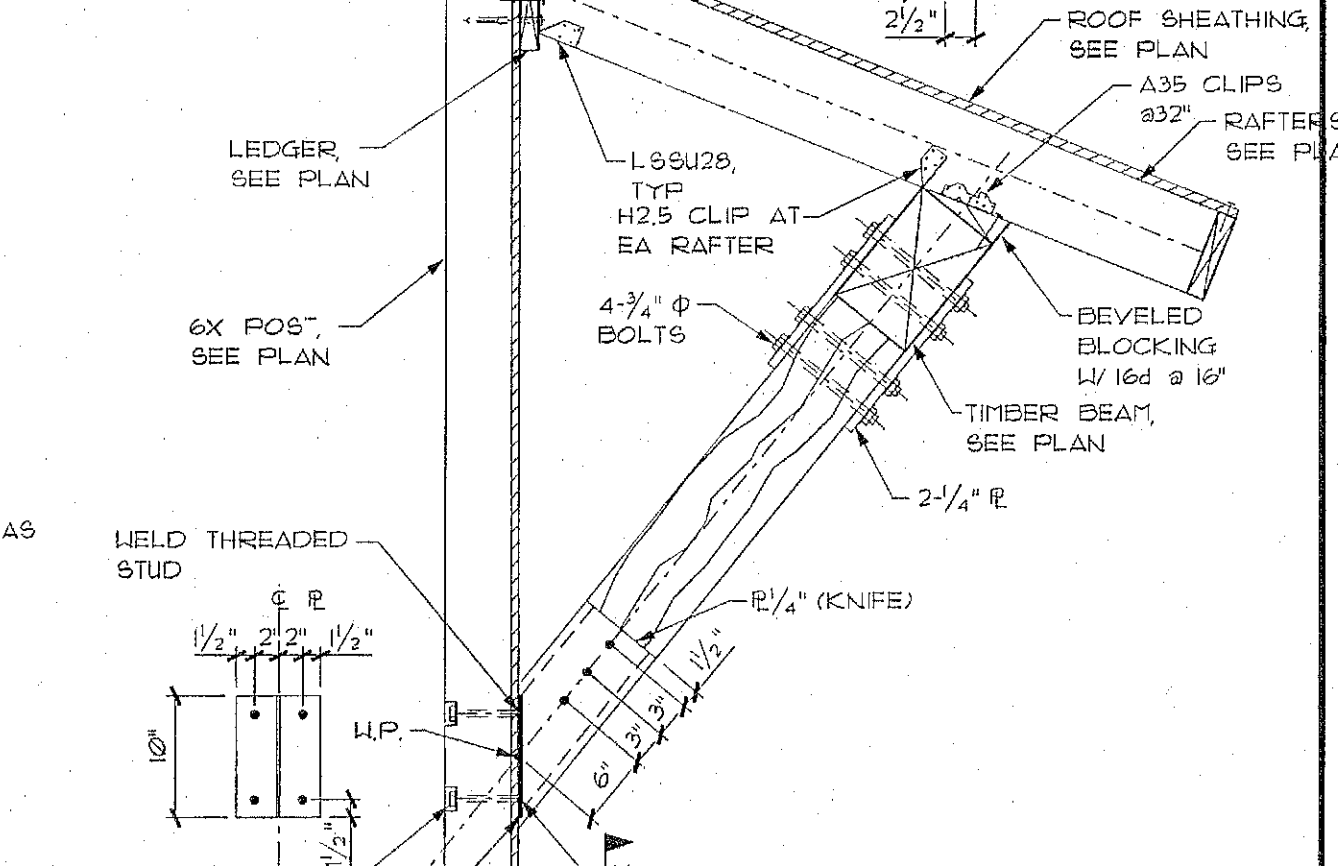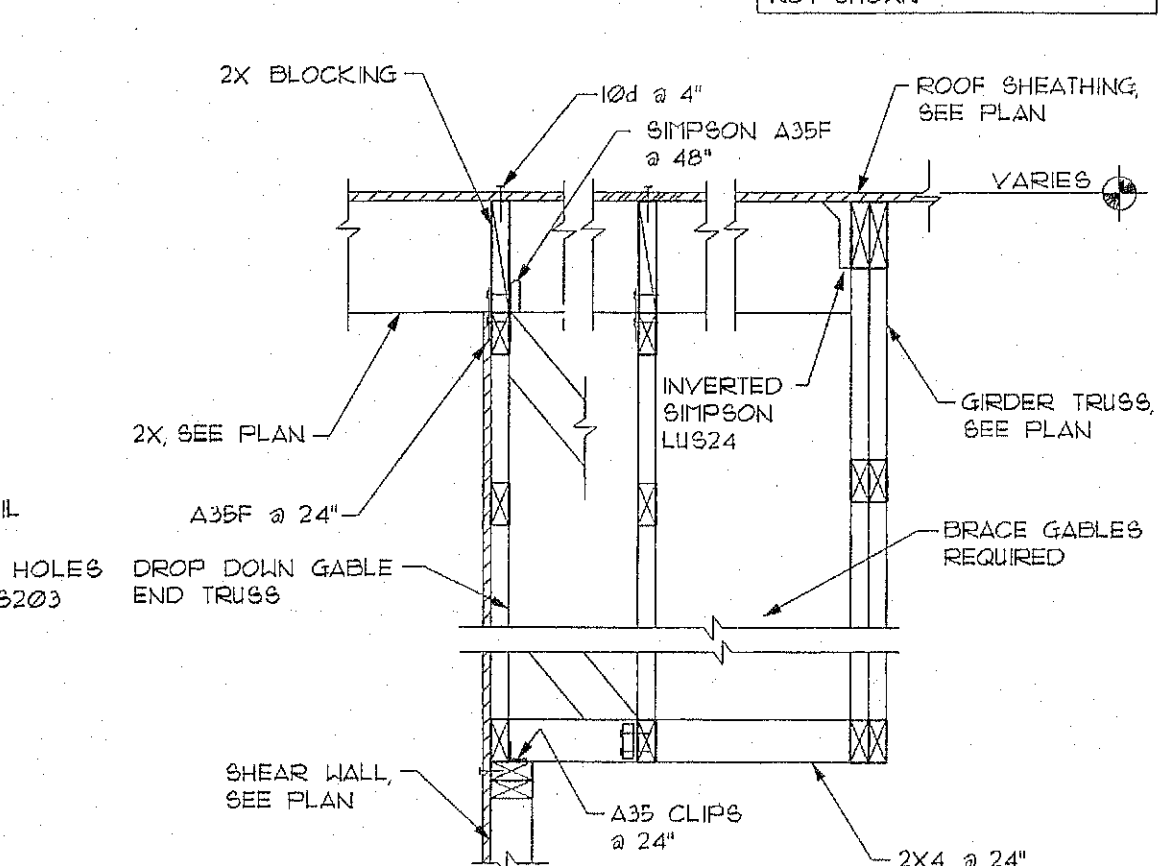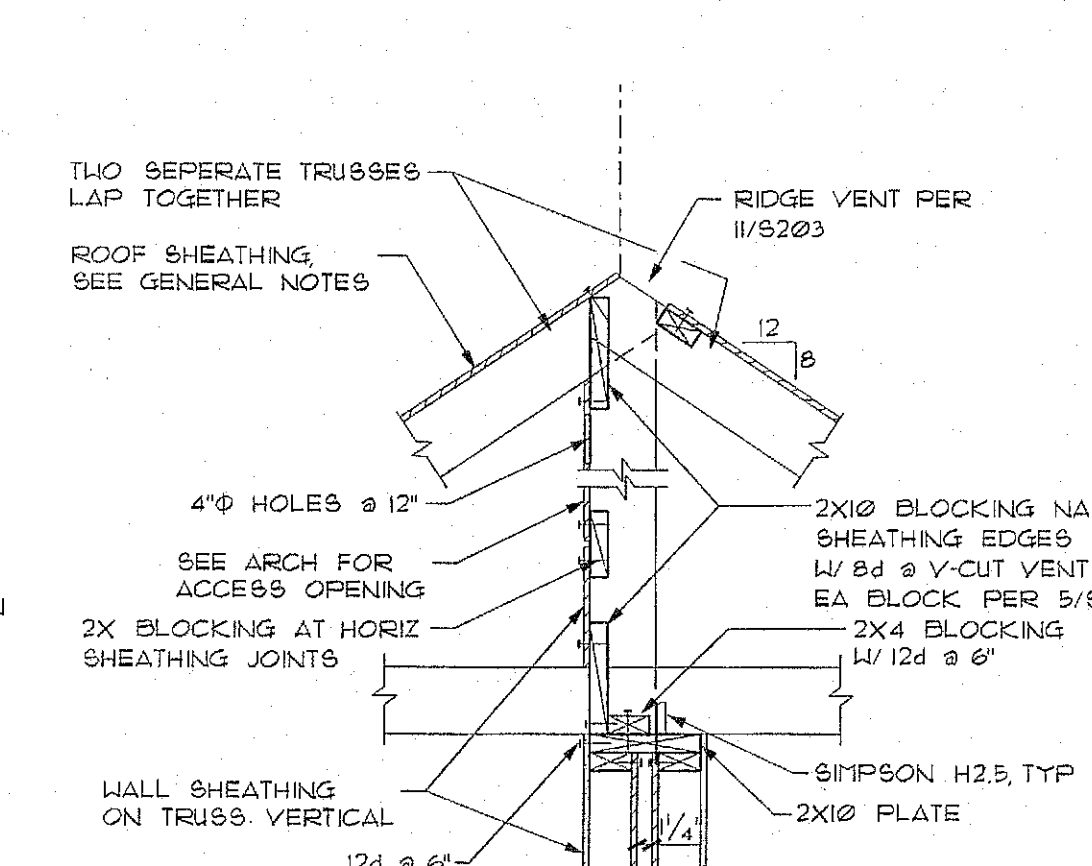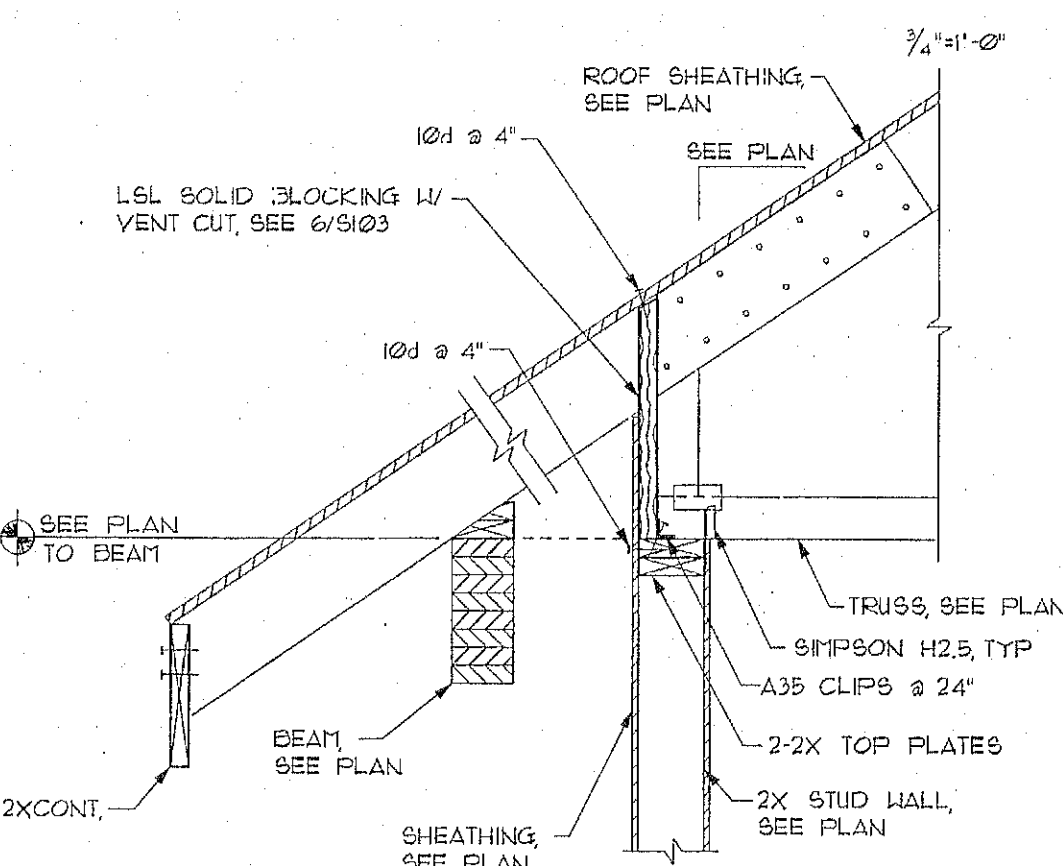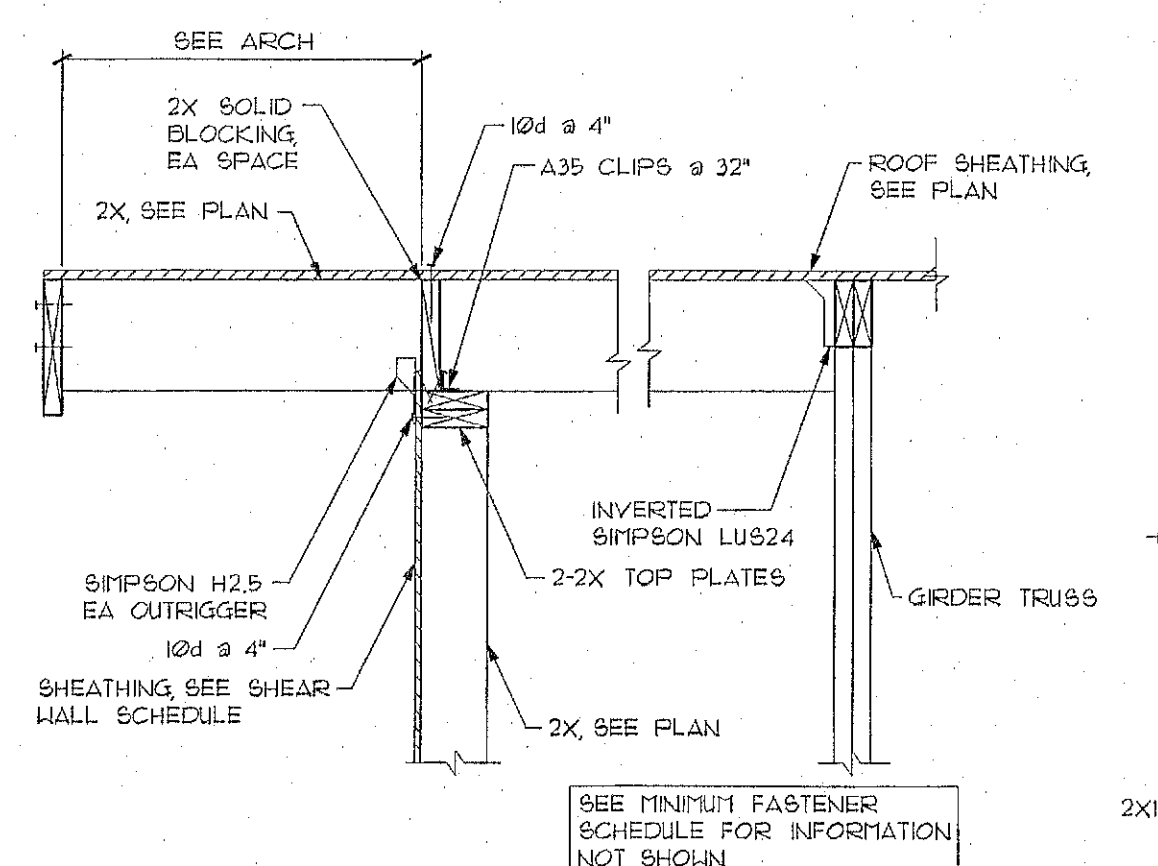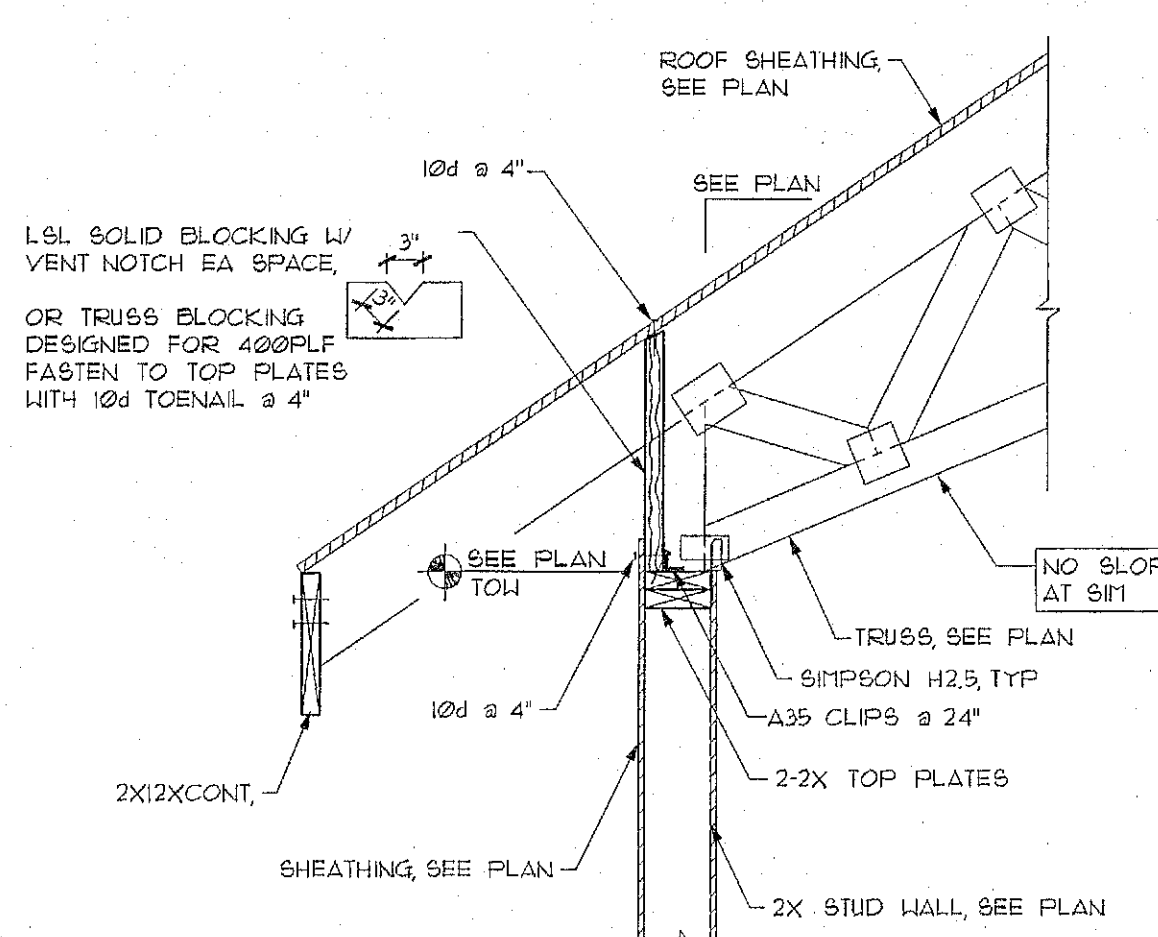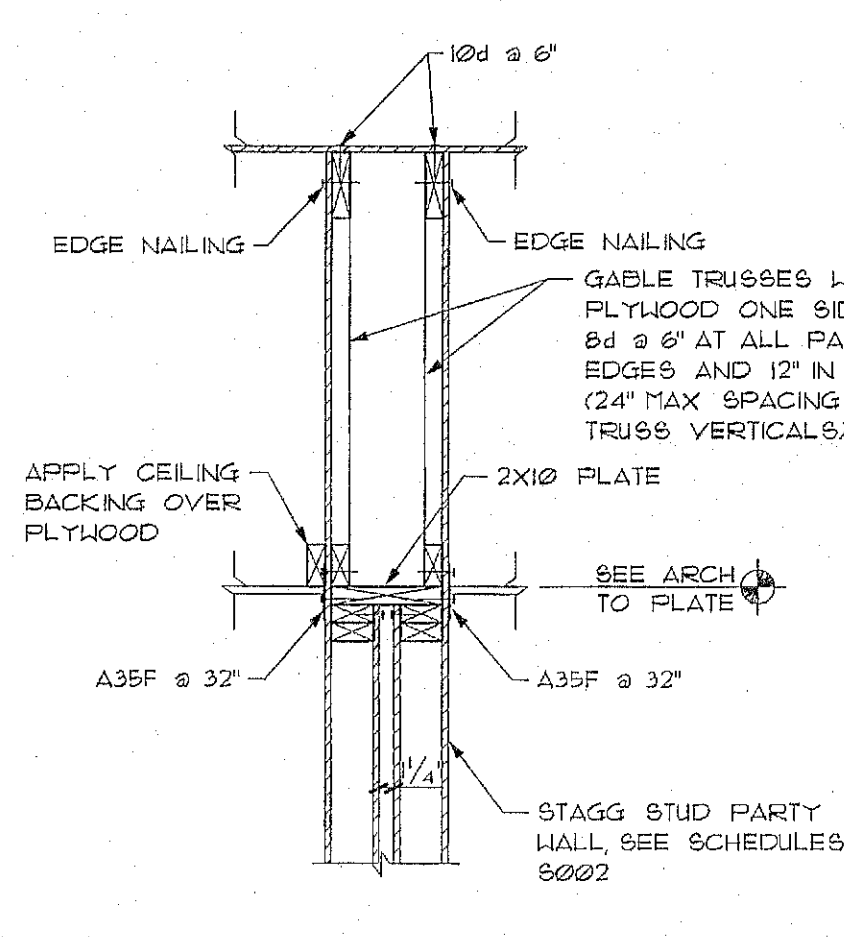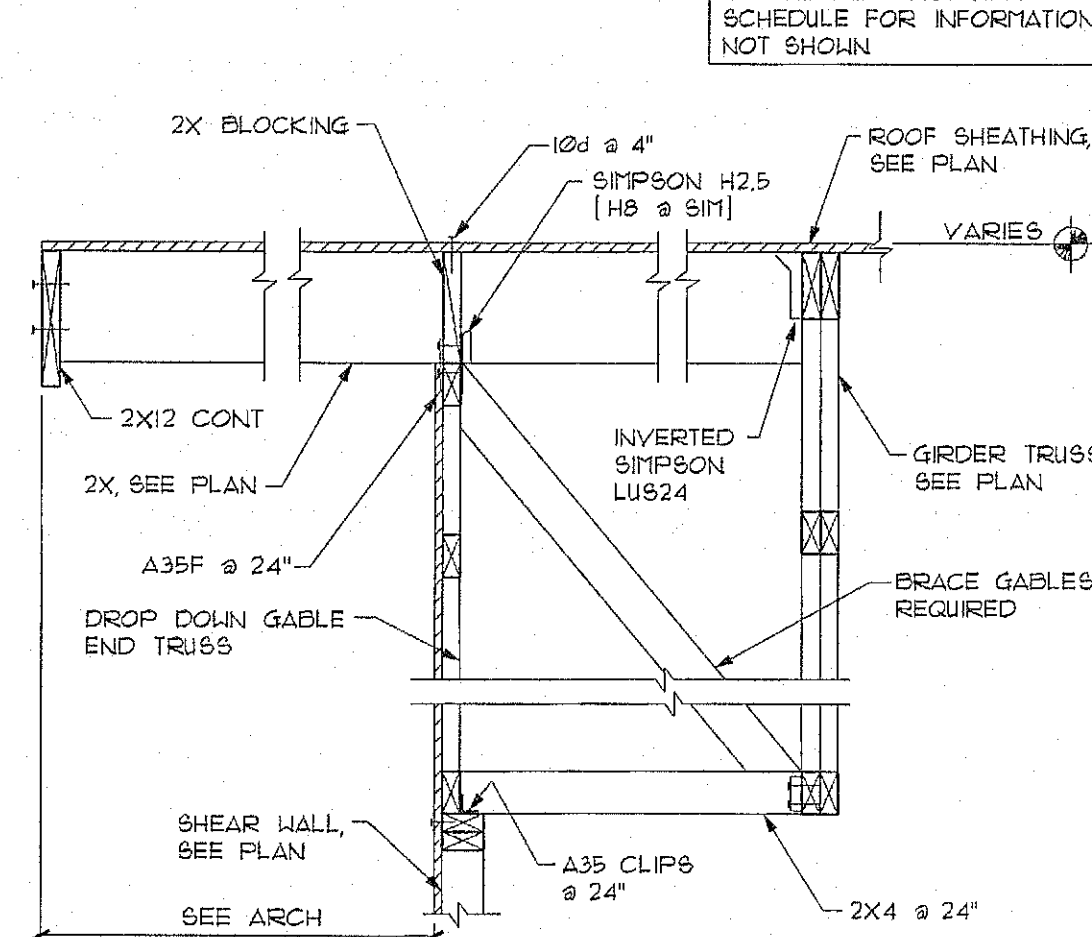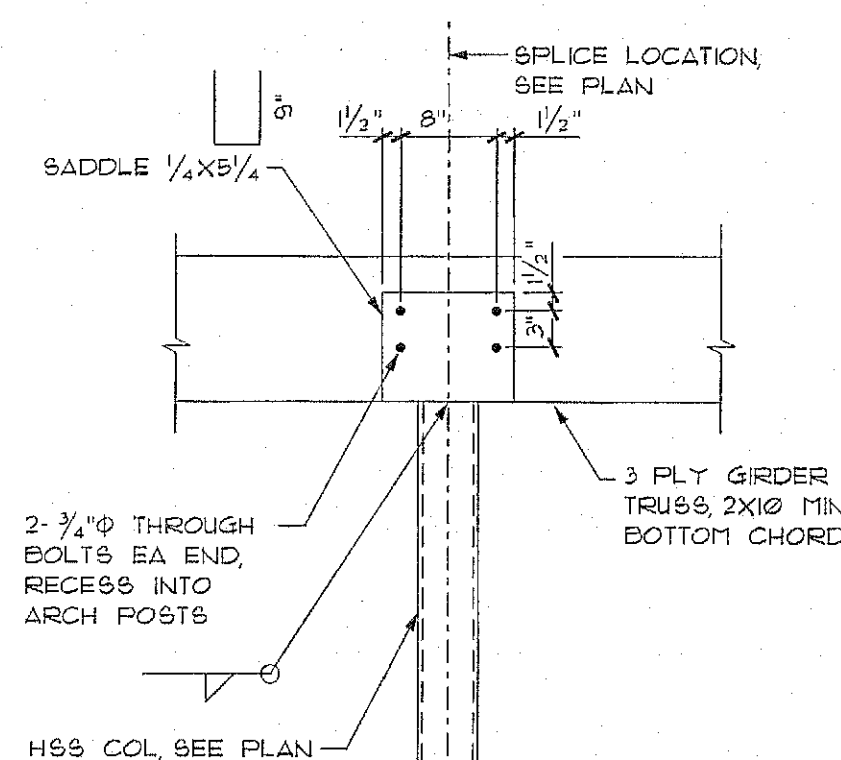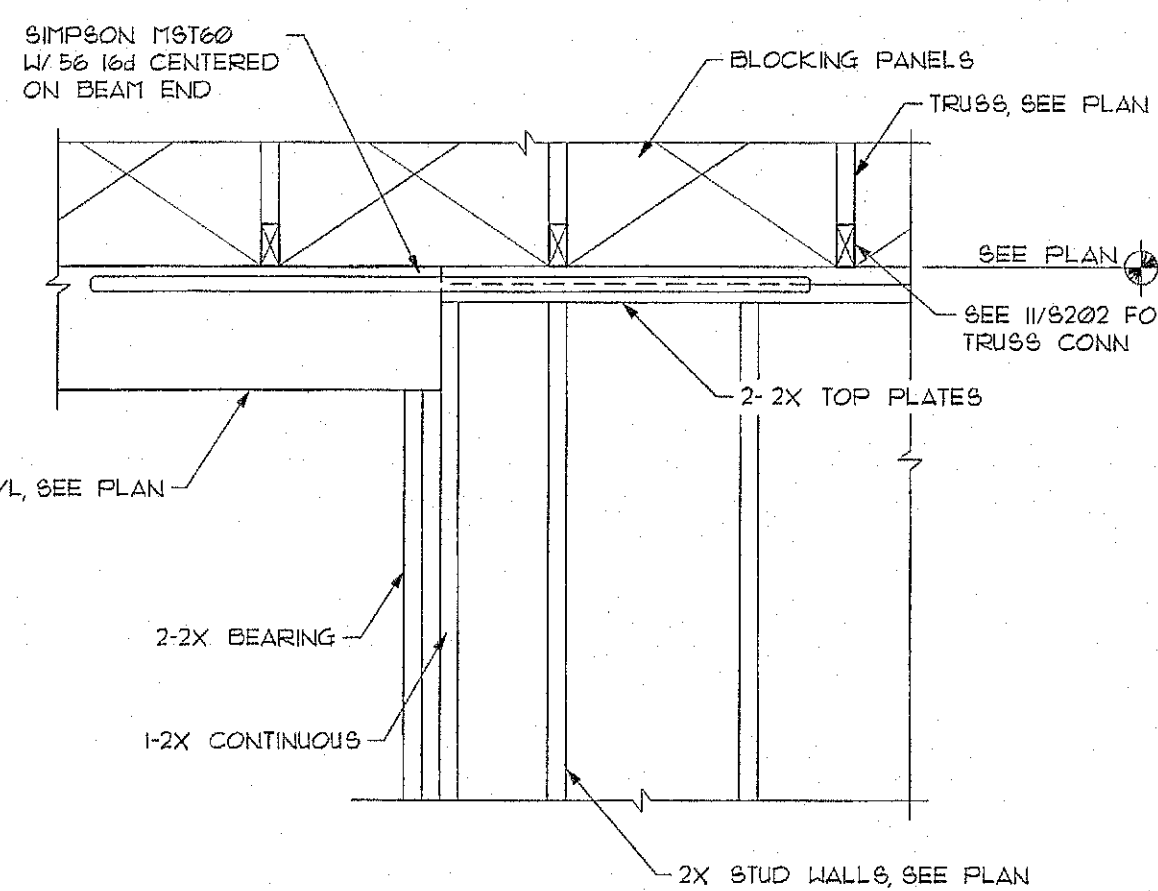

20'-0"
10'-0"
5'-0"
0'

20'-0"
10'-0"
5'-0"
0
5'-0"
10'-0"
20'-0"

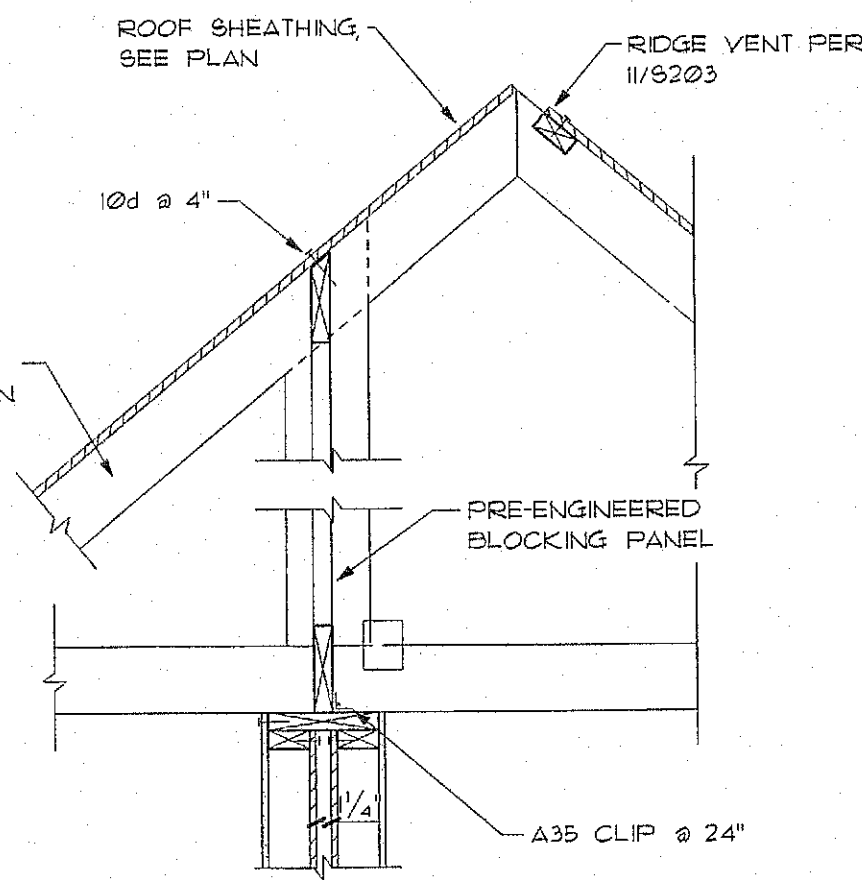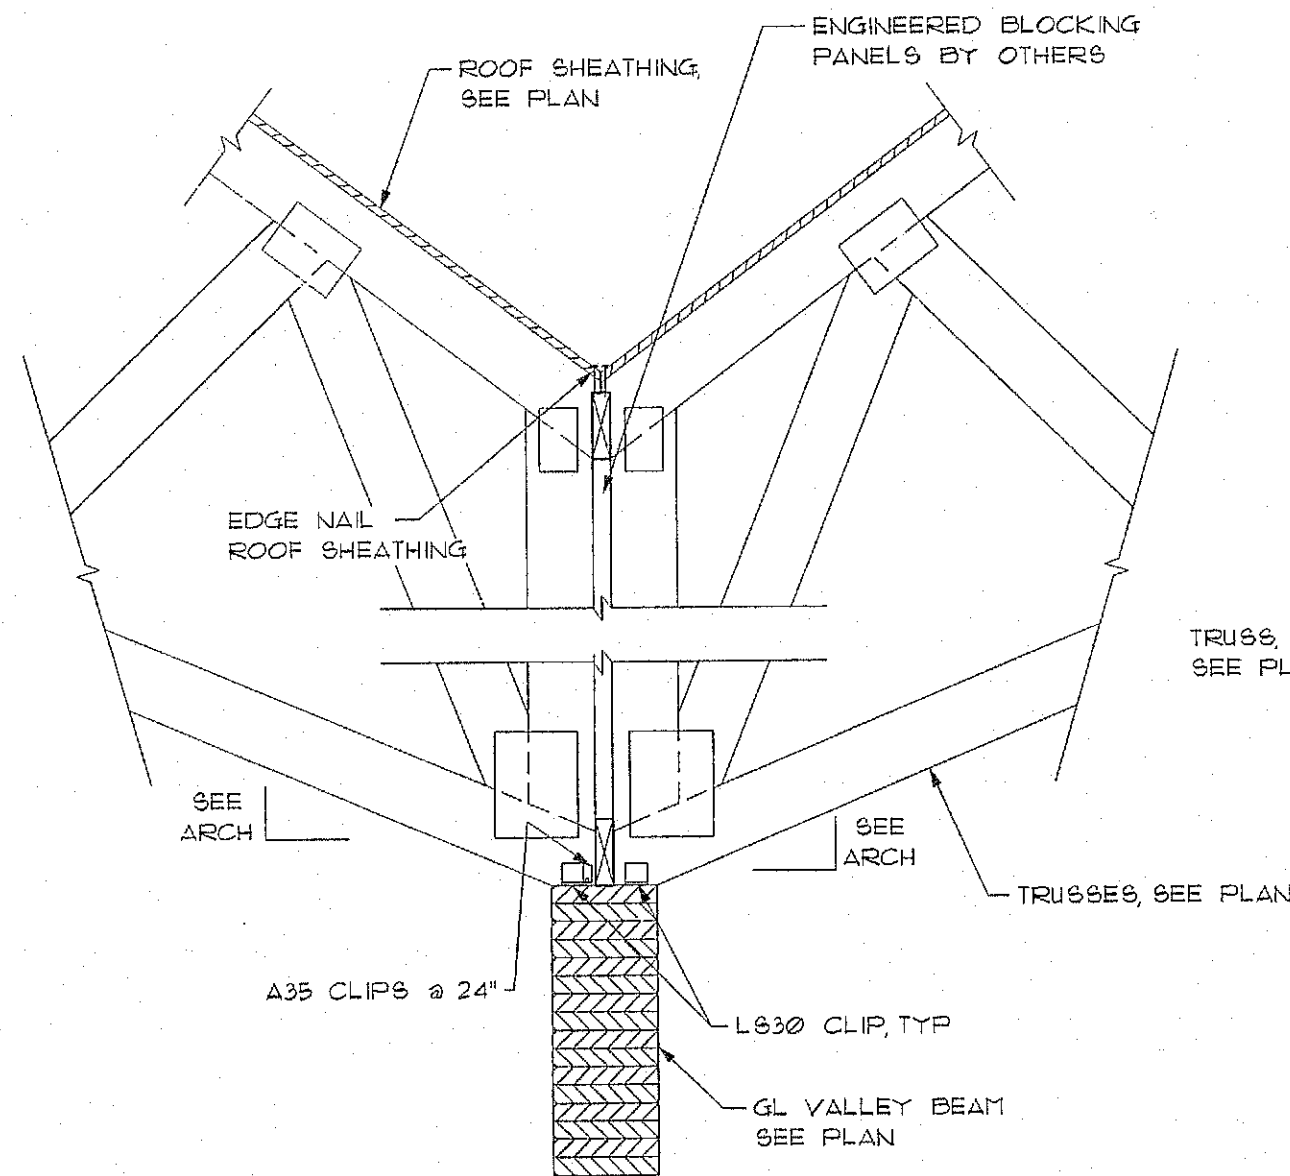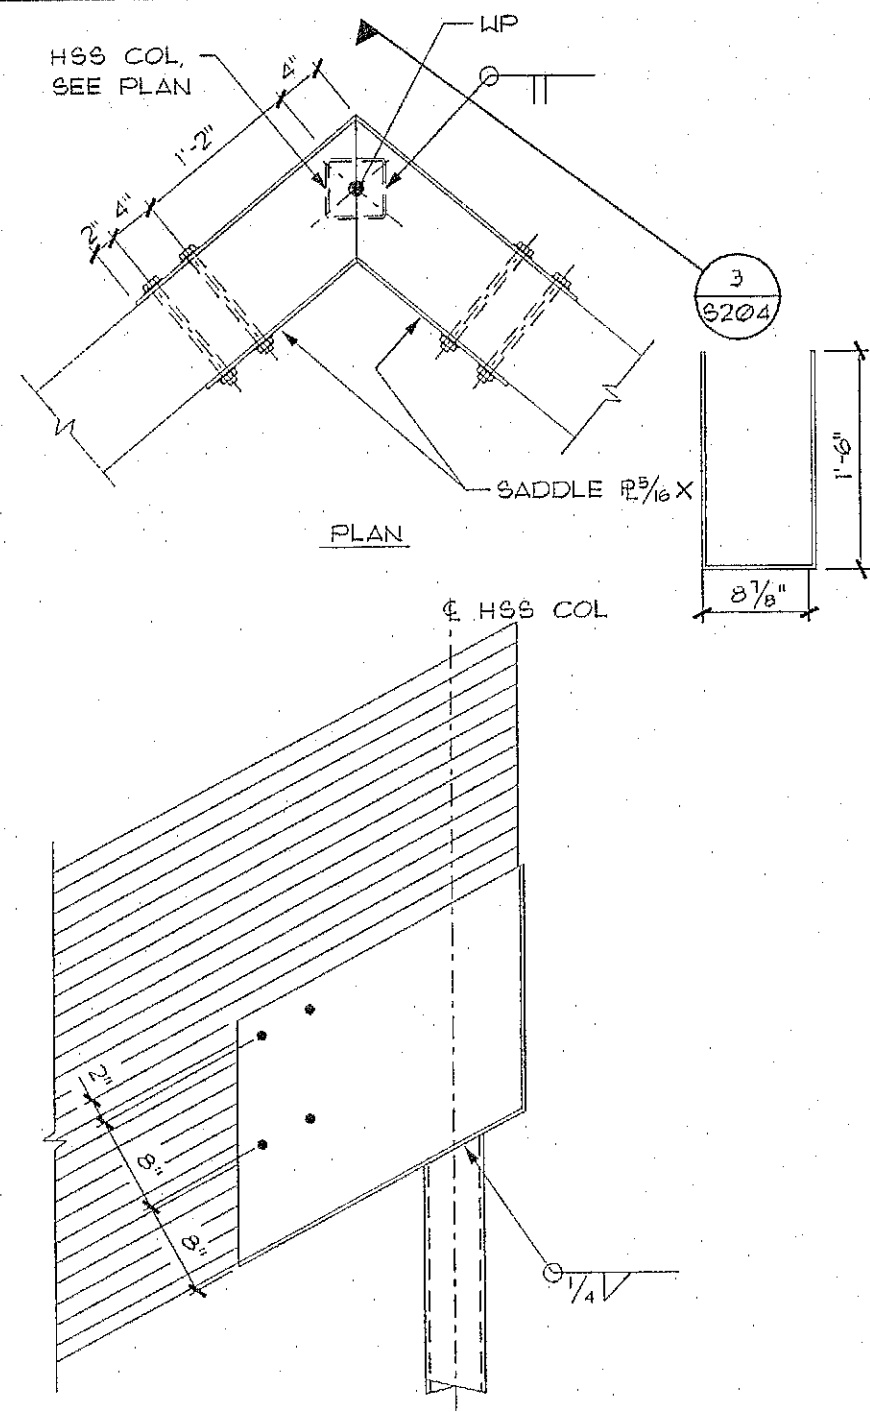

1
S204 REF 9103 3/4"=1'-0"

2
S204 REF 9103 3/4"=1'-0"

3
S204 REF 9103 3/4"=1'-0"

4
S204 REF 9103 3/4"=1'-0"

5
S204 REF 9103 3/4"=1'-0"

6
S204 REF 9103 3/4"=1'-0"

7
S204 REF 9103 3/4"=1'-0"

8
S204 REF 9103 3/4"=1'-0"

9
S204 REF 9103 1 1/2"=1'-0"

10
S204 REF 9103 3/4"=1'-0"

11
S204 REF 9103 3/4"=1'-0"

12
S204 REF 9103 3/4"=1'-0"

13
S204 REF 9103 3/4"=1'-0"

14
S204 REF 9103 3/4"=1'-0"

14
S204 REF 9103 3/4"=1'-0"

REVISIONS

ALPENGLOW at Big Sky
BIG SKY, MT
Uphill Unit

AS-BUILTS



COPYRIGHT 2003
CTA
ARCHITECTS
ENGINEERS
BILLINGS • MISSOULA
BOISE • GREAT FALLS
HELENA • KALISPELL
SPOKANE
ALL RIGHTS RESERVED

DRAWN BY: BML
CHECKED BY: BMB
DATE: 9-1-04
CTA # 171115
CADD FILE: MAU99204
DIR: K:\MAU99

CTA
ARCHITECTS
ENGINEERS
BILLINGS • MISSOULA
BOISE • GREAT FALLS
HELENA • KALISPELL
SPOKANE

STRUCTURAL
DETAILS

SHEET
S204 OF 12

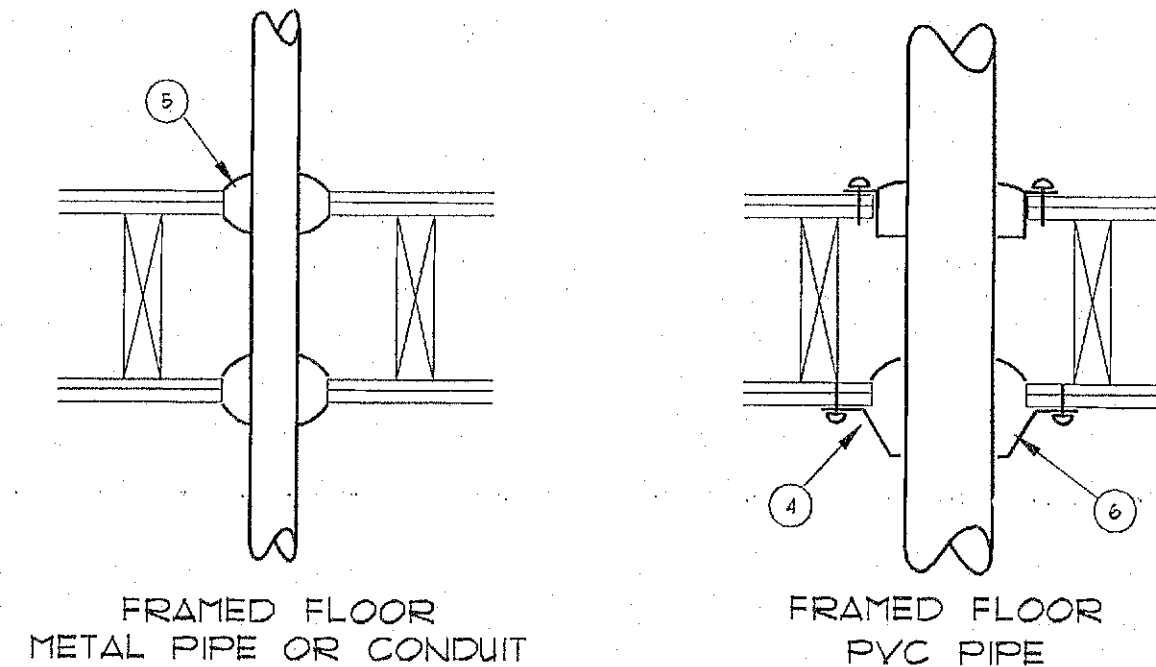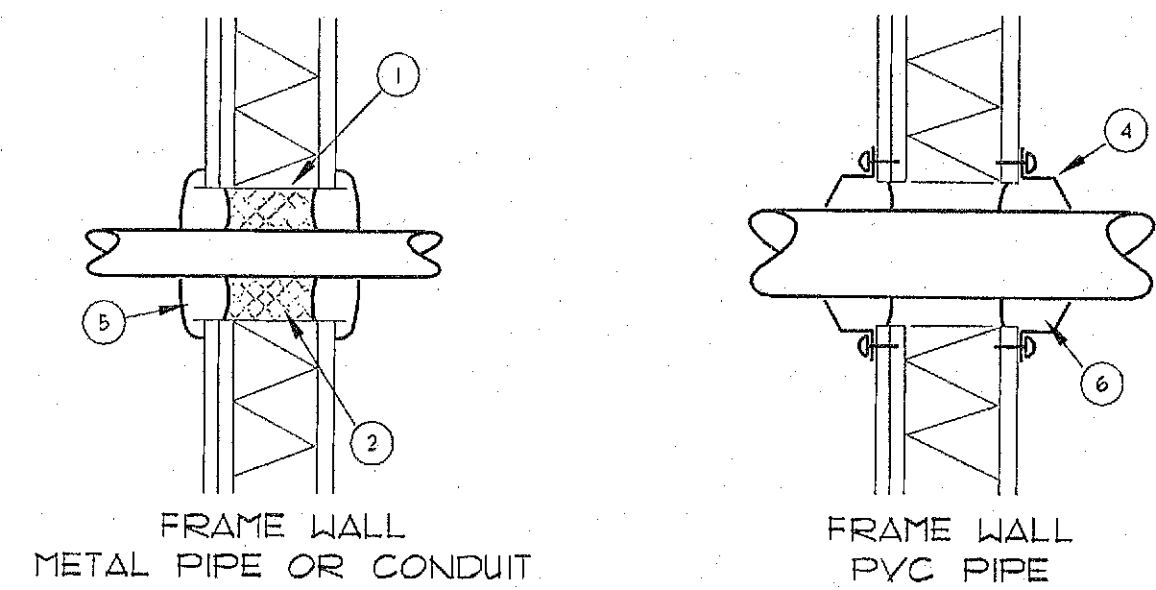




KEY

- 1 WIRE MESH OR SHEET METAL SLEEVE THRU OPENING.
- 2 MINERAL WOOL BACKING MATERIAL.
- 3 NOT USED.
- 4 METAL-TABBED RETAINING COLLAR AROUND OPENING AND FOLDED IN AFTER CAULKING IS APPLIED.
- 5 GUN OR TROWEL SPECIFIED FIRE STOPPING COMPOUND ALL AROUND OPENING ON BOTH SIDES (METACALK 950).
- 6 GUN OR TROWEL SPECIFIED FIRE STOPPING COMPOUND (INTUMESCENT FOR PVC PIPING) ALL AROUND OPENING ON BOTH SIDES.

NOTE:

FIRE STOPPING MATERIALS AND SYSTEM SHALL BE "METACALK" PRODUCTS AS MANUFACTURED BY RECTOR SEAL CORP., P.O. BOX 14689, HOUSTON, TX 77221, PHONE 800-231-3345, (713) 528-6423.

MAXIMUM PIPE/TUBING SUPPORT SPACING, FEET										
NOM. SIZE	THRU 3/4"	1"	1-1/4"	1-1/2"	2"	2-1/2"	3"	4"	6"	8"
STEEL	N.A.	12	12	12	12	15	15	15	15	15
CPVC	N.A.	5	6	1	8	9	10	-	-	-

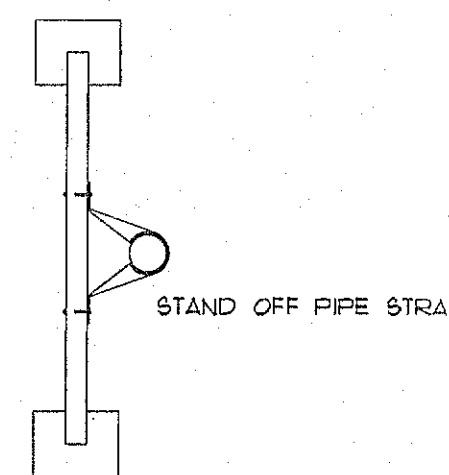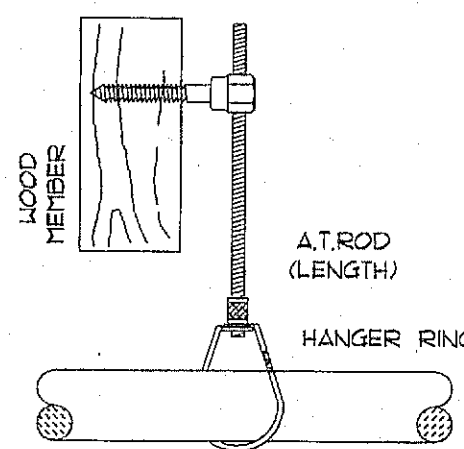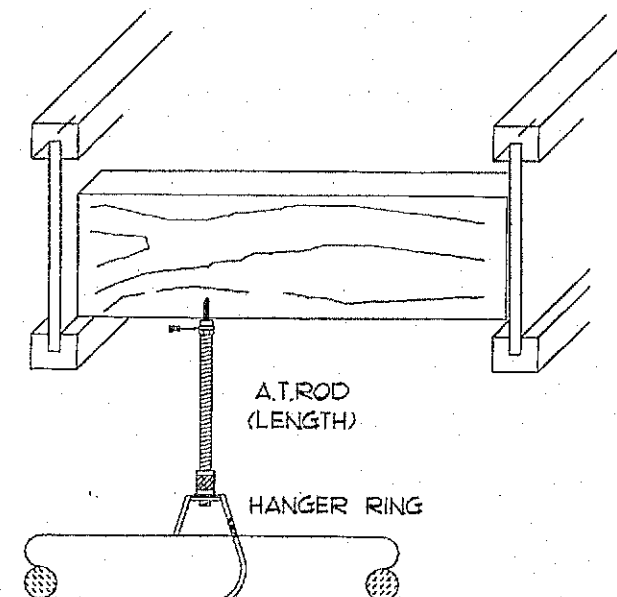

2 HANGER DETAILS

NO SCALE

1 FIRE STOPPING PIPE PENETRATION DETAILS


NO SCALE

RISER LEGEND

- 1 1" GM 145, 1" GALV x 2 TOE, 12" 1" SOLID GALV WALL PLATES
- 2 2" RESIDENTIAL DOMESTIC SHUTOFF VALVE
- 3 1/2" AMES SERIES 40000 RPZ WITH AIR GAP FITTING
- 4 POTTER RBVS BALL VALVE SWITCH
- 5 POTTER VSR-SF FLOW SWITCH
- 6 MILWAUKEE MODEL 8050502 BUTTERFLY VALVE
- 7 CENTRAL 6 HEAD SPARE HEAD CABINET
- 8 UNITED BRASS 1/2" MODEL 99 SCREWBED CHECK VALVE
- 9 1/4"x3 NIPPLE, 1/4"x3-WAY VALVE, 1/4" WATER GAUGE, 1/4" PLUG
- 10 WILKINS MODEL HXT-30 EXPANSION TANK


NOTE:

1. PIPE IN MECHANICAL ROOM TO BE SCHEDULE 40 DYNATHREAD.
2. PIPE IN REMAINING PORTIONS OF BUILDING TO BE CPVC HARVEL BLAZERMASTER.

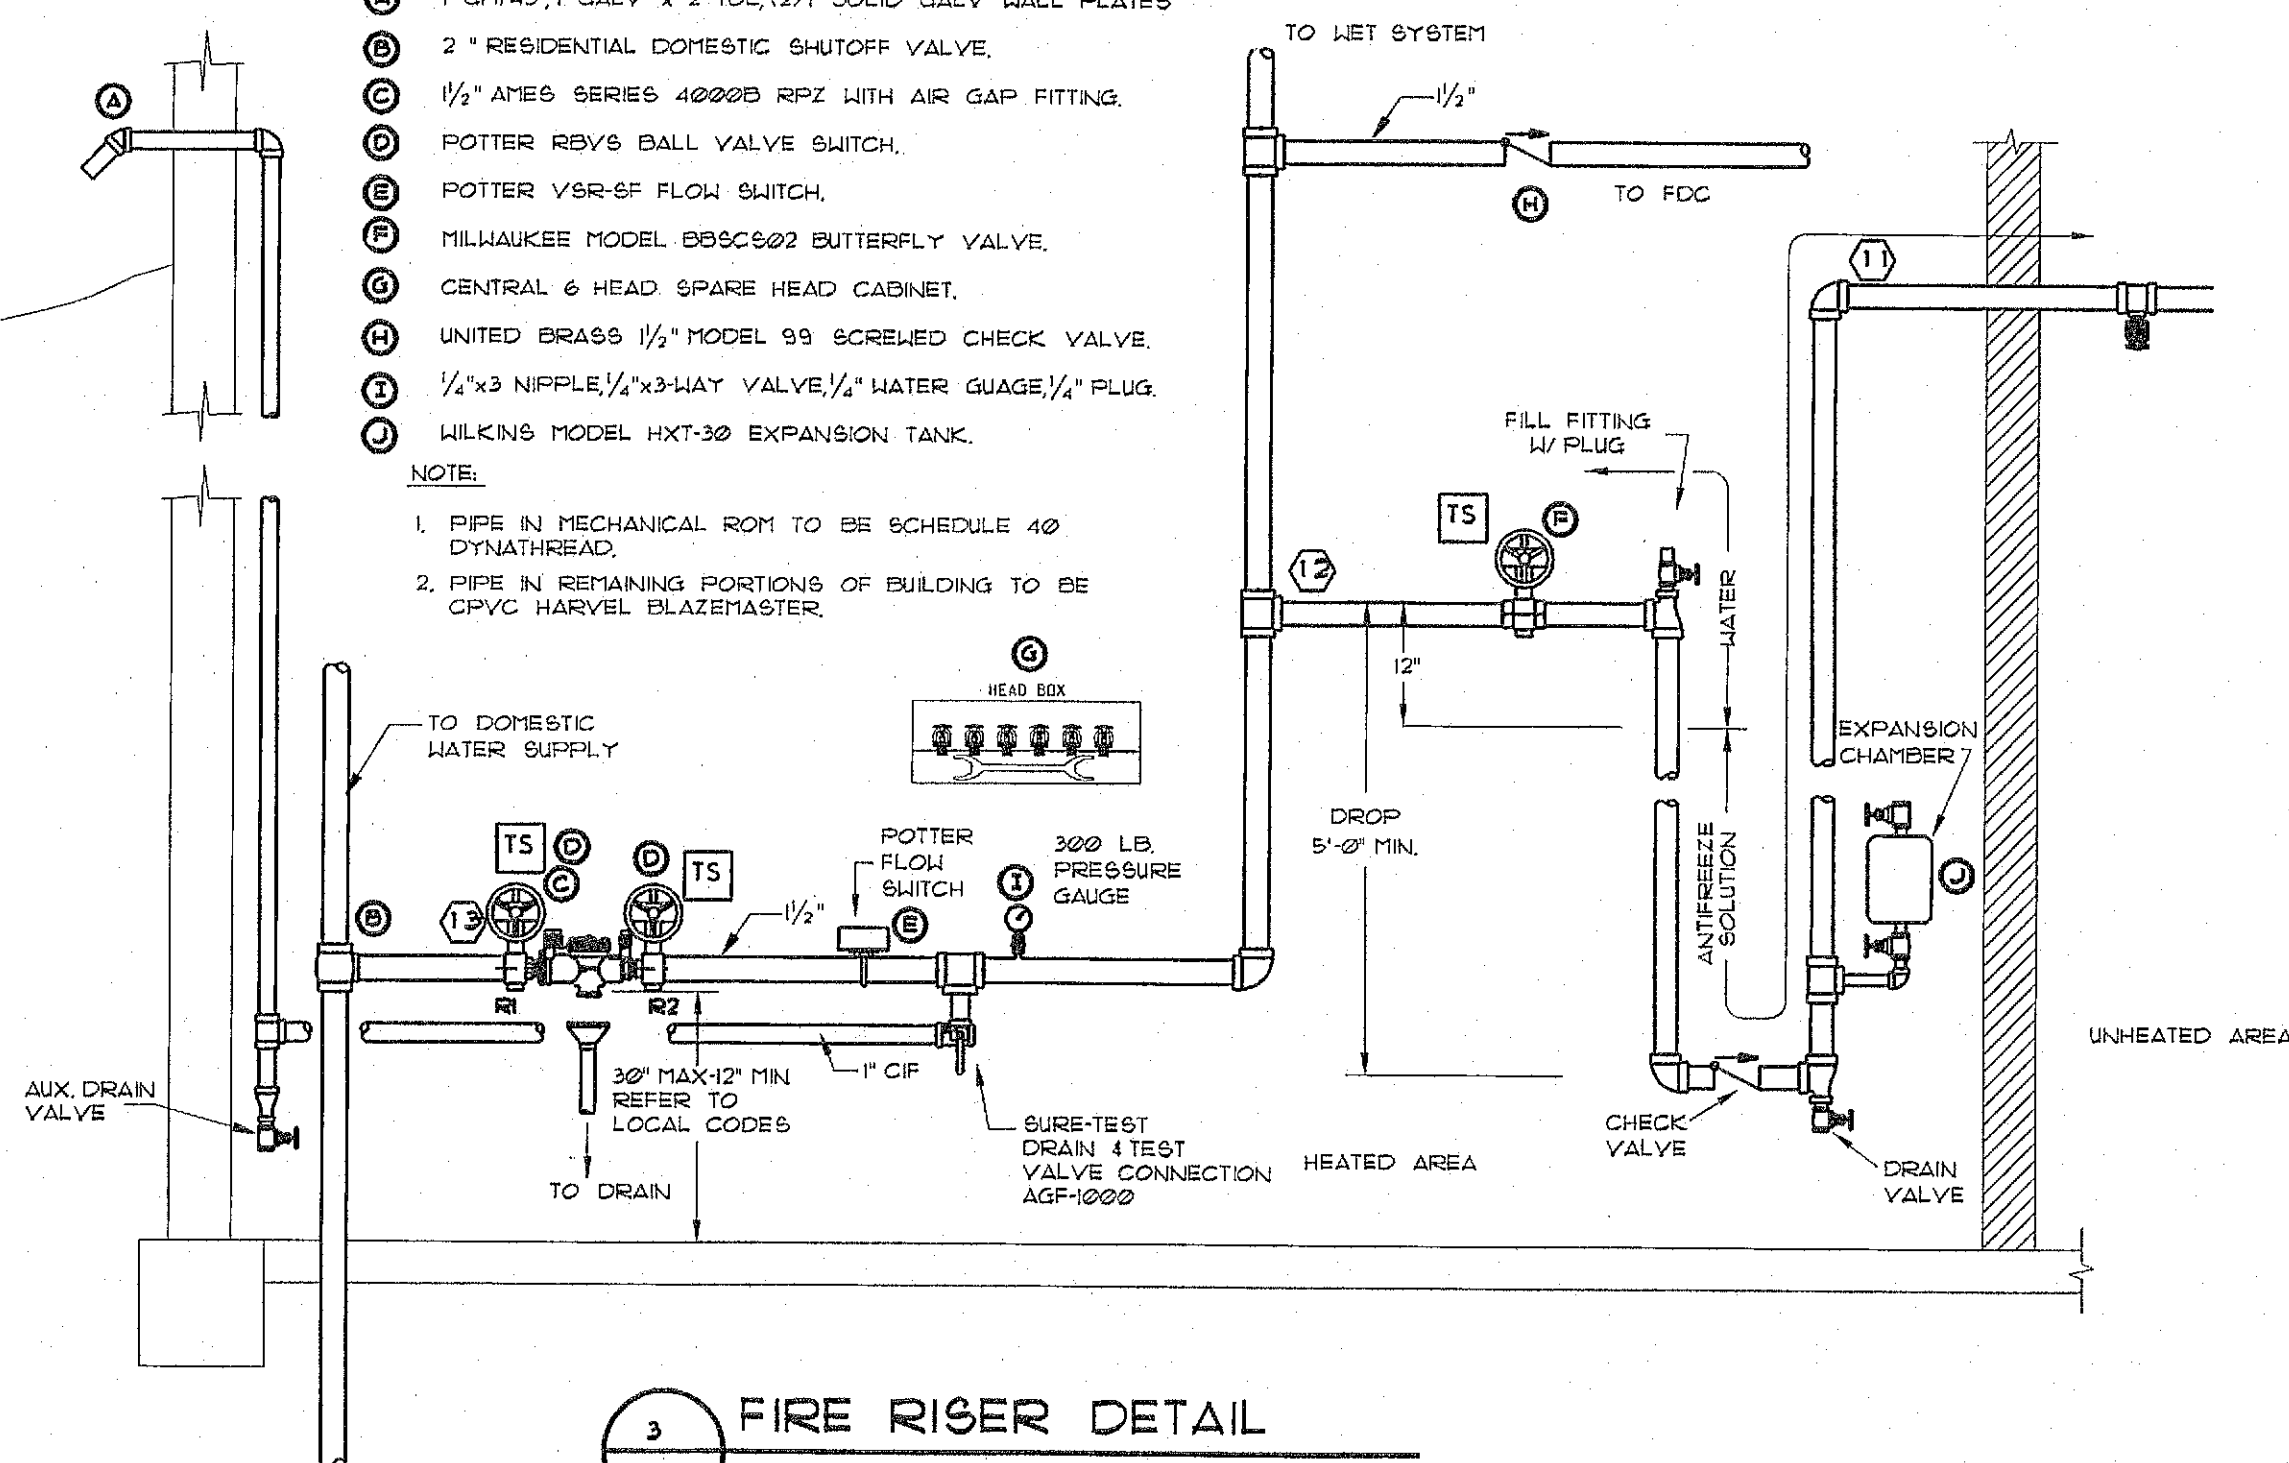

3 FIRE RISER DETAIL

NO SCALE

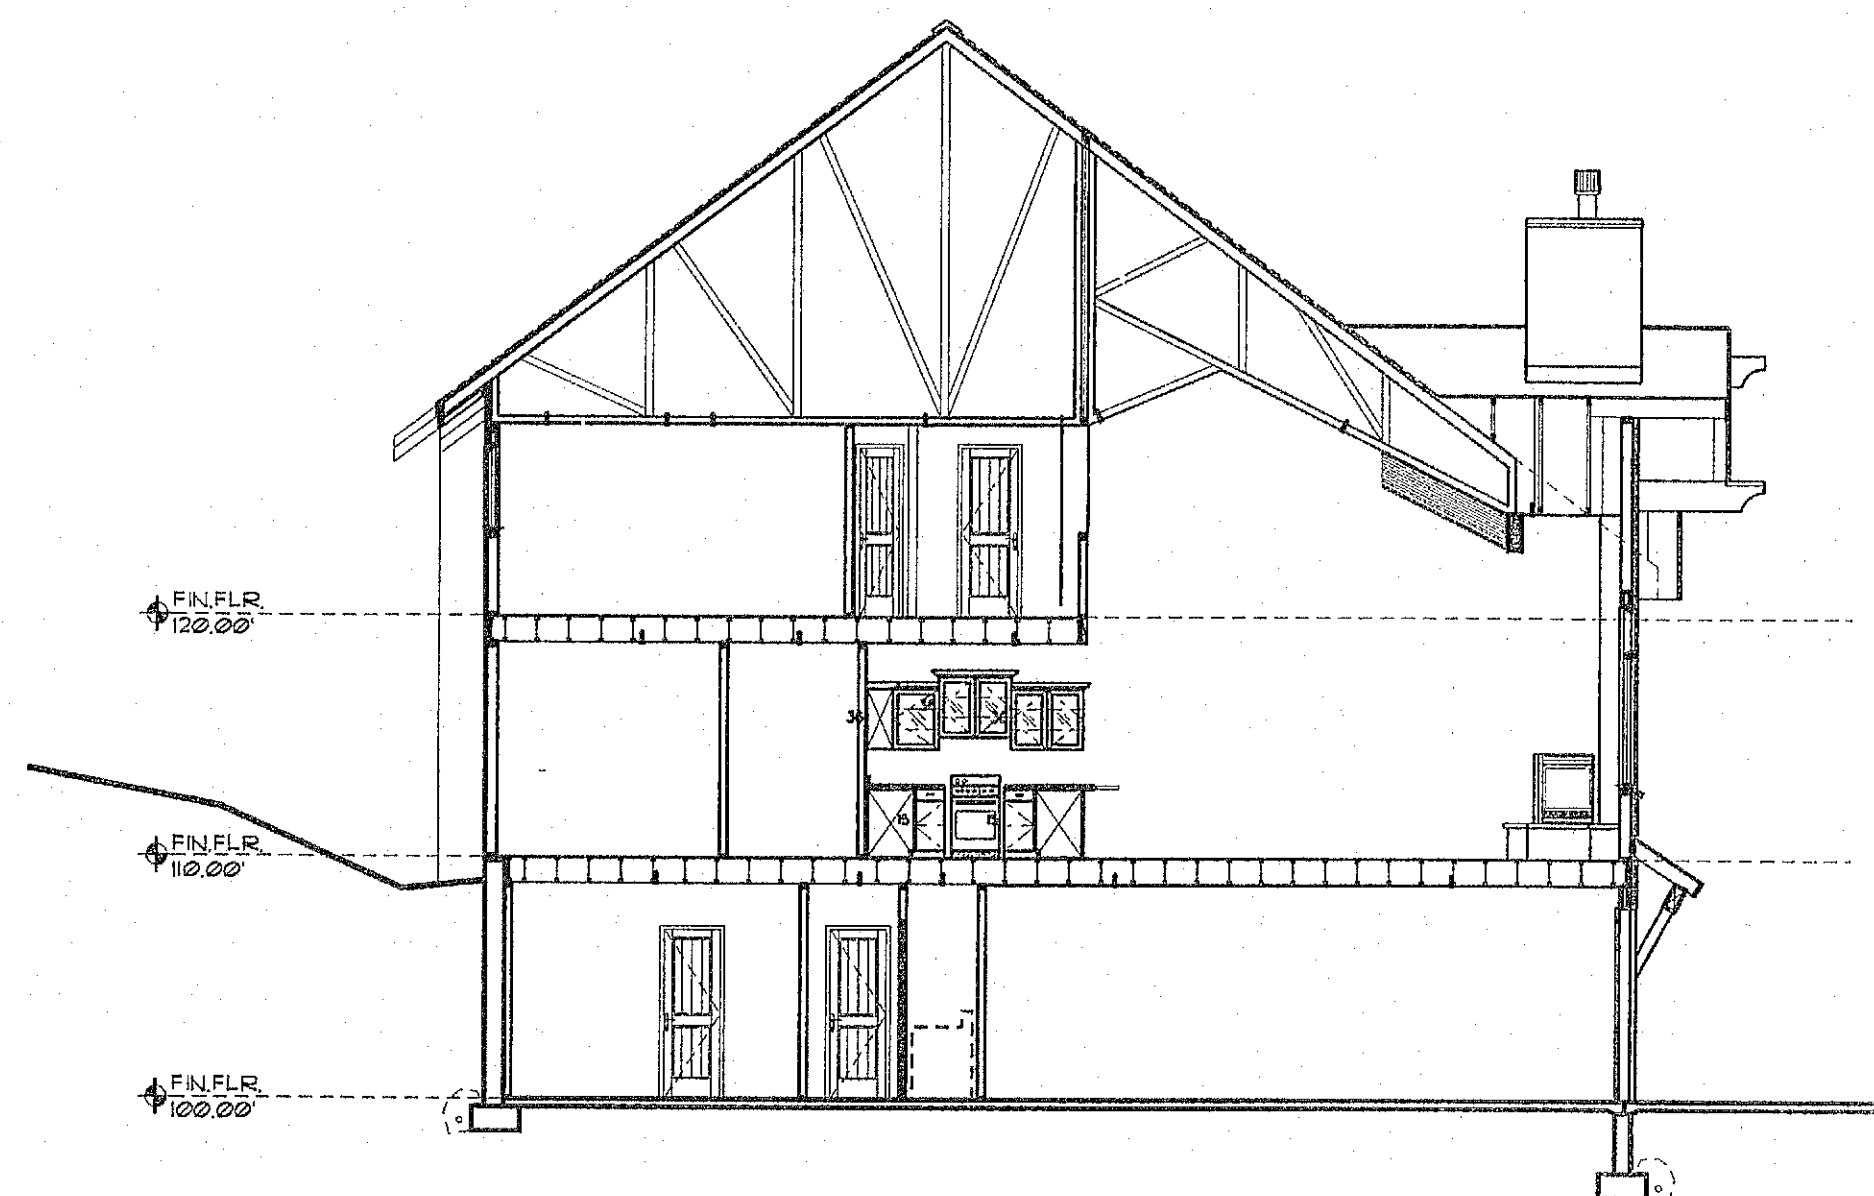


4 BUILDING SECTION

SCALE: 1/8" = 1'-0"

FIRE SPRINKLER NOTES

1. FIRE PROTECTION SYSTEM TO COMPLY WITH N.F.P.A. 13R 1999, AND ALL APPLICABLE STATE AND LOCAL CODES.
2. ADHERE TO AND OBTAIN ALL PERMITS, LICENSES AND GOVERNMENT REQUIREMENTS.
3. FINAL INSPECTION AND APPROVAL BY LOCAL FIRE DEPARTMENT.
4. CUTTING OF STRUCTURAL AND/OR ARCHITECTURAL MEMBERS TO BE DONE ONLY WITH THE WRITTEN APPROVAL OF THE APPROVING ENGINEER.
5. WATER SUPPLY FOR THIS STRUCTURE IS A MUNICIPAL WATER SOURCE. NO FLOW TESTS HAVE BEEN TAKEN AT THIS POINT.
6. PIPE ROUTING SHALL BE USED AND ANY ADDITIONAL OFFSETS OR FITTINGS REQUIRED FOR PROPER INSTALLATION, COORDINATION WITH OTHER TRADES, AND/OR TO MAINTAIN PROPER CLEARANCES SHALL BE PROVIDED, VERIFY EXISTING STRUCTURAL, MECHANICAL, ELECTRICAL INSTALLATIONS AND AVOID ANY/ALL OBSTRUCTIONS OR INTERFERENCES WITH FIRE PROTECTION PIPE ROUTING.
7. FIRE STOP ALL PENETRATIONS OF SMOKE/FIRE WALLS, CEILING, FLOORS PER 1/F501.
8. SPRINKLER HEADS ARE TO BE COORDINATED WITH ALL DIFFUSERS, SPEAKERS, LIGHTING FIXTURES AND CEILING SYSTEMS.
9. PROVIDE STOCK OF EXTRA SPRINKLERS IN ACCORDANCE WITH N.F.P.A. 13 3-16.1.
10. METHODS OF HANGING PIPES, HEADS AND BRANCHES SHALL BE IN ACCORDANCE WITH N.F.P.A. 13D AND 2/F501.
11. AUTOMATIC SPRINKLER TEMPERATURE RATINGS OF FUSIBLE ELEMENTS TO BE IN ACCORDANCE WITH N.F.P.A. 13D.
12. ALL VALVES FOR FIRE SERVICE SHALL BE LISTED BY THE UNDERWRITERS LABORATORIES, INC. AND THE FACTORY MUTUAL LABORATORIES. VALVES SHALL BE FACTORY MARKED "UL" AND "FM", ITS WORKING PRESSURE.
13. ALL VALVES ON THE FIRE PROTECTION SYSTEM TO BE ELECTRICALLY SUPERVISED, TYPE AND EXACT LOCATION OF FLOW PRESSURE AND SUPERVISORY SWITCHES SHALL BE ACCOMPLISHED BETWEEN THE DIFFERENT RESPONSIBLE TRADES.
14. ALL WIRING SHALL BE ACCOMPLISHED UNDER THE ELECTRICAL CONTRACT. COORDINATE ALL ELECTRICAL ITEMS WITH ELECTRICAL CONTRACTOR AND INSURE PROPER COORDINATION.
15. PROVIDE A PERMANENTLY ATTACHED NAME TAG STATING THE REQUIRED DESIGN CRITERIA FOR EACH HYDRAULICALLY DESIGNED SYSTEM.
16. ALL SPRINKLER HEADS MOUNTED IN CEILING SHALL BE LOCATED A MINIMUM OF 4" AWAY FROM ANY HALL, CEILING HEIGHT CHANGES OR ANY OTHER VERTICAL INTERSECTING SURFACE.

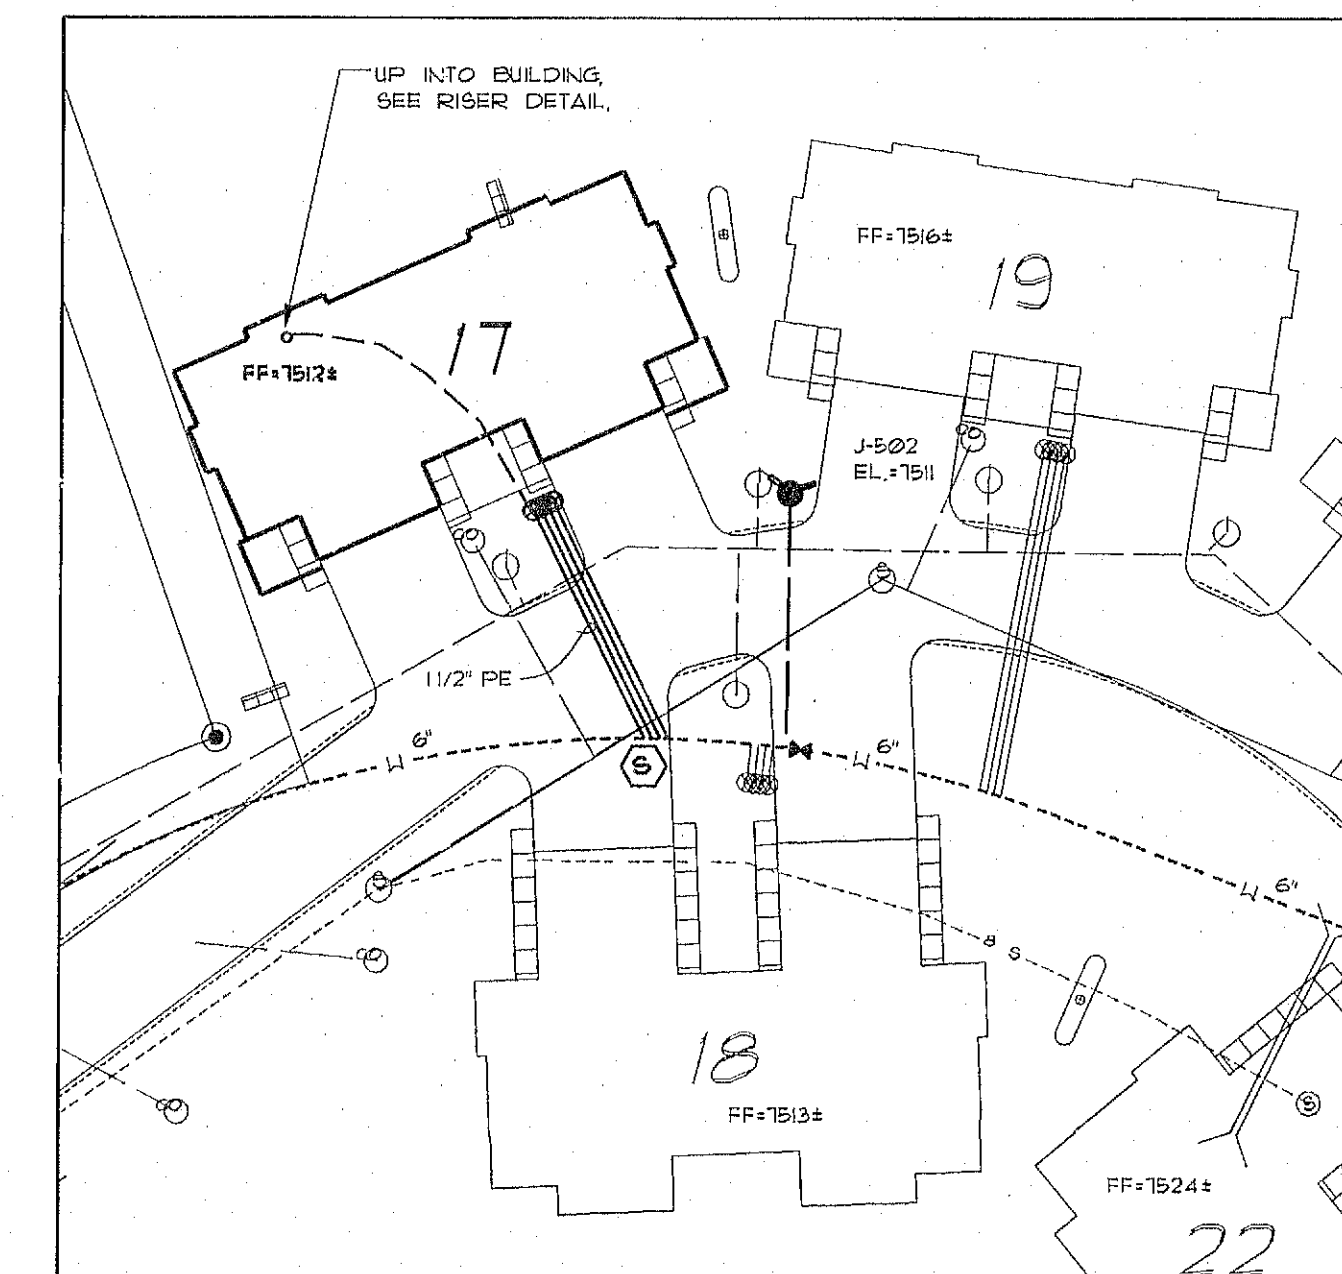

5 SITE PLAN

NO SCALE



DESIGN • INSTALLATIONS • INSPECTIONS • COMMERCIAL • RESIDENTIAL
ACTIVE LICENSE #72FPC CONTRACTOR'S REG. #10024

1101 Chestnut St.
Helena, MT 59601
PHN (406) 443-3531
FAX (406) 443-3578

REVISIONS:

ALPENGLOW at Big Sky
BIG SKY, MT
Uphill Unit

CONSTRUCTION
DOCUMENTS

COPYRIGHT 2003
CTA
ARCHITECTS
ENGINEERS
BILLINGS • MISSOULA
BOISE • GREAT FALLS
HELENA • KANSAS
SPOKANE
ALL RIGHTS RESERVED

DRAWN BY: W.S.
CHECKED BY: D.K.
DATE: 3-16-04
CTA # SECURITY
CADD FILE: AGUPF50
DIR: YAGLOWUP

CTA
ARCHITECTS
ENGINEERS
BILLINGS • MISSOULA
BOISE • GREAT FALLS
HELENA • KANSAS
SPOKANE

DETAILS

SHEET

F101 OF 4

REVISIONS:

ALPENGLOW at Big Sky
BIG SKY, MT
Uphill Unit

CONSTRUCTION
DOCUMENTS

COPYRIGHT 2003
CTA
ARCHITECTS
ENGINEERS
BILLINGS • MISSOULA
BOISE • GREAT FALLS
HELENA • KALISPELL
SPOKANE
ALL RIGHTS RESERVED


DRAWN BY: W.B.
CHECKED BY: D.K.
DATE: 3-16-04
CTA # SECURITY
CADD FILE: ALUPF301
DIR: YVAGLOWUP

CTA
ARCHITECTS
ENGINEERS
BILLINGS • MISSOULA
BOISE • GREAT FALLS
HELENA • KALISPELL
SPOKANE

UPHILL
UNIT
1ST FLOOR

SHEET

F301 OF 4

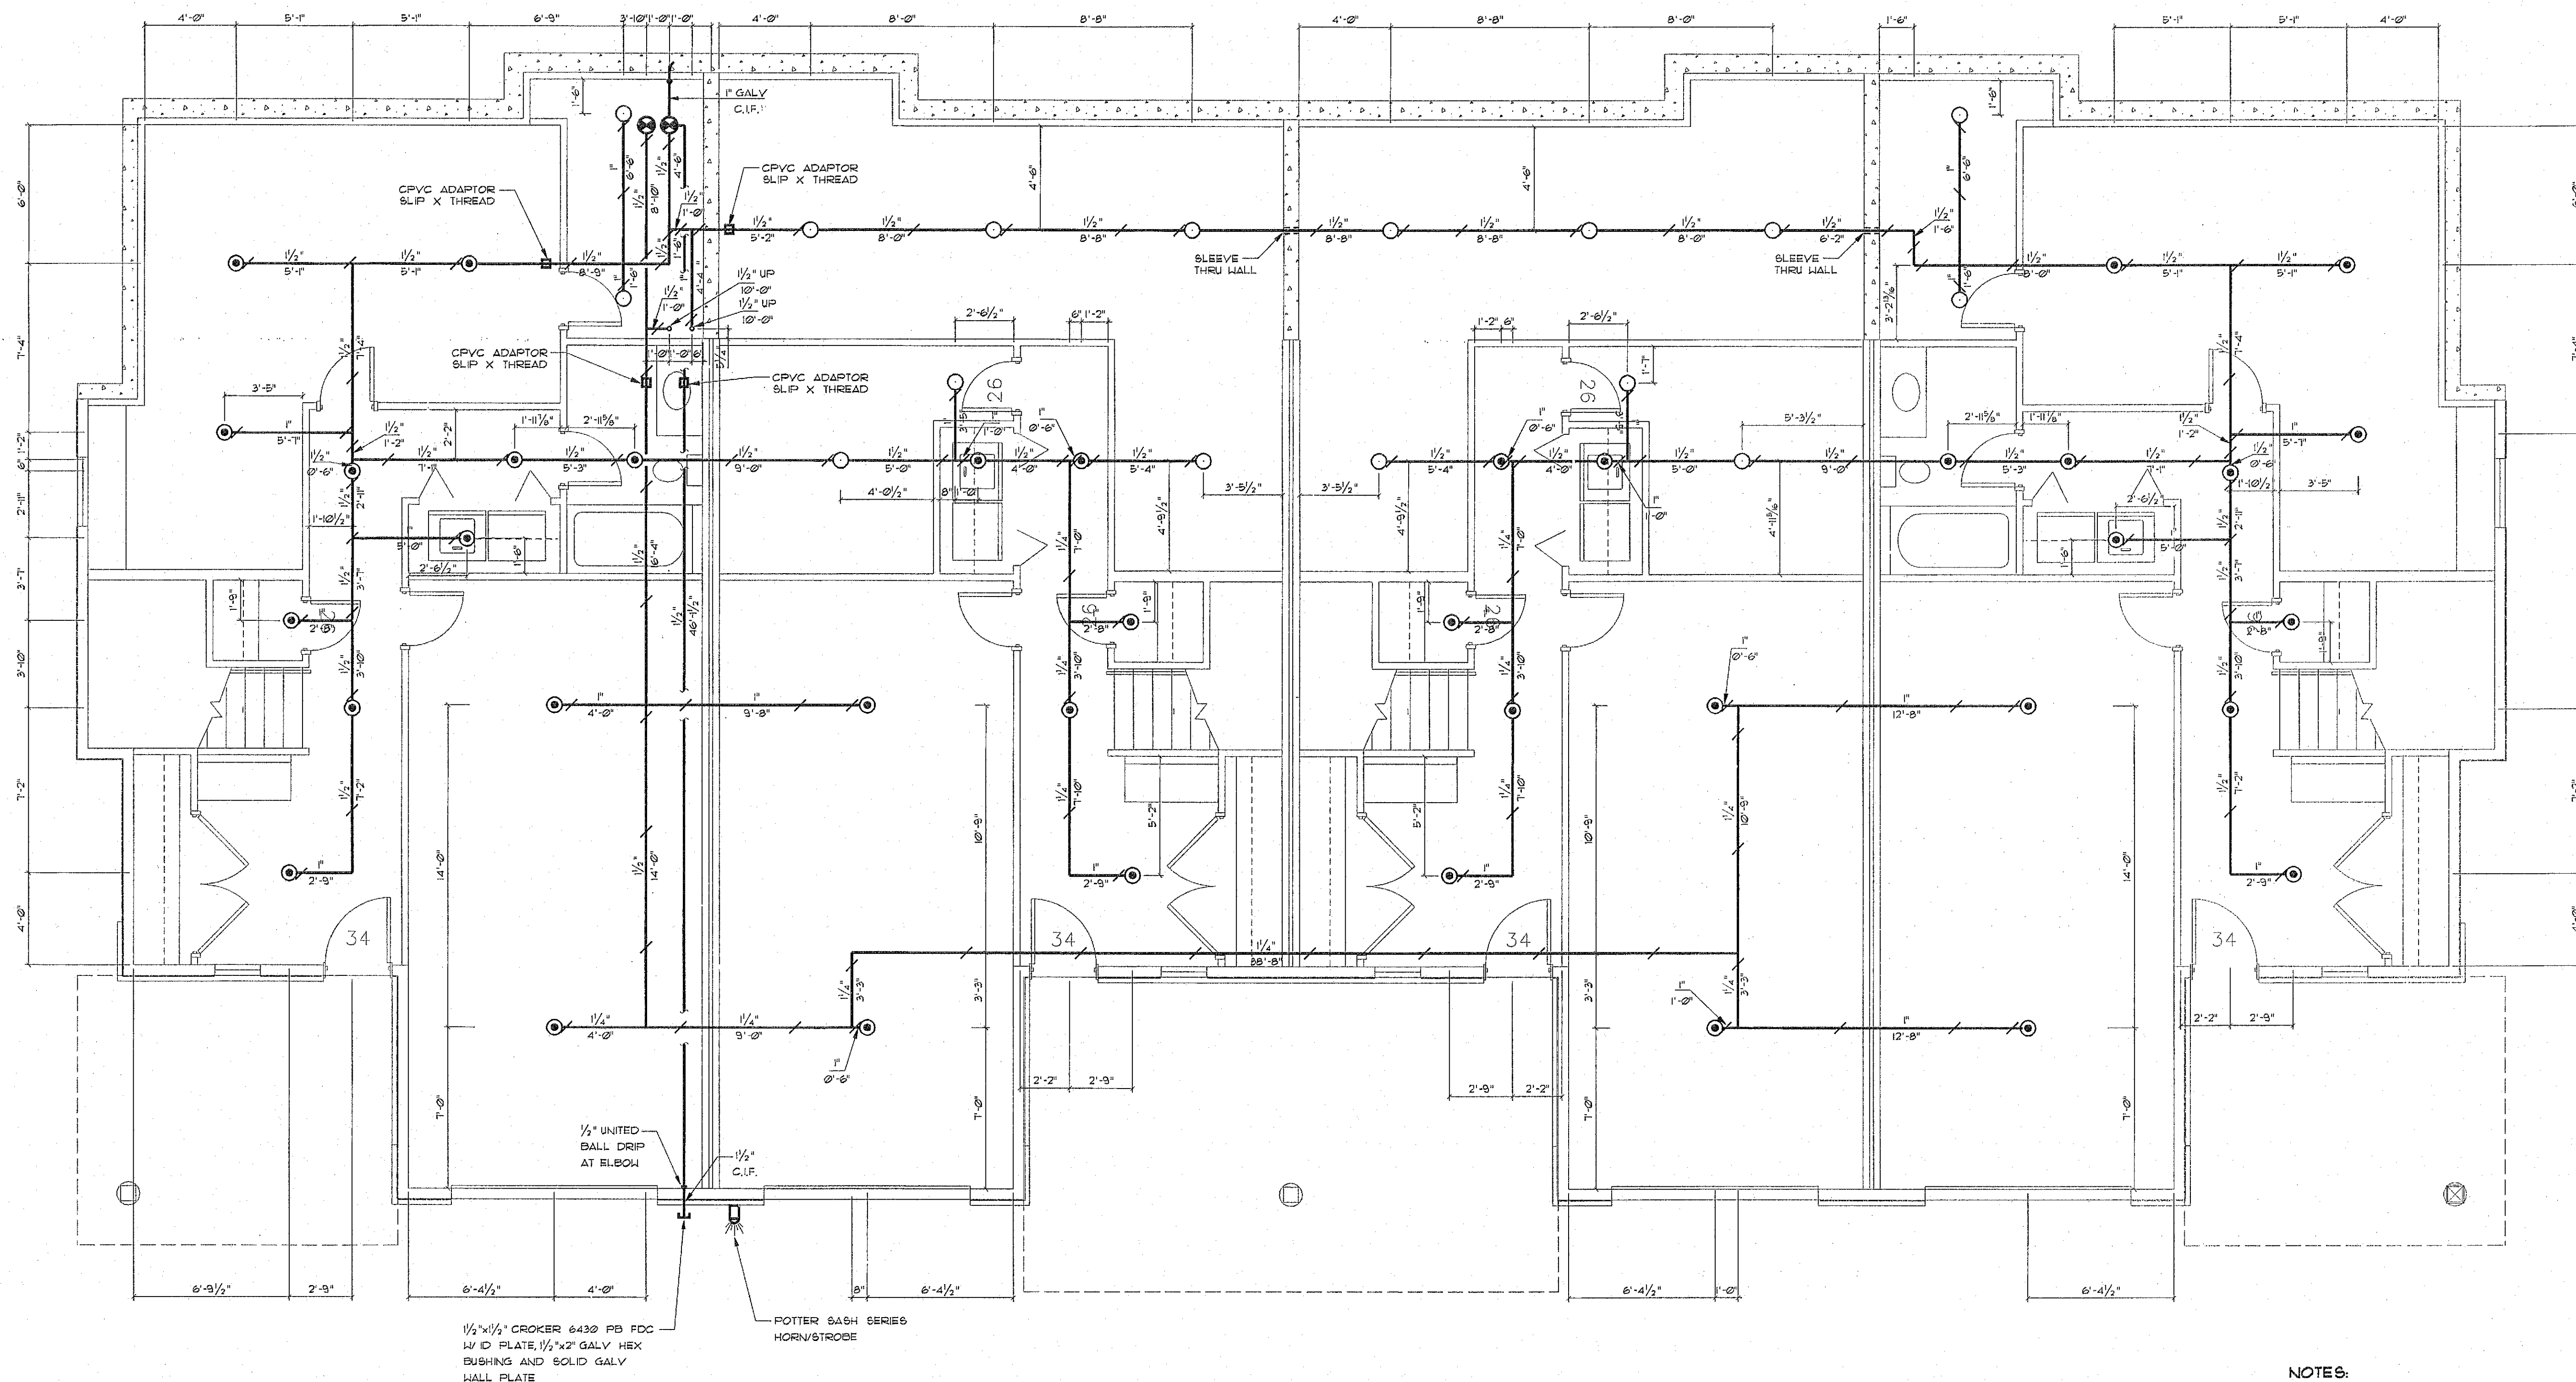

1ST FLOOR
FIRE SPRINKLER PLAN

SCALE: 1/4" = 1'-0"

NOTES:


1. ALL DROPS SHALL BE 1" UNLESS OTHERWISE NOTED.
2. ALL PIPING SHALL BE 9'-6" ABOVE FINISH FLOOR UNLESS OTHERWISE NOTED.
3. OWNER TO SUPPLY KNOX BOX AND ACCESS KEYS.

HYDRAULIC DESIGN DATA				SPRINKLER HEADS							
HAZARD CLASSIFICATION: 13R	SYSTEM AREA: 11572 SQ. FT.			SYMBOL	TYPE	MANUFACTURER	MODEL	TYPE	FINISH	CANOPY	K-FACTOR
HYDRAULIC DESIGN DATA: 4 SPRINKLERS	196 SQ. FT./HD MAX			⊙	RESIDENTIAL CONCEALED PENDENT	CENTRAL	LFH	SSP	BRASS	WHT CNCLD	4.2
AREA OF APPLICATION: 426 SQ. FT.	HOSE ALLOWANCE: 0 GPM			○	STORAGE UPRIGHT INTERMEDIATE	CENTRAL	TY-FRB	SSU	BRASS	—	5.6
TOTAL SYSTEM REQUIREMENTS				⊙	RESIDENTIAL RECESSED PENDENT	CENTRAL	LFH	SSP	BRASS	—	4.9
	59 GPM AT 83 PSI CONNECTION AT MAIN										155°
WATER SUPPLY INFORMATION											0
STATIC PRESSURE: 91 PSI											
RESIDUAL PRESSURE: 72 PSI WITH 300 GPM FLOWING											
HYDRANT LOCATION/NUMBER: J-502	BY: SIMULATION	DATE: 3/06/04									

Security
FIRE PROTECTION, INC.

DESIGN • INSTALLATIONS • INSPECTIONS • COMMERCIAL • RESIDENTIAL
ACTIVE LICENSE #72FPC CONTRACTOR'S REG. #10024

1101 Chestnut St.
Helena, MT 59601
PHN (406) 443-3531
FAX (406) 443-3578

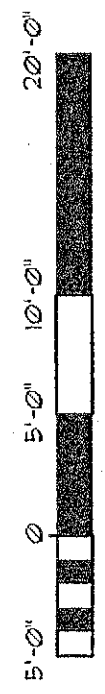

SCALE: $\frac{1}{4}" = 1' - 0"$

[illegible]

1. ALL DROPS SHALL BE 1" UNLESS OTHERWISE NOTED.
2. ALL PIPING SHALL BE 8'-6" ABOVE FINISH FLOOR UNLESS OTHERWISE NOTED.

DESIGN • INSTALLATIONS • INSPECTIONS • COMMERCIAL • RESIDENTIAL
ACTIVE LICENSE #72FPC CONTRACTOR'S REG. #10024

1101 Chestnut St.
Helena, MT 59601
PHN (406) 443-3531
FAX (406) 443-3578

F303 OF 4


Alpen glow
FSS

FIRE SPRINKLER NOTES


1. FIRE PROTECTION SYSTEM TO COMPLY WITH NFPA 13R 1999, AND ALL APPLICABLE STATE AND LOCAL CODES.
2. NO INSTALLATION OF ANY PART OF THE SYSTEM DEPICTED IN THESE DRAWINGS SHALL OCCUR PRIOR TO OBTAINING ALL PERMITS, LICENSES, GOVERNMENT REQUIREMENTS AND OWNERS REPRESENTATIVE APPROVAL.
3. FINAL INSPECTION AND APPROVAL BY LOCAL FIRE DEPARTMENT, AND OWNERS INSURANCE UNDERWRITER.
4. CUTTING OF STRUCTURAL AND/OR ARCHITECTURAL MEMBERS TO BE DONE ONLY WITH THE WRITTEN APPROVAL OF THE APPROVING ENGINEER.
5. A COMPUTER SIMULATED FLOW TEST INDICATES 91 P.S.I. STATIC PRESSURE WITH A RESIDUAL PRESSURE OF 72 P.S.I. @ 300 G.P.M. ON 60' RISE.
6. PIPE ROUTING SHOWN SHALL BE USED AND ANY ADDITIONAL OFFSETS OR FITTINGS REQUIRED FOR PROPER INSTALLATION, COORDINATION WITH OTHER TRADES, AND/OR TO MAINTAIN PROPER CLEARANCES SHALL BE PROVIDED. VERIFY EXISTING STRUCTURAL, MECHANICAL, ELECTRICAL INSTALLATIONS AND AVOID ANY/ALL OBSTRUCTIONS OR INTERFERENCES WITH FIRE PROTECTION PIPE ROUTING.
7. FIRE STOP ALL PENETRATIONS OF SMOKE/FIRE WALLS, CEILINGS, FLOORS, ROOFS, ETC. PER 3/FP1.
8. ACCESS PANELS TO ALL VALVES ABOVE NON-ACCESSIBLE CEILINGS AND CHASES ARE BY THE GENERAL CONTRACTOR.
9. SPRINKLER HEADS ARE TO BE COORDINATED WITH ALL EXISTING NEW DIFFUSERS, SPEAKERS, LIGHTING FIXTURES AND CEILING SYSTEMS.
10. PROVIDE STOCK OF EXTRA SPRINKLERS IN ACCORDANCE WITH N.F.P.A. 13 3-16.7.
11. METHODS OF HANGING PIPES, HEADERS AND BRANCHES SHALL BE IN ACCORDANCE WITH N.F.P.A. 13, AND HANGER CHART 4/FP1.
12. AUTOMATIC SPRINKLER TEMPERATURE RATINGS OF FUSIBLE ELEMENTS TO BE IN ACCORDANCE WITH N.F.P.A. 13.
13. ALL VALVES ON THE FIRE PROTECTION SYSTEM TO BE ELECTRICALLY SUPERVISED. TYPE AND EXACT LOCATION OF FLOW, PRESSURE AND SUPERVISORY SWITCHES SHALL BE ACCOMPLISHED BETWEEN THE DIFFERENT RESPONSIBLE TRADES.
14. ALL WIRING SHALL BE ACCOMPLISHED UNDER THE ELECTRICAL CONTRACT. COORDINATE ALL ELECTRICAL ITEMS WITH ELECTRICAL CONTRACTOR AND INSURE PROPER COORDINATION.
15. PROVIDE A PERMANENTLY ATTACHED NAME TAG STATING THE REQUIRED DESIGN CRITERIA FOR EACH HYDRAULICALLY DESIGNED SYSTEM.
16. SPRINKLERS SHALL COVER THE ENTIRE AREA OF THE ROOM INCLUDING ALCOVES. SPRAY SHALL NOT BE BLOCKED BY WALLS OR PARTITIONS.
17. ALL SPRINKLER HEADS MOUNTED IN CEILING SHALL BE LOCATED A MINIMUM OF 4" AWAY FROM ANY WALLS, CEILING HEIGHT CHANGES OR ANY OTHER VERTICAL INTERSECTING SURFACE.
18. IT IS THE INTENT OF THESE SHOP DRAWINGS TO PROVIDE AN ACCURATE CONCEPT FOR INSTALLATION PURPOSES. IT IS THE RESPONSIBILITY OF THIS FIRE SPRINKLER SUB-CONTRACTOR TO FIELD SURVEY THE SYSTEM SHOWN AND PROVIDE REVISIONS NECESSARY FOR A SMOOTH INSTALLATION. ADDITIONALLY IT IS THE RESPONSIBILITY OF THE AWARDED FIRE SPRINKLER SUB-CONTRACTOR TO INSURE THE CODE COMPLIANCY OF THIS SYSTEM INSTALLATION. THIS DESIGNER WILL NOT BE HELD RESPONSIBLE FOR ANY FORSEEN, OR UNFORSEEN CONFLICTS. THESE CONFLICTS INCLUDE, BUT ARE NOT LIMITED TO, ACCURACY OF PIPE CUTS, OFFSETS, FITTINGS, VALVES, EQUIPMENT INSTALLED BY OTHERS, OR ANY OTHER ADDITION TO THIS SYSTEM REQUIRED BY CODE, OR LOCAL JURISDICTIONS.

TABLE 1 MAXIMUM SUPPORT SPACING DISTANCE END LINE SPRINKLER HEAD DROP ELBOW		
PIPE SIZE INCHES	SYSTEM PRESSURE	
	< 100 psi	> 100 psi
3/4"	9'	6'
1"	12'	8'
1-1/4"	16'	12'
1-1/2"-2"	24'	12'


TABLE 2 MAXIMUM SUPPORT SPACING DISTANCE INLINE SPRINKLER HEAD DROP TEE		
PIPE SIZE INCHES	SYSTEM PRESSURE	
	< 100 psi	> 100 psi
3/4"	4'	3'
1"	5'	4'
1-1/4"	6'	5'
1-1/2"-2"	7'	7'

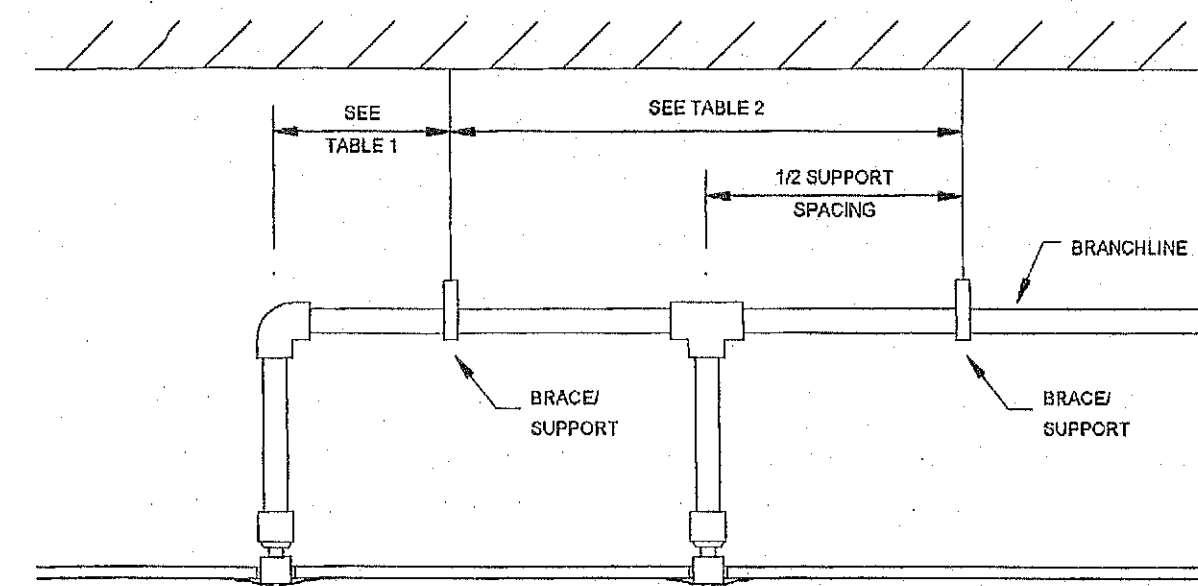

4 HANGER SPACING CHART
FP1 NO SCALE

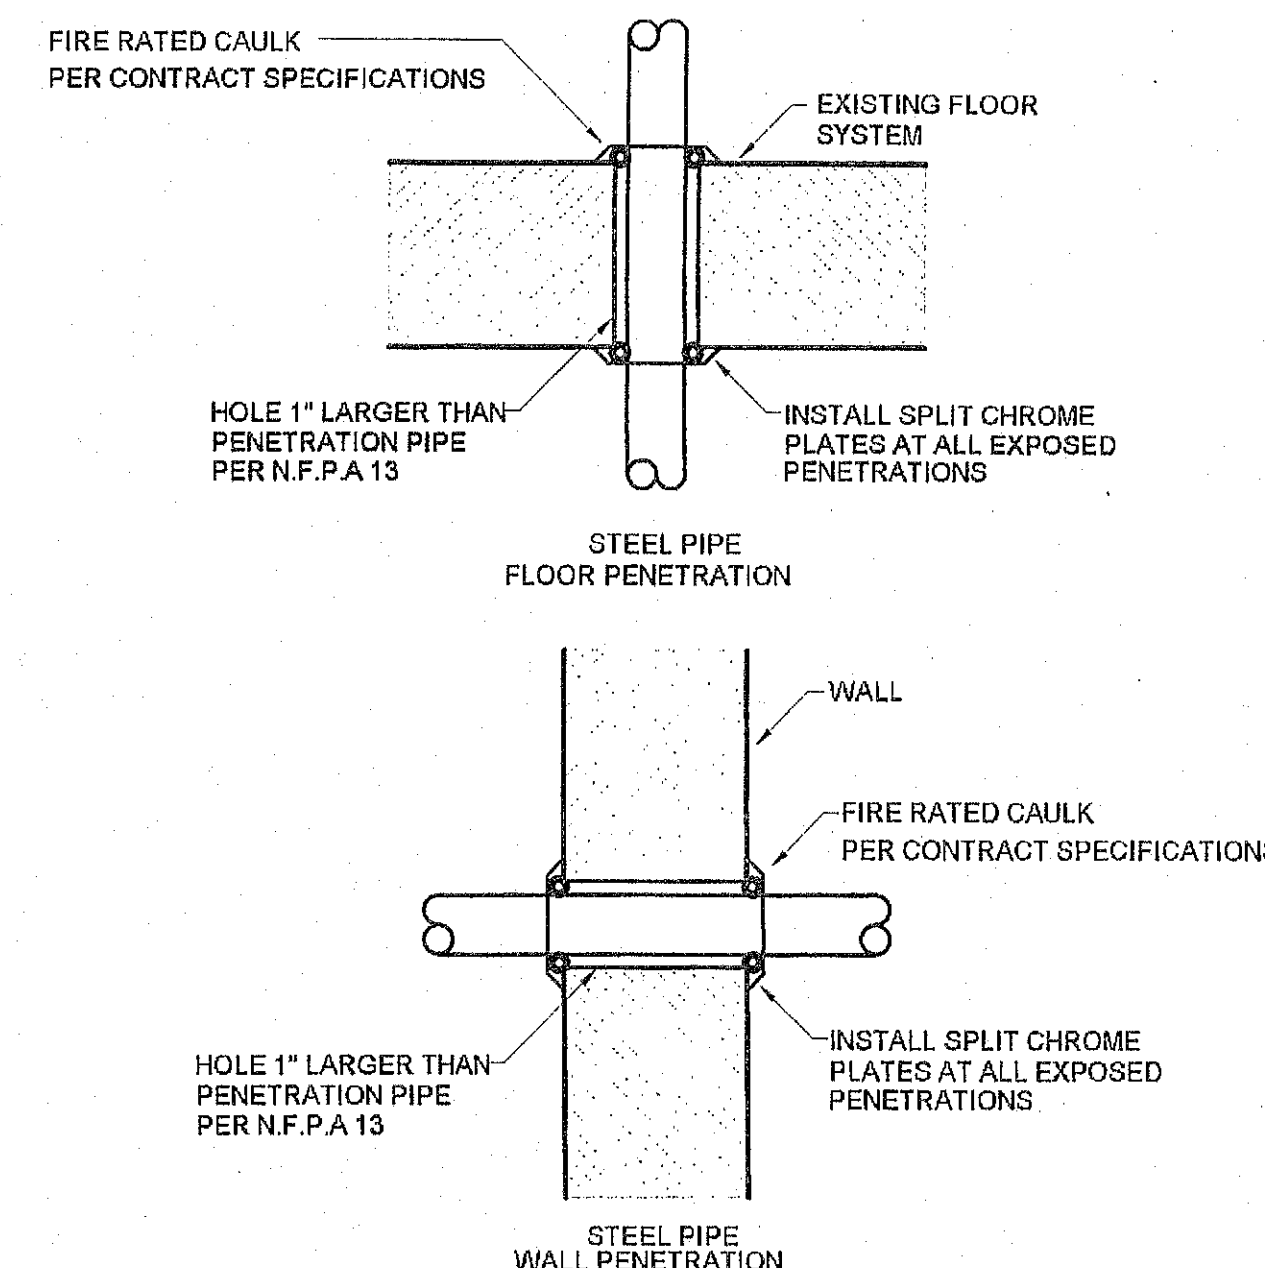


3 FIRE STOP DETAIL
FP1 NO SCALE

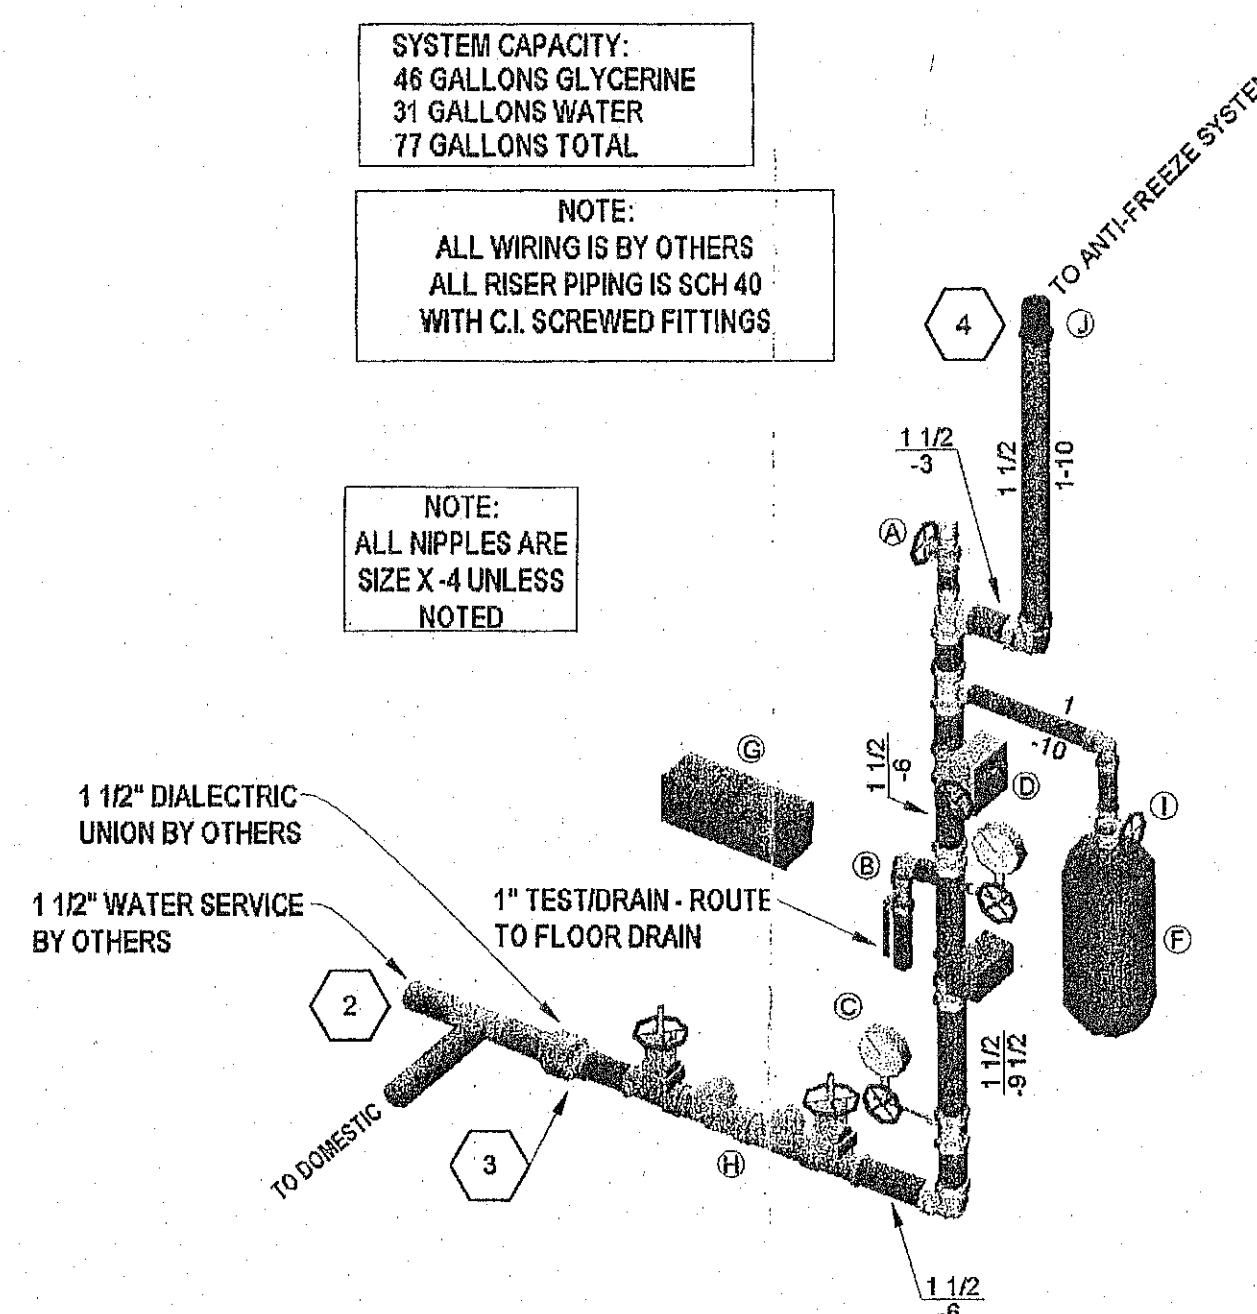


1 RISER DETAIL
FP1 1\"/>

RISER / FDC LEGEND

- A) 1" BRONZE GLOBE VALVE WITH PLUG
- B) 1 1/2" RISER MANIFOLD WITH TEST TRIM
- C) 1/2" X 1/4" GALV. HEX BUSHING, 1/4" X-3 NIPPLE, 1/4" 3-WAY VALVE, 1/4" WATER GAUGE, 1/4" PLUG
- D) 1 1/2" SCREWED BUTTERFLY VALVE W/ TAMPER MILWAUKEE BBSCS
- E) HORNSTROBE - POTTER SASH SERIES (SEE A/FP2 FOR LOCATION)
- F) 2.5 GALLON EXPANSION CHAMBER AND 1" GLOBE VALVE
- G) 3 SPARE HEAD CABINET
- H) 1 1/2" REDUCED PRESSURE BACKFLOW PREVENTER - AMES 4000B WITH LOCKING HANDLES
- I) 1" GLOBE VALVE
- J) 1 1/2" CPVC SLIP X THREAD ADAPTER
- K) 1 1/2" SCREWED CHECK VALVE
- L) 1 1/2" X 1/2" X 1 1/2" TEE, 1/2" X-4 NIPPLE, 1/2" STREET ELBOW AND 1/2" BALL DRIP VALVE
- M) 2 1/2" X 1 1/2" GALV. HEX BUSHING, 2 1/2" X 2 1/2" FIRE DEPT. CONNECTION WITH I.D. PLATE "AUTO-SPKR" WITH ROUGHED BRASS FINISH - CROKER 6620 AND (1) 1 1/2" SOLID GALV WALL PLATE AT INTERIOR.

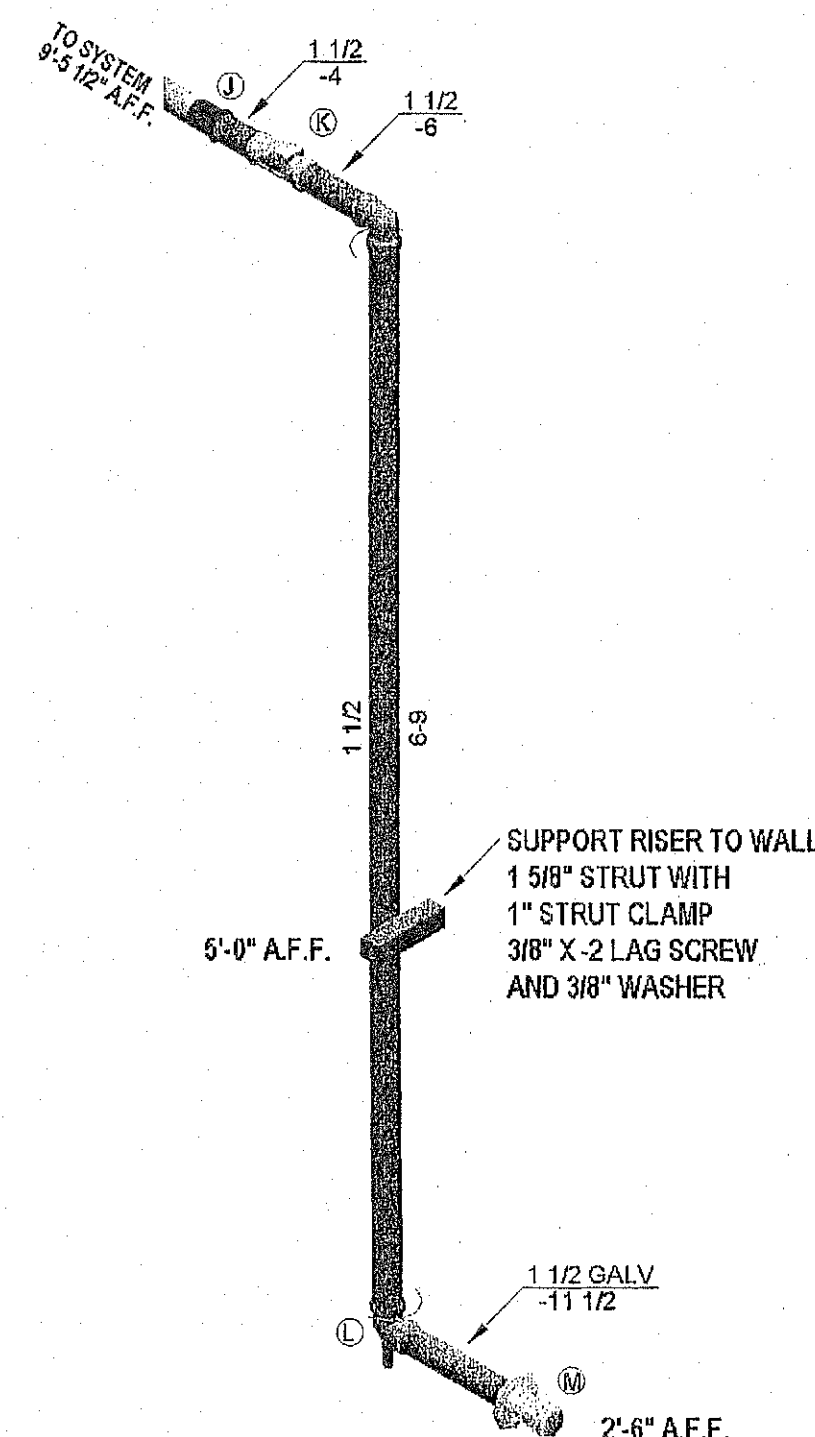

5 F.D.C. DETAIL
FP1 1\"/>

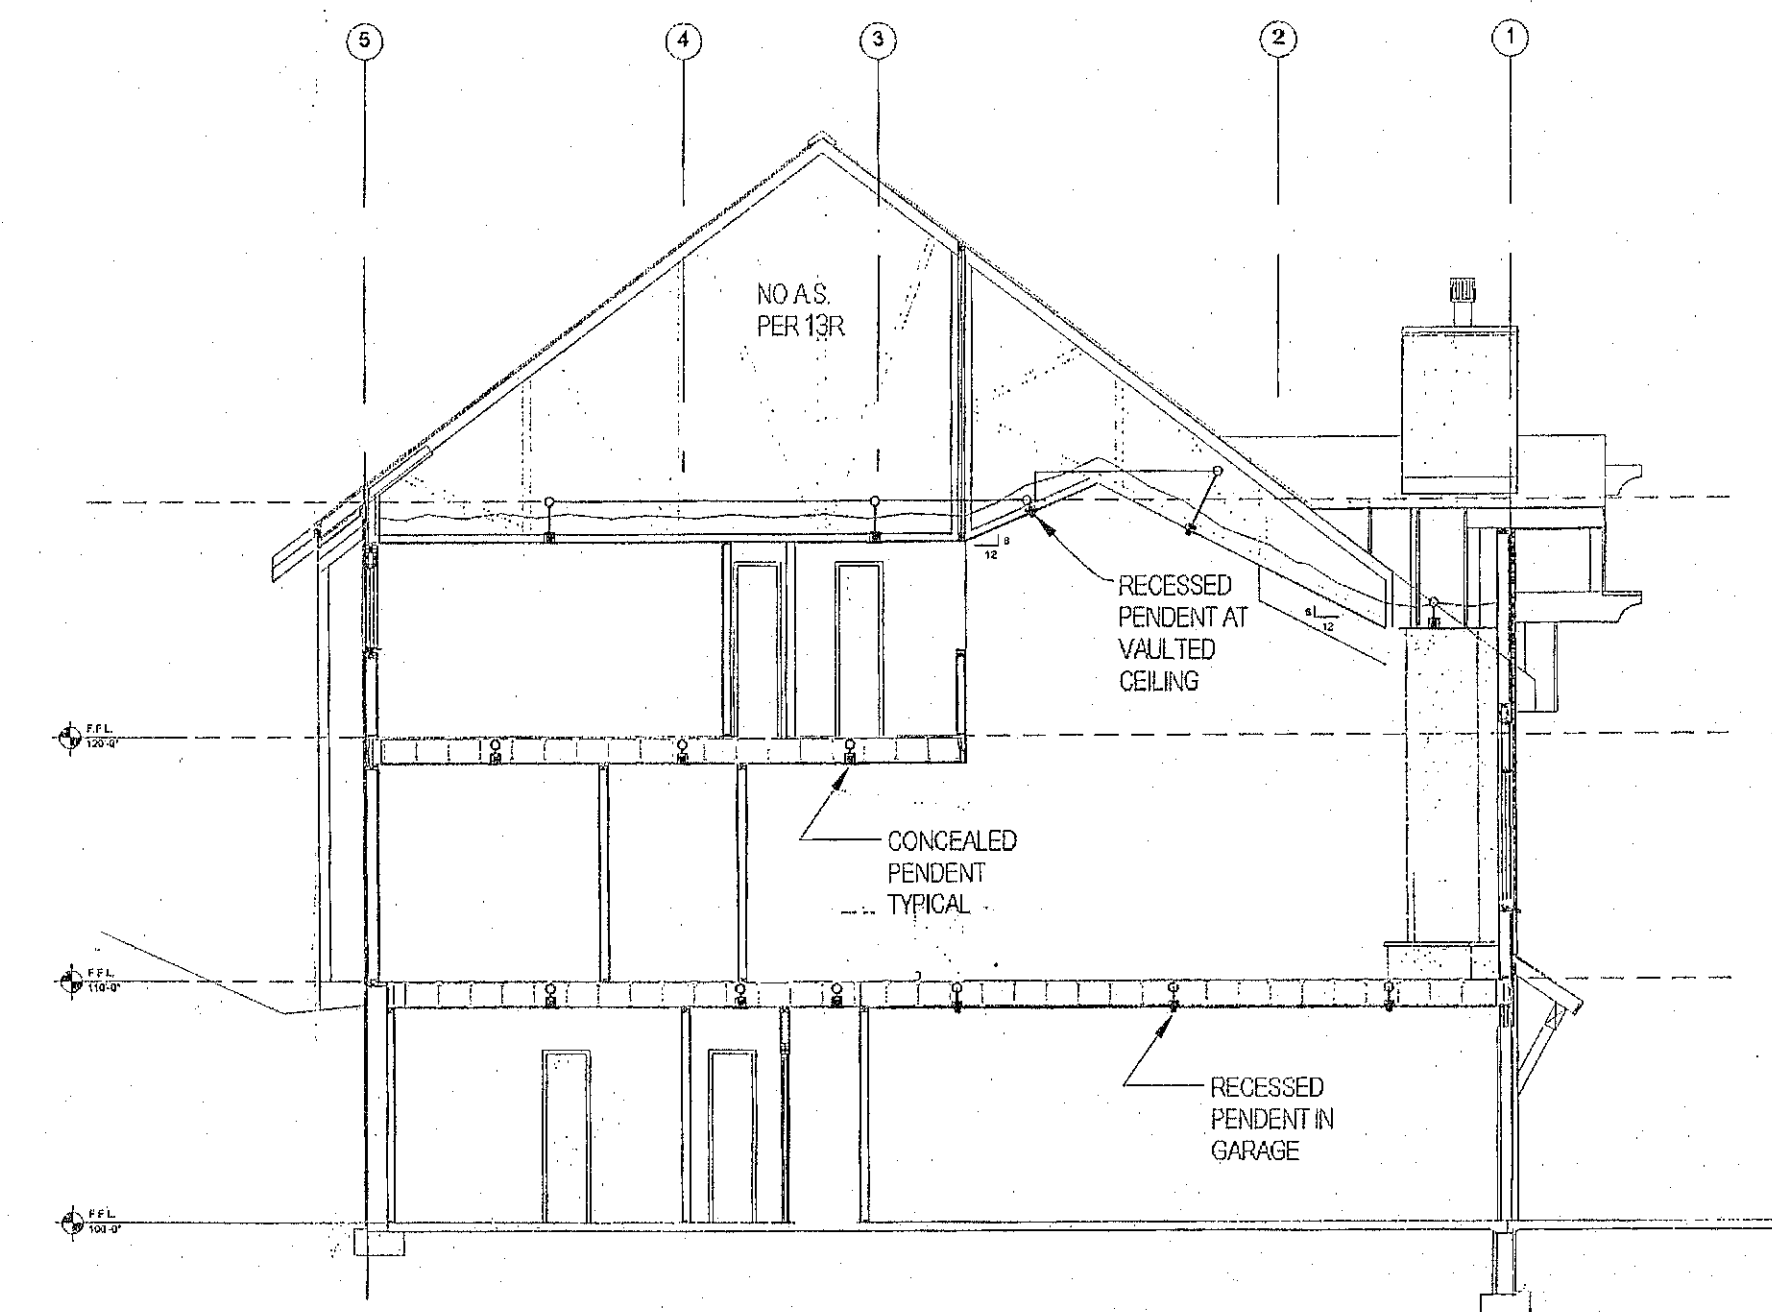


2 BUILDING SECTION
FP1 1/8\"/>


NOTICE	ENGINEER	APPROVALS & COORDINATION			HYDRAULIC DESIGN DATA				SPRINKLER HEADS												
IT IS THE OWNERS RESPONSIBILITY TO PROVIDE ADEQUATE HEAT TO PREVENT FREEZING THROUGHOUT WET PIPE SPRINKLER SYSTEM AREAS AND IN ENCLOSURES FOR DRY PIPE AND OTHER TYPES OF VALVES CONTROLLING WATER SUPPLY TO SPRINKLER SYSTEMS.	 BRYAN J. KENDRICK Certification Number 088444 - LEVEL IV	ORGANIZATION	CONTACT	PHONE	HAZARD CLASSIFICATION:	SYSTEM AREA:		SQ. FT.	MANUFACTURER	MODEL	SIN #	TYPE	FINISH	ORIFICE	DROP	CANOPY	TEMP	SYMBOL	QTY		
		BIG SKY FIRE DEPARTMENT	J. REVISKY	(406)995-2100	HYDRAULIC DESIGN DATA:	GPM/SQ. FT.	SQ. FT. AND MAX														
					AREA OF APPLICATION:	SQ. FT.	HOSE ALLOW:		GPM												
		SYSTEM TYPE				TOTAL SYSTEM REQUIREMENTS:															
						GPM AT PSI AT PUMP HOUSE															
						WATER SUPPLY INFORMATION															
		WET X				STATIC PRESSURE:		PSI													
		DRY				RESIDUAL PRESSURE:		PSI WITH		GPM FLOWING											
				TEST TAKEN AT:		BY:		DATE:		TOTAL											
										TOTAL											

Fire Sprinkler Specialties, Inc.
Service, Installation and Design
PMB 2017
#1 Jackson Creek Road
Montana City, MT 59634
Phone: 406-227-6050
Fax: 406-227-7936



REVISIONS			CONTRACT NAME:		SCALE: 1/8"=1'-0" 
NO.	DATE	DESCRIPTION	ALPENGLow - UPHILL UNIT BIG SKY, MONTANA 59716		
			CONTRACT WITH:		DRAWN BY: B. KENDRICK CHECKED BY: J. STEAB DATE: 02/12/05 CONTRACT NO.: NWSO NO.: 0504 SHEET NO.: FP1 OF 2
			MAUS CONSTRUCTION, INC. 200 E. WILLIAMS ROAD GALLATIN GATEWAY, MT 59730		
			SITE PLAN, DETAILS AND NOTES		

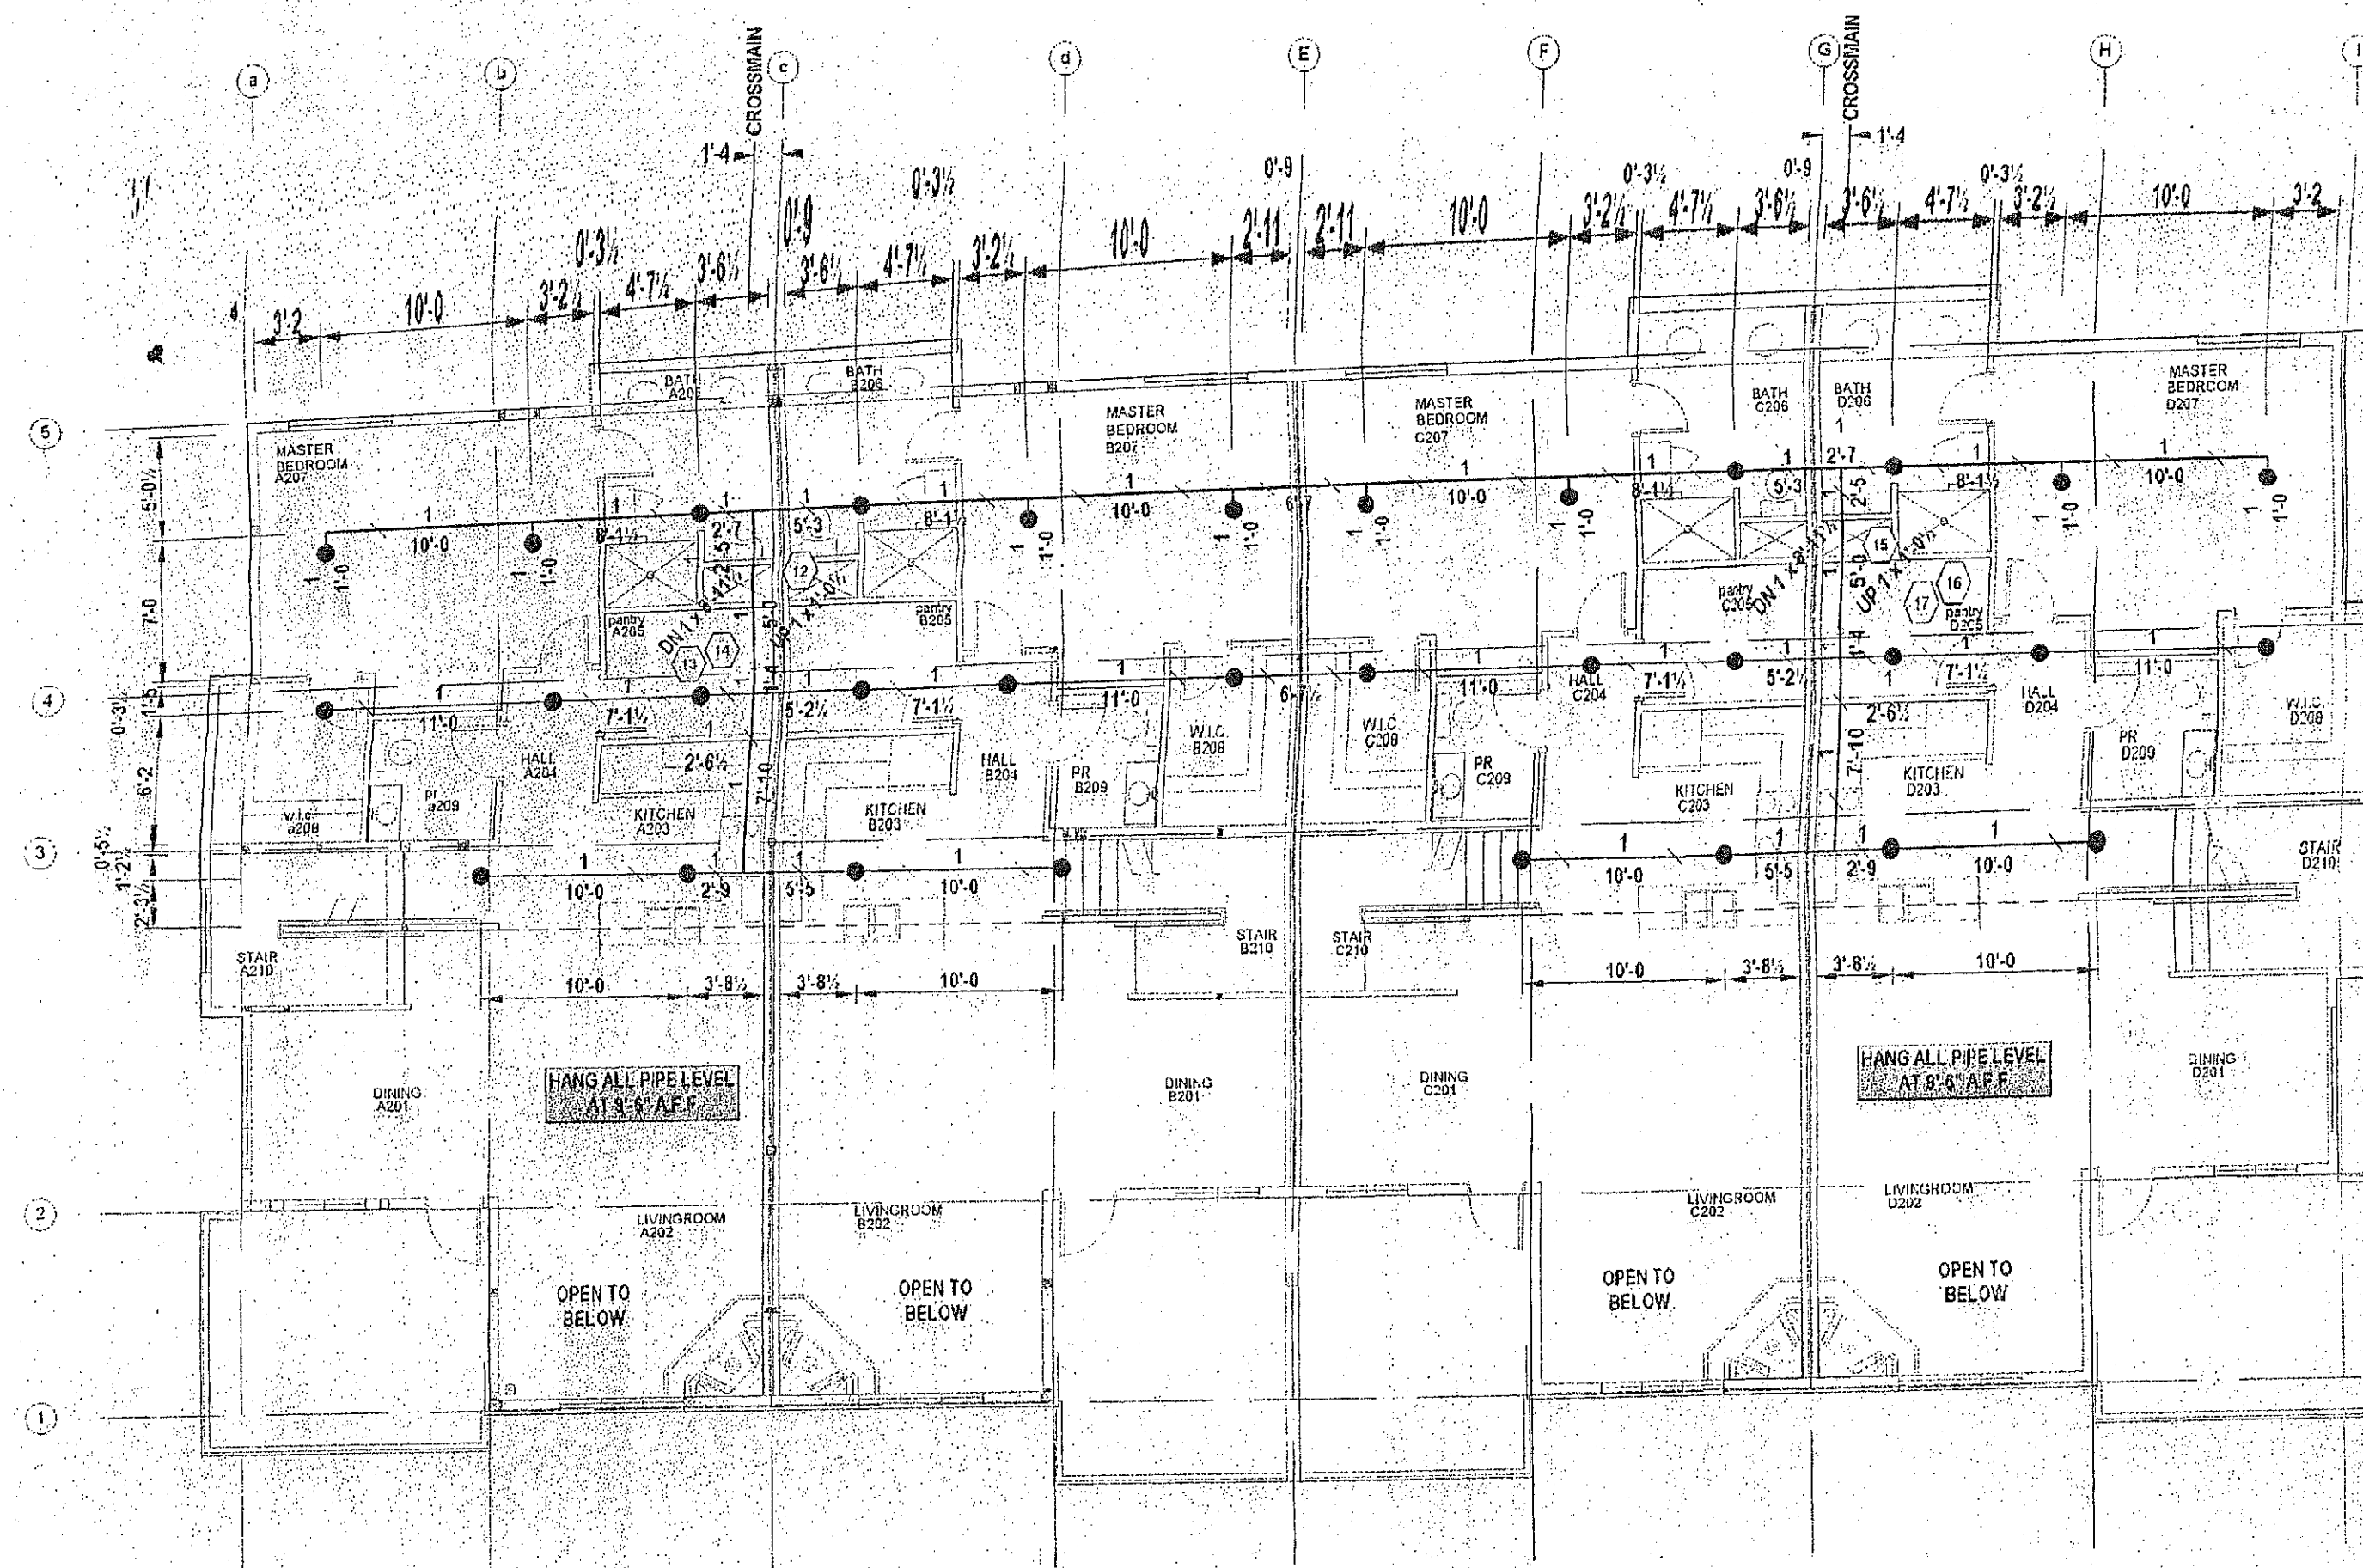

A FIRE SPRINKLER PLAN - 2ND FLOOR
FP2 1/8" = 1'-0"

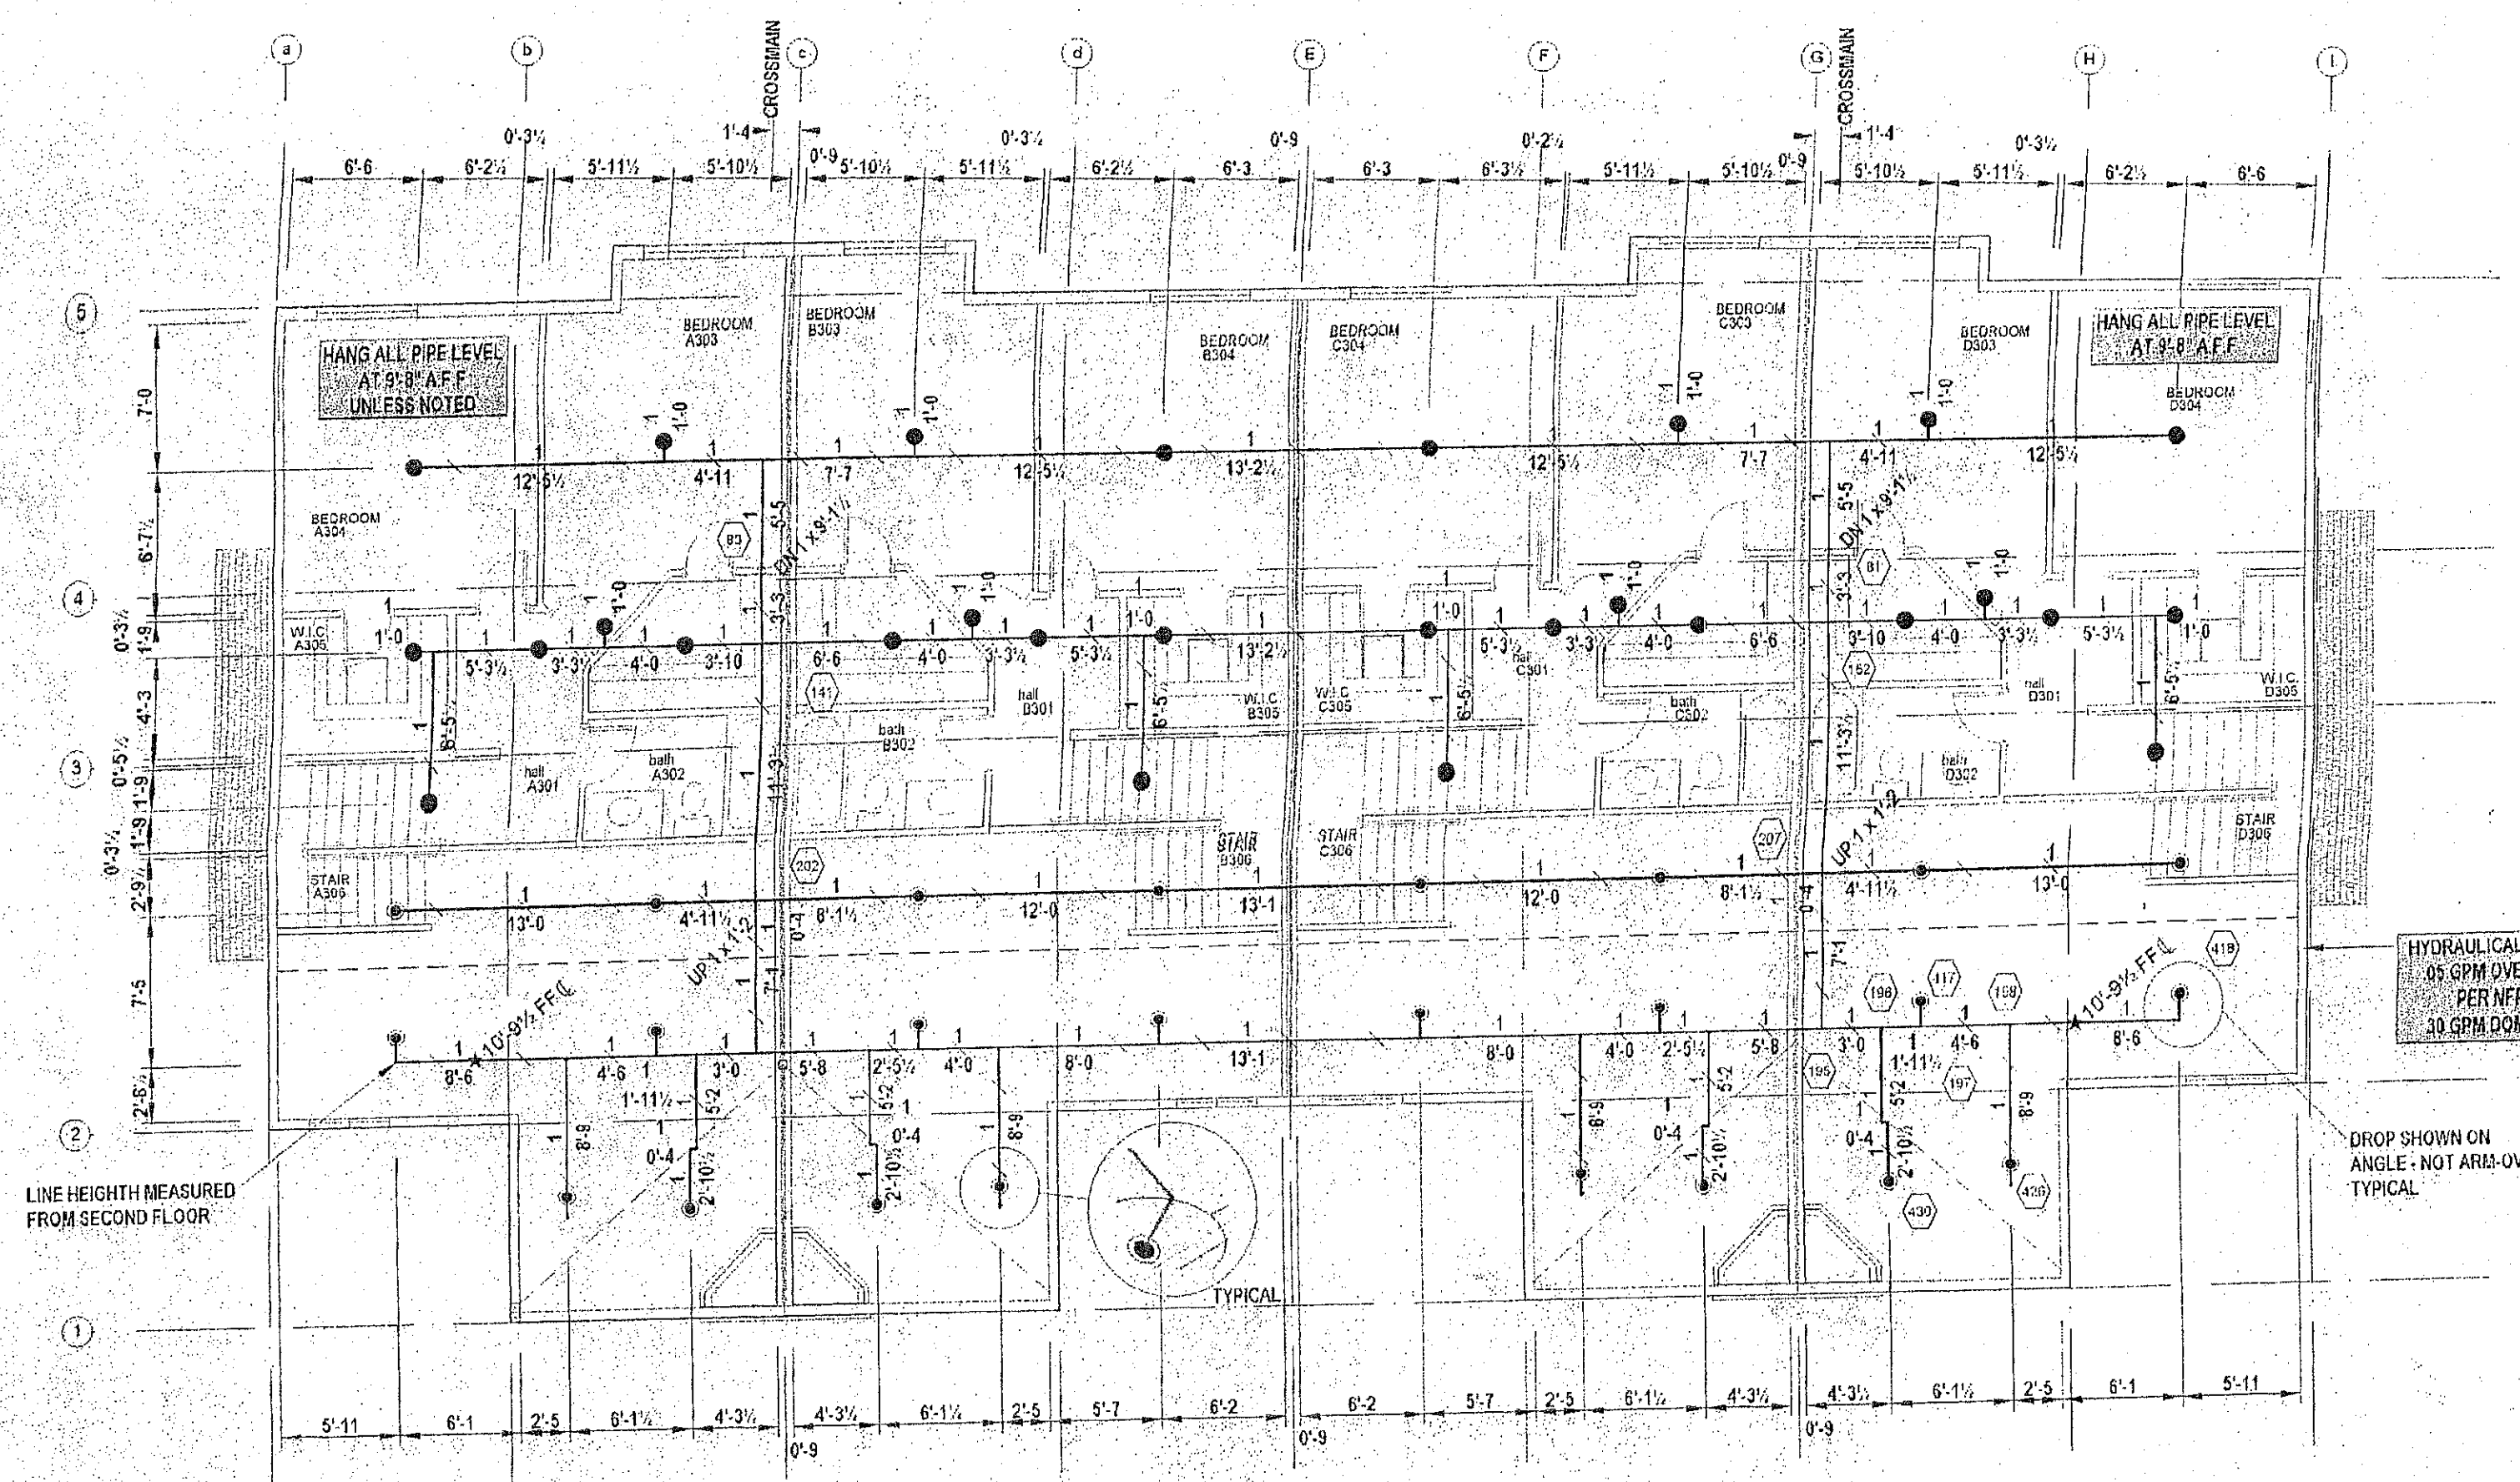

A FIRE SPRINKLER PLAN - 3RD FLOOR
FP2 1/8" = 1'-0"

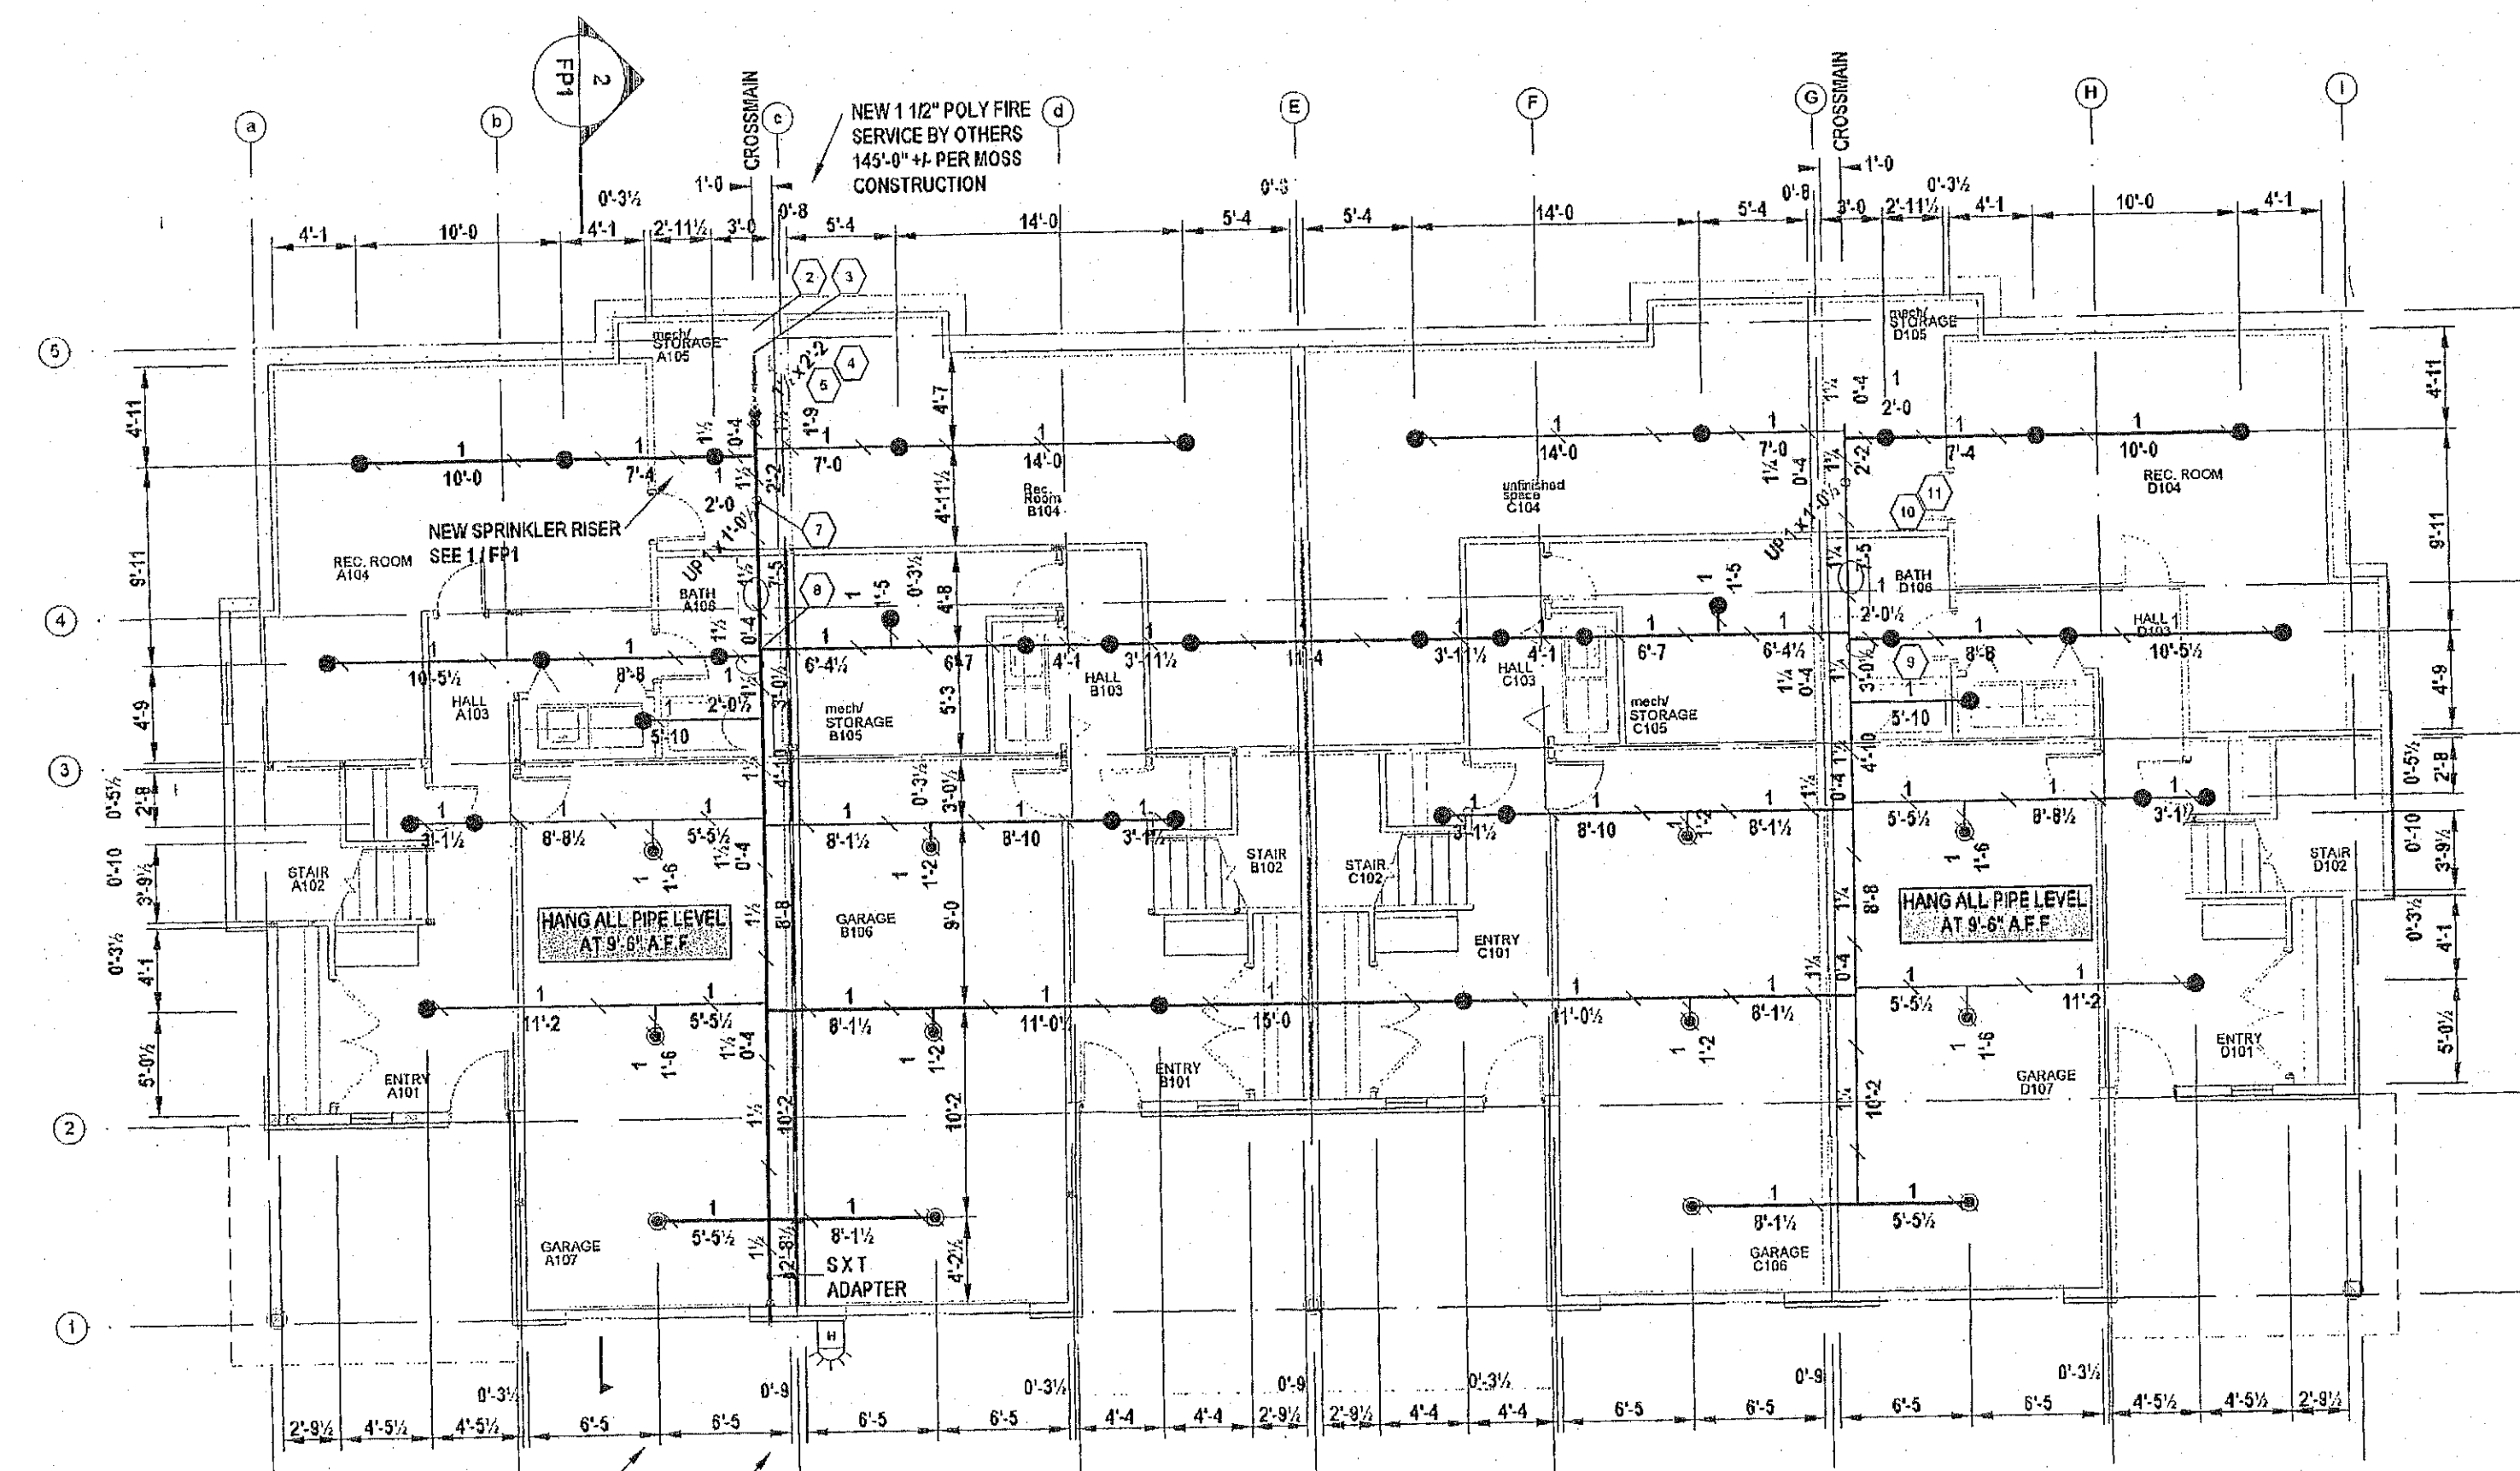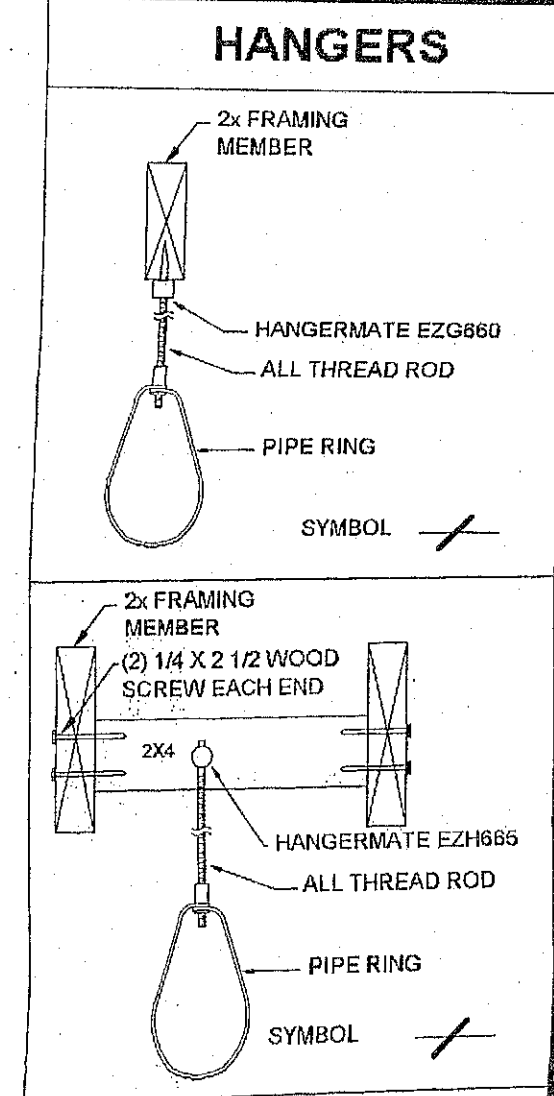


A FIRE SPRINKLER PLAN - 1ST FLOOR
FP2 1/8" = 1'-0"

HANGER NOTES

- 1) HANG PIPE AT ELEVATION NOTED WITH HANGER NOTED, 3/8 X C/F ATR AND RING - PER DETAILS THIS SHEET

GENERAL NOTES

- 1) ALL CEILINGS ARE 8'-11 1/2" A.F.F. UNLESS NOTED THUS: (X-X)
- 2) INSTALL BRANCHLINES AT UPPER LEVEL 4" ABOVE ANY NEW CEILING.
- 3) * 0'-0" FF ϕ DENOTES CENTER OF PIPE ELEVATION TO FINISH FLOOR
- 4) INSTALL APPROVED FIRE CAULK AT ALL FULL HEIGHT WALL PENETRATIONS PER 3/FP1
- 5) ALL PIPING TO BE CPVC WITH CPVC FITTINGS (UNLESS OTHERWISE NOTED).
- 6) MAXIMUM PENDENT HEAD SPACING SHALL NOT BE GREATER THAN 16 X 16 FEET, OR 256 SQ. FT.
- 7) ALL DROPS TO PENDENT SPRINKLERS TO BE 1" X 0.4" CPVC WITH 1" X 1/2" SPRINKLER ADAPTER
- 8) ALL PIPE CUT LENGTHS ARE CENTER TO CENTER.

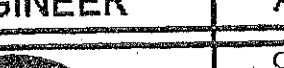NOTICE	ENGINEER	APPROVALS & COORDINATION			HYDRAULIC DESIGN DATA				SPRINKLER HEADS										
IT IS THE OWNERS RESPONSIBILITY TO PROVIDE ADEQUATE HEAT TO PREVENT FREEZING THROUGHOUT WET PIPE SPRINKLER SYSTEM AREAS AND IN ENCLOSURES FOR DRY PIPE AND OTHER TYPES OF VALVES CONTROLLING WATER SUPPLIES TO SPRINKLER SYSTEMS.	 BRYAN J. KENDRICK Certification Number 088444 - LEVEL IV	ORGANIZATION	CONTACT	PHONE	HAZARD CLASSIFICATION: RESIDENTIAL	SYSTEM AREA: 4,346	SQ. FT.	MANUFACTURER	MODEL	SIN#	TYPE	FINISH	ORIFICE	DROP	CANOPY	TEMP	SYMBOL	QTY.	
		BIG SKY FIRE DEPARTMENT	J. REVISKY	(406)995-2100	HYDRAULIC DESIGN DATA: .05	GPM/SQ. FT.	256	SQ. FT./HD MAX	CENTRAL	LFII	TY2590	SSP	BRASS	7/16K-4.2	98	WHT CNCLD	160°	●	98
					AREA OF APPLICATION: 4 HEADS	SQ. FT.	HOSE ALLOW: 27	GPM	CENTRAL	LFII	TY2234	SSP	WHITE	7/16K-4.9	24	WHT RECD	155°	●	24
		TOTAL SYSTEM REQUIREMENTS:																	
		55.1 GPM AT 73 PSI AT CITY CONNECTION																	
		WATER SUPPLY INFORMATION																	
		STATIC PRESSURE: 91 PSI																	
		RESIDUAL PRESSURE: 71 PSI WITH 300 GPM FLOWING																	
		TEST TAKEN AT: J-502 BY: CTA DATE: 3-6-2004																	
		TOTAL 134 TOTAL 134																	
SYSTEM TYPE																			
WET X																			
DRY																			

Fire Sprinkler Specialties, Inc.
Service, Installation and Design
PMB 2017
#1 Jackson Creek Road
Montana City, MT 59634
Phone: 406-227-6050
Fax: 406-227-7936

REVISIONS			CONTRACT NAME:
NO.	DATE	DESCRIPTION	ALPENGLOW - UPHILL UNIT BIG SKY, MONTANA 59716
			CONTRACT WITH:
			MAUS CONSTRUCTION, INC.
			200 E. WILLIAMS ROAD
			GALLATIN GATEWAY, MT 59730
			FIRE SPRINKLER PLAN

SCALE: 1/8" = 1'-0"
DRAWN BY: B. KENDRICK
CHECKED BY: J. STEAB
DATE: 02/2/05
CONTRACT NO.:
INWSD NO.: 0504
SHEET NO.:
FP2 OF 2