


FOREST GLEN INN OWNERS' ASSOCIATION
 Formerly Forest Glen Inn, Inc.
 August 20, 1979 - B. 759, P. 339

(See 1978-9 Plan of Forest Glen Inn, Inc. & Frank Silvey Property for Robert Forcier by Thome Surveys, recd. RB. 46, P.25)

PASQUALE FRANCHI
 Formerly Robert J. Forcier
 September 27, 1984 - B. 963, P. 331

(See 1969 Plan of Subdivision No. 2 for Artist Falls Corp. by C.R. Storer, Inc., recd., RB. 13, P.19)

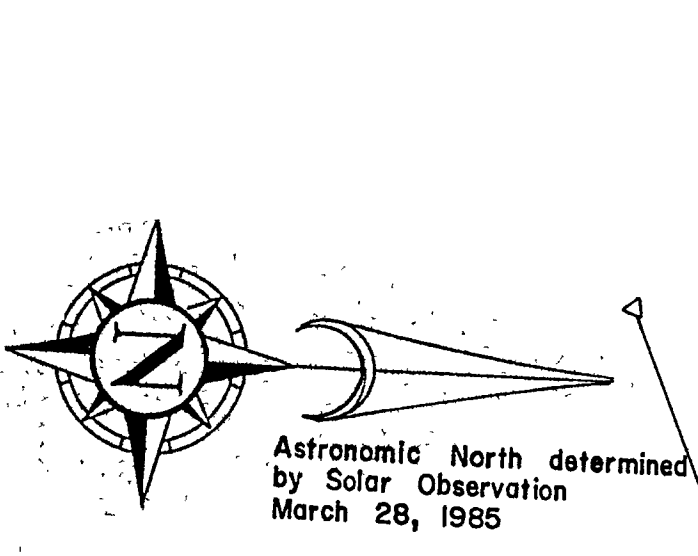

CARROLL COUNTY
 REGISTRY OF DEEDS
 PLAN BOOK 102
 PAGE 42
 REGISTER

EDWARD J. McNALLY, JR.
 Formerly Philip A. Robertson
 December 1, 1960 - B. 349, P. 435

JAMES A. & JUDITH A. MENSEREAU
 Formerly Alfred B. Gobeille
 March 18, 1971 - B. 482, P. 321

MATCH TO SHEET AB-1


TO ARTIST FALLS ROAD
 8 N.H. RTE. 16

TOWN OF CONWAY
 Formerly Artist Falls Corp. & William G. Duprey & Son, Inc.
 December 26, 1973 - B. 564, P. 413

WOODLAND ROAD

(See 1961 Subdivision Plan of C.A. Potter & P.A. Robertson Property by Thome Surveys, recd. RB. 7, P.5)

The Subdivision Regulations of Conway are a part of this plat and approval of this plat is contingent on completion of all the requirements of said subdivision regulations, excepting only any variances or modifications made in writing by the Planning Board and the Registrar.

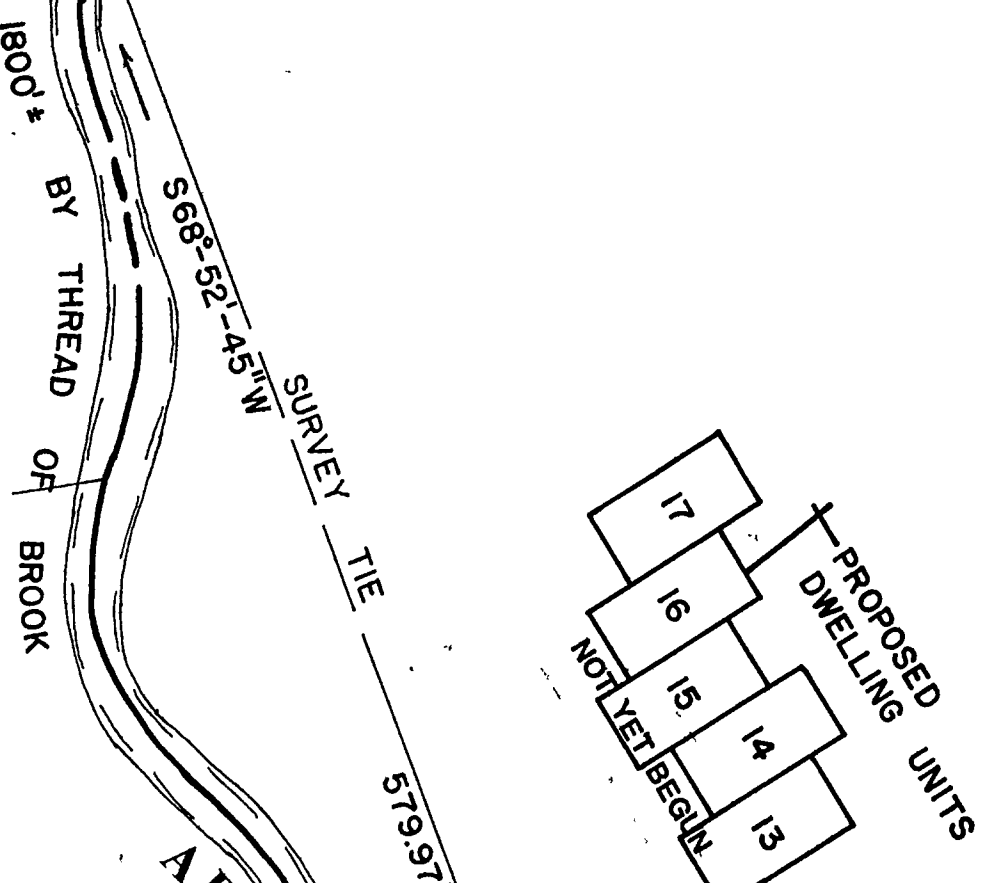

WILLIAM J. & SUE ANNE HOUNSELL
 Formerly Joseph P. Diorio
 September 18, 1980 - B. 798, P. 275

LOT 1
 TRACT 1

JUDITH A. NELL
 Formerly North Conway Chalet Properties, Inc. - December 7, 1977 - B. 694, P. 359


LOTS 8 & 9

LINDA J. FARLEY & MARILYN WATSON
 Formerly North Conway Chalet Properties, Inc. - September 15, 1977 - B. 694, P. 225

JAMES G. & BETTY J. SYLVESTER
 Formerly John H. & Jane C. Watts - July 26, 1972 - B. 518, P. 350

MARIANO, JR. & GERALDINE PIMENTAL
 Formerly Artist Falls Corp.
 August 18, 1971 - B. 492, P. 306

ARTIST FALLS CORP.
 Formerly James D. & Samuel Palumbo - July 12, 1976 - B. 631, P. 177

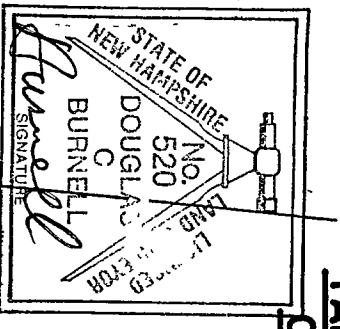


Plans acknowledged by the Conway Planning Board as an "As-Built" Plan of an approved Subdivision of said Board. Copyright © 1987 HEBCEPA
 William Reed of 11/15/87 All Rights Reserved

he.b.

H. EDMUND BERGERON
CIVIL ENGINEERS, P.A.
 NORTH CONWAY, N.H.

SURVEYED BY: RWU
 DESIGNED BY:
 DRAWN BY: HMM
 CHECKED BY: FHB

DATE	REVISION

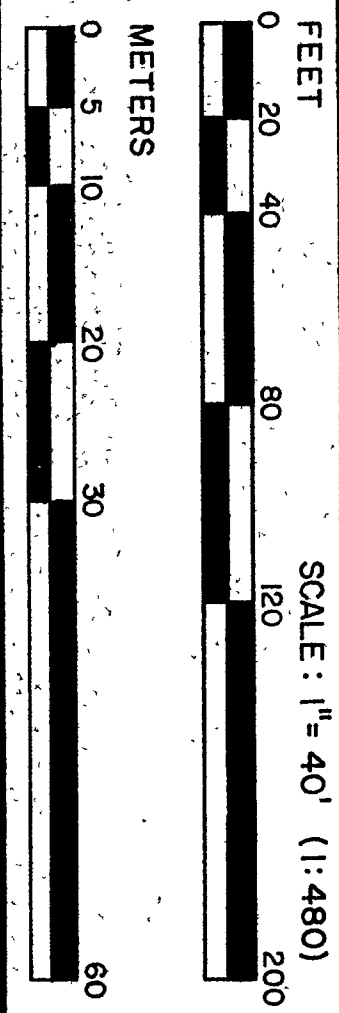

AS BUILT PLANS
 OF
ARTIST BROOK CONDOMINIUMS
 IN
TOWN OF CONWAY N.H.
 PREPARED FOR
WOODLAND RD. REALTY TRUST

AB-2
SHEET 2 OF 5
 9-28-87
 1-730-87

018725

RECEIVED
 1987 OCT 21 AM 9:19
 CARROLL COUNTY
 REGISTRY OF DEEDS

LOT 27