

Chatham

Wadleigh

182 440-A

182440

Request 15 Nov 1990

Homeowner

356 - 5436

portland glass

APPROVAL FOR CONSTRUCTION

N.H. DEPARTMENT OF ENVIRONMENTAL SERVICES
WATER SUPPLY & POLLUTION CONTROL DIVISION
P.O. BOX 95, 6 HAZEN DRIVE, CONCORD, NH 03301

THE PLANS AND SPECIFICATIONS FOR SEWAGE OR WASTE DISPOSAL SYSTEM SUBMITTED FOR:

OWNER:

SCOTT WADLEIGH
PO BOX 3178
NORTH CONWAY, NH 03860

APPROVAL NO. 182440

Lot Numbers: 2
Subd. Appvl. No.: 35043
Subd. Name: 35043

COPY OF PLAN & APPROVAL SENT TO:

Type of System: 0000003BR
0004506PD

BOARD OF SELECTMEN
HCR, BOX 233
CHATHAM, NH 03813

Town/City Location:

CHATHAM

BY APPLICANT: PERMIT NO. 000000209

Street Location:

SOUTH CHATHAM ROAD

THORNE SURVEYS
BROWNFIELD ROAD
CENTER CONWAY, NH, 03813

Subsurface waste disposal systems must be operated and maintained in a manner so as to prevent nuisance or health hazard due to system failure.
(RSA 149-E:3-b)

It is unlawful to discharge any hazardous chemicals or substances into subsurface waste disposal systems. Included are paints, thinners, gasoline and chlorinated hydrocarbon solvents such as TCE, sometimes used to clean failed septic systems and auto parts. (WS 410.05)

ADVISE YOUR CONTRACTOR OF REQUIRED CHANGES
IN PLANS AS INDICATED BELOW CONDITIONS

Approved this date: 07/13/90

By:

Stephanie Larson
STEPHANIE LARSON

N.H. Water Supply & Pollution Control
Division Staff

REVISED 2/87

W0061660

(OVER)

N.H. DEPARTMENT OF ENVIRONMENTAL SERVICES
WATER SUPPLY & POLLUTION CONTROL DIVISION
P.O. BOX 95, 6 HAZEN DRIVE, CONCORD, NH 03301

THIS APPROVAL DOES NOT SUPERSEDE ANY EQUIVALENT OR MORE
STRINGENT LOCAL ORDINANCES OR REGULATIONS, STATE
STANDARDS ARE MINIMAL AND MUST BE MET STATEWIDE.

**IN THE EVENT OF SYSTEM FAILURE, IT SHALL BE THE
RESPONSIBILITY OF THE OWNER TO CORRECT
ANY SUCH FAILURE.**

NO LIABILITY IS INCURRED BY THE STATE by reason of any approval of subdivision plans or any approval to construct or use a sewage or waste disposal system. Approval by the Water Supply And Pollution Control Division of sewage and waste disposal systems and subdivisions is based on plans and specifications supplied by the applicant.

NO GUARANTEE IS INTENDED OR IMPLIED BY REASON OF
ANY ADVICE GIVEN BY THE DIVISION OR ITS STAFF.

PLEASE POST IN A CONSPICUOUS PLACE DURING CONSTRUCTION

The system must be constructed in strict accordance
with the approved plans and specifications.

The installed system must be left uncovered and cannot be used
after construction until it is inspected and
finally approved by an authorized agent
of the Division. This is to make
certain the system is built
according to the approved
plans and specifications.

CONTACT THIS OFFICE: 271-3501, OR OUR AUTHORIZED
LOCAL AGENT, IF ANY, WHEN READY FOR INSPECTION!

This system must be installed by an installer holding out permit except an owner may install the system for his domicile/exemption.

Ws 1003.07 (a) ALL CONSTRUCTION APPROVALS ISSUED BY THE DIVISION
SHALL EXPIRE 4 YEARS FROM THE DATE OF ISSUE, UNLESS AN OPERATIONAL
APPROVAL HAS BEEN GRANTED OR IS IMMINENT FOR SUBJECT CONSTRUCTION.

APPROVAL FOR OPERATION

N.H. DEPARTMENT OF ENVIRONMENTAL SERVICES
WATER SUPPLY & POLLUTION CONTROL DIVISION
P.O. BOX 95, 6 HAZEN DRIVE, CONCORD, NH 03301

THE INDIVIDUAL SEWAGE OR WASTE DISPOSAL SYSTEM CONSTRUCTED FOR:

OWNER:

SCOTT WADLEIGH
PO BOX 3178
NORTH CONWAY, NH 03860

COPT SENT TO:

BOARD OF SELECTMEN
HCR, BOX 233
CHATHAM, NH 03813

Subsurface waste disposal systems must be operated and maintained in a manner so as to prevent nuisance or health hazard due to system failure.
(RSA 149-E:3-b)

It is unlawful to discharge any hazardous chemicals or substances into subsurface waste disposal systems. Included ate paints, thinners, gasoline and chlorinated hydrocarbon solvents such as TCE, sometimes used to clean failed septic systems and auto parts. (WS 410.05)

REVISED 2/87

W0061660

Amended to show new location of house, well, septic tank, d-box & sewer lines

APPROVAL NO.

182440

A

Lot Numbers:

Subd. Appvl. No.:

Subd. Name:

2

35043

35043

Type of System:

0000003BR

000450GPD

Town/City Location:

Street Location:

CHATHAM
SOUTH CHATHAM ROAD

Installer

Permit No.

☒ Owner Installed For His Domicile

Was Inspected On (Date) 16 Nov 1990
Before Covering And Is Hereby Approved For Use.

Date Approved: 16 Nov 1990

By:

Frank H. Train
Authorized Agent Of N.H. Water Supply And
Pollution Control Division

(OVER)

NHDES, WSPCD FILE

GOLD = Owner's

YELLOW = Town's;

BLUE = NHDES, WSPCD file

N.H. DEPARTMENT OF ENVIRONMENTAL SERVICES
WATER SUPPLY & POLLUTION CONTROL DIVISION
P.O. BOX 95, 6 HAZEN DRIVE, CONCORD, NH 03301

THIS APPROVAL DOES NOT SUPERSEDE ANY EQUIVALENT OR MORE
STRINGENT LOCAL ORDINANCES OR REGULATIONS, STATE
STANDARDS ARE MINIMAL AND MUST BE MET STATEWIDE.

**IN THE EVENT OF SYSTEM FAILURE, IT SHALL BE THE
RESPONSIBILITY OF THE OWNER TO CORRECT
ANY SUCH FAILURE.**

NO LIABILITY IS INCURRED BY THE STATE by reason of any approval of subdivision plans or any approval to construct or use a sewage or waste disposal system. Approval by the Water Supply And Pollution Control Division of sewage and waste disposal systems and subdivisions is based on plans and specifications supplied by the applicant.

NO GUARANTEE IS INTENDED OR IMPLIED BY REASON OF
ANY ADVICE GIVEN BY THE DIVISION OR ITS STAFF.

() Data Input () Expedite

Construction Approval No. _____

CONSTRUCTION APPROVAL CHECKLIST

Work No. 61660

TOWN: Chatham
 SUBDIVISION NAME: Patch
 Owner: Wadleigh
 SIZE: 3 (BR) FLOW: 450 (GPD)
 DESCRIPTION/TYPE OF SYSTEM: _____

SUBDIVISION APPROVAL NO: 35043
 LOT NUMBER/UNIT NUMBER: 2

- TYPE**
- ☒ 1. Single Family Residence (4 - bedroom max.)
 - ☐ 2. Apartment
 - ☐ 3. Condominium
 - ☐ 4. Mobile Home Park
 - ☐ 5. Camping/Tenting
 - ☐ 6. Commercial
 - ☐ 7. Industrial
 - ☐ 8. Public Food Handling
 - ☐ 9. Duplex
 - ☐ 10. Other

- DESIGN**
- ☐ n. In-ground
 - ☒ o. Above-ground/Mounded
 - ☐ p. Ledge Lot
 - ☐ q. Chambers
 - ☐ r. Pressure Distribution
 - ☐ s. Dry Well
 - ☐ t. Trenches
 - ☐ u. Modified Dry Well
 - ☐ v. Holding Tank
 - ☐ z. Other

Waiver Granted (yes/no): _____

Previous Construction Approval # _____

Status: 1. New 4. Revised
 2. Replacement 5. Other
 3. Amended

RETURN DATE:

6/8/90

BY: 82

RETURN REASON:

RESUBMITTAL DATE:

APPLICATION DATE: May 31 1990

SITE INSPECTION DATE: July 10 1990 Peter Hammer

PROJECT COORDINATOR: _____

APPROVALS REQUIRED: D&F _____ 149:8a _____ WS _____ (UIC)GWP _____ Other _____

SOILS GROUP: 3 TYPE: BKC Becht LOT SIZE: 60636.84

PERC. RATE: Comp 1 AMEND: _____ APPROVAL DATE: July 13, 1990

CONDITIONS: _____

APPROVED BY: Stephanie Larson

NOTE: (☒) Gravity System () Other

Bed bottom to be set:

to maintain:

() no deeper than _____" below the original ground.

(☒) 4 ' min. above the reported/any S.H.W.T.

() no less than _____" above the original ground.

() 8 ' min. above the reported/any ledge depth.

() no lower than the original ground at high contour.

() 8 ' min. above the reported/any impermeable soil.

() Fill spec. OK.

- | | |
|-------------------------------------|--|
| ☒ | 1. DESIGNER'S SEAL |
| ☒ | 2. TOWN APPROVAL (stamp and/or signature required) |
| ☒ | 3. P.E. STAMP (systems greater than 2500 GPD, ledge lots - same person as designer) |
| ☒ | 4. TWO (preferably 3) COPIES |
| ☒ | 5. SCALE 1" = 20' Plan |
| ☒ | 6. SIZE - fold to 8 1/2 x 11", location plan and title showing. |
| ☒ | 7. LOT PLAN - with dimensions and area shown. |
| ☒ | 8. BUILDINGS - existing and proposed shown. |
| ☒ | 9. WELL - location & radius (keep radius within lot lines if possible). |
| ☒ | 10. WATER PIPES - proposed & existing from well or main line. |
| ☒ | 11. DISPOSAL SYSTEM SCALE PLAN - all proposed components & piping. |
| ☒ | 12. SEPTIC TANK - location, size, volume, material. |
| ☒ | 13. SECTION THRU SYSTEM - show original grade profile. |
| ☒ | 14. KEY ELEVATIONS & INVERTS |
| ☒ | 15. PIPE SLOPES & SIZE - recommend Sch 40 or Cast Iron thru foundation to tank. |
| ☒ | 16. MANUFACTURE, SPECIFICATIONS & MATERIALS - all key components; include tanks, D-Box, pumps & piping. |
| ☒ | 17. TOPO - 2 foot contours, 75' all directions from proposed system, including detail beyond property line. |
| ☒ | 18. LEACHING PIPE - statement pipes are to be level. |
| ☒ | 19. SEPTIC STONE - indicate specifications. |
| ☒ | 20. CHAMBER DETAILS - vents, wire mesh, flow distribution (40% reduction private dwellings only). |
| ☒ | 21. PRESSURE DISTRIBUTION - calculations, waiver form, basal area delineation. |
| ☒ | 22. LOCATION PLAN - with detailed directions to site, include mileages from intersections, poles (show number) and landmarks. |
| ☒ | 23. CLAY BARRIER or Heavy Soil Blanket - shown for raised system. |
| ☒ | 24. SEALANTS —specify for pipe penetrations & tank joints (not roof tar). |
| ☒ | 25. SURFACE WATER - nearest location, include seasonal wet areas & channels - state if none within 75'. |
| ☒ | 26. LEDGE - outcrops or boulders greater than three foot diameter, within 75 feet of system. |
| ☒ | 27. FOUNDATION DRAINS & OUTLET LOCATION - if none, so state . |
| ☒ | 28. BENCH MARK - permanent, close to & within sight of system. |
| ☒ | 29. TIES TO FIELD - at least two to permanent or semi-permanent control points. |
| ☒ | 30. USE - indicate if residential or commercial and type of facility, within flow calculations, i.e. condo, apartment, restaurant, office, etc. |
| ☒ | 31. FLOW CALCULATIONS (or bedroom count for residential). |
| ☒ | 32. TEST PIT - location & depth to ledge, impervious & S.H.W.T. mark with stakes and numbers in field. |
| ☒ | 33. SOILS LOG - descriptions of types & properties including color, texture, structure, consistency and depth to mottling. |
| ☒ | 34. SOILS CLASSIFICATION - SCS survey data & copy of mapping with locus. Clearly show number or abbreviation. |
| ☒ | 35. PERCOLATION TEST - location, depth & rate. |
| ☒ | 36. PUMP SYSTEM - specs., detail, dose volume, pump size, wiring spec. valves & piping, controls & control elevations, alarm, capacity and heads of pumps. |
| ☒ | 37. REPLACEMENT SYSTEM - location or narrative to indicate failure or reason for new design. |
| ☒ | 38. HOLDING TANKS - waiver form, 2000 gallons minimum, alarm, water tight. |
| ☒ | 39. RECEIVING AREA/LAYER - adequate (75 feet). |
| ☒ | 40. MINIMUM - system 300 GPD system design (500 GPD commercial). |

ATTACH ADDITIONAL CONDITIONS, ETC. TO BE TYPED ON APPROVAL ("REMARKS" ON BOTTOM OF REVERSE SIDE - TYPED BY W. PROC. AS CONDITIONS ON APPROVAL)



Department of Environmental Services
Water Supply and Pollution Control Division
Subsurface Systems Bureau
P.O. Box 95 - Hazen Drive
Concord, New Hampshire 03301
271-3501/3502

2 61660

APPLICATION FOR INDIVIDUAL SEWAGE DISPOSAL SYSTEM APPROVAL



DO NOT WRITE IN THIS SPACE
FOR OFFICE USE ONLY

Fee Paid 80 Check No. 573
Date Received MAY 31 1990
Date Entered _____

Work No. _____
By _____

Failed System Replacement _____
Expedite _____
Waiver Request _____

\$80.00 per Lot

1. System Location:

CITY/TOWN: Chatham
STREET: South Chatham Road
SUBDIVISION NAME: JEFF Patch, Province Falls
STATE APPROVAL NO. #35043

CITY/TOWN APPROVAL OBTAINED: Chatham

IF YES/DATE: _____ NO _____ NOT REQUIRED ☒

LOT NO: _____ TAX MAP NO: _____
3 lot subdivision

2. Water Supply:

MUNICIPAL WATER SUPPLY _____ COMMUNITY _____ WELL ON LOT ☒ OTHER _____

3. Lot OWNER'S Name: Scott Wadleigh STREET: P.O. Box 378
CITY/TOWN: No. Conway STATE: NH ZIP: 03860 TEL. NO: 356-5436

4. APPLICANT'S Name: Thorne Surveys STREET: Brownfield Road
CITY/TOWN: Center Conway STATE: NH ZIP: 03813 TEL. NO: 447-2254

Designer's Name: DAVE Douglass Permit No: 209 P.E.: _____

(P.E. required if more than 2,500 GPD)

5. Amended Plan _____ Revised Plan _____ Previous Construction Approval No. _____

THE STATEMENT BELOW MUST BE SIGNED AND DATED BY THE APPLICANT AND OWNER(S)

Owner(s):

THE UNDERSIGNED CERTIFY THAT THEY ARE THE PRESENT OWNERS OF THE PROPERTY BEING APPLIED FOR AND THAT THEY HAVE SEEN THE PLANS AND THEY ARE IN ACCORDANCE WITH THEIR NEEDS AND DESIRES. THE UNDERSIGNED FULLY UNDERSTANDS THAT SHOULD THIS PLAN BE APPROVED, NO WAIVERS TO THE CONSTRUCTION APPROVAL WILL BE ALLOWED. ANY CHANGES WILL REQUIRE A NEW SUBMISSION (WITH FEE), REVIEW AND APPROVAL.

Date: 21 MAY 1990 Signed: [Signature]
Owner(s)

Applicant:

To the best of my knowledge, the data and information which I have submitted to obtain approval for construction from the New Hampshire Water Supply and Pollution Control Division is true and correct. I understand that an approval based upon incorrect data may be subject to revocation. I also understand that NO CONSTRUCTION OF ANY STRUCTURE SERVICED BY THE PROPOSED SYSTEM, NOR THE SYSTEM ITSELF, MAY COMMENCE WITHOUT PRIOR WRITTEN DIVISION APPROVAL. I HAVE COMPLIED WITH ALL LOCAL REGULATIONS OR ORDINANCES RELATIVE TO CONSTRUCTION OF SEWAGE DISPOSAL SYSTEMS AND HAVE OBTAINED ALL OTHER APPROVALS THAT MAY BE REQUIRED FOR OTHER WORK RELATED TO CONSTRUCTION OF THE SEWAGE DISPOSAL SYSTEM. The applicant herewith certifies, where applicable, that the approved off-site, municipal or community, water supply is available at the lot line.

Date: 21 MAY 1990 Signed: [Signature] 209
Applicant Permit No.

(Continued on Reverse Side)

YOU MUST SUBMIT THE FOLLOWING INFORMATION
(Put ALL information on plans)

Three (3) sets of scale plans (one inch = 20 feet) showing all lot dimensions and indicating the distance to and location of existing and proposed buildings, wells, and waste disposal systems. If the proposed system or well is closer than seventy-five (75) feet to a boundary, you will need to indicate what is on the adjoining lot. If the lot is so large that it cannot be scaled 1" = 20' on your drawing, two copies of a scale plan with a larger scale must also be submitted. The 1:20 scale plan must also contain pertinent elevation data and location of test pits and percolation test holes. All plans must be folded to 8 1/2 x 11". Show areas of exposed ledge or boulders greater than 3' in diameter within 75' of proposed system.

Specific directions so that inspector may easily drive to and find the site. Include mileages referenced from intersections or landmarks to this site.

Distance and location of nearest surface water in relation to disposal system (must be a minimum of 75 feet from all lakes, streams, ponds and swamps whether intermittent or year round).

a. Location of proposed and existing drinking water supply pipes. Soil Data (to be determined in leaching area for each system, indicate where and when tests were taken). Percolation test data including rate and depth of test.

b. Test Pit Log:

- * Show depth from original ground surface to the observed water table.
- * Show depth to seasonal high water table (springtime). This may be an estimate based on mottling, SCS data, etc., (water table must be four (4) feet below the bed during all seasons of the year).
- * Show depth from original ground surface to impermeable substratum (i.e. clay or ledge). Clay and hardpan will be considered impermeable unless proven otherwise. Bottom of leach bed, field or dry well must be eight (8) feet above any ledge or other impermeable substratum on lots with wells; and a minimum of 6 feet above ledge, etc., on lots with approved off-lot water supplies (municipal or community).
- * Where fill is required, filled area must extend a minimum of ten (10) feet in all direction beyond the edge of the bed at same elevation as top of the bed before tapering off at a 3:1 slope (3 horizontal to 1 vertical). A core or layer of impervious soil must be placed around the outside of bed to prevent lateral seepage of sewage. All topsoil, roots and organic matter under the leaching system must be removed before fill is placed. Show fill details and material specification on cross section.

c. Soil survey data for the lot. This information is available at the office of the Local Soil Conservation District Office. When taken from current soil map, a copy designating locus and site will be acceptable (state reference source).

Number of bedrooms or estimated sewage load in gallons per day.

Ground surface elevations for the lot showing the slope of the land at two foot contour intervals. Sufficient spot elevations are required to verify "level lots". Show original and proposed contours. Reference contours to a benchmark located near the proposed system. This topographical information must appear on the 1:20 scale plan.

Liquid capacity of septic tank, details and materials of construction.

Scale plan of leaching system with construction details and dimensions. Show sill elevations, invert elevations at building exit, inlet and outlet from septic tank, inlet and outlet from distribution box, invert of leach lines and bottom elevation of leaching area. Inverts must be referenced to your benchmark. Inverts may be best indicated on your cross section or profile sections.

Make, type and capacity of sewage pump, pump well, discharge line, siphons, siphon chambers, etc. (when used).

Number of outlets and name of manufacturer of distribution box (all laterals must be directly connected to distribution box, i.e., no tees in the middle of the bed or field will be allowed).

Cross section of leaching trench, leaching bed, or dry well showing all construction details (in leach bed, lines should be uniformly spaced from 3 to 5 feet on center and half of that distance in from the edge of the bed: present requirements for dry wells are 6 inches minimum of stone around sides of dry well and 1 foot minimum of stone under dry well). Show all fill details on cross section.

Type and size of stone. Must be clean and meet "septic stone" specifications.

Type, size and manufacturer of leaching pipe.

Type of leaching pipe joints for perforated pipes. (Ends of leaching pipes must be tied together, sealed by caps or plugged.)

Statement that leaching pipes and bottom of leaching area will be level.

Show a suitable area for a replacement system where available or state that the system may have to be rebuilt in place, if failure occurs.

LIABILITY IS INCURRED BY THE STATE by reason of any approval for construction of individual sewage disposal system. Approval by the Water Supply and Pollution Control Division of individual sewage disposal systems is based on plans and specifications supplied by the applicant. NO GUARANTEE IS INTENDED OR IMPLIED BY REASON OF ANY ADVICE GIVEN BY THE DIVISION OR ITS STAFF.



State of New Hampshire

DEPARTMENT OF ENVIRONMENTAL SERVICES
WATER SUPPLY & POLLUTION CONTROL DIVISION

6 Hazen Drive, P.O. Box 95, Concord, NH 03302-0095
(603) 271-3501/3502

COUNCIL

JOHN F. BRIDGES, Chairman
MICHAEL G. LITTLE, Vice Chairman
E. H. B. BARTELINK
RICHARD M. FLYNN
JAMES F. HAYDEN
GEORGE F. HURT
WILBUR F. LaPAGE
DONALD A. NORMANDEAU, Ph.D.
WAYNE L. PATENAUDE
JEFFREY TAYLOR
JAMES VAROTSIS
WILLIAM T. WALLACE, M.D., M.P.H.

ROBERT W. VARNEY
COMMISSIONER

RUSSELL A. NYLANDER, P.E.
CHIEF ENGINEER

June 8, 1990

Thorne Surveys
Brownfield Road
Center Conway, NH 03813

Subject: Wadleigh, Chatham

Dear Mr. Douglas:

A review of the plans for the subject disposal system has been completed. We regret to inform you that your application must be denied at this time for the following reasons:

1. ✓ Each line into the bed must exit separately from the D-box, no tee's or ell's allowed.
2. Pending a site check to verify SHWT and site conditions.
3. ✓ Please show a major road on your locus map or provide written directions to South Chatham Road.
4. ✓ Lot number?



If you have any questions or comments regarding this response contact me at your convenience.

Sincerely,

Stephanie Larson
Stephanie Larson
Sanitarian
Subsurface Systems Bureau

SL/jl
cc: Designer File 209

TYPICAL LEACH BED DESIGN

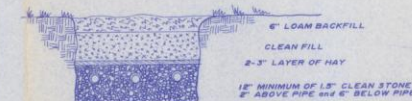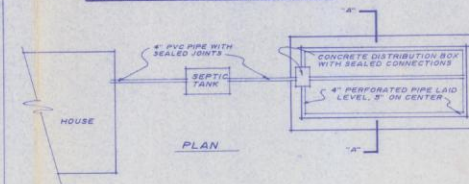

*NOT TO SCALE

SEPTIC SYSTEM SPECIFICATIONS

SEPTIC TANK TO BE 1,000 GALLONS, AS MANUFACTURED BY SUPERIOR, OR APPROVED EQUAL.
DISTRIBUTION BOX TO HAVE 4 OUTLETS, AS MANUFACTURED BY SUPERIOR, OR APPROVED EQUAL.
LEACH FIELD DIMENSIONS: LENGTH 33'-0" WIDTH 15'-0" AREA 495 S.F.
NUMBER OF LEACH LINES 4
GRAIN PIPE TO BE 4" PVC WITH SEALED JOINTS.
GRAIN TILE TO BE 4" PVC WITH COLLAR JOINTS OR APPROVED EQUAL.
THE BOTTOM OF LEACH AREA SHALL BE 2'-0" BELOW ORIGINAL GRADE ON UPHILL SIDE.
LEACH LINES SHALL BE SEALED INTO 2" BOX & SEPTIC TANK WITH HYDRAULIC CEMENT.
THERE IS NO SURFACE WATER, OR NEIGHBORING WELLS, WITHIN 75 FEET OF PROPOSED SYSTEM.
REPLACEMENT AREA: AS SHOWN
EACH BED TO BE DUG UP AND REPLACED IN SAME LOCATION IN THE EVENT OF FAILURE.

SOIL TEST DATA

TEST PIT LOG
0'-0" Dark/Black Topsoil 1 7/8 YR 2/0
10'-0" Dark/Brown Fine Sandy loam, friable, moist 6/1/1
20'-0" Coarse loamy sand, brown, mottled firm layers with fine sandy layers 2.5 YR 5/4
30'-0" Compact silty clay till grey, many angular fragments
24" water observed 18" count No ledge
PERM. RATE 6 GPH/line
DATE OF TEST 5/1/90
SOIL TESTER [Signature]

LOCATION SKETCH





LOT OWNER
NAME Scott Wadleigh
ADDRESS PO Box 3118 North Conway, NH 03860
SUBDIVISION NAME Telfs Patch, Province Falls Chatham, NH
SUBDIVISION APPROVAL NUMBER 23043 LOT NUMBER 2
STREET South Chatham Road
CITY or TOWN Chatham

STATE


DESIGNED BY [Signature]
CHECKED BY [Signature]
SURVEYED G.H. & M.G. 11/90 DRAFTED TDA 5/1/90
REVISIONS
SCALE AS NOTED
THADDEUS THORNE-SURVEYS, INC.
CENTER CONWAY, NEW HAMPSHIRE 03813

20-32

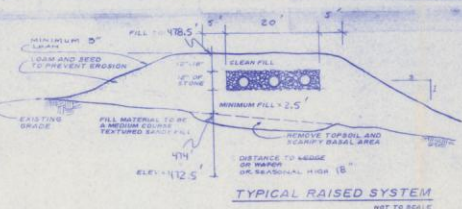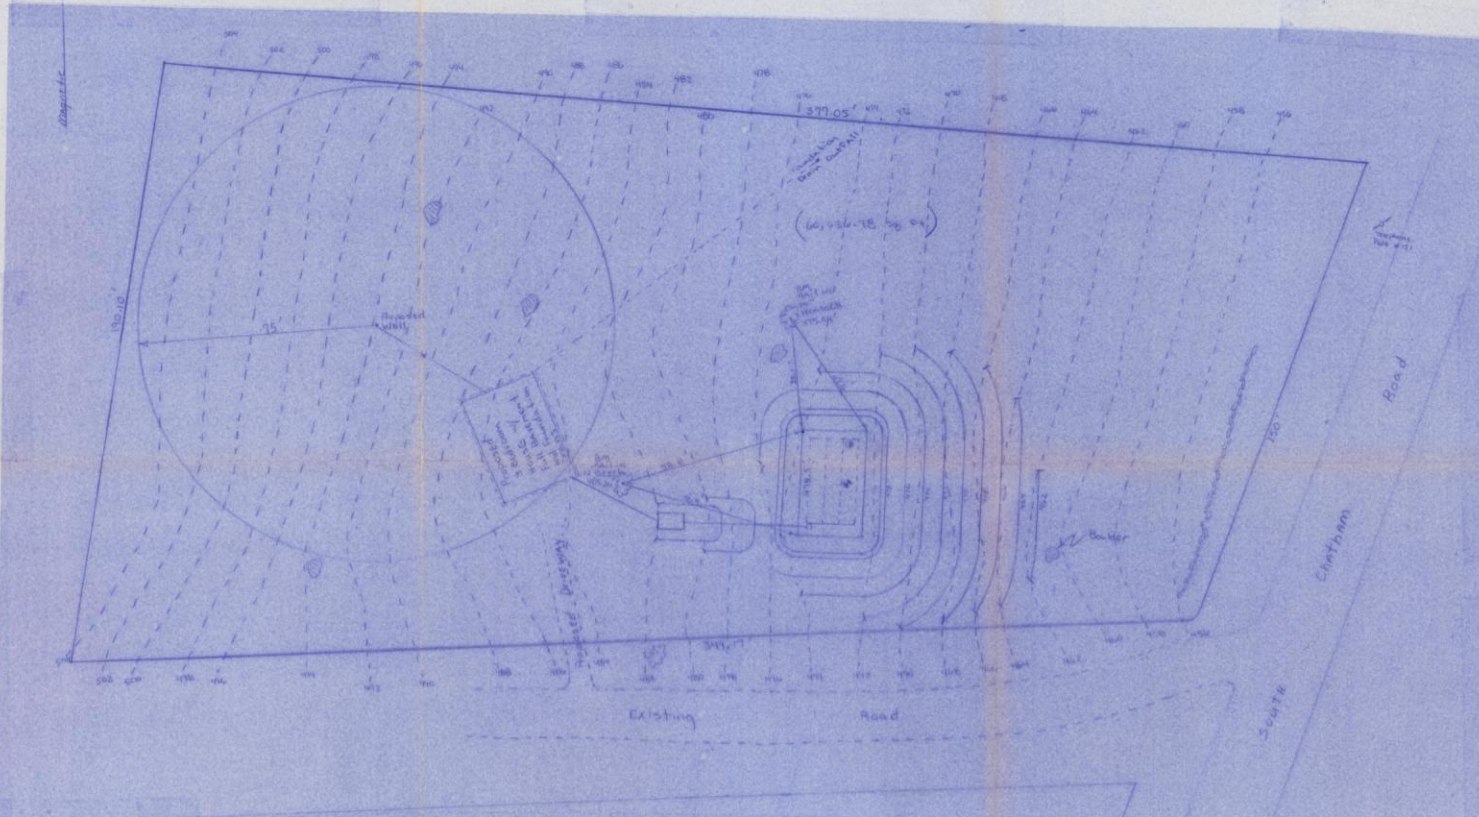

notes: 1. A 3 bedroom house creates 450 GPD which at a 6 min. perc rate requires 475 sq ft Leaching Area.



ORIGINAL GRADE 474
EXIST. F. 472.5
BED BOTTOM 470.5
FINISH GRADE 478.5
LEACH - NONE

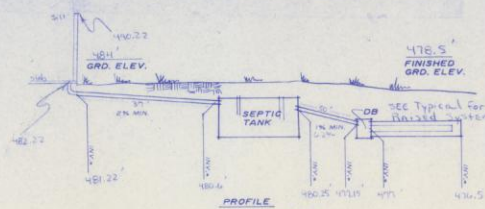

NOTE: THIS PLAN DOES NOT REPRESENT A BOUNDARY SURVEY.

SCALE 1" = 20'

THIS SEPTIC SYSTEM DESIGN IS BASED ON SOIL TESTS CONDUCTED ON 5/10/90. IF SOIL CONDITIONS ARE FOUND TO BE DIFFERENT AT THE TIME OF CONSTRUCTION, NOTIFY T. THORNE SURVEYS PRIOR TO PROCEEDING WITH CONSTRUCTION.

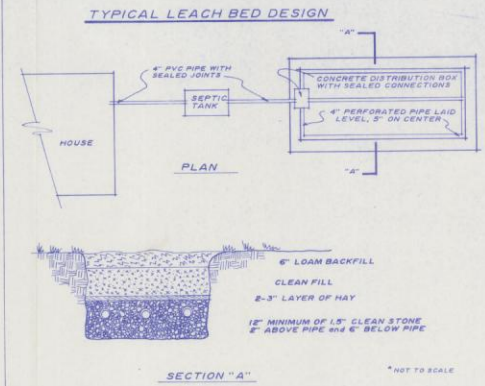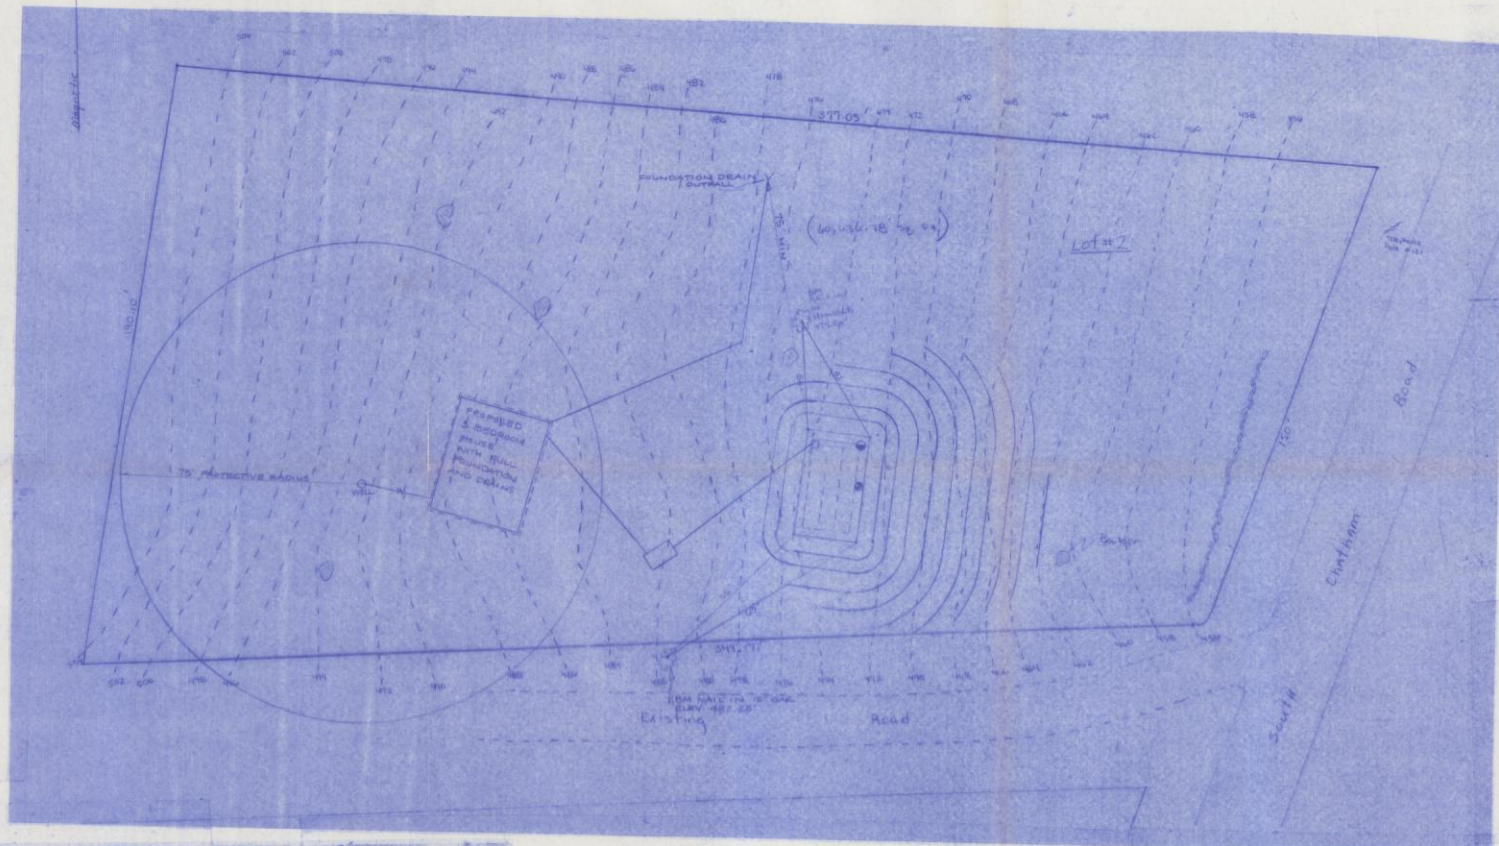

SEPTIC SYSTEM SPECIFICATIONS

SEPTIC TANK TO BE 1,000 GALLONS, AS MANUFACTURED BY SUPERIOR, OR APPROVED EQUAL.

DISTRIBUTION BOX TO HAVE 4 OUTLETS, AS MANUFACTURED BY SUPERIOR, OR APPROVED EQUAL.

LEACH FIELD DIMENSIONS: LENGTH 20' WIDTH 15' AREA 300 sq ft

NUMBER OF LEACH LINES 4

DRAIN PIPE TO BE 4" PVC WITH SEALED JOINTS

DRAIN TILE TO BE 4" PVC WITH COLLAR JOINTS OR APPROVED EQUAL.

THE BOTTOM OF LEACH AREA SHALL BE 2-3" BELOW ORIGINAL GRADE ON UPHILL SIDE.

LEACH LINES SHALL BE SEALED INTO BOX & SEPTIC TANK WITH HYDRAULIC CEMENT.

THERE IS NO SURFACE WATER, OR NEIGHBORING WELLS, WITHIN 75 FEET OF PROPOSED SYSTEM.

REPLACEMENT AREA: AS SHOWN

LEACH BED TO BE DUG UP AND REPLACED IN SAME LOCATION IN THE EVENT OF FAILURE.

SOIL TEST DATA

TEST PIT LOG



- 0'-10" Dark/Black Topsoil 1/5 YR 2/0
- 10'-16" Dark/Brown Fine Sandy loam - friable, moist 10/4r 3/4
- 16'-30" Coarse loamy sand heavily mottled from gravel with fine sandy layers 2 S YR 5/4
- 30'-36" Compact Aviation Till Grey, Many Angular fragments 2H Water observed 8" from top No ledge

PERC RATE 4 min/inch

DEPTH OF PERC 14"

DATE OF TESTS 3/10/90

SOIL TYPES BtlC

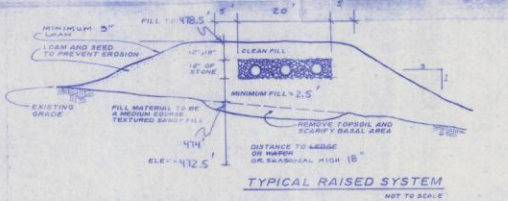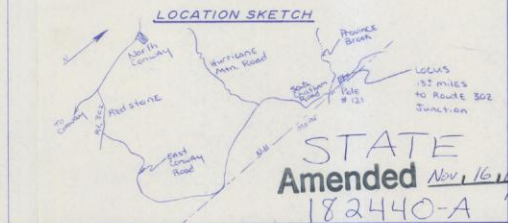

notes: 1. A 3 bedroom house creates 450 GPD which at a 6 min perc rate requires 675 sq ft leaching area.


ORIGINAL GRADE 477.4

EXISTING 478.5

BED BOTTOM 476.5

FINISH GRADE 478.5

LEACH NONE

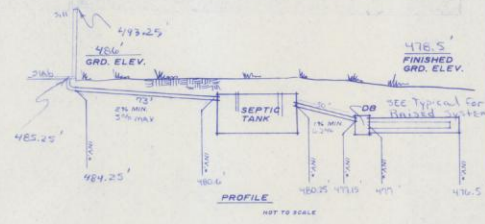

LOT OWNER: NAME Scott Wadleigh

ADDRESS PO Box 3178 North Conway, NH 03860

SUBDIVISION NAME Jeff Patch, Pinnacle Falls Chatham, NH

SUBDIVISION APPROVAL NUMBER 235443 LOT NUMBER 2

STREET South Chatham Road

CITY or TOWN Chatham

SURVEYED G.H. & M.G. 1150 DRAFTED TDA 5/10/90

REVISIONS ASBUILT 11/14/00

SCALE AS NOTED

THADDEUS THORNE-SURVEYS, INC. CENTER CONWAY, NEW HAMPSHIRE 03813