



WELL CERTIFICATE OF COMPLETION

Owner	Pacheco-Valencia, Everardo	WEL	120624-1	SEP	EX
Location	608 Fox Hollow Circle, Otto, NC, 28763	PID	6581336266	ACREAGE	0.84
Directions	608 Fox Hollow Circle, Otto, NC, 28763				
Design	Single-Family Well	GW-1 A	On File	GPS	35.08012° N, 83.40116° W
Well Driller	Rick Crane	Cert #	3073-A		

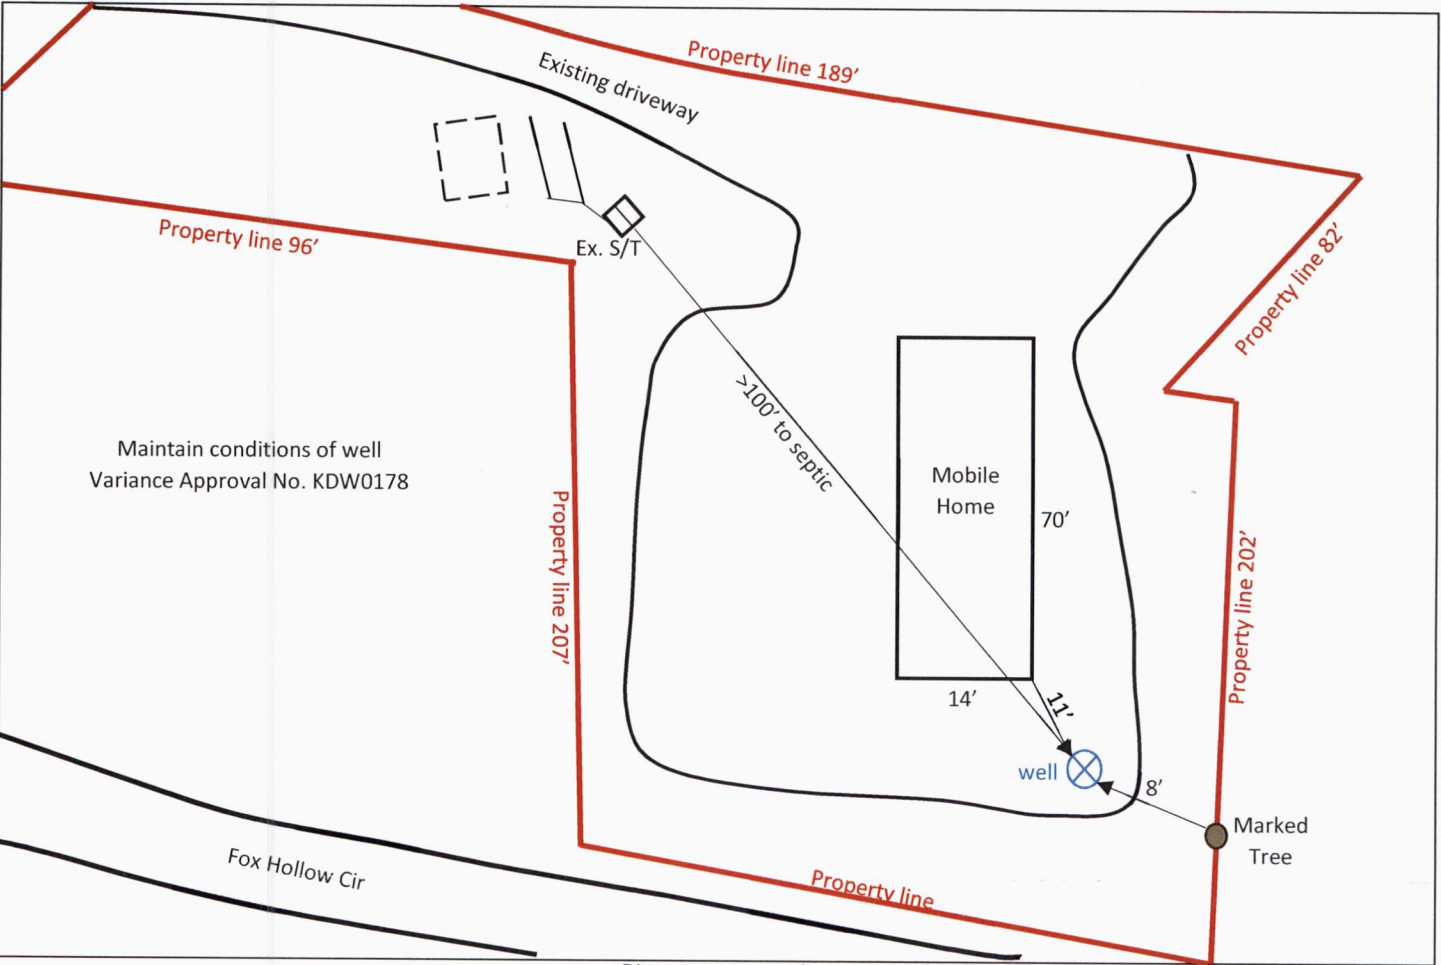


Diagram not to scale

GROUT	Bentonite Slurry	Depth: 20 ft	Method: Pump	Cap: Bent. Chips 0-3 ft	By: Trevor Justice REHS 3294, Brayden West, and Sarah Slack	Date: 2/10/2025
CASING	SDR21 PVC with Coupling	Depth: 90 ft	Diameter: 6.25 inches			
WELL HEAD	Height: 17 inches	Vent: ☒ Yes ☐ No	Threadless Sample Tap: ☒ Yes ☐ No	Seal: ☒ Yes ☐ No	Hose Bib: Not Installed	
WELL PLATE	☒ .0107 J (2)	Date: 2/17/2025	Depth: 955 ft	Yield: 3 gpm	Static H ₂ O: ft	Permit #: ☐ Yes ☐ No
PUMP PLATE	☒ .0107 J (3)	Date: 3/13/2025	Depth: 500 ft	HP: 1½	Installer: Rick Crane	Cert #: 3073-A

The issuance of this document by MCPH in no way guarantees the issuance of other permits. The property owner is responsible for checking with appropriate governing bodies in meeting their requirements, and in maintaining safe separation distances between this well and potential groundwater contaminants. All rules in 15A NCAC 02C Well Construction Standards are incorporated by reference into this document, including any subsequent amendments to those rules, and shall be adhered to.

October 28, 2025
Issue Date

Trevor Justice REHS 3294