


10/7/16 E-M.

Macon County
Public Health
**OPERATIONS PERMIT
ON-SITE WASTEWATER SYSTEM TYPES II-V**

Applicant/Owner	Gregg Hutton	Log #	010116-S	PDWW#	N/A
Address	Lot 123 Diamond Falls Estates, off Diamond Falls Blvd.	PID #	6552290004	ACREAGE	2.13
Directions	64W to L on West Old Murphy Rd., R on West Dills Creek, R on Anderson Creek Rd., into Diamond Falls, then right to lot 123.				
Design	360 Gallons Per Day	Facility	Three Bedroom Residence	Install Type	New Construction
Foundation	Basement with plumbing	Water Source	Existing Shared Well / Off Site		

The following items are on file and part of this permit: GPS/GIS Application IP/CA Soil Sheet Map Plat Map Engineer's Drawing
Comments:

As-Built Diagram (Not to Scale)

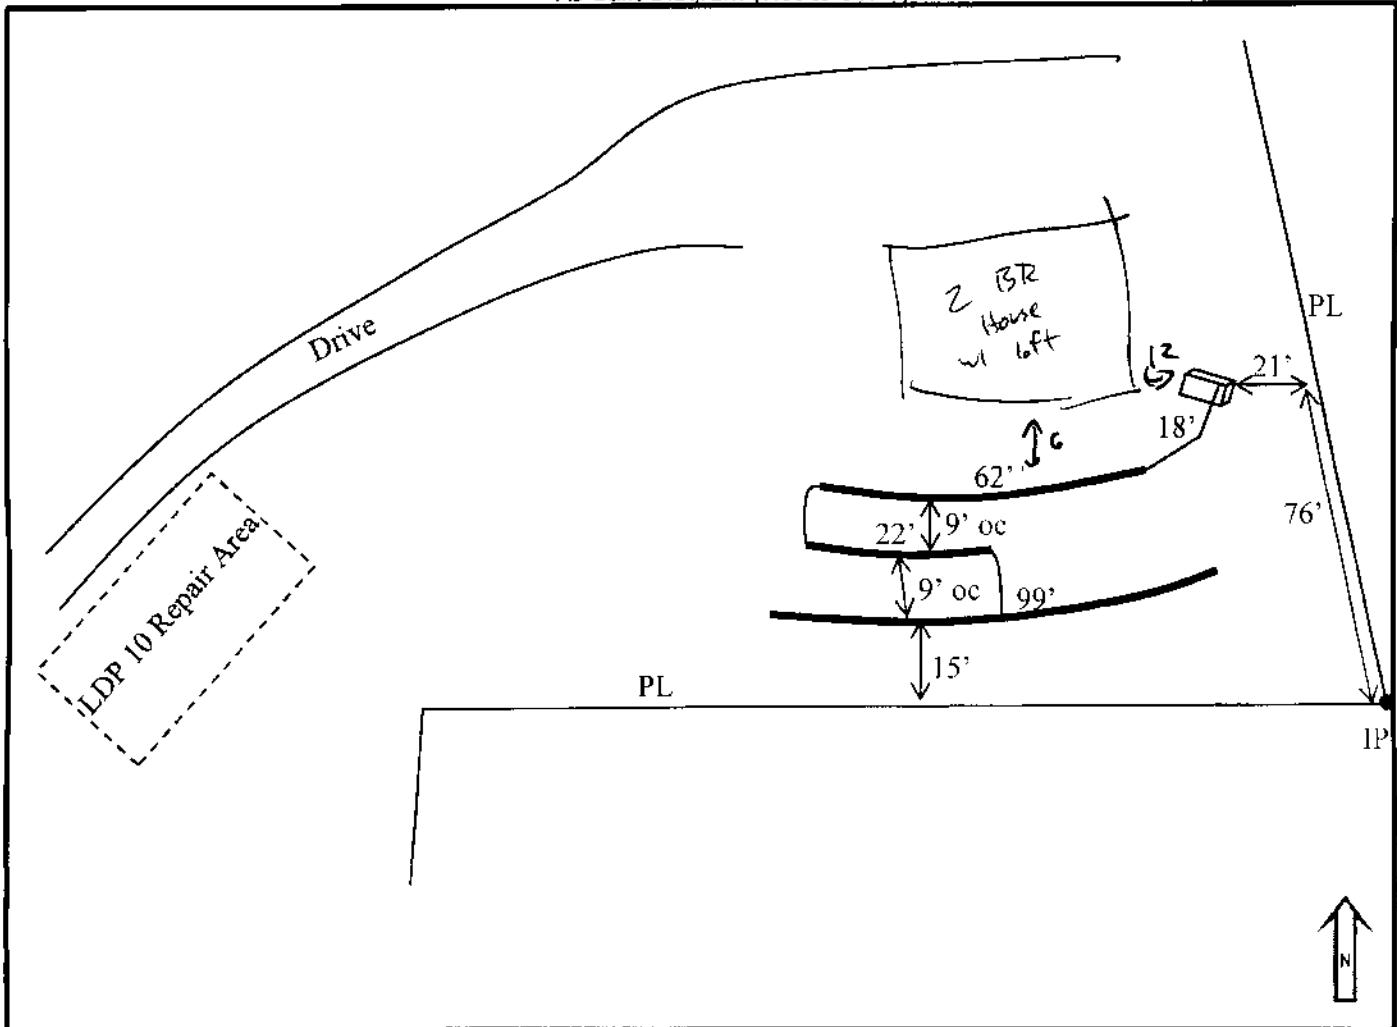

INSTALLED	Infiltrator Quick 4 Plus (IQ4PS) - Gravity;			REPAIR	10" Large Diameter Pipe - Gravity;		
Type IIa	Average Trench Depth: 18"	LTAR: 0.5	Saprolite: Yes	Type IIIf	Area: 720ft ²	LTAR: 0.5	Saprolite: No
S. TANK	1000 gallons	ID: Inf - STB - ID# - 1000 gallons	Date:		Effluent Filter: Polylok		
P. TANK	Not Required	ID: MFG - PT - ID# - gallons	Date:		Dosing Detail:		
TRENCH	Length: 183ft	# of Lines: 3	DISTRIBUTION	Serial	WELL SETBACK	100 ft Minimum	
INSTALLER	Stephen Wood	Cert. # 2348	MONITORING	M C P H :	Mgt. Entity:	Reporting Freq.:	

This system has been installed in compliance with applicable NC General Statutes, Rules for Sewage Treatment and Disposal, and all conditions of the IP and AC System shall perform in accordance with Rule 1961. Ground absorption sewage treatment and disposal systems shall be checked, and the contents of the septic tank removed, periodically from all compartments, to ensure proper operation of the system. The contents shall be pumped whenever the solids level is found to be more than 1/3 of the liquid depth in any compartment. **QUESTIONS? (828)349-2490**

Inspection Date: 1/5/2016

Charles Womack, REHS #1300

Charles Womack, Authorized State Agent

Final Inspection/ Issue Date: 10-6-16

Select an Agent...

Authorized State Agent