

MACON COUNTY PUBLIC HEALTH CENTER


Franklin, North Carolina 28734

SUBSURFACE SEWAGE SYSTEM OPERATIONS PERMIT - TYPES II-IV

☒ New Installation ☐ Addition to Existing System ☐ Partial Repair ☐ 100% Repair
☒ Single family dwelling(s) 1 # ☐ Multi-family dwelling ☐ Commercial (type) _____
 Total # bedrooms 2 Daily Flow: (Gallons per day): 240
 Property Owner: C.D. Buchenan, Jr.
 Property Description: Doe Falls Rd.
 Township Highlands Parcel ID Number 04-00919 Map Number 7522.00-46-5900
 Type of System 10" ID Large Diameter Pipe System Classification III
 Septic Tank Size 1000 Pump Tank Size _____ Trench Bottom Depth 18" LS LTAR .6
 Drinking Water Source: ☐ Individual Well/Spring ☒ Shared Well/Spring ☐ City ☐ Community
 Future Repair Area Required ☒ Yes ☐ No Type of System for Future Repair _____
 Date Improvements Permit/Authorization to construct issued 11-14-98 Permit No. _____
 Installer Jerry Anderson & D.W. Henry Design Engineer _____ Project Number _____
 Inspection Frequency: Health Dept. _____ Mgt. Entity _____ Mgt. Entity Reporting Frequency _____
 Cautions or Comments: _____

The following checked items are on file and are part of this Operations Permit:

- ☒ Application ☒ Improvement Permit ☐ Survey/Plat Map ☐ Engineer's Drawing
☐ Soil Data Sheet ☒ Authorization To Construct ☒ Map (Other) ☐ Zoning Permit
☒ Other COC for another system approval on same property

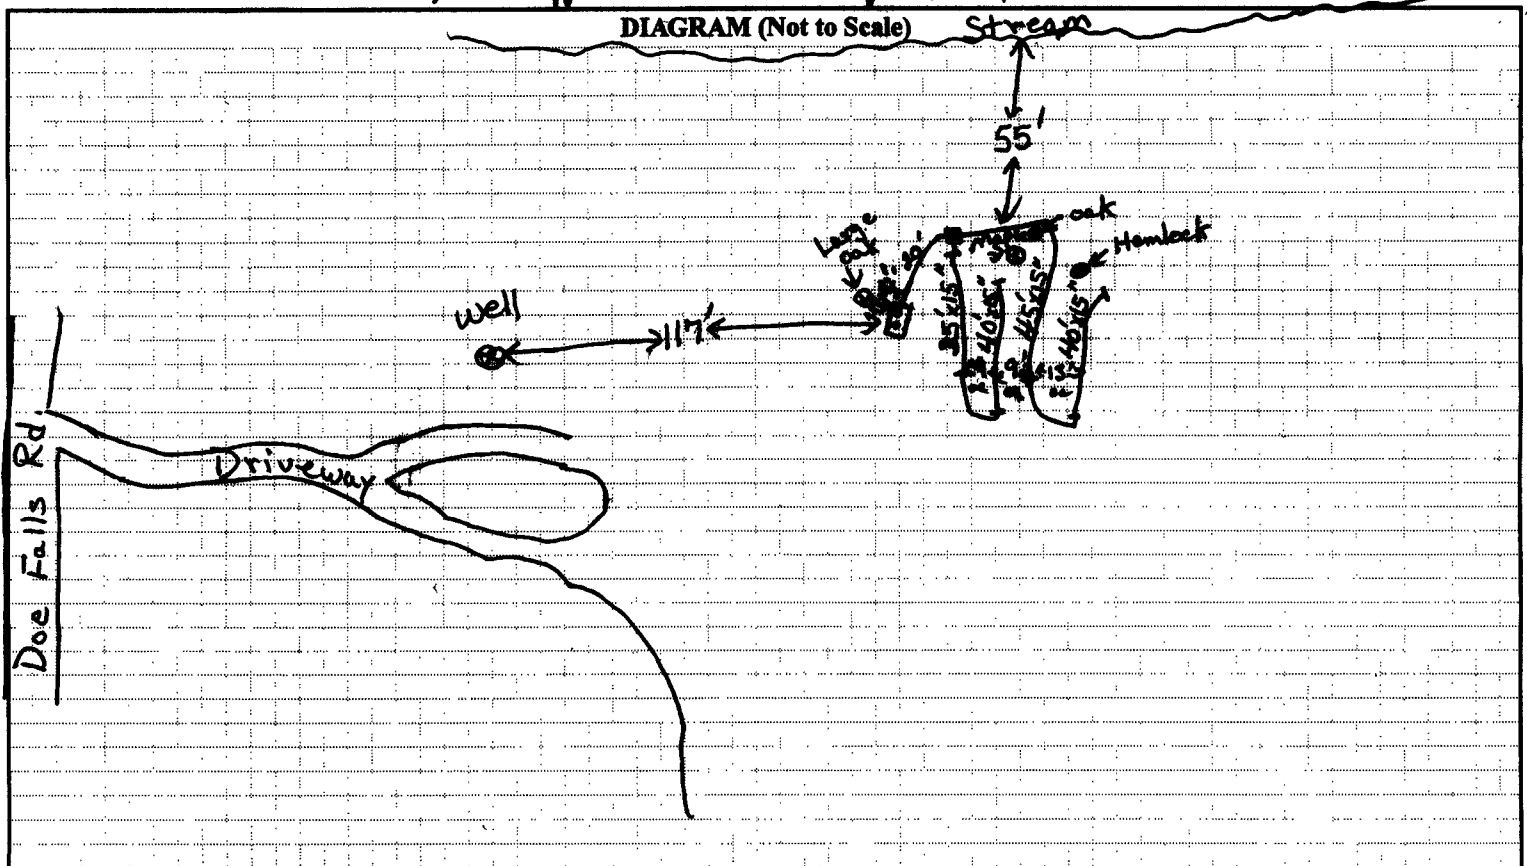

A representative of the Macon County Public Health Center has inspected this sewage disposal system and finds that it conforms to state guidelines. This permit is issued subject to all the provisions of the North Carolina Laws and Rules for Sewage Treatment and Disposal. **No person is permitted to make alterations to this system without the approval of an authorized Environmental Health Specialist.** This approval indicates that this system has been installed in compliance with the standards as set forth in the above regulations, but shall in no way be taken as a guarantee that the system will function satisfactorily for any given period of time. **The area designated as "repair area" is required for future use and must remain undisturbed.**

8-26-98 D-box & lines

3-17-99 Tank

Charles Womack R.R.

Environmental Health Specialist

White-Owners's Copy

Yellow-Health Dept. Copy

Pink-Building Inspection Dept. Copy

Buckhannon, C. MACON COUNTY PUBLIC HEALTH CENTER

Franklin, North Carolina 28734

Number _____


- ☒ **IMPROVEMENT PERMIT:** This Improvement Permit is valid for 5 years (Expiration Date 7-14-2003) and is subject to revocation if the site plans or the intended use changes.
- ☒ **AUTHORIZATION FOR WASTEWATER SYSTEM CONSTRUCTION:** This Authorization is valid for 5 years (Expiration Date 7-14-2003) and is subject to revocation if the site plans or the intended use changes.
- ☐ **REPAIR AUTHORIZATION FOR WASTEWATER SYSTEM CONSTRUCTION:** ☐ Partial Repair ☐ 100% Repair
- This Authorization is for the repair of an existing wastewater system and is valid for _____ days after the date of issue.

NOTE: Both an Improvement Permit and an Authorization for Wastewater System Construction are required prior to obtaining a building permit or other construction permits.

Applicant or Owner C.D. Buckhannon, Jr.
 Township Sugarfork Parcel ID# 04-00919 Map # 7522.00-46-5900 Acreage 4.5
 Property Description Off Buck Falls and Doe Falls Rd.
☒ Residential # Bedrooms 2 () Commercial # Employees _____ Proposed Drinking Water Source Existing Spring
 Suitable Soil Depth 18-24" Suitable Saprolite Depth 60" Slope 55-60% Daily Flow 240 GPD LTR 0.6
 Type of System Hand dug 10" ID Large Diameter Pipe System Classification III
 Total Nitrification Line Length 160' Trench Bottom Depth 18" on low side Stone Under Line _____
 Total Nitrification Line Width 15" Precast Tank Size 1000 gal. Stone Over Line _____

very steep slope **DIAGRAM (NOT TO SCALE)**

Notes:

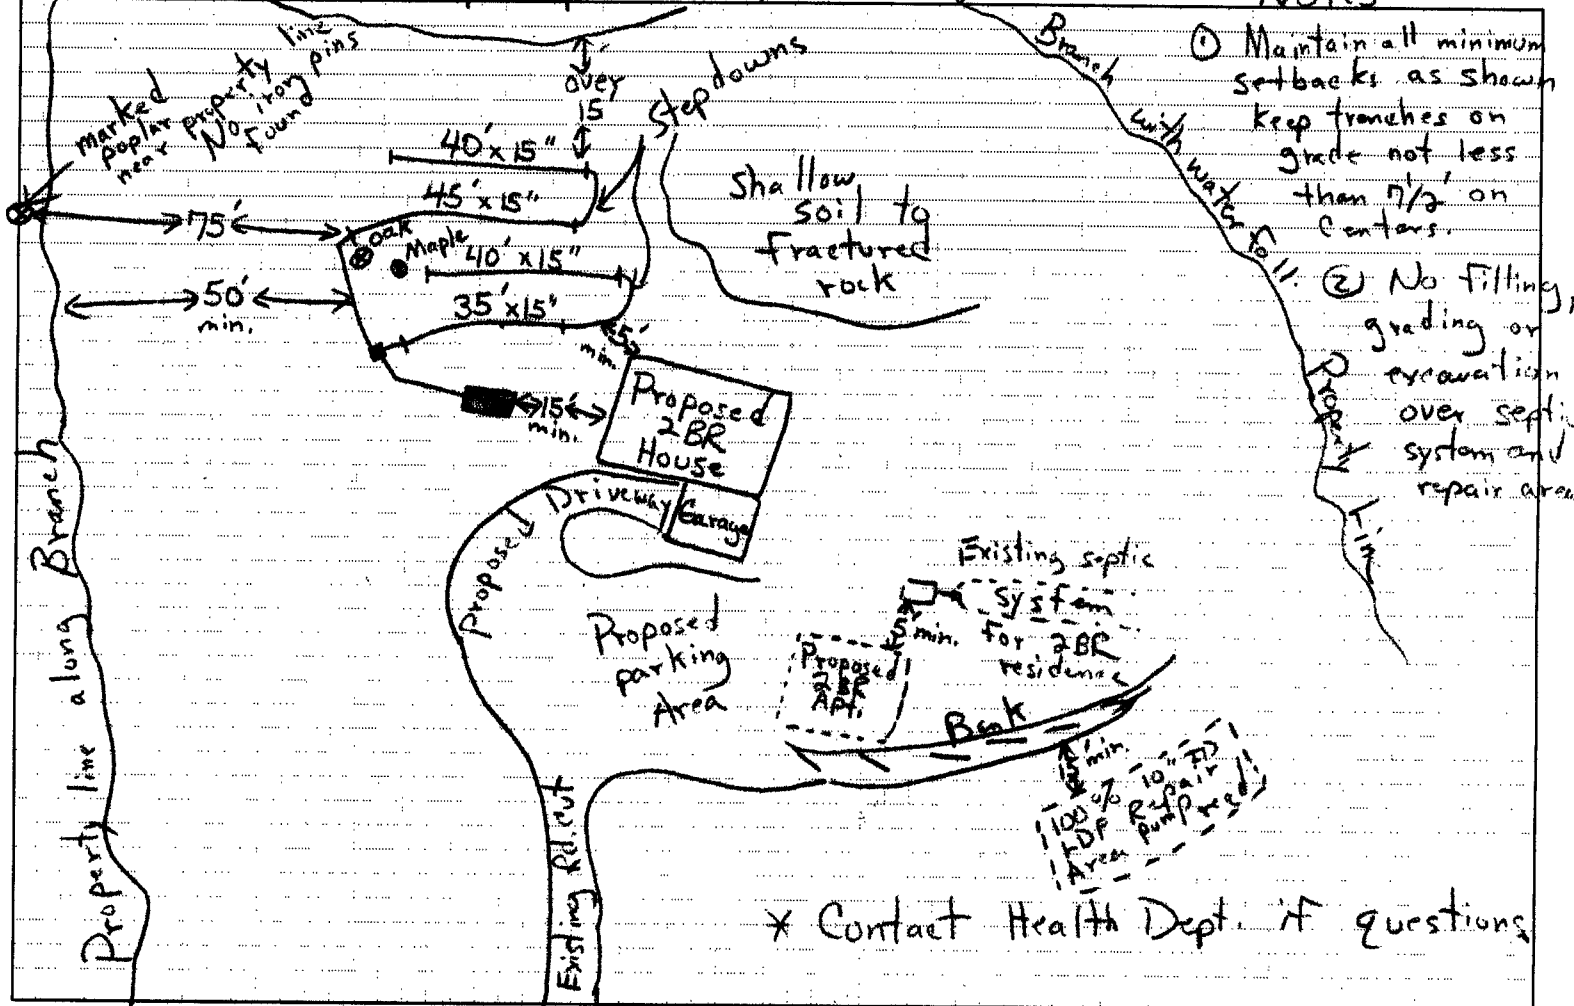

A representative of the Macon County Public Health Center has made a site evaluation of this property and finds it () suitable ☒ provisionally suitable for the proposed facility. This conforms to state guidelines and is not a guarantee.

Date 7-14-98 Charles Womack RS

I have read and understand the requirements of this permit/authorization:

Environmental Health Specialist

(Signature) _____ Applicant ☒ Agent _____

White - Owner's Copy

Yellow - Building Inspections Dept. Copy

Pink - Health Dept. Copy