

Certificate of Completion

Macon County Health Department

Date 1-24-89

Time Called 1:35


NAME OF OWNER E.H. O'Neal & ~~M.O. Brush~~ Ellis H. ONEAL Lot 28 PIN 0702564

ADDRESS Mulberry Road- LOT 27 & 28 834 Summit Rd ROAD

NAME OF INSTALLER FB Vinson

PERMIT NUMBER

1. Site Permit Issued ☒
2. Septic Tank Properly Located ☒
3. Septic Tank Adequate Size ☒
4. Tank Meets Structural Requirements ☒
5. Tank Level ☒
6. Effluent Lower Than Influent ☒
7. Tank Has 9" Free Board ☒
8. Tank at Proper Depth ☒
9. All Ells 45 deg. or more with Cleanouts ☒
10. Dist. Box properly located and level ☒
11. All Solid Pipe of Approved Material ☒ 10" LDP
12. Nitrification Line of Approved Material ☒
13. Lines of Sufficient Length and Width ☒
14. Lines have Approved Grade $\frac{1}{4}"$ in 10' ☒
15. Minimum of 8" gravel under and 2" over line NA
16. Lines adequate distance apart ☒

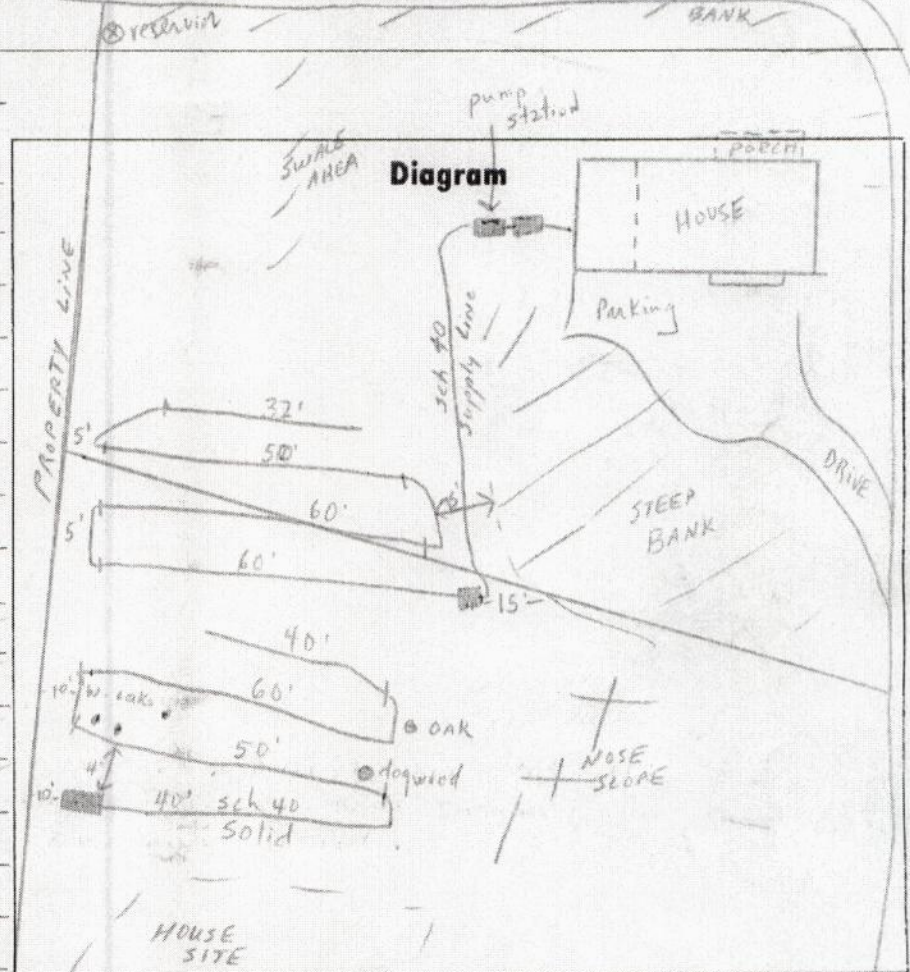

A Representative of the Macon County Health Dept. has inspected this Sewage System and finds it
(☒) suitable () unsuitable.

Date inspected 1-24-89 1-25-89 1-26-89

Time inspected 4:45 9:00 11:30
4:00

This conforms the State Guidelines and is not a Guarantee.

Sanitarian(s) 1) Jane Morgan RS
2) Dennis Spaul RS
3) Paul H. Jordan

Spuck line with transit. Start at bottom and work up to top of hill. Line must be on grade.


ump spec and alarm with meet spec. on attached sheet from MCHD.

MACON COUNTY HEALTH DEPARTMENT
FRANKLIN, N.C. 28734
Phone 369-9526

(207 28) *Operations*
IMPROVEMENTS PERMIT
Owner E.H. O'Neal & M.C. Brush
Location Mulberry Rd- The Summit
Area of Lot LOT 28 / LOT 27
Residential ☒ 2 HOUSES
Commercial ☐
Mobile Home ☐ Size _____
Suitable Soil Depth _____
Sub MCHD pg. 21 Single Residential 3.1 Spec.

Number of Bedrooms 3 2
Precast Tank Size 1000 1000
Trench Bottom Depth 20" See Note
Total Drain Line Length 200' / 150' = TOTAL 350'
Drain Line Width 14-15 inches
Stone Under Line NA } SB2
Stone Over Line NA } Gravel back

- NOTE: 1) COMMUNITY WATER - WATER Line Access from drives.
2) SB2 - large diameter pipe to be installed. System must be hand dug.
3) Trench depth must not exceed 20 inches.
4) Trench width 14-15 inches.
5) This permit is for (2) systems. Easement for pump system must be recorded with deed prior to issuance of permanent power to dwelling.

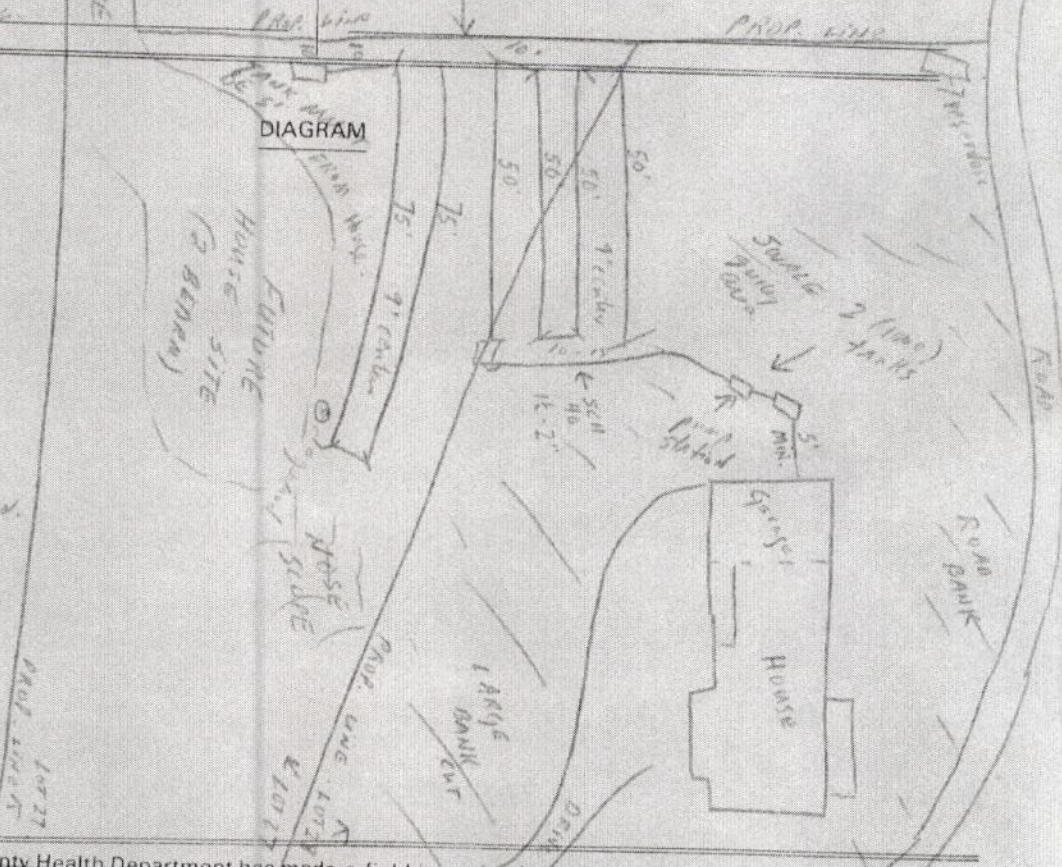

A representative of the Macon County Health Department has made a field investigation of this property and finds it () suitable () marginally suitable () unsuitable for proposed installation. This permit is valid for 3 years after date of issue. Any alterations of this proposed installation or site as shown by this permit renders it invalid. If any soil restrictions are encountered during installation, contractor shall contact M.C.H.D.
This conforms to State Guidelines and is not a GUARANTEE.

DATE 7-7-88
I, E.H. O'Neal
knowledge
state that the above information is correct to the best of my

TEMPORARY SPOUSE
W. Dark Simpson

The issuance of this permit renders previous permit dated 4-29-85 (MCHD No. 10020) null and void.