

MACON COUNTY PUBLIC HEALTH CENTER

Franklin, North Carolina 28734


SUBSURFACE SEWAGE SYSTEM OPERATIONS PERMIT - TYPES II-IV

☒ New Installation ☐ Addition to Existing System ☐ Partial Repair ☐ 100% Repair
☒ Single family dwelling(s) 1 # ☐ Multi-family dwelling ☐ Commercial (type) _____
Total # bedrooms 3 Daily Flow: (Gallons per day): 360
Property Owner: ROBERT & PATRICIA KACN
Property Description: REF BATTLE BRANCH RD
Township ELLITAM Parcel ID Number 03-32883 Map Number 7515.00-51-4674
Type of System QUICK 4 System Classification III
Septic Tank Size 1000 Pump Tank Size 83-32500 Trench Bottom Depth 18" LTAR 5
Drinking Water Source: ☐ Individual Well/Spring ☒ Shared Well/Spring ☐ City ☐ Community
Future Repair Area Required ☒ Yes ☐ No Type of System for Future Repair 25% REDUCTION
Date Improvements Permit/Authorization to construct issued 6-7-06 Permit No. _____
Installer MARY TAYLOR Design Engineer _____ Project Number _____
Inspection Frequency: Health Dept. _____ Mgt. Entity _____ Mgt. Entity Reporting Frequency _____
Cautions or Comments: clean filter & pump tank as needed

The following checked items are on file and are part of this Operations Permit:

- | | | | |
|--|---|--|---|
| ☐ Application | ☐ Improvement Permit | ☐ Survey/Plat Map | ☐ Engineer's Drawing |
| ☐ Soil Data Sheet | ☐ Authorization To Construct | ☐ Map (Other) | ☐ Zoning Permit |
| ☐ Other _____ | | | |

DIAGRAM (Not to Scale)

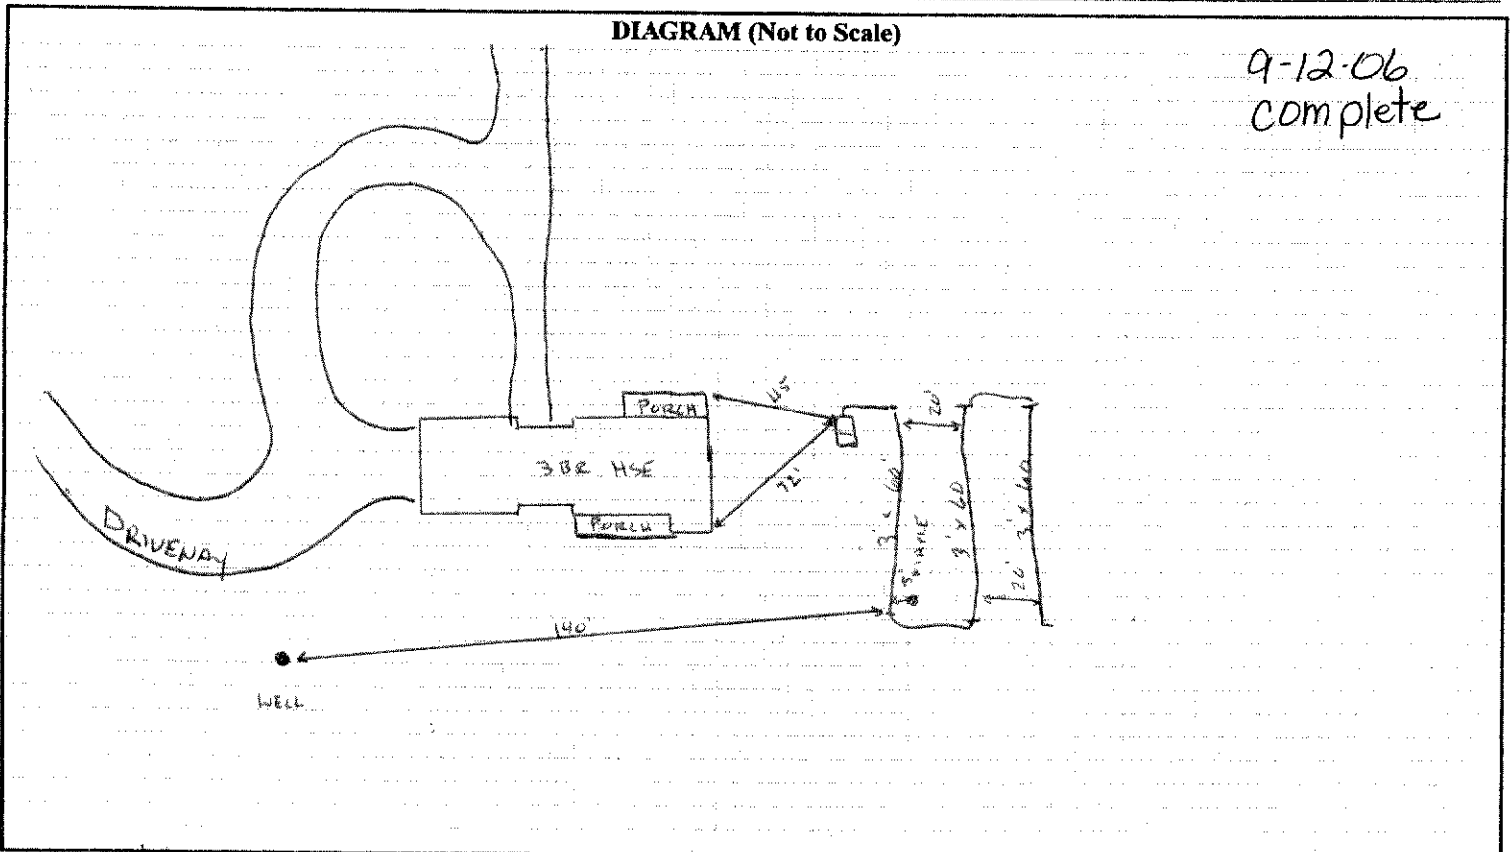

A representative of the Macon County Public Health Center has inspected this sewage disposal system and finds that it conforms to state guidelines. This permit is issued subject to all the provisions of the North Carolina Laws and Rules for Sewage Treatment and Disposal. **No person is permitted to make alterations to this system without the approval of an authorized Environmental Health Specialist.** This approval indicates that this system has been installed in compliance with the standards as set forth in the above regulations, but shall in no way be taken as a guarantee that the system will function satisfactorily for any given period of time. **The area designated as "repair area" is required for future use and must remain undisturbed.**

9-17-06

Date Inspected

White-Owners's Copy

Yellow-Health Dept. Copy

Environmental Health Specialist

Karn, R.
MACON COUNTY PUBLIC HEALTH CENTER

1830 Lakeside Drive • Franklin, North Carolina 28734

☒ **IMPROVEMENT PERMIT:** This Improvement Permit is valid for 5 years (Expiration Date 6-7-11)

☒ **AUTHORIZATION FOR WASTEWATER SYSTEM CONSTRUCTION:** This Authorization is valid for 5 years
(Expiration Date 6-7-11)

☐ This authorization is for an addition to an existing wastewater system.

☒ **REPAIR AUTHORIZATION FOR WASTEWATER SYSTEM CONSTRUCTION:** ☐ Partial Repair ☐ 100% Repair
This Authorization is for the repair of an existing wastewater system and is valid for _____ days after the date of issue.

NOTE: Both an Improvement Permit and an Authorization for Wastewater System Construction
are required prior to obtaining a building permit or other construction permits.

Applicant or Owner Robert + Patricia Karn
Township Ellijay Parcel ID# 0319926 Map # 03-32883/7515.00-51-4076 Acreage 3.06
Property Description Off Battle Branch Rd.


(X) Residential # Bedrooms 3 () Commercial (type) _____ # Employees _____
Suitable Soil Depth 48" Suitable Saprolite Depth _____ Slope 15-23% Daily Flow 360 GPD LTAR 5
Type of System 25% Reduction System Classification III

The Type of System Permitted ☐ Does ☐ Does Not Differ from the Type Specified on the Application

Total Nitrification Line Length 180' Trench Bottom Depth 18-20" Stone Under Line _____ Stone Over Line _____

Total Nitrification Line Width 3' Septic Tank Size 1000 gal. Pump Tank Size _____

Minimum horizontal distance between drinking water source and wastewater system 100' min.

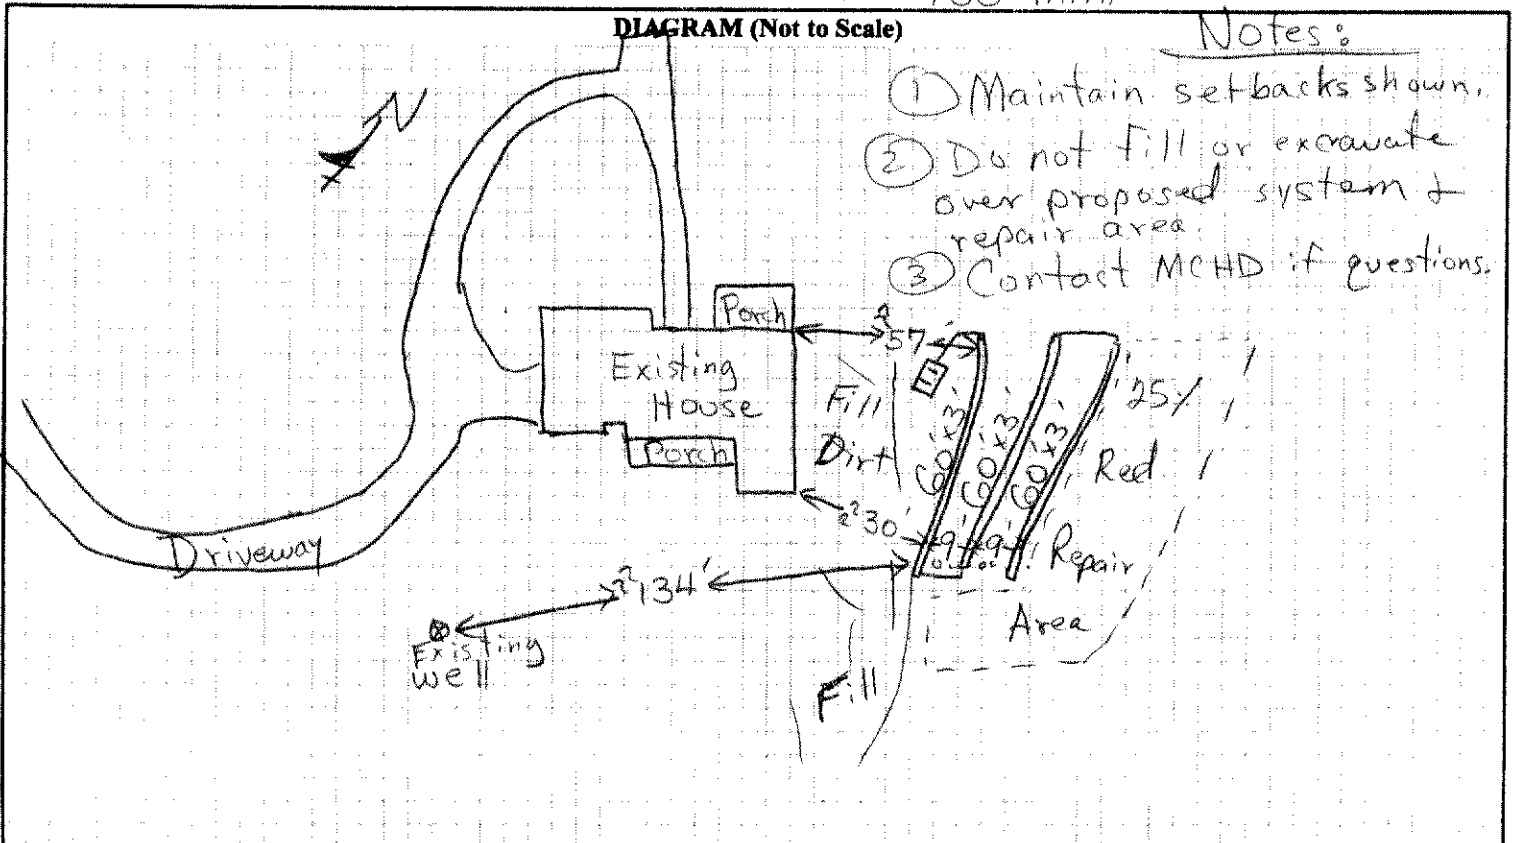

This permit/authorization is subject to revocation if the site plan, plat, or intended use changes, is transferrable, and is subject to the provisions of the Laws and Rules for Sewage System Collection, Treatment, and Disposal of the North Carolina Administrative Code.

Date 6-7-06 Charles Womack R.S. Authorized State Agent

I have read, understand the requirements, and accept the specifications of this permit/authorization:

(Signature) X R Karn ☒ Owner ☐ Legal Representative Date 6/13/06

White-Owners's Copy

Pink-Health Dept. Copy