

MACON COUNTY PUBLIC HEALTH CENTER

1830 Lakeside Drive · Franklin, North Carolina 28734

SUBSURFACE SEWAGE SYSTEM OPERATIONS PERMIT – TYPES II-IV

☒ New Installation ☐ Addition to Existing System ☐ Partial Repair ☐ 100% Repair

☒ Single family dwelling(s): 1# ☐ Multi-family dwelling ☐ Commercial (type): _____

Total # Bedrooms: 3 Daily Flow: 360 gpd Township: Cartoogechaye Parcel ID#: 0836315 Map #: 6521.00-96 8892

Property Owner: Daniel Rohloff

Property Description: Rainbow Falls s/d, Lot #29

Type of System: LDP-10 (Gravity) System Class: III f

Septic Tank Size: 1000 gal Pump Tank Size: NA Trench Bottom Depth: 18" (Low Side) LTAR: 0.5

Drinking Water Source: ☒ Individual Well/ Spring ☐ Shared Well/ Spring ☐ City ☐ Community

Future Repair Area: Required Type of Repair: LDP-10 (Gravity)

Date IP/AC issued: 10/22/2008 Installer: Jimmy Nelson Cert. #: 1398 Log Number: 084508

Inspection Frequency: Health Dept.: NA Mgt. Entity: NA Reporting Frequency: NA


Cautions or Comments: CST-1000 STB-232 9/26/08

The following checked items are on file and are part of this Operations Permit.

☒ Application ☒ Improvement Permit ☒ Authorization to Construct ☐ Survey/ Plat Map ☒ Soil Data Sheet ☐ Map (Other) ☐ Engineer's Drawing

As-Built Diagram (Not to Scale)

27/09 OSWW ok
feet from house to tank

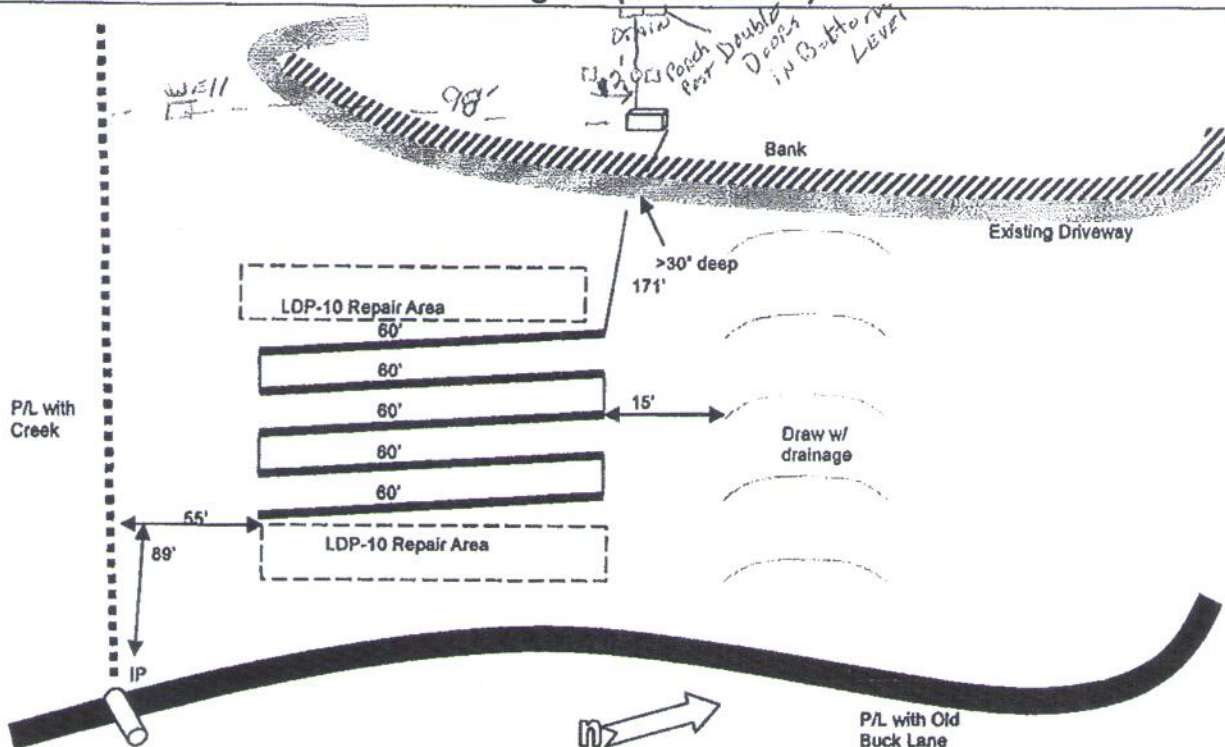

A representative of the Macon County Public Health Center has inspected this sewage disposal system and finds that it conforms to state guidelines. This permit is issued subject to all the provisions of the North Carolina Laws and Rules for Sewage Treatment and Disposal. No person is permitted to make alterations to this system without the approval of an authorized Environmental Health Specialist. This approval indicates that this system has been installed in compliance with the standards as set forth in the above regulations, but shall in no way be taken as a guarantee that the system will function satisfactorily for any given period of time.

The area designated as "repair area" is required for future use and must remain undisturbed.

Date Inspected: 10/21/08

Wesley Bintz, RSI

Authorized State Agent