

MACON COUNTY PUBLIC HEALTH CENTER


Franklin, North Carolina 28734

SUBSURFACE SEWAGE SYSTEM OPERATIONS PERMIT - TYPES II-IV

☒ New Installation ☐ Addition to Existing System ☐ Partial Repair ☐ 100% Repair
☒ Single family dwelling(s) 1 # ☐ Multi-family dwelling ☐ Commercial (type) _____
 Total # bedrooms 2 Daily Flow: (Gallons per day): 240
 Property Owner: C.D. Buchenan, Jr.
 Property Description: Doe Falls Rd.
 Township Highlands Parcel ID Number 04-00919 Map Number 7522.00-46-5900
 Type of System 10" ID Large Diameter Pipe System Classification III
 Septic Tank Size 1000 Pump Tank Size _____ Trench Bottom Depth 18" LS LTAR .6
 Drinking Water Source: ☐ Individual Well/Spring ☒ Shared Well/Spring ☐ City ☐ Community
 Future Repair Area Required ☒ Yes ☐ No Type of System for Future Repair _____
 Date Improvements Permit/Authorization to construct issued 11-14-98 Permit No. _____
 Installer Jerry Anderson & D.W. Henry Design Engineer _____ Project Number _____
 Inspection Frequency: Health Dept. _____ Mgt. Entity _____ Mgt. Entity Reporting Frequency _____
 Cautions or Comments: _____

The following checked items are on file and are part of this Operations Permit:

- ☒ Application ☒ Improvement Permit ☐ Survey/Plat Map ☐ Engineer's Drawing
☐ Soil Data Sheet ☒ Authorization To Construct ☒ Map (Other) ☐ Zoning Permit
☒ Other COC for another system approval on same property

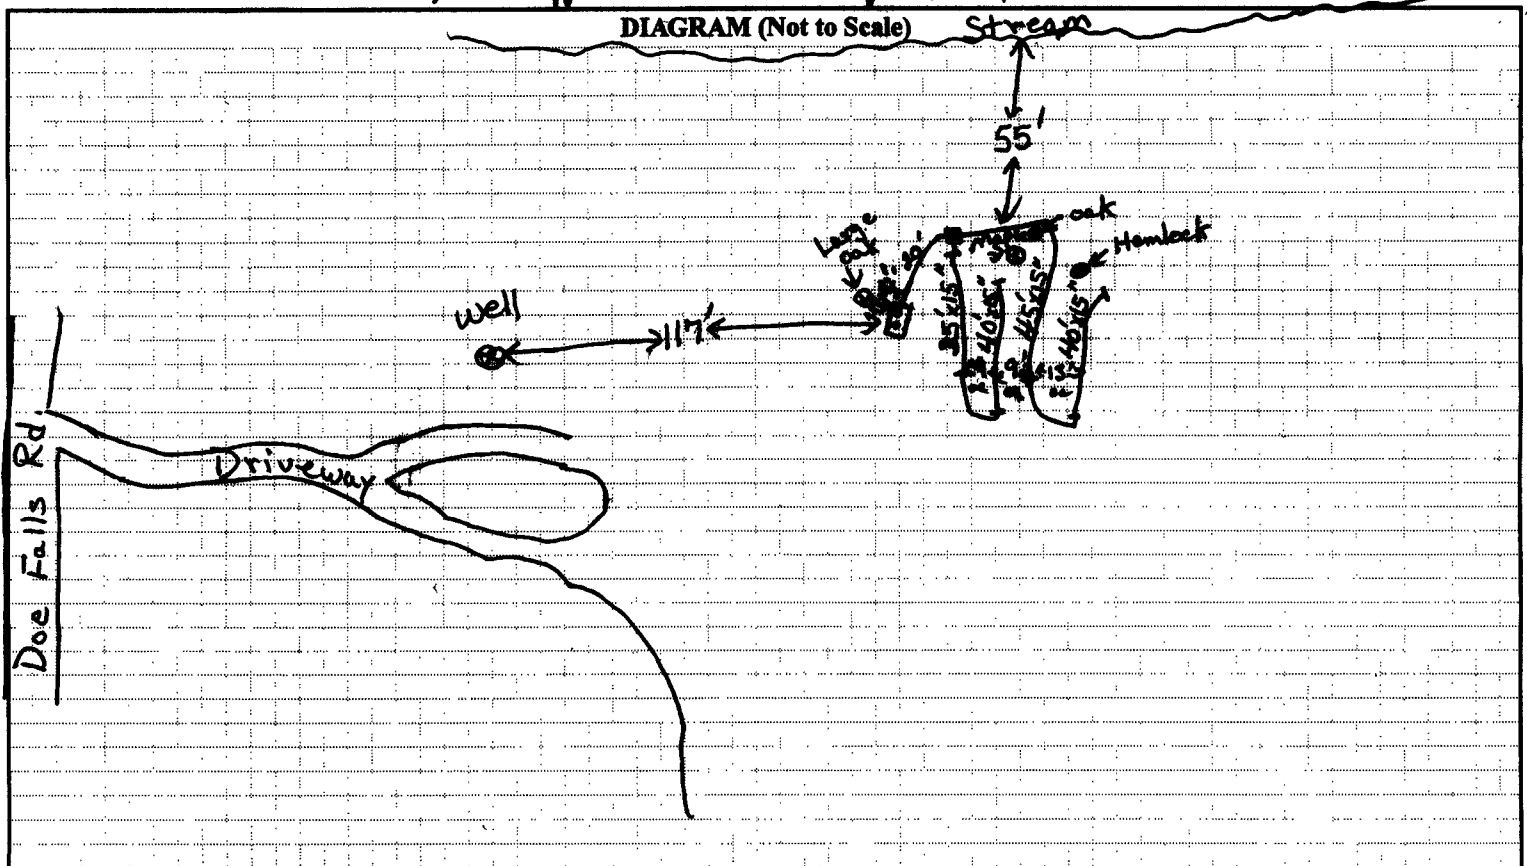

A representative of the Macon County Public Health Center has inspected this sewage disposal system and finds that it conforms to state guidelines. This permit is issued subject to all the provisions of the North Carolina Laws and Rules for Sewage Treatment and Disposal. **No person is permitted to make alterations to this system without the approval of an authorized Environmental Health Specialist.** This approval indicates that this system has been installed in compliance with the standards as set forth in the above regulations, but shall in no way be taken as a guarantee that the system will function satisfactorily for any given period of time. **The area designated as "repair area" is required for future use and must remain undisturbed.**

8-26-98 D-box & lines

Date Inspected

3-17-99 Tank

Charles Womack R.R.

Environmental Health Specialist

White-Owners's Copy

Yellow-Health Dept. Copy

Pink-Building Inspection Dept. Copy

Number

Pink - Health Dept. Copy