


JACKSON COUNTY DEPARTMENT OF PUBLIC HEALTH

REFERENCE NUMBER J549850 OPERATIONS PERMIT	DATE 06.09.05	PIN 8506-80-5984
APPLICANT: MATHIAS DONALD P TRUSTEE 1011 BRIGHTWATERS BLVD NE ST PETERSBURG FL 33704		OWNER: MATHIAS, DONALD P TRUSTEE 1011 BRIGHTWATERS BLVD NE ST PETERSBURG FL 33704
TELEPHONE: 828.399-1511		
SPECIFICATIONS: 2-3		2.84 acres
LOCATION/DIRECTIONS: WOLF LAKE..LOT #7..HWY 281..CROSS DAM..1ST L VES OWEN RD..5 MI..R..		
FEE:	RECEIPT:	SIGNATURE OF OWNER OR AUTHORIZED AGENT:

The above signature indicates that I have read, understood and concur with all provisions and information as outlined on the back.

#BEDRMS 3-360gpd TYPE..SYS III f 10" large diameter pipe
 SZ..TANK 1000g SZ..CHAMB N/A NITRIFI 600ft² OPER..REQ NO

REMARKS: Installed (4) lines at 60' each of 10" large diameter pipe. Step downs were used. (1) 1000g septic tank. Installed by Appalachian Grading & Stone-Dick Phillips.

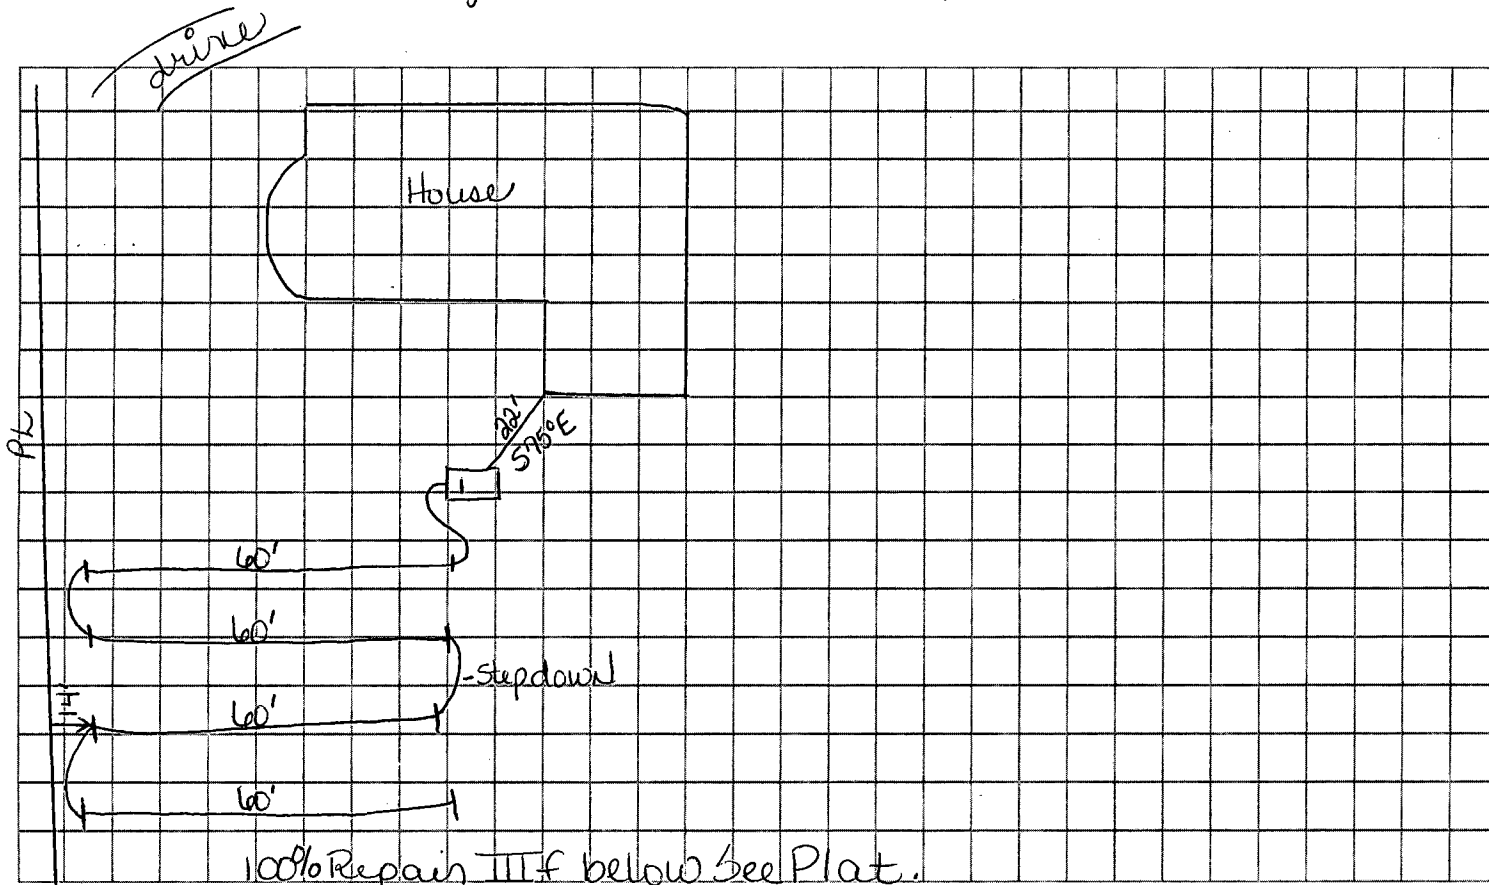

OWNER/INSTALLER RESPONSIBLE FOR COMPLIANCE WITH ALL APPLICABLE STATE RULES

DATE..ISSUED

ENV HEALTH SPEC

DATE..APPROVED 9/14/05

ENV HEALTH SPEC

> JGDPH-2500 (10/01)

Senya M. Howell RS