

DISTRICT HEALTH DEPARTMENT  
Franklin, N.C.

FINAL INSPECTION

House  
B Town

DATE 10-1-74  
Time Called 2:00

NAME OF OWNER Bob Handley  
ADDRESS Rt. # 3, Franklin, N.C. (B Town lakes)  
NAME OF INSTALLER Nat Stenry  
INSTALLER PERMIT NUMBER 21

- 1. Site Permit Issued
- 2. Septic Tank Properly Located
- 3. Septic Tank Adequate Size
- 4. Tank Meets Structural Requirements
- 5. Tank Level
- 6. Effluent Lower Than Influent
- 7. Tank Has 9" Free Board
- 8. Tank at Proper Depth
- 9. All Ells 45 deg. or less with cleanouts
- 10. Distribution Box properly located and level
- 11. All Solid Pipe of Approved Material
- 12. Nitrification Line of Approved Material
- 13. Lines of Sufficient Length and Width
- 14. Lines have Approved Grade 1/4" in 10'
- 15. Minimum of 8" gravel under and 2" over line
- 16. Lines adequate distance apart

A Representative of the Macon County Health Department has inspected this Sewage System and finds it  Suitable ( ) Unsuitable.

Date Inspected 10-1-74

Time Inspected 5:00

Signed [Signature]  
Macon County Health Dept.


REMARKS \_\_\_\_\_  
\_\_\_\_\_  
\_\_\_\_\_

DISTRICT HEALTH DEPARTMENT  
Franklin, N.C.

SITE INSPECTION

NAME OF OWNER Robert D. Sandley  
ADDRESS Rt. 4, Franklin, N.C. Buntingtown Lake Lots 5+6  
Approximate Area of Lot acres + Garbage Disposal Yes  
Number of Bedrooms 2 Number of Baths 3  
Square Footage of House 3600  
Soil Percolation Adequate Yes S.C.S. Soil Test No  
Type Water System Drilled Well  
Size of Septic Tank 1000 Line Length 150 No. of Lines 2

SITE DIAGRAM

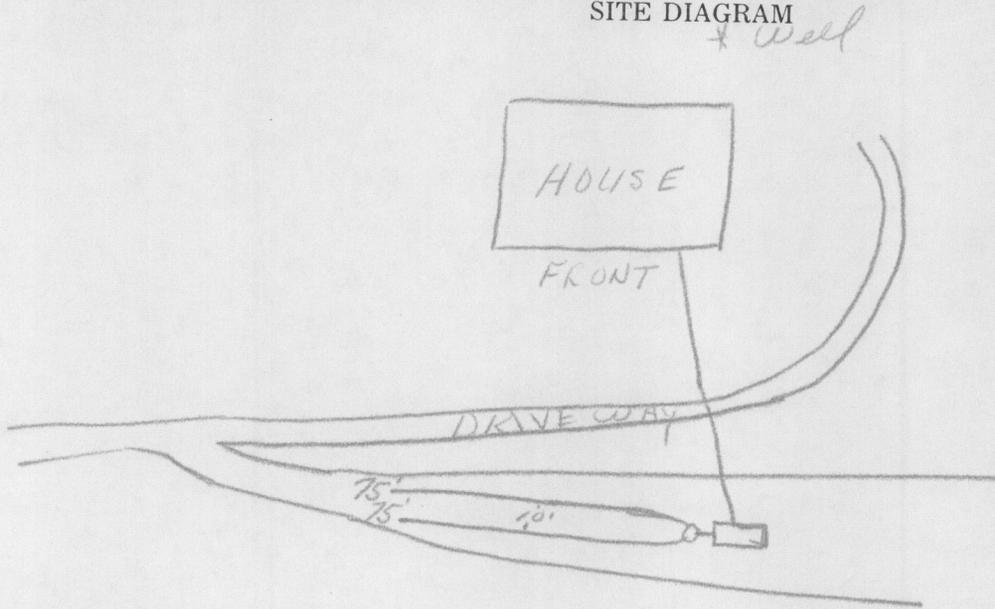

A Representative of the Macon County Health Department has inspected this site and finds it  Suitable  Unsuitable for proposed installation.

DATE June 18, 1974 SIGNED Rick Norton

REMARKS \_\_\_\_\_  
\_\_\_\_\_  
\_\_\_\_\_

