

MACON COUNTY PUBLIC HEALTH CENTER

1830 Lakeside Drive · Franklin, North Carolina 28734

SUBSURFACE SEWAGE SYSTEM OPERATIONS PERMIT – TYPES II-IV

☒ New Installation ☐ Addition to Existing System ☐ Partial Repair ☐ 100% Repair

☒ Single family dwelling(s): 1# ☐ Multi-family dwelling ☐ Commercial (type): _____

Total # Bedrooms: 2 Daily Flow: 360 gpd Township: Ellijay Parcel ID#: 0336465 Map #: _____

Property Owner: Charles Brown

Property Description: Off Perks Rd. Lot #5

Type of System: Infiltrator Quick 4 (Gravity) System Class: Ila

Septic Tank Size: 1000 gal Pump Tank Size: NA Trench Bottom Depth: 18" (Low Side) LTAR: 0.5

Drinking Water Source: ☐ Single Family Well ☐ Spring ☒ Shared Well/ Spring off-site ☐ City ☐ Community

Future Repair Area Required ☒ Yes ☐ No Type of Repair: 25% Reduction (Gravity)

Date IP/AC issued: 9/12/08 Installer: Tim Teague

Cert. # 1739

Log #: 083208

Inspection Frequency: Health Dept.: NA

Mgt. Entity: NA


Reporting Frequency: NA

Cautions or Comments: B+B 1000 STB 805 1-22-08

The following checked items are on file and are part of this Operations Permit.

☐ Application ☐ Improvement Permit/ Auth. To Construct ☐ Soil Data Sheet ☐ Map (Other) ☐ Zoning Permit ☐ Survey/ Plat Map ☐ Engineer's Drawing

As-Built Diagram (Not to Scale)

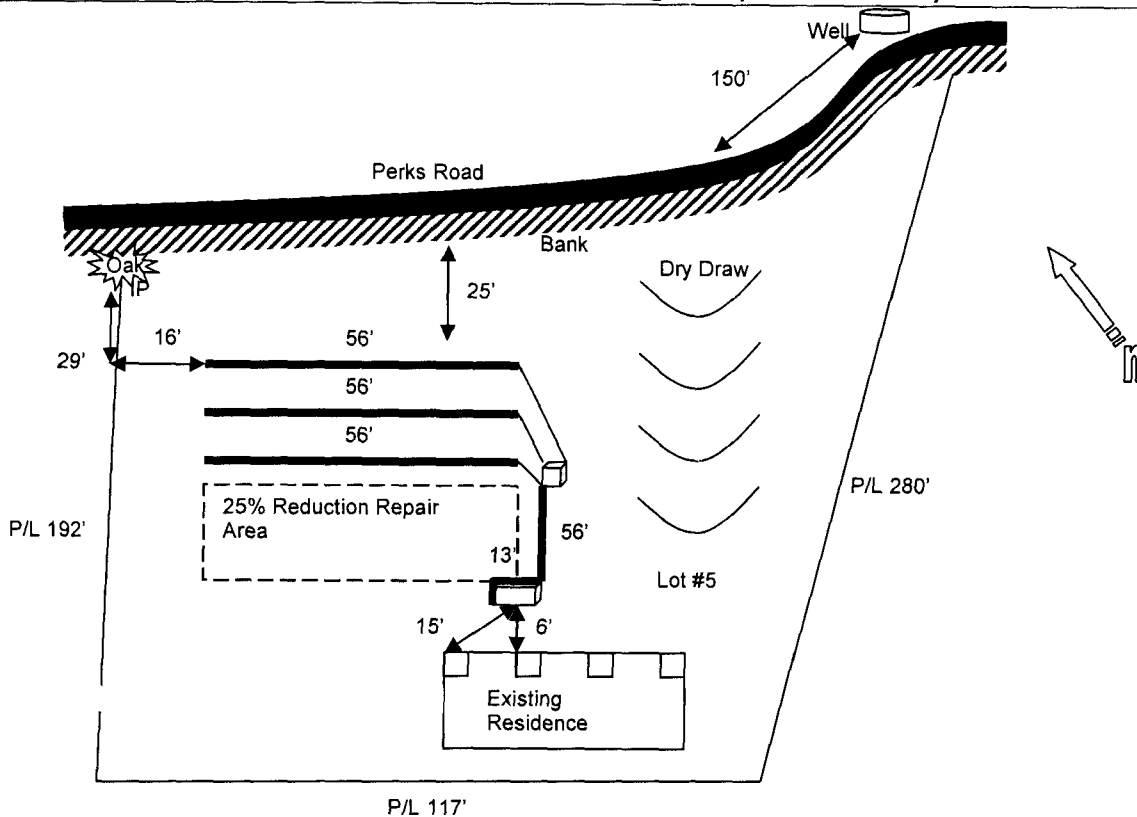

A representative of the Macon County Public Health Center has inspected this sewage disposal system and finds that it conforms to state guidelines. This Permit is issued subject to all the provisions of the North Carolina Laws and Rules for Sewage Treatment and Disposal. **No person is permitted to make alterations to this system without the approval of an authorized Environmental Health Specialist.** This approval indicates that this system has been installed in compliance with the standards as set forth in the above regulations, but shall in no way be taken as a guarantee that the system will function satisfactorily for any given period of time. The area designated as "repair area" is required for future use and must remain undisturbed.

Date Inspected: 2/17/09

Wesley Bintz, RS2227

Authorized State Agent