

MACON COUNTY PUBLIC HEALTH CENTER  
Franklin, North Carolina 28734

SUBSURFACE SEWAGE SYSTEM OPERATIONS PERMIT - TYPES II-IV

☒ New Installation ☐ Partial Repair ☐ 100% Repair

☒ Single family dwelling(s) 1 # ☐ Multi-family dwelling ☐ Commercial (type) \_\_\_\_\_

Total # bedrooms 3+Shop Daily Flow: 460 Gallons per day

Property Owner: Glade W. + Joyce Haas

Property Description: Middle Burningtown Rd.

Township Burningtown Parcel ID Number 10-00224 Map Number 6566.00-28-1122

Type of System Polystyrene Aggregate System Classification III

Septic Tank Size 1500 Pump Tank Size \_\_\_\_\_ Trench Bottom Depth 16-18" low side LTAR .55

Drinking Water Source: ☒ Individual Well/Spring ☐ Shared Well/Spring ☐ City ☐ Community

Future Repair Area Required ☒ Yes ☐ No Type of System for Future Repair 10" ID Large Dia. Pipe

Date Improvements Permit/Authorization to construct issued 7-8-99 Permit No. \_\_\_\_\_

Installer Gene Van Aernam Design Engineer \_\_\_\_\_ Project Number \_\_\_\_\_


Inspection Frequency: Health Dept. \_\_\_\_\_ Mgt. Entity \_\_\_\_\_ Mgt. Entity Reporting Frequency \_\_\_\_\_

Cautions or Comments: \_\_\_\_\_

**The following checked items are on file and are part of this Operations Permit:**

- |   |  |   |   |
|---|--|---|---|
| <input checked="" type="checkbox"/> Application | <input checked="" type="checkbox"/> Improvement Permit         | <input checked="" type="checkbox"/> Survey/Plat Map | <input type="checkbox"/> Engineer's Drawing |
| <input type="checkbox"/> Soil Data Sheet        | <input checked="" type="checkbox"/> Authorization To Construct | <input type="checkbox"/> Map (Other)                | <input type="checkbox"/> Zoning Permit      |
| <input type="checkbox"/> Other                  |  |   |   |

DIAGRAM (Not to Scale)

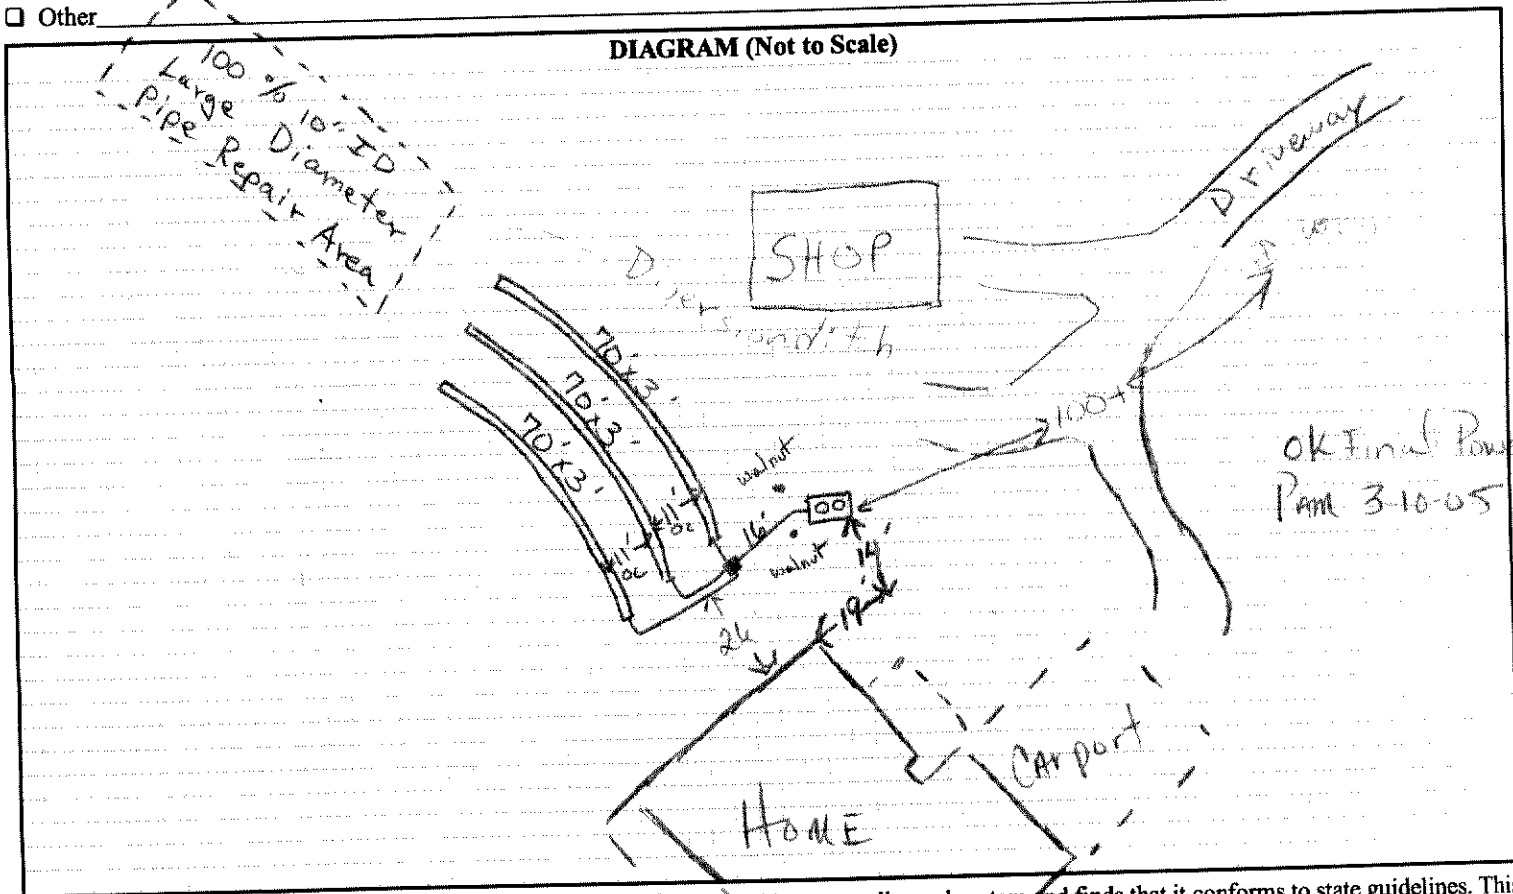

A representative of the Macon County Public Health Center has inspected this sewage disposal system and finds that it conforms to state guidelines. This permit is issued subject to all the provisions of the North Carolina Laws and Rules for Sewage Treatment and Disposal. **No person is permitted to make alterations to this system without the approval of an authorized Environmental Health Specialist.** This approval indicates that this system has been installed in compliance with the standards as set forth in the above regulations, but shall in no way be taken as a guarantee that the system will function satisfactorily for any given period of time. **The area designated as "repair area" is required for future use and must remain undisturbed.**

8-23-99  
Date Inspected

Charles Womack RS  
Environmental Health Specialist