



Macon County
Public Health

REQUEST FOR RESEARCH/PUBLIC INFORMATION
ENVIRONMENTAL HEALTH

Fields marked with an asterisk (*) are required.

114

PROPERTY INFORMATION		
PROPERTY OWNER*		DATE OF REQUEST*
Darryl Malmin		08/28/2026
ADDRESS*		PID#*
Little Hogback Mountain, Highlands, NC, 28741		7533445307
SUBDIVISION	LOT	ACREAGE
none		1.23
IMPROVEMENT PERMIT/ CONSTRUCTION AUTH. INFORMATION		
DATE OPERATION PERMIT ISSUED	YEAR HOUSE BUILT* 1978	OWNER AT TIME OF CONSTRUCTION* N/A
ADDITIONAL NAMES TO SEARCH*		
N/A		
CONTACT INFORMATION		
REQUESTOR/ AGENCY		
Vignette Realty LLC		
PHONE	FAX	
828-200-6387		
ADDRESS	E-MAIL	
	KS@vignetterealty.com	
COMMENTS		
Septic permits please!		

--

Owner or legal representative

Date

CONTACT US:

1830 Lakeside Dr, Franklin NC 28734
Phone: (828) 349-2489 or (828) 349-2490
Email- envirovm@maconnc.org
www.maconnc.org/environmental-health.html

If research beyond searching our database for provided names is required, a fee no less than for \$15 will be charged. For every additional 30 minutes of research, \$15 more will be charged.

Without making a site visit, MCPH makes no guarantee that the permit provided matches the requested property.

ENVIRONMENTAL HEALTH USE ONLY

FILES SEARCHED/ COMMENTS		
Not found. GIS points to 7533437686. -MA PERMIT DOCUMENTS 8/31/26		
RESULTS		
☒ FOUND ☐ NOT FOUND	FILE NAME/ NUMBER	TIME RESEARCH STARTED
TIME/ DATE/ 8/31/26 METHOD OF RESPONSE Email	RESEARCHER AJ	TIME RESEARCH FINISHED

Certificate of Completion

Macon County Health Department

Date 3-28-78

Time Called 10:00

NAME OF OWNER loyd Lephram


ADDRESS Buck Creek

NAME OF INSTALLER Merwin Chambers

PERMIT NUMBER 34

1. Site Permit Issued ☒
2. Septic Tank Properly Located ☒
3. Septic Tank Adequate Size ☒
4. Tank Meets Structural Requirements ☒
5. Tank Level ☒
6. Effluent Lower Than Influent ☒
7. Tank Has 9" Free Board ☒
8. Tank at Proper Depth ☒
9. All Ells 45 deg. or more with Cleanouts ☒
10. Dist. Box properly located and level ☒
11. All Solid Pipe of Approved Material ☒
12. Nitrification Line of Approved Material ☒
13. Lines of Sufficient Length and Width ☒
14. Lines have Approved Grade $\frac{1}{4}$ " in 10' ☒
15. Minimum of 8" gravel under and 2" over line ☒
16. Lines adequate distance apart ☒

Diagram

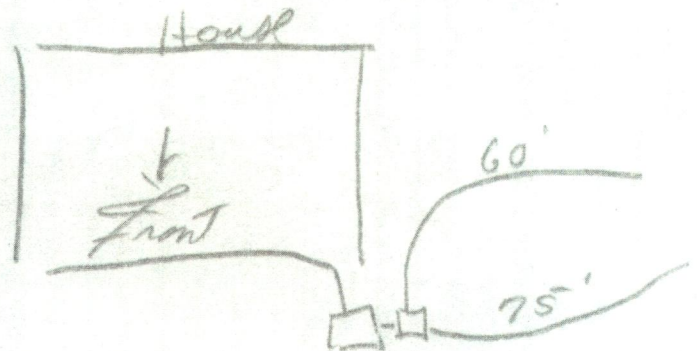

A Representative of the Macon County Health Dept. has inspected this Sewage System and finds it
() suitable () unsuitable.

Date inspected 3-28-78

Time inspected 1:00

This conforms the State Guidelines and is not a Guarantee.

Sanitarian

Ray Thomas