



The Jackson County Department of Public Health
538 Scotts Creek Rd. Suite 100 * Sylva, NC 28779
Tel: 828-586-8994 * FAX: 828-586-3493
Shelley Carraway
DIRECTOR
Shelley Carraway

Operations Permit

Reference Number: 2021-22252-9-11554	Permit Number: 2021-22252-9-11554
PIN: 7554-49-6807	Application Date: 11/30/2021
Owner: STAMEY, WAYNE K	City: FRANKLIN NC
Address: PO BOX 1352	Zip Code: 28744
Lot Number: LT 7,8 UN 1 TAHALA SHORES	Bedrooms: 5
Service Type: IP / CA / OP	
Directions To Site: Woods Mtn. Trail	

Initial System Type: IIIG-25% Reduction
Nitrification: 1091 SQFT
Pump Tank Size: N/A
Repair System Type: IIIF-10" LARGE DIAMETER PIPE
Septic Tank Size: 1500 GALLON INFILTRATOR PLASTIC

Remarks

Attached drawing is not to scale.
 Appropriate cover and vegetation shall be established ASAP to prevent erosion. Do not drive or build over system or repair. Do not fill over septic system or repair area. Maintain repair area. Pump tank every 3-5 years.

INSTALLED A 1500 GALLON INFILTRATOR PLASTIC SEPTIC TANK TO FEED 276' LINEAR FEET OF IIIG- 25% REDUCTION CHAMBER TYPE DRAINLINES IN TRENCHES 36" WIDE AND 23-33" DEEP. THREE TRENCHES CONNECTED BY 3" SCH 40 PVC IN A SERIAL FASHION.

SYSTEM ADEQUATE FOR 5 BEDROOMS 600 GPD MAXIMUM OCCUPANCY 10 PEOPLE.

INSTALLED BY: PATRICK RATHBONE, CERT #5405.

Fee: \$600.00
EHS: *Blake Bartha, 2838*

Receipt:
Date: 11/18/22

Signature: _____

Date: _____




Jackson County Department of Public Health
538 Scotts Creek Road, Suite 100
Sylva, NC 28779
Phone: (828) 587-8250 FAX: (828) 586-1207

Operations Permit

Reference Number: 2021-22252-9-11554
PIN: 7554-49-6807
Owner: STAMEY, WAYNE K
Address: PO BOX 1352
Lot Number: LT 7,8 UN 1 TAHALA SHORES
Service Type: IP / CA / OP
Directions To Site: Woods Mtn. Trail

Permit Number: 2021-22252-9-11554
Application Date: 11/30/2021
City: FRANKLIN NC
Zip Code: 28744
Bedrooms: 5

* supply line buried 30" + under driveway. Fed into the middle of top drainline via endcap. RBB 11/18/22

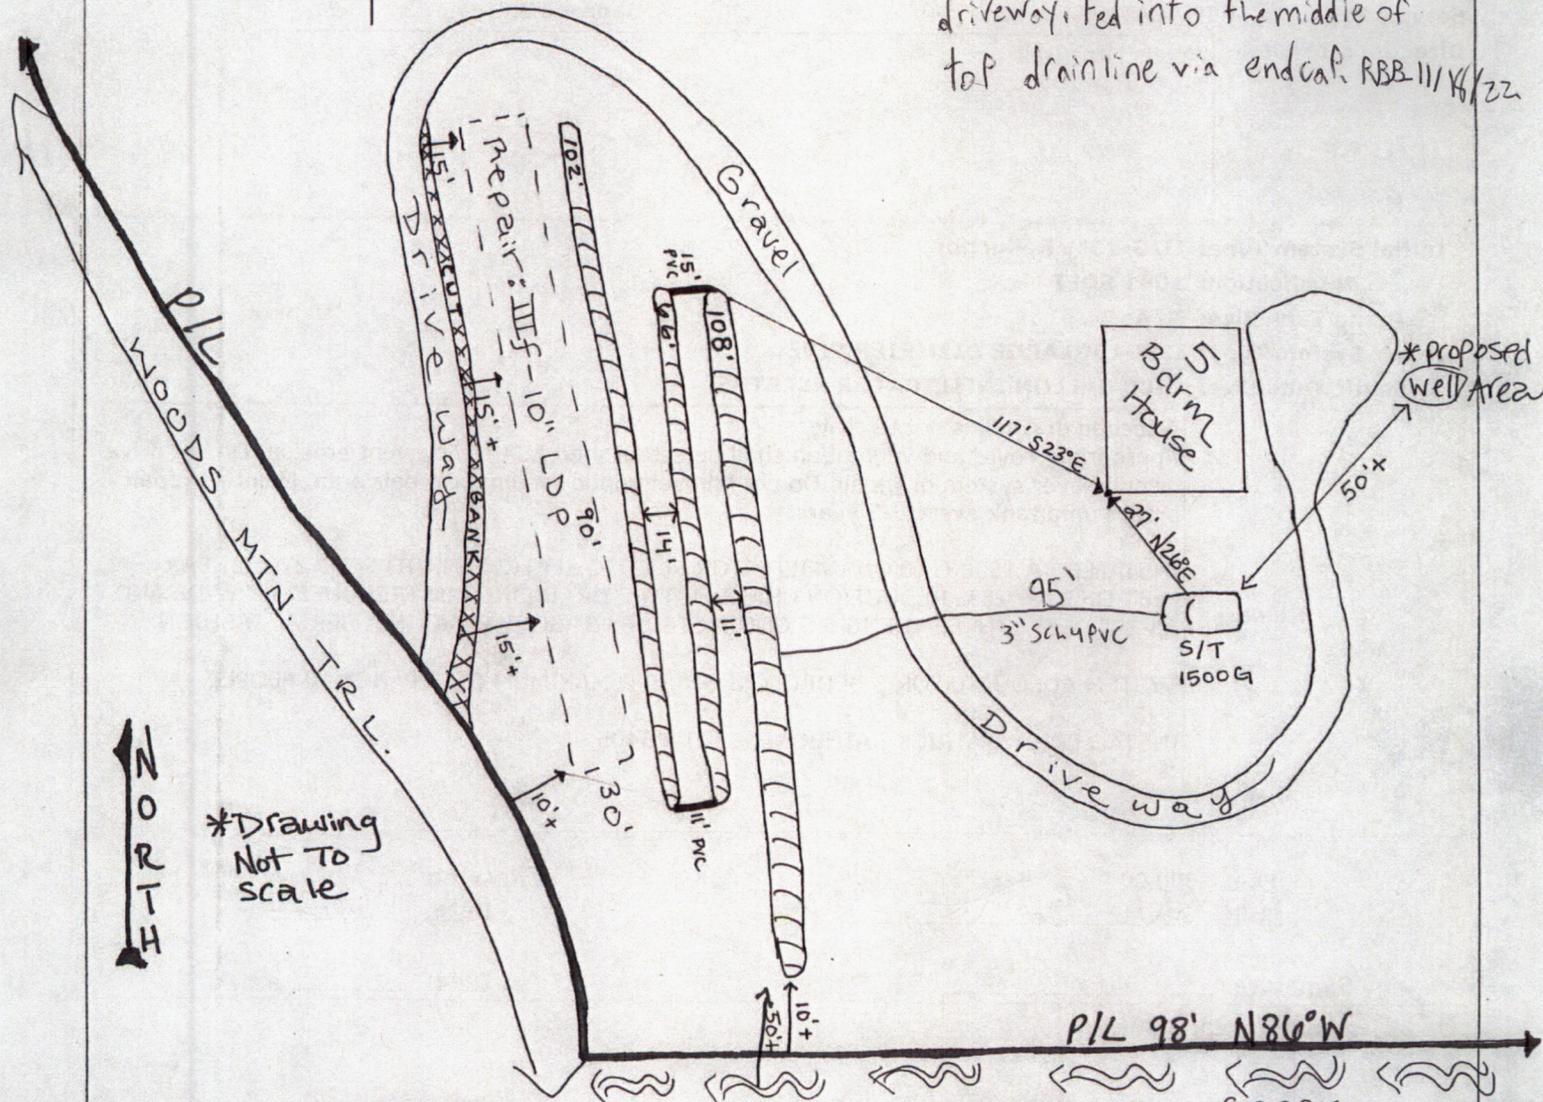

*Drawing Not To Scale

↑ NORTH

Fee: \$600.00

EHS: Blake Bart

Signature: _____

Receipt: _____

Date: 11/18/22

Date: _____