




Macon County
Public Health

OPERATIONS PERMIT ON-SITE WASTEWATER SYSTEM TYPES II-V

Applicant/Owner	CCJS, LLC	Log #	091621-S	PDWW#	Existing
Address	Lot 8, Simplicity Woods	PID #	6593557801	ACREAGE	2.18
Directions	Clarks Chapel Road to R on Simplicity Woods Drive to top lot on left.				
Design	240 Gallons Per Day	Facility	2 BDRM Tiny Home	Install Type	New Construction
Foundation	Crawlspace	Water Source	Existing Shared Well / On Site		

The following items are on file and part of this permit: ☐GPS/GIS ☒Application ☒IP/CA ☒Soil Sheet ☐Map ☐Plat Map ☐Engineer's Drawing
Comments:

As-Built Diagram (Not to Scale)

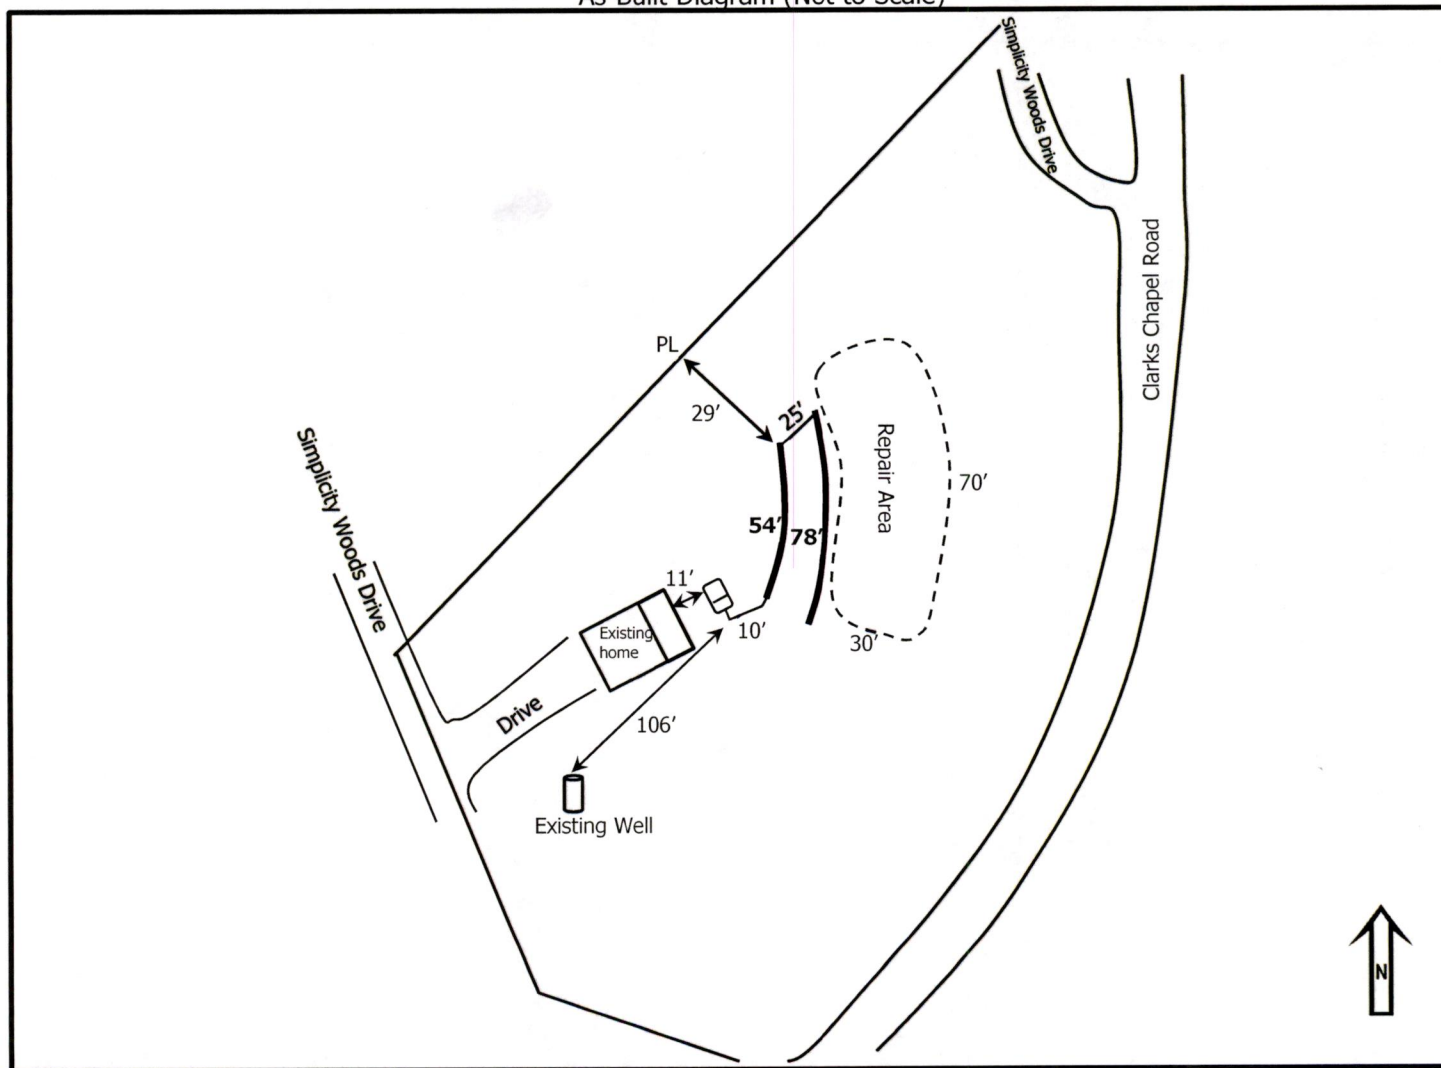

INSTALLED	Infiltrator Quick 4 Plus (IQ4PS) - Gravity;			REPAIR	25% Reduction - Gravity;		
Type IIa	Average Trench Depth: 18"	LTAR: 0.45	Saprolite: Yes	Type IIa	Area: 1100 ft ²	LTAR: 0.45	Saprolite: Yes
S. TANK	1000 gallons	ID: INF - STB - 2071 - 1000 gallons	Date: 2 0 2 1	Effluent Filter: Polylok			
P. TANK	Not Required	ID: MFG - PT - ID# - gallons	Date: N / A	Dosing Detail: N/A			
TRENCH	Length: 132 ft	# of Lines: 2	DISTRIBUTION	Serial - SCH40	WELL SETBACK	100 ft Minimum	
INSTALLER	Patrick Rathbone	Cert. # 5405	MONITORING	M C P H :	Mgt. Entity:	Reporting Freq.:	

This system has been installed in compliance with applicable NC General Statutes, Rules for Sewage Treatment and Disposal, and all conditions of the I.P and A.C. System shall perform in accordance with Rule .1961. Ground absorption sewage treatment and disposal systems shall be checked, and the contents of the septic tank removed, periodically from all compartments, to ensure proper operation of the system. The contents shall be pumped whenever the solids level is found to be more than 1/3 of the liquid depth in any compartment. **QUESTIONS? (828)349-2490**

Inspection Date: 12/2/2021

Jonathan Fouts, REHS 1979

Jonathan Fouts, REHS

Authorized State Agent

Final Inspection/ Issue Date: 12/2/2021

Jonathan Fouts, REHS 1979

Jonathan Fouts, REHS

Authorized State Agent