

Certificate of Completion

Macon County Health Department

Date 6-12-87

Time Called 11:25


NAME OF OWNER Bill & Jill Lee

ADDRESS Lot 1 Block B Trimont Mtn. Estates

NAME OF INSTALLER Bill Lee

PERMIT NUMBER ✓

1. Site Permit Issued ✓
2. Septic Tank Properly Located ✓
3. Septic Tank Adequate Size ✓
4. Tank Meets Structural Requirements ✓
5. Tank Level ✓
6. Effluent Lower Than Influent ✓
7. Tank Has 9" Free Board ✓
8. Tank at Proper Depth ✓
9. All Ells 45 deg. or more with Cleanouts ✓
10. Dist. Box properly located and level ✓
11. All Solid Pipe of Approved Material ✓
12. Nitrification Line of Approved Material ✓
13. Lines of Sufficient Length and Width ✓
14. Lines have Approved Grade 1/4" in 10' ✓
15. Minimum of 8" gravel under and 2" over line ✓
16. Lines adequate distance apart ✓

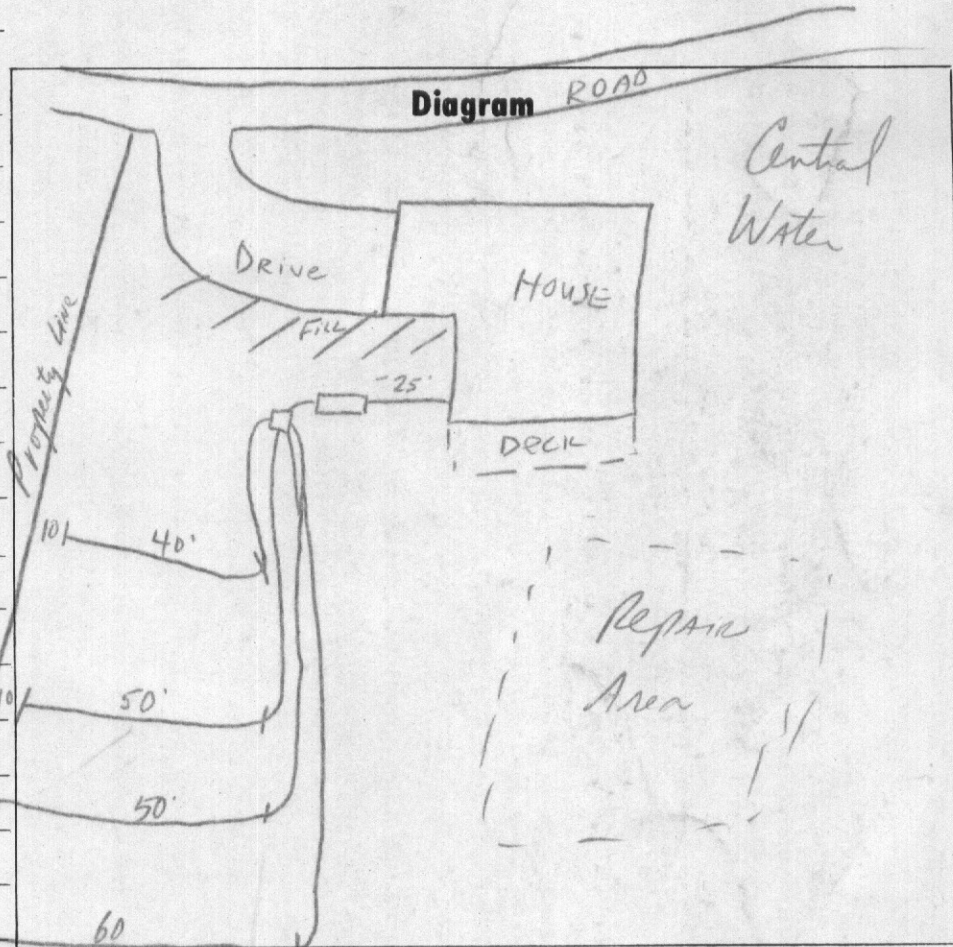

A Representative of the Macon County Health Dept. has inspected this Sewage System and finds it ☒ suitable () unsuitable.

Date inspected 6-12-87

Time inspected 1:26

This conforms the State Guidelines and is not a Guarantee.

SEPTIC SYSTEM FINAL
Power Hook-up OK
W. David Simpson

DM

Sanitarian


Jane B. Morgan

MACON COUNTY HEALTH DEPARTMENT
FRANKLIN, N.C. 28734
369-9526

IMPROVEMENTS PERMIT

Owner <u>Bill & Jill Lee</u>	Number of Bedrooms <u>3</u>
Location <u>Lot 1 Block 8 Trimont Mtn Est.</u>	Number of Bathrooms <u>3</u>
Area of Lot	Type of Tank (Size) <u>Precast</u>
Residential ☒	Drain Line Length <u>200'</u>
Commercial ☐	Drain Line Width <u>3'</u>
Mobile Home ☐ Size	Size Tank (Gal.) <u>1000</u>
Square Footage of House <u>2300</u>	Stone Under Line <u>8"</u>
SCS Soil Test	Stone Over Line <u>2"</u>

DIAGRAM

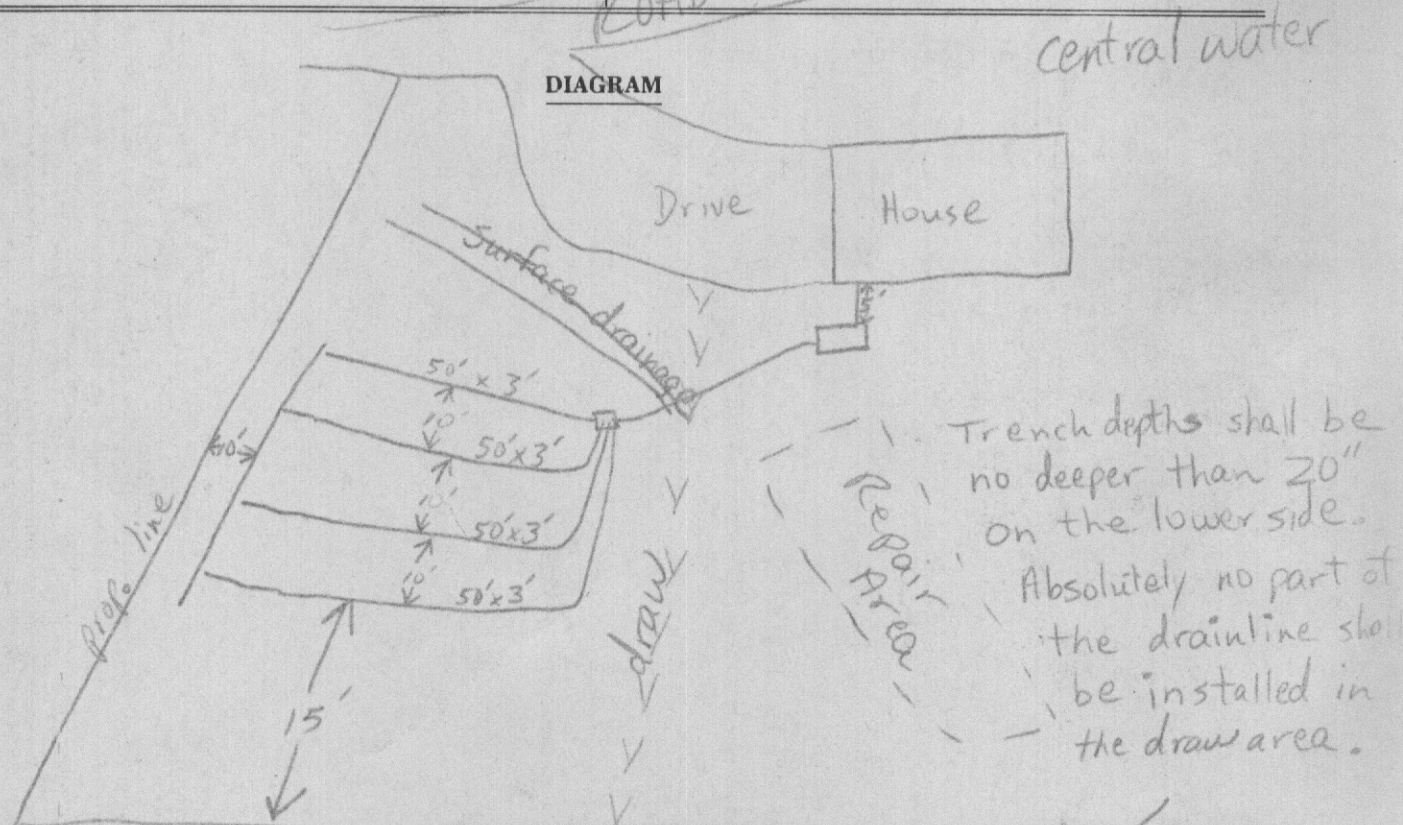

A representative of the Macon County Health Department has made a field investigation of this property and finds it ☐ suitable ☐ marginally suitable ☐ unsuitable for proposed installation. This permit is valid for 1 year after date of issue. Any alterations of this proposed installation as shown by this permit renders it invalid. If any soil restrictions are encountered during installation, contractor shall contact M.C.H.D.

This conforms to State Guidelines and is not a GUARANTEE.

DATE 1/12/87 SANITARIAN Patrick Murre Jane Murre

I, Jill Lee state that the above information is correct to the best of my knowledge.