


CONSTRUCTION	KEY
FOUNDATION • STONE	B • BOILER
STRUCTURE • WOOD FRAME	DW • DISH WASHER
SIDING • VINYL	E • ELECTRIC
ROOFING • TAR AND GRAVEL	F • FURNACE
	G • GAS
	OT • OIL TANK
	R • REFRIGERATOR
	W/D • WASHER/DRYER
	WH • WATER HEATER
	WL • WATER LINE
	WM • WATER METER


CEILING HEIGHTS
BASEMENT • 7'-2"
FIRST FLOOR • 9'-1"
SECOND FLOOR • 8'-9"
THIRD FLOOR • 8'-9"

0'5'10'20'


1/8" = 1'-0"

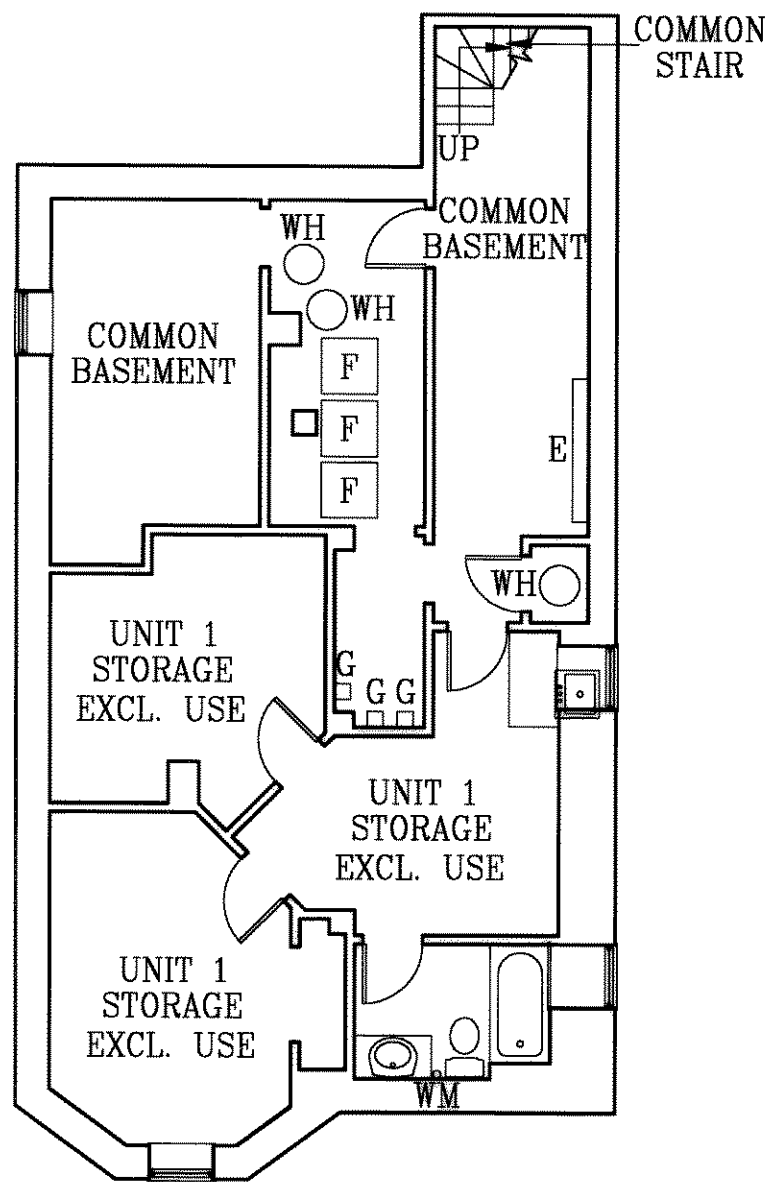


BASEMENT

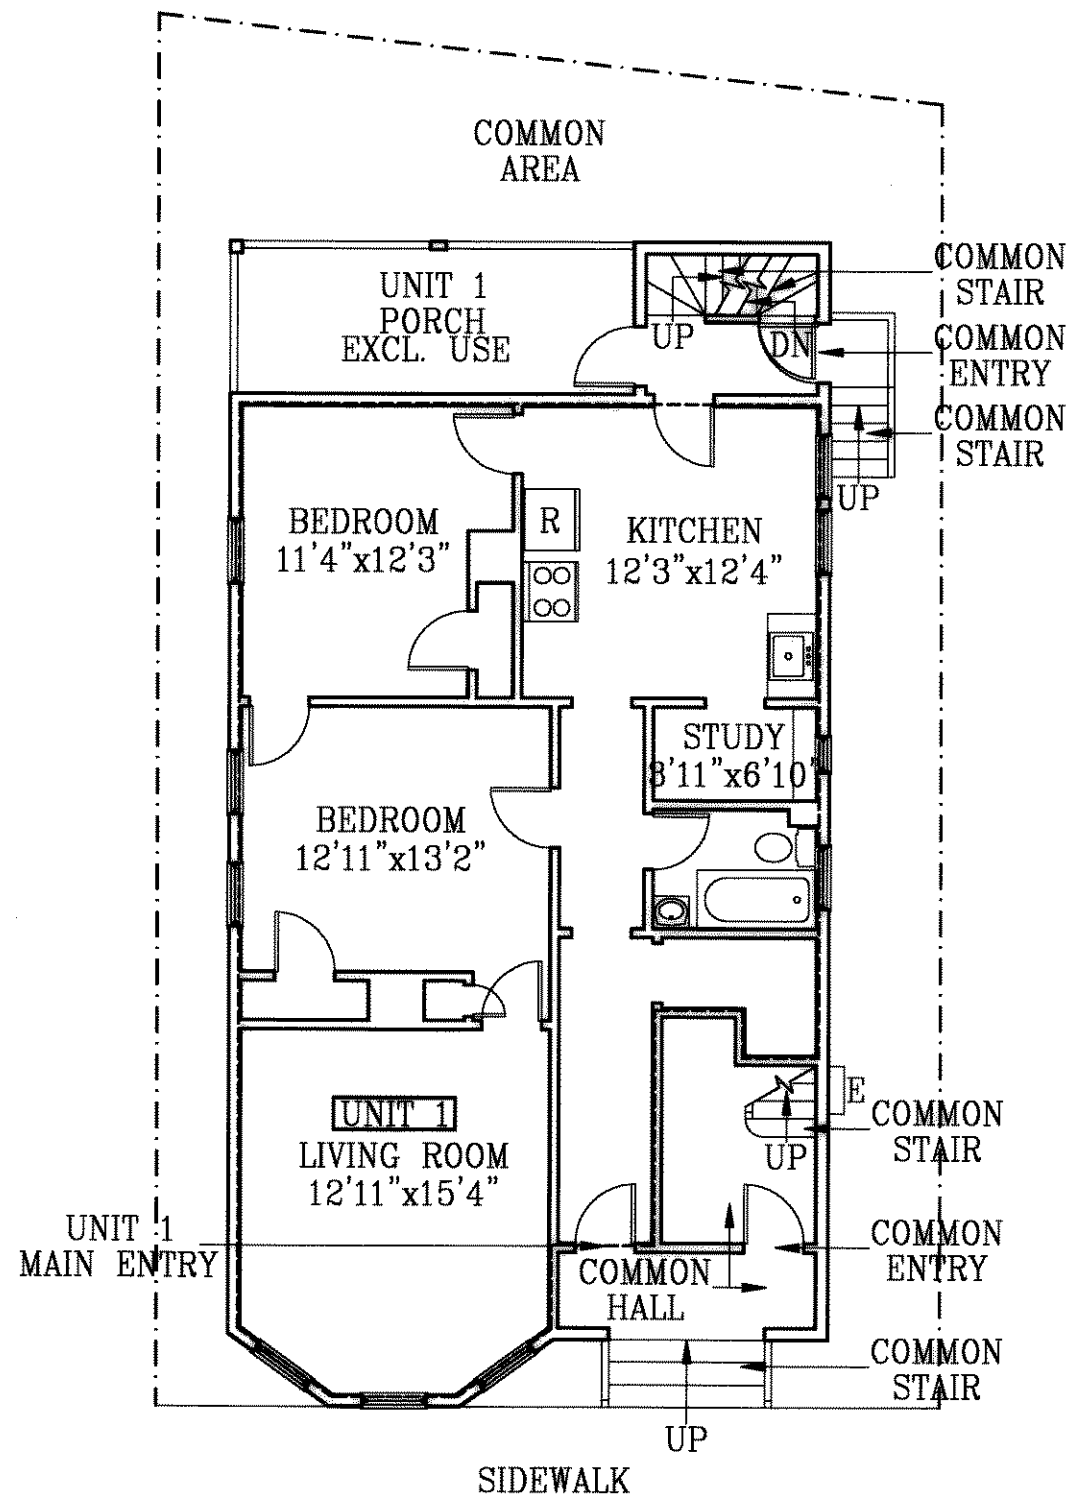

FIRST FLOOR & SITE

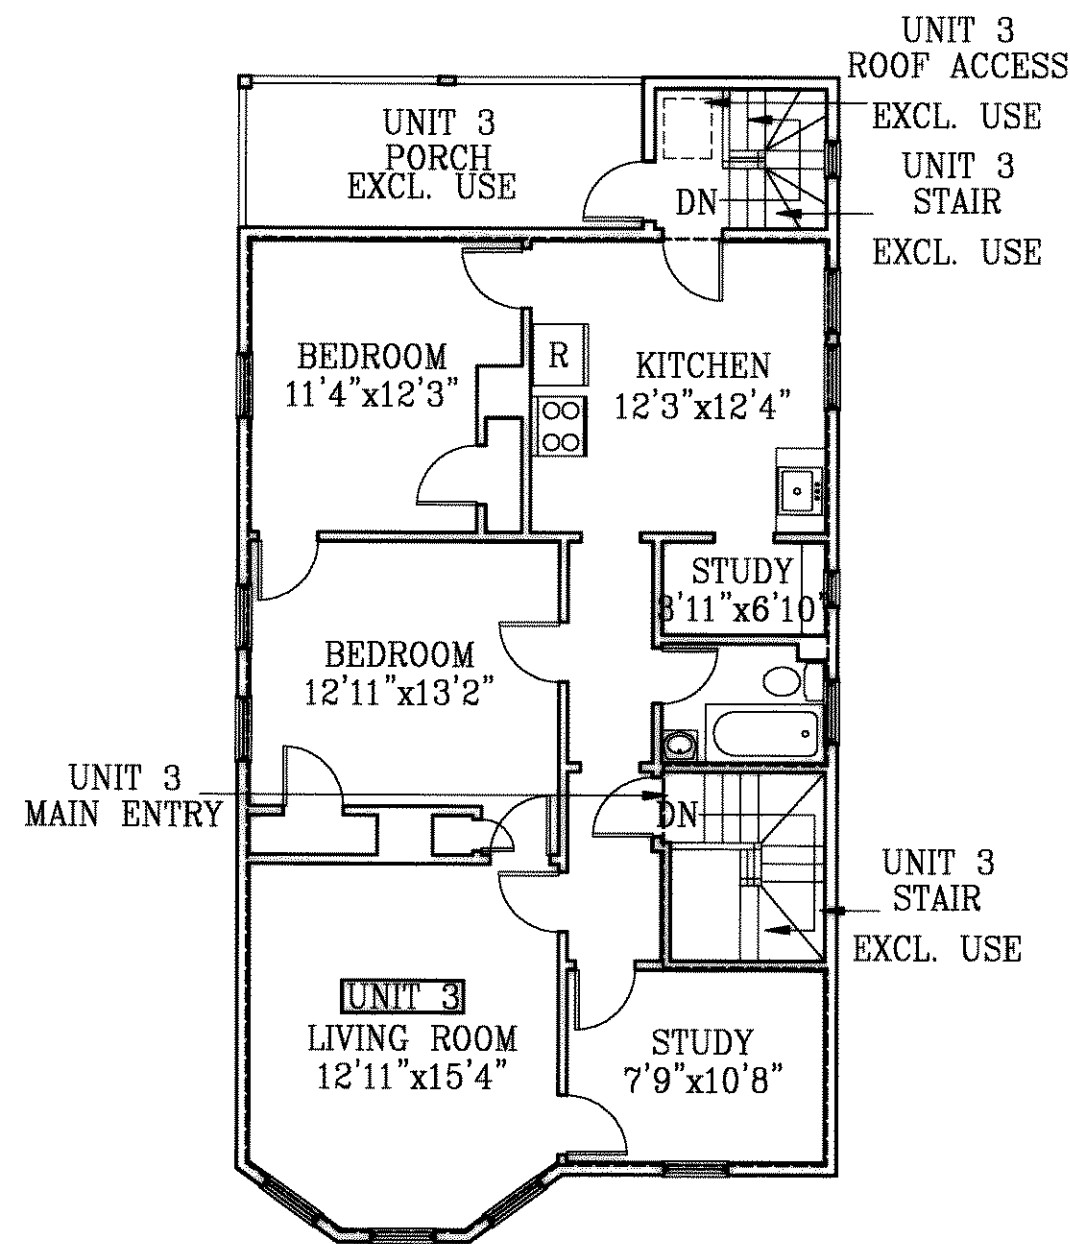

THIRD FLOOR

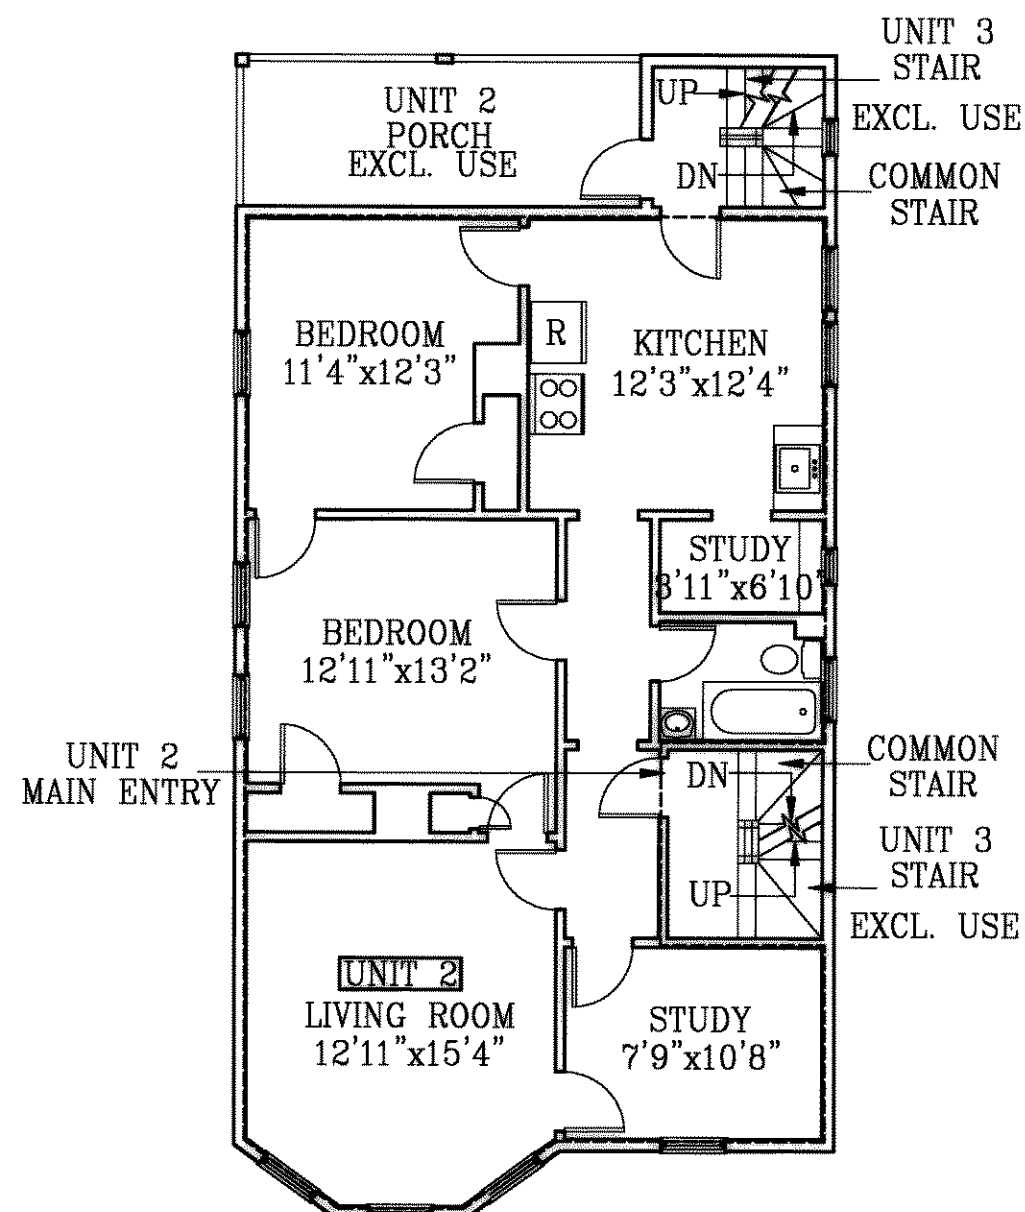

SECOND FLOOR

2005 00001009
Cert#: Bk: 2005 Pg: 1009
Doc: PLAN 12/09/2005 01:41 PM

2005-1009

RESERVED FOR REGISTRY USE

3 KENNEY STREET CONDOMINIUM JAMAICA PLAIN, MASSACHUSETTS 02130

FLOOR PLANS - AS BUILT
TO ACCOMPANY MASTER DEED

UNIT 1	865	SQUARE FEET
UNIT 2	908	SQUARE FEET
UNIT 3	908	SQUARE FEET

NOTES:
DIMENSIONS ARE TO FACE OF
PLASTER.
DIMENSIONS NOTED MAY BE
DETERMINED BY SCALING.
BUILDING IS OF WOOD FRAME
CONSTRUCTION.

CERTIFICATIONS:
I HEREBY CERTIFY THAT THIS PLAN
WAS PREPARED IN ACCORDANCE
WITH THE RULES AND REGULATIONS
OF THE MASSACHUSETTS REGISTRIES
OF DEEDS.

I HEREBY CERTIFY THAT THIS PLAN
FULLY AND ACCURATELY DEPICTS
THE LAYOUT, DIMENSIONS AND
LOCATION OF THE BUILDING AND
OTHER DESIGNATED ELEMENTS, AS
BUILT, AS OF OCTOBER 20, 2005 OF THE
PROPERTY AT 3 KENNEY STREET,
JAMAICA PLAIN, MASSACHUSETTS.

I HEREBY CERTIFY THAT THIS PLAN
FULLY AND ACCURATELY DEPICTS
THE LAYOUT, LOCATION, UNIT
NUMBER AND DIMENSIONS OF THE
UNITS, AS BUILT, AS OF OCTOBER 20,
2005.

JONATHAN RAISZ DATE: OCT. 20, 2005
REG. ARCHITECT - MA LIC. NO. 8181

