


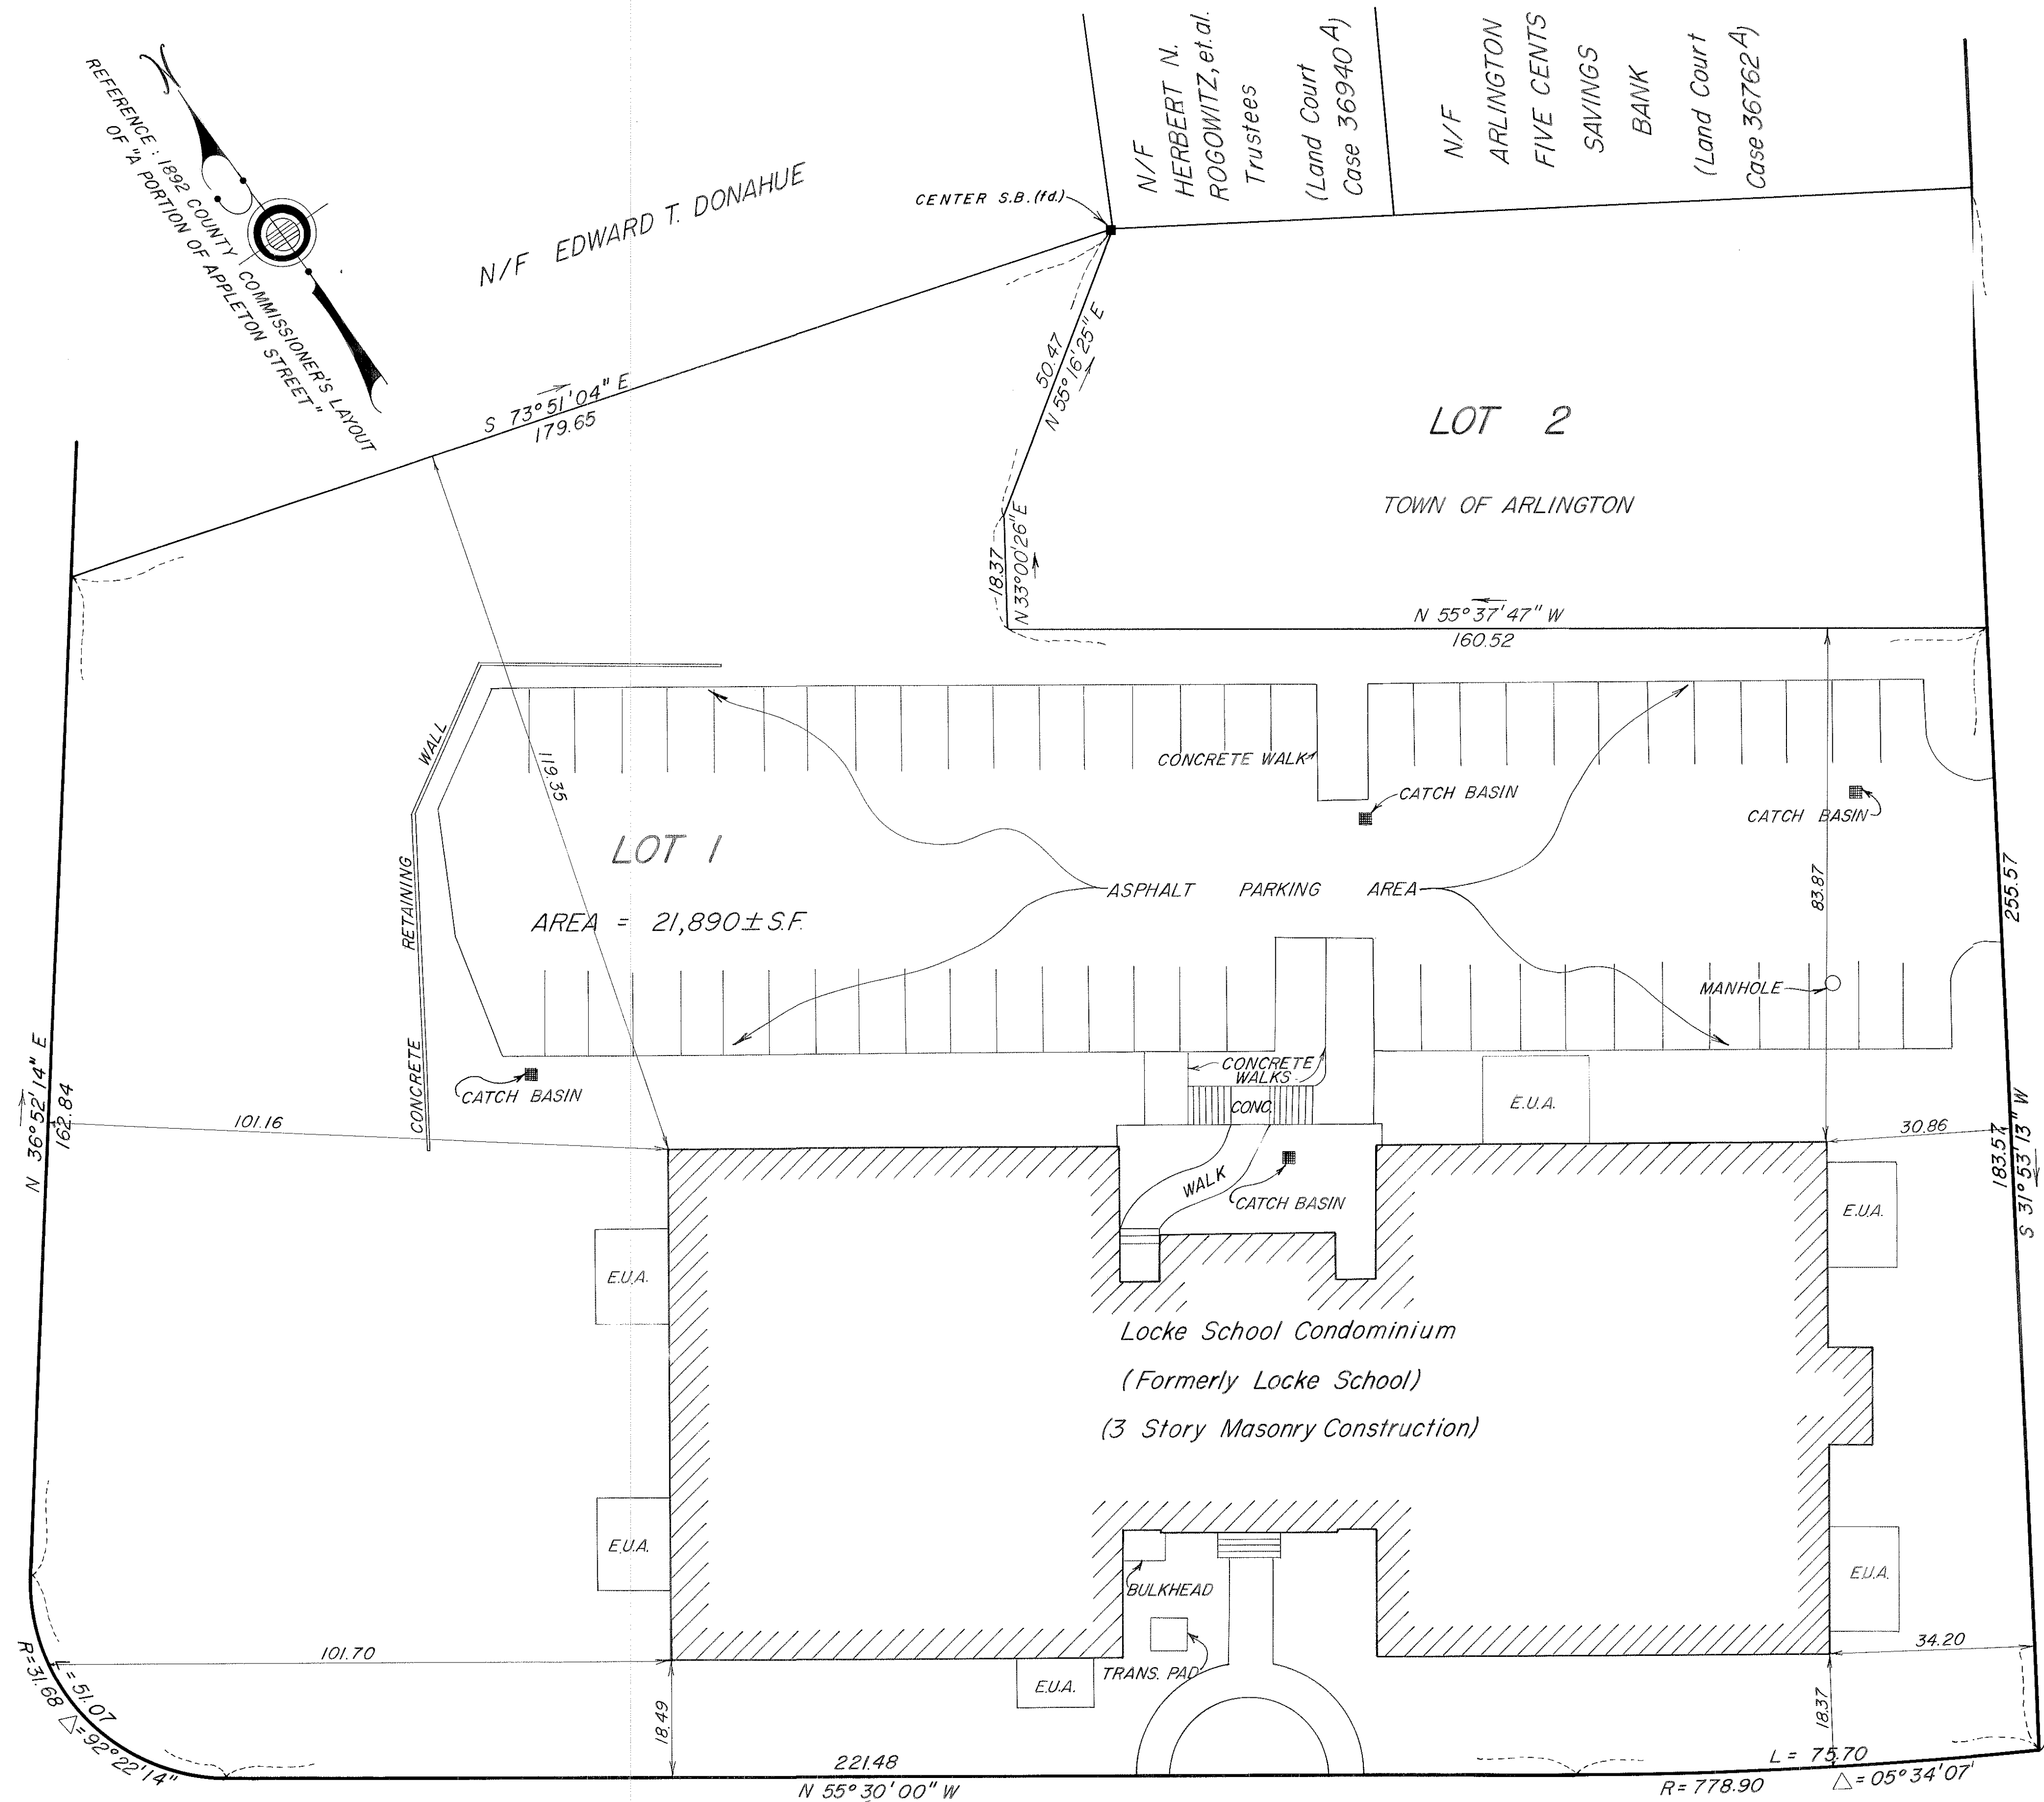

SURRY ROAD

DAVIS ROAD
(Public - 40' Wide)

PARK AVENUE
(Public - 80' Wide)
(1875 Layout)

PAUL REVERE ROAD
(Formerly Vine Street)
(Public - 50' Wide) (1877 Layout)


NOTE:
E.U.A. DENOTES EXCLUSIVE USE AREA

I certify that the preparation of this plan conforms with the rules and regulations of the Registers of Deeds, dated: January 1, 1976.
Henry E. Thomas, Jr. Registered Land Surveyor
Date: June 28, 1984

This survey and plan were prepared in accordance with Procedural and Technical Standards for the Practice of Land Surveying in the Commonwealth of Massachusetts. This plan and the accompanying statements do not constitute a certification of title to either the property or the abutting properties displayed hereon.


By: *Henry E. Thomas, Jr.* R.L.S. 2P092 June 29, 1984

I certify that this plan fully and accurately depicts the location of the Locke School Condominium building.
Henry E. Thomas, Jr. Registered Land Surveyor
Date: June 28, 1984

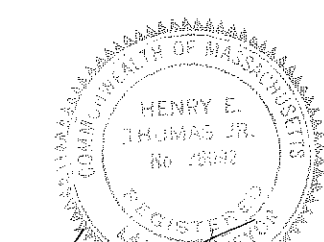


Henry E. Thomas, Jr.
June 28, 1984

Plan of Land in
ARLINGTON, MASS.
Prepared for: Locke School Trust
Scale: 1" = 16' Date: June 28, 1984
Schofield Brothers, Inc. Professional Engineers
& Registered Land Surveyors
1071 Worcester Road, Framingham, Mass., 01701

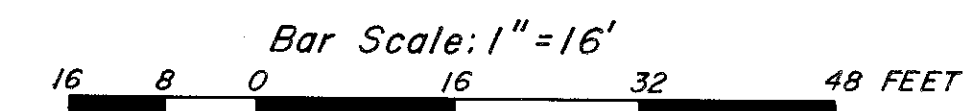

Research by: *L.J.D.* Drafted by: *W.J.B.*
Field Chief: *R.H.M.* Checked by: *H.E.T.*
Computed by: *M.E.D.* Approved by: *H.E.T.*

Fee 200 By EJK
Middlesex Registry of Deeds
Southern District
Cambridge, Massachusetts
Plan No 741(A0FB) of 1984
Rec'd JULY 5 1984
at 9:50am Doc No 82
Rec'd, Bk 15666 Pg 566
Attest
John F. Jangoull
Register

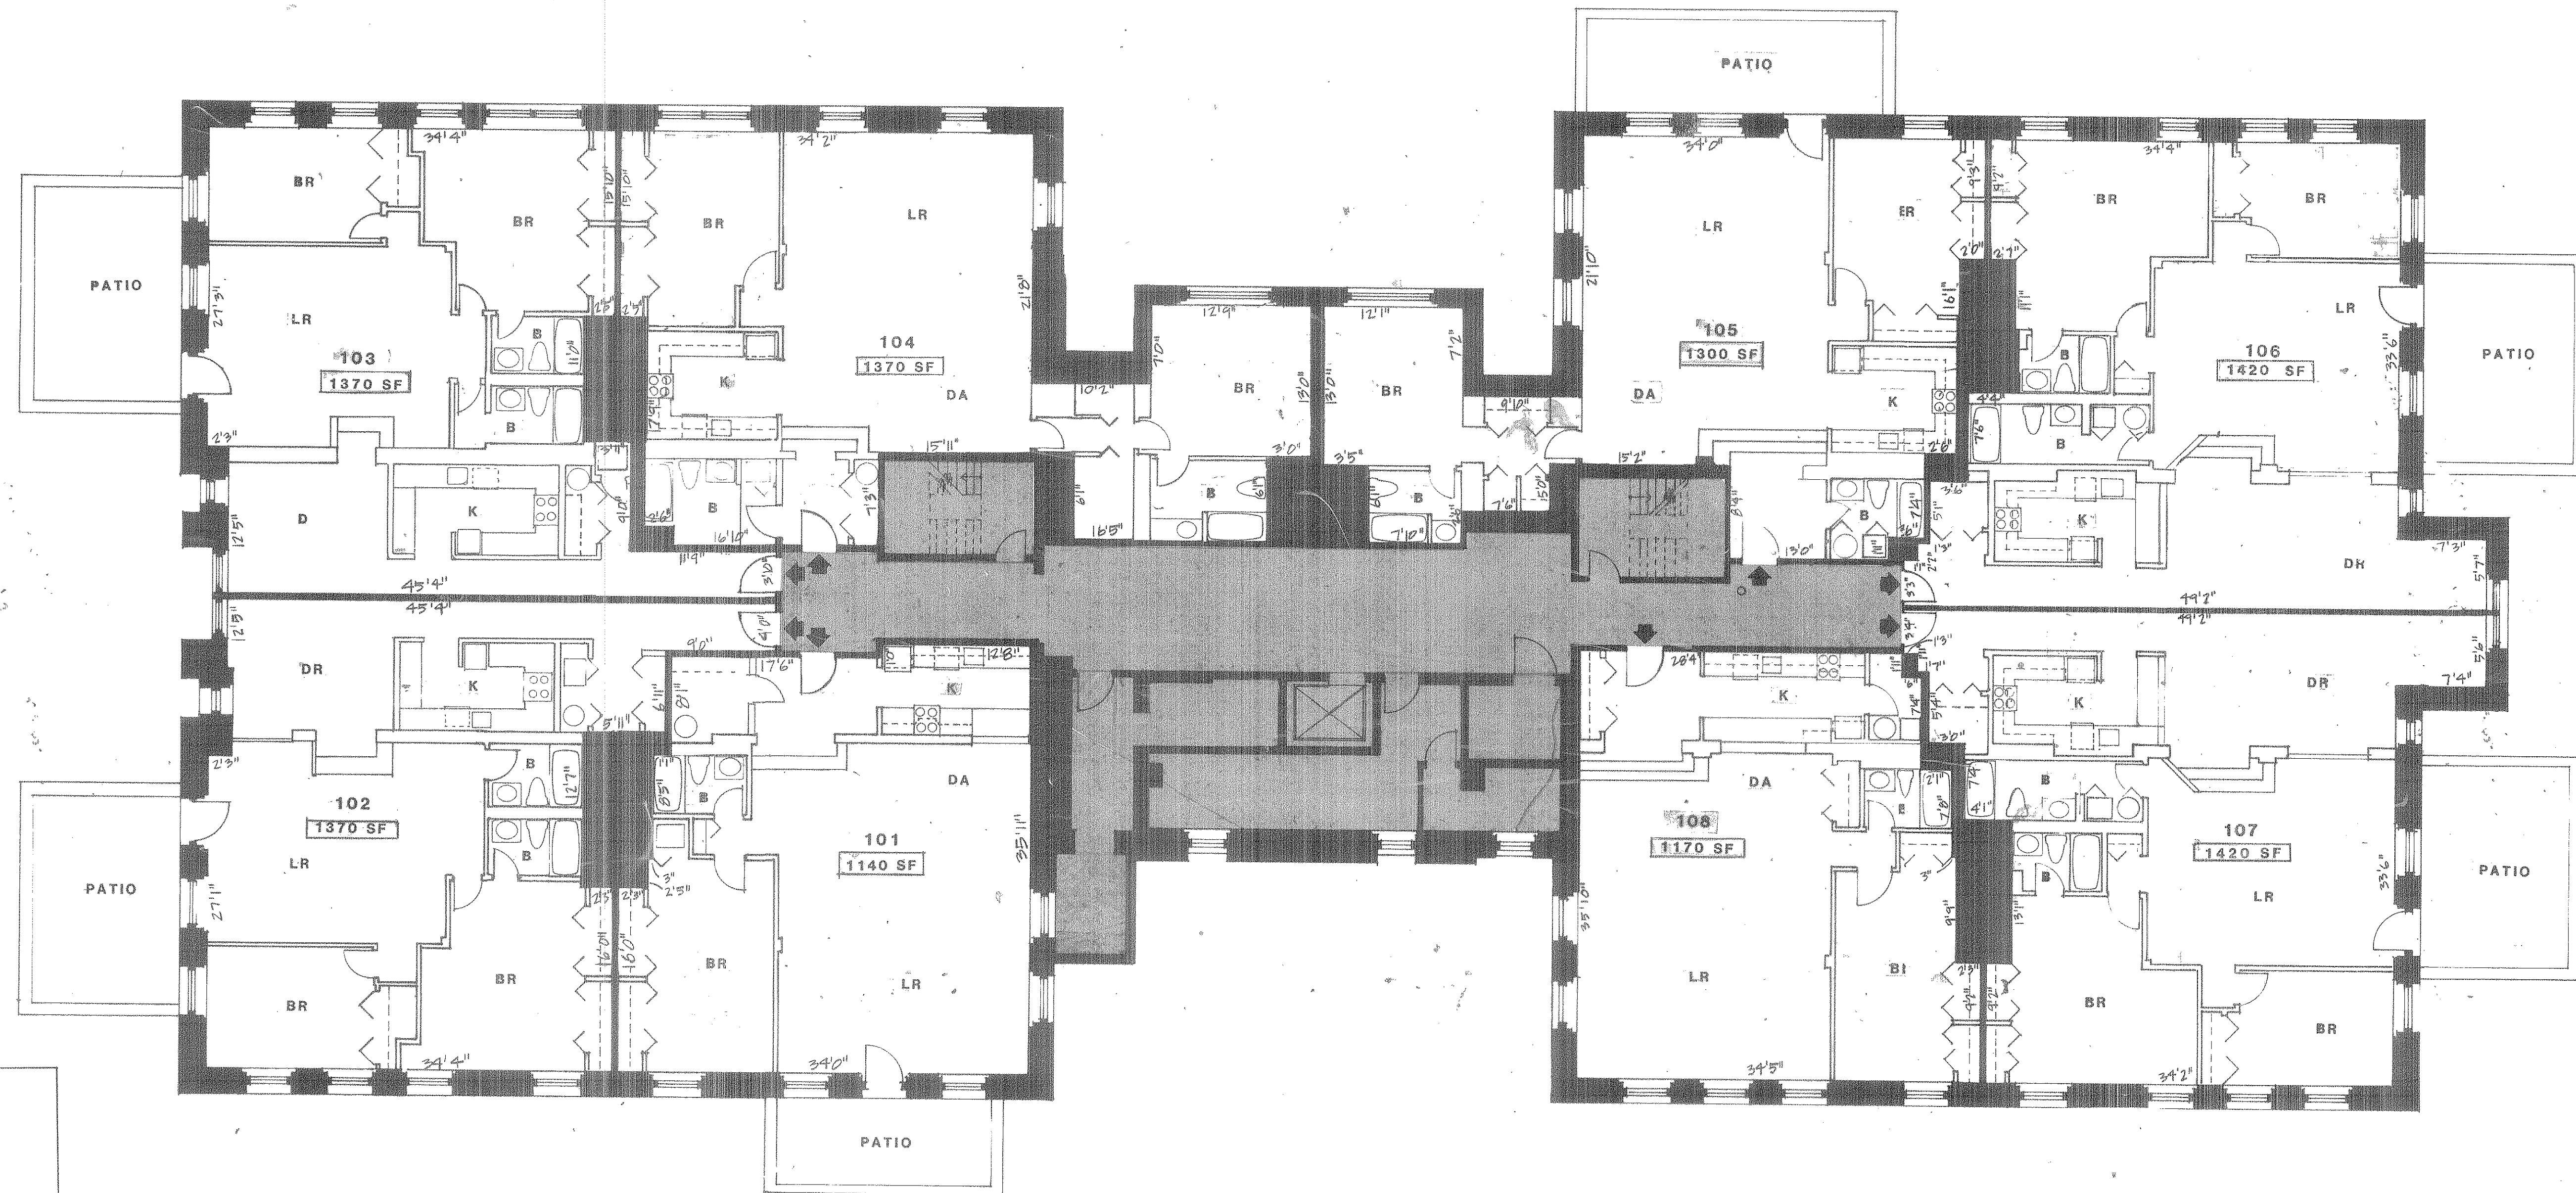


I certify that this plan has been prepared in conformity with the rules and regulations of the Registry of Deeds of the Commonwealth of Massachusetts.


I certify that this plan fully and accurately depicts the layout, location, unit number and dimensions of each of the units in the Locke School Condominium shown herein, as built and in existence on the date hereof.

Peter A. Bullis
 Peter A. Bullis
 6-19-84
 Date

Maurice N. Finegold
 Maurice N. Finegold
 7-3-84
 Date

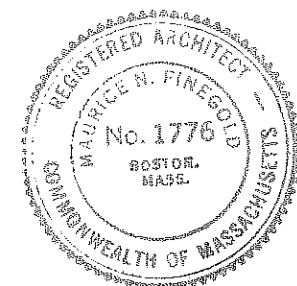

ANDERSON NOTTER FINEGOLD INC.

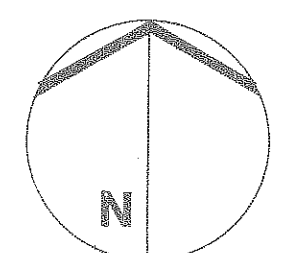

GROUND FLOOR
LOCKE SCHOOL CONDOMINIUM
 FORMERLY THE LOCKE SCHOOL, ARLINGTON, MASSACHUSETTS

0 2 5 10 15 30 50

1

741-2


I certify that this plan has been prepared in conformity with the rules and regulations of the Registry of Deeds of the Commonwealth of Massachusetts.

I certify that this plan fully and accurately depicts the layout, location, unit number and dimensions of each of the units in the Locke School Condominium shown herein, as built and in existence on the date hereof.

Peter E. Bullis
Peter E. Bullis
Maurice N. Finegold
Maurice N. Finegold

6-19-84
Date


ANDERSON NOTTER FINEGOLD INC.

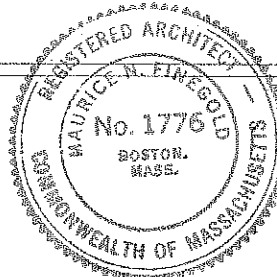

PAUL REVERE ROAD

PARKING

DAVIS ROAD

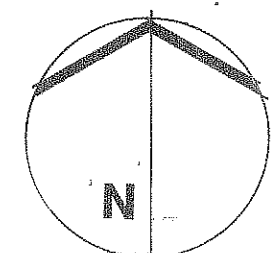


FIRST FLOOR
LOCKE SCHOOL CONDOMINIUM
FORMERLY THE LOCKE SCHOOL, ARLINGTON, MASSACHUSETTS

0 2 5 10 15 30 50

2


741-3

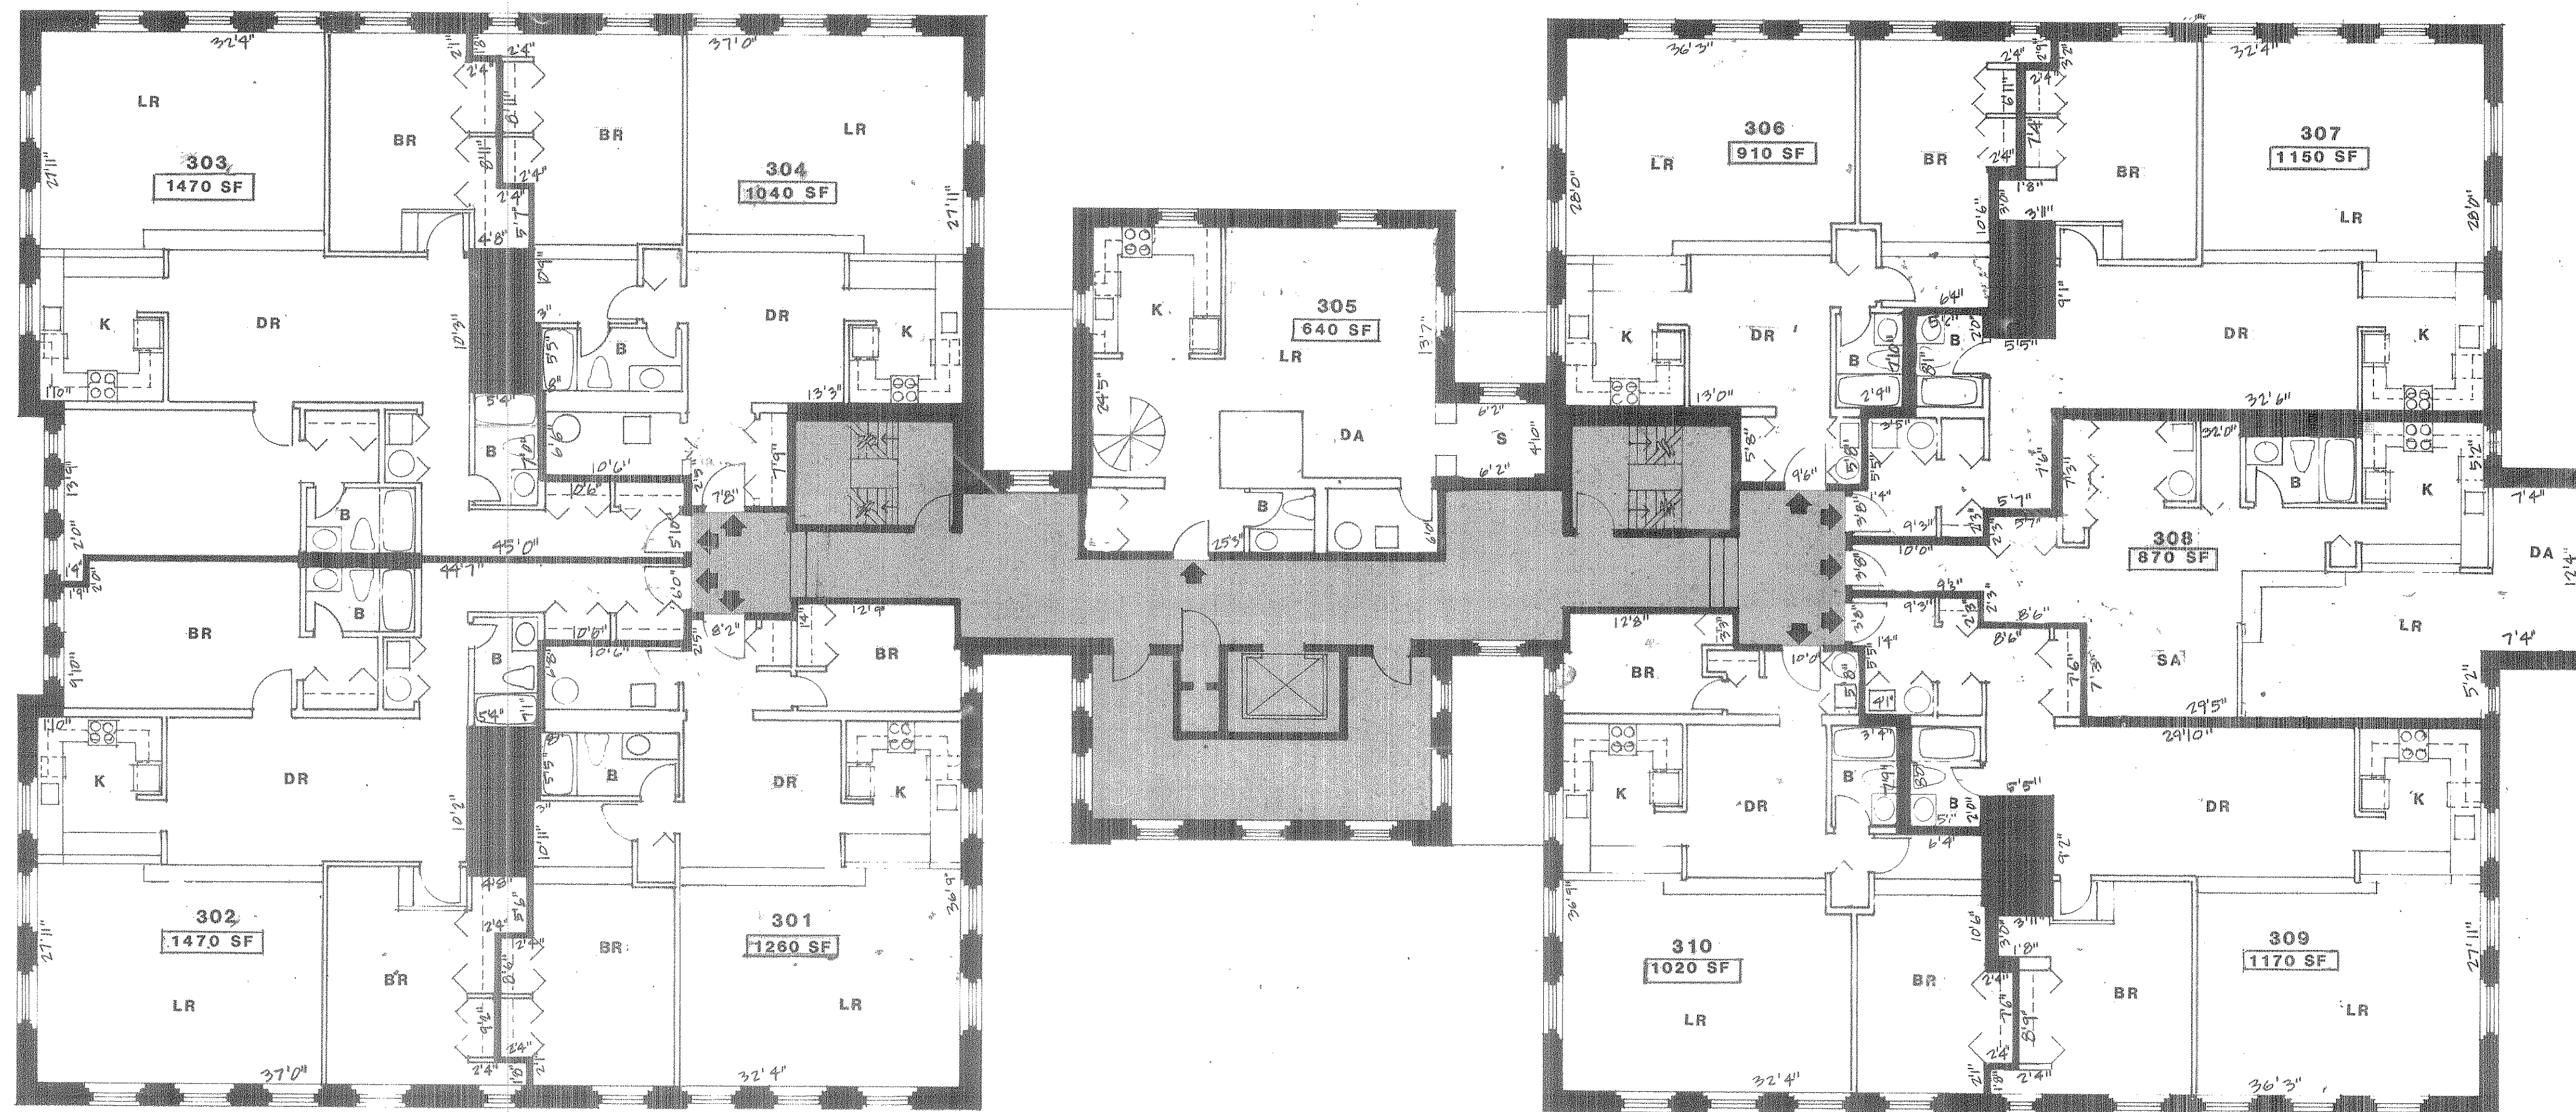


I certify that this plan has been prepared in conformity with the rules and regulations of the Registry of Deeds of the Commonwealth of Massachusetts.

I certify that this plan fully and accurately depicts the layout, location, unit number and dimensions of each of the units in the Locke School Condominium shown herein, as built and in existence on the date hereof.

Peter E. Bullis
Peter E. Bullis
Date 6-19-84
Maurice N. Finegold
Maurice N. Finegold

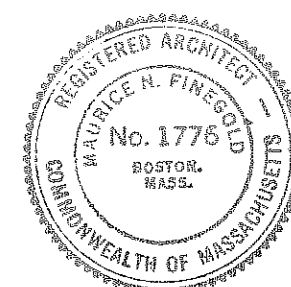


ANDERSON, NOTTER FINEGOLD INC.

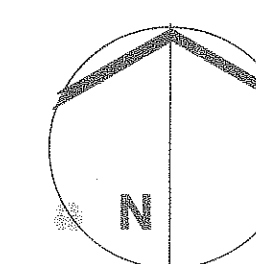

SECOND FLOOR
LOCKE SCHOOL CONDOMINIUM
FORMERLY THE LOCKE SCHOOL, ARLINGTON, MASSACHUSETTS

0 2 5 10 15 30 50


3

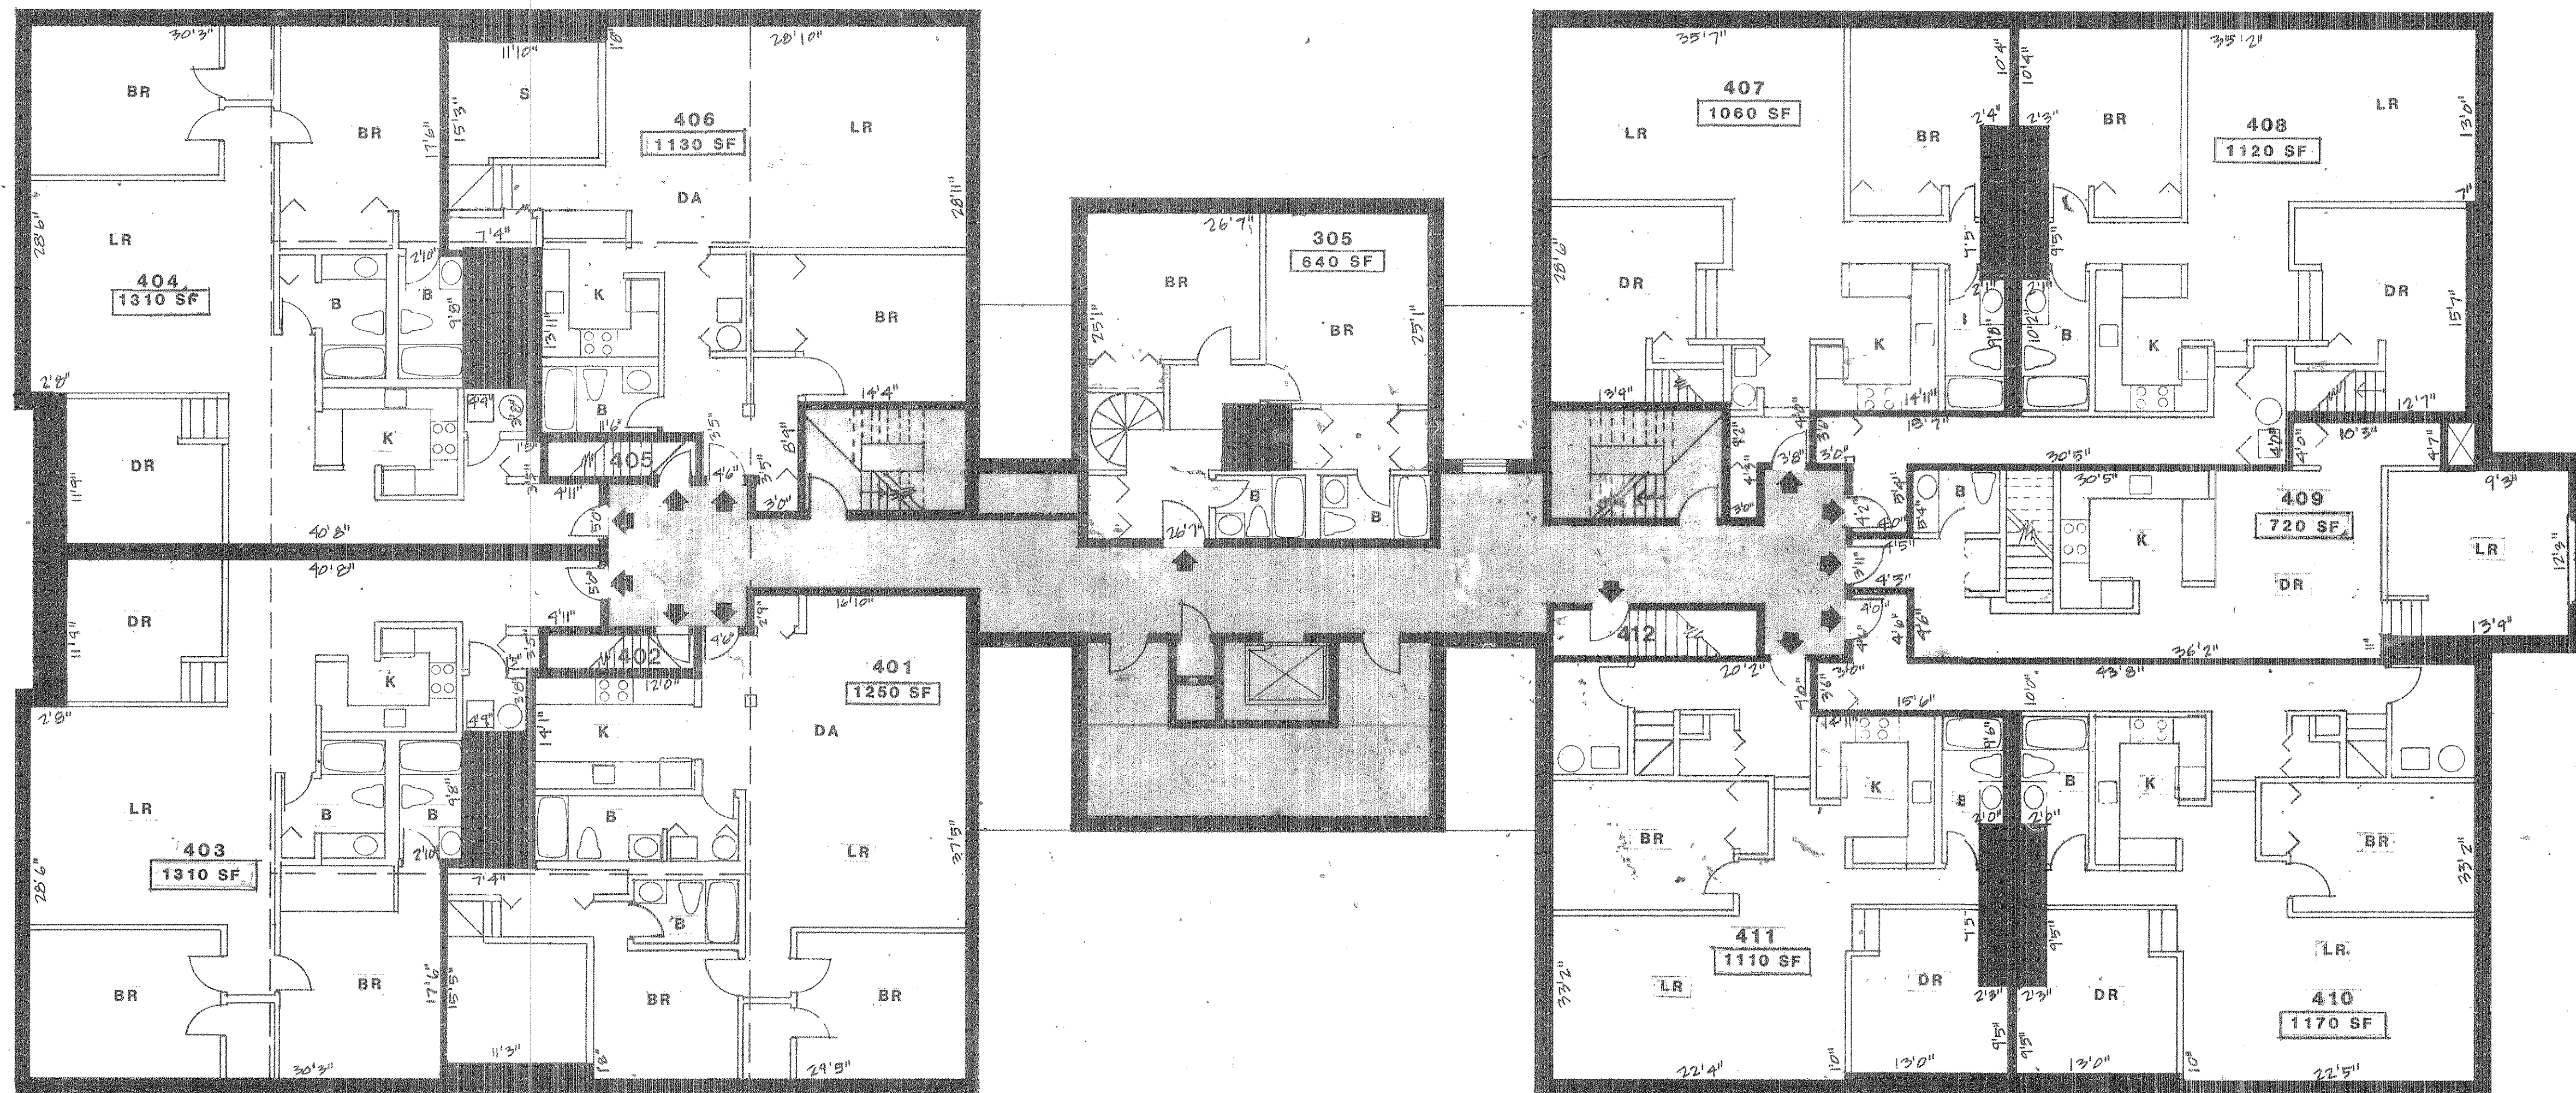


I certify that this plan has been prepared in conformity with the rules and regulations of the Registry of Deeds of the Commonwealth of Massachusetts.

I certify that this plan fully and accurately depicts the layout, location, unit number and dimensions of each of the units in the Locke School Condominium shown herein, as built and in existence on the date hereof.

Peter A. Bullis
Peter A. Bullis
Date 6-19-84
Maurice N. Finegold
Maurice N. Finegold
Date 7-3-84

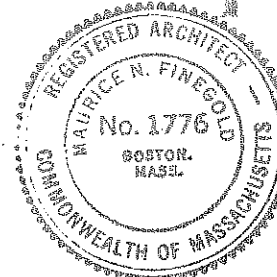

ANDERSON NOTTER FINEGOLD INC.

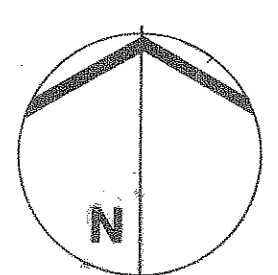




THIRD FLOOR
LOCKE SCHOOL CONDOMINIUM
FORMERLY THE LOCKE SCHOOL, ARLINGTON, MASSACHUSETTS



4

PLAN NUMBER 741(E-078) 1984
RECORDED BOOK 15666 PAGE 566


741-5

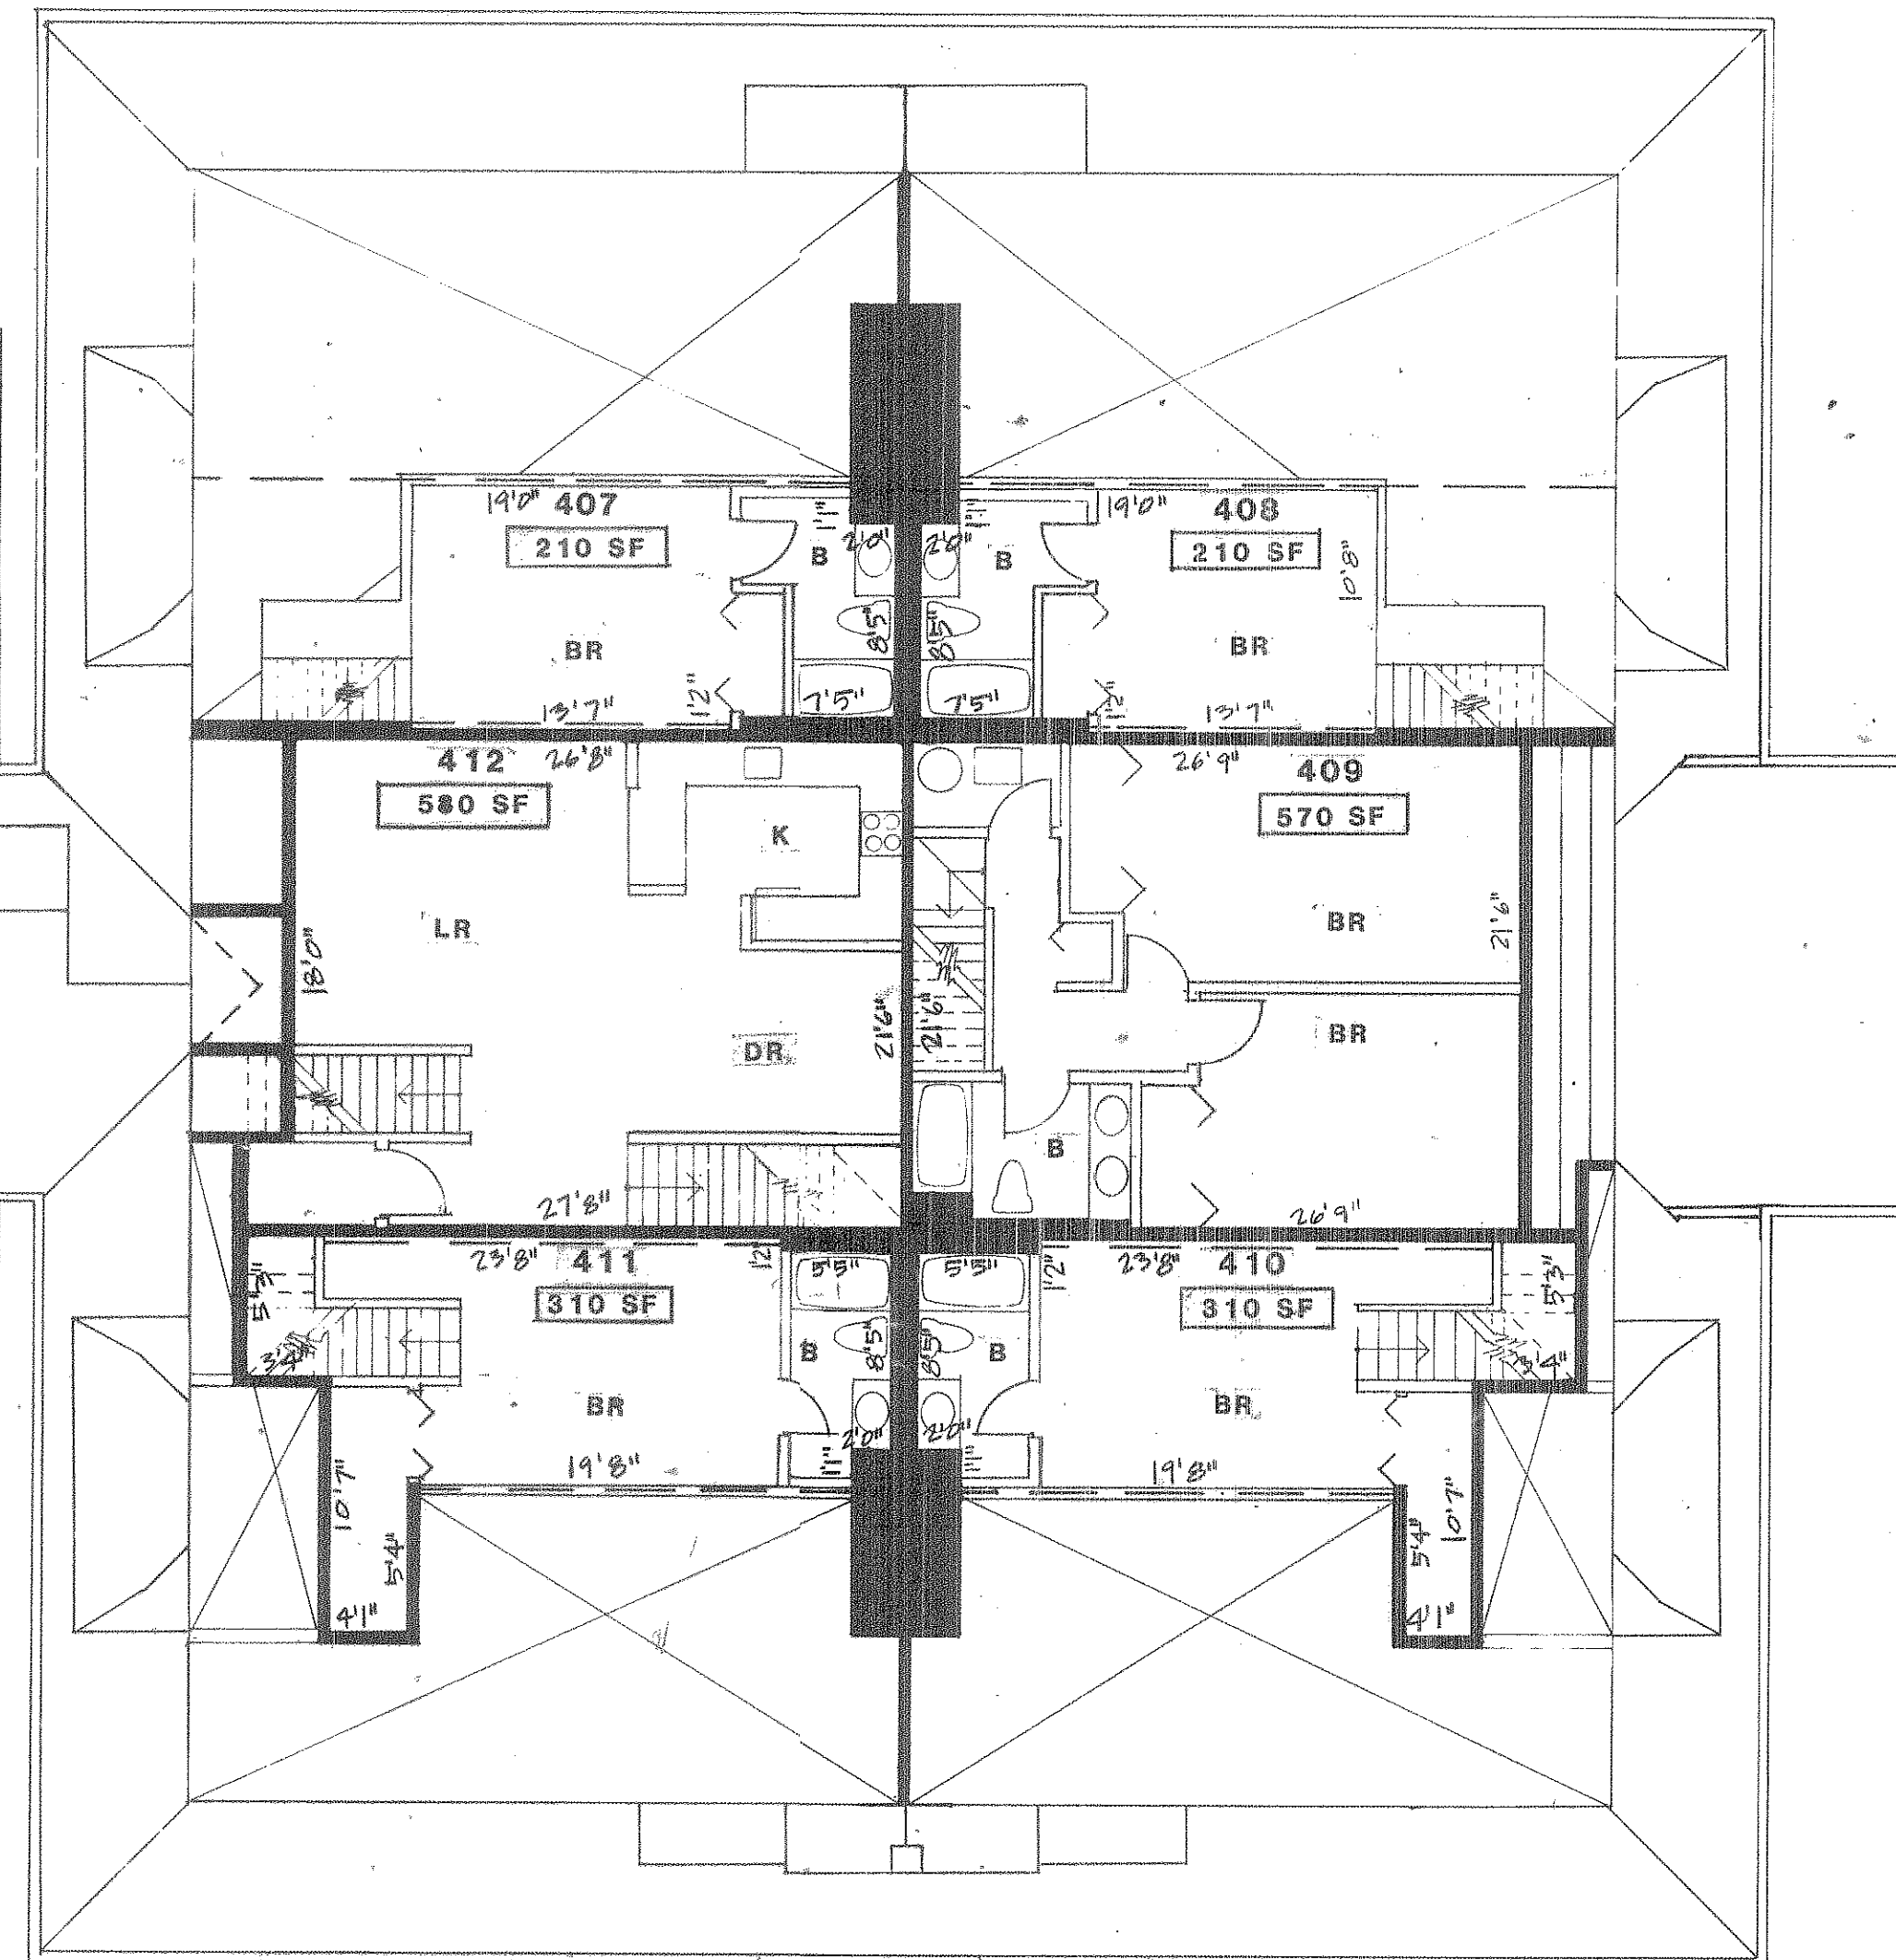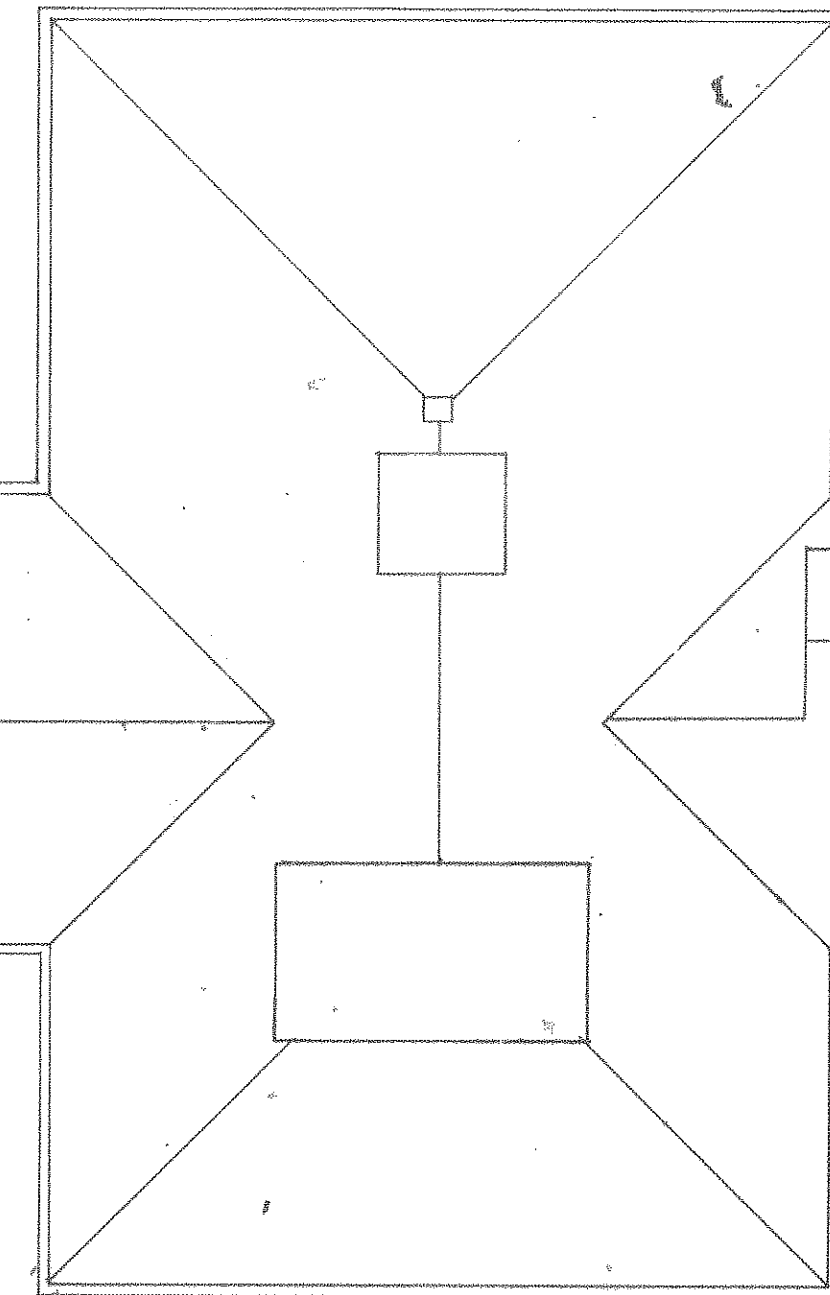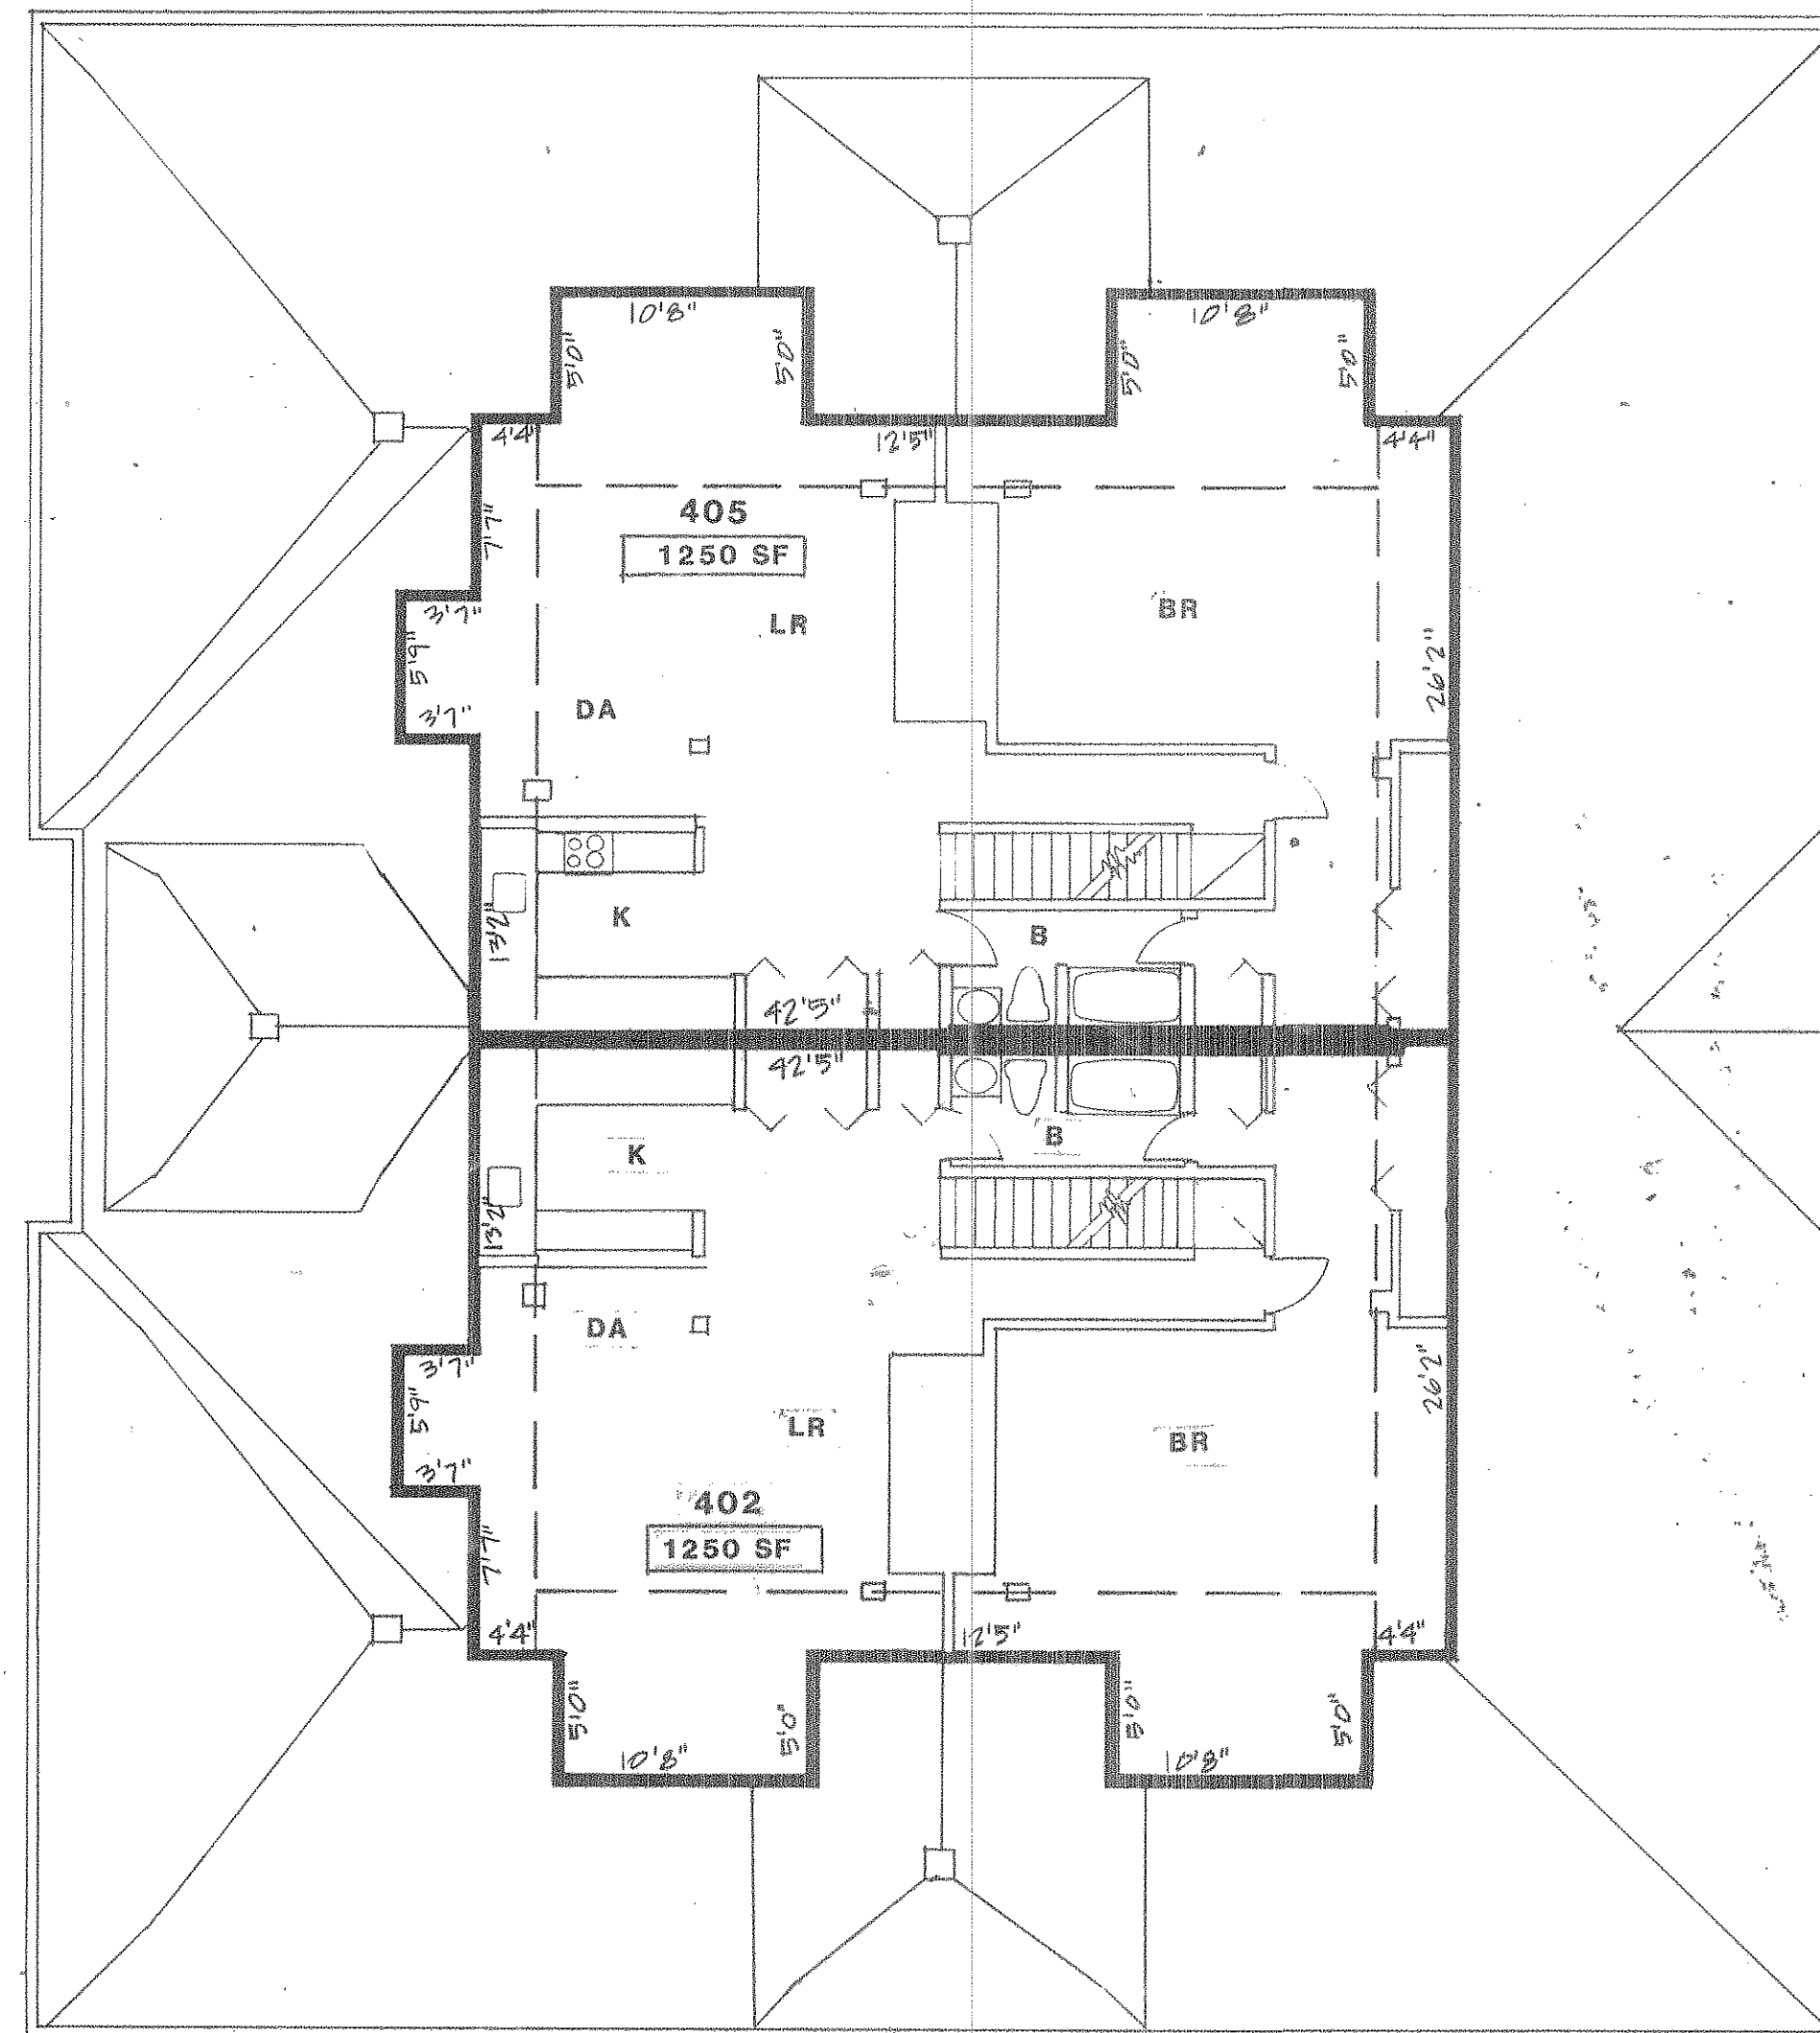


I certify that this plan has been prepared in conformity with the rules and regulations of the Registry of Deeds of the Commonwealth of Massachusetts.

I certify that this plan fully and accurately depicts the layout, location, unit number and dimensions of each of the units in the Locke School Condominium shown herein, as built and in existence on the date hereof.


Peter A. Bullis
 Peter A. Bullis
 6-19-84
 Date

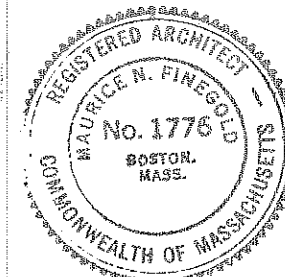


ANDERSON NOTTER FINEGOLD INC.

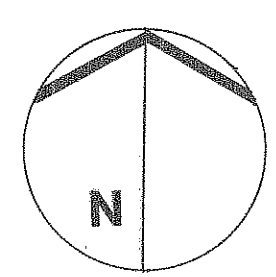

FOURTH FLOOR
LOCKE SCHOOL CONDOMINIUM
 FORMERLY THE LOCKE SCHOOL, ARLINGTON, MASSACHUSETTS

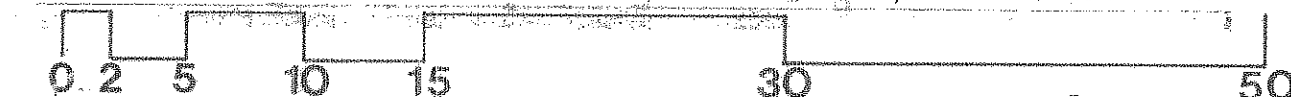

5

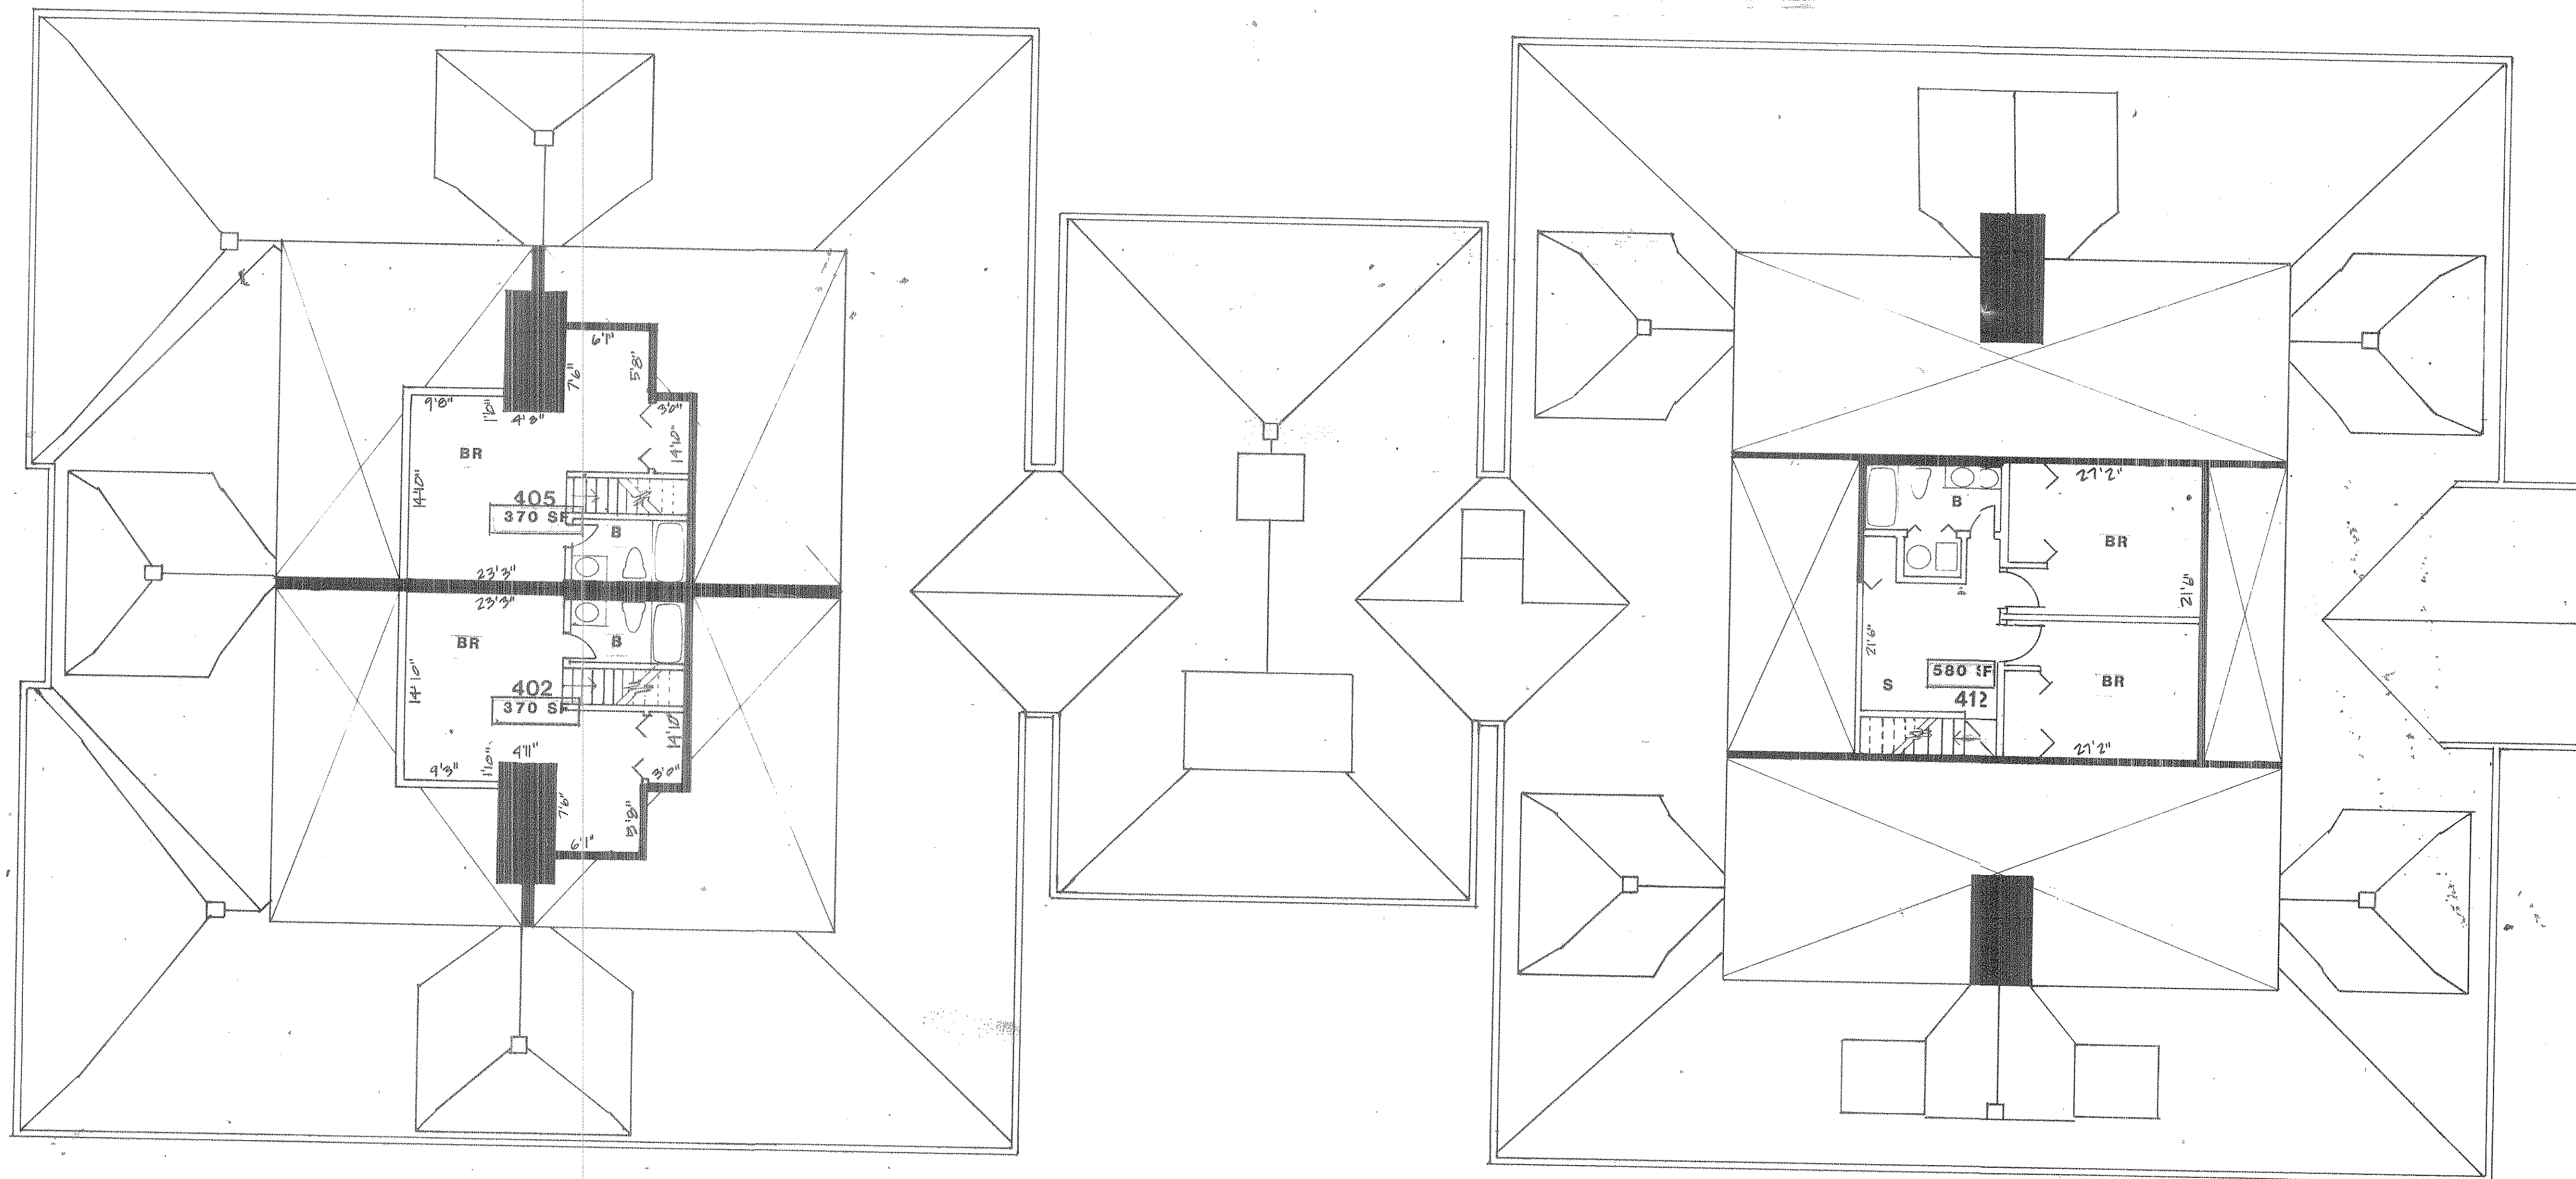


I certify that this plan has been prepared in conformity with the rules and regulations of the Registry of Deeds of the Commonwealth of Massachusetts.


I certify that this plan fully and accurately depicts the layout, location, unit number and dimensions of each of the units in the Locke School Condominium shown herein, as built and in existence on the date hereof.

Peter J. Bull
Peter J. Bull
Maurice N. Finegold
Maurice N. Finegold

6-19-84
Date

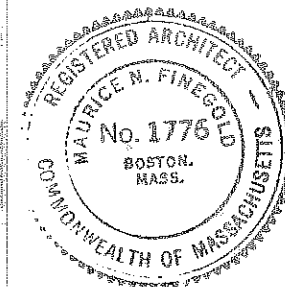


ANDERSON NOTTER FINEGOLD INC.

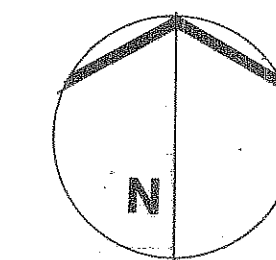


LOCKE SCHOOL CONDOMINIUM
FIFTH FLOOR
FORMERLY THE LOCKE SCHOOL, ARLINGTON, MASSACHUSETTS




6

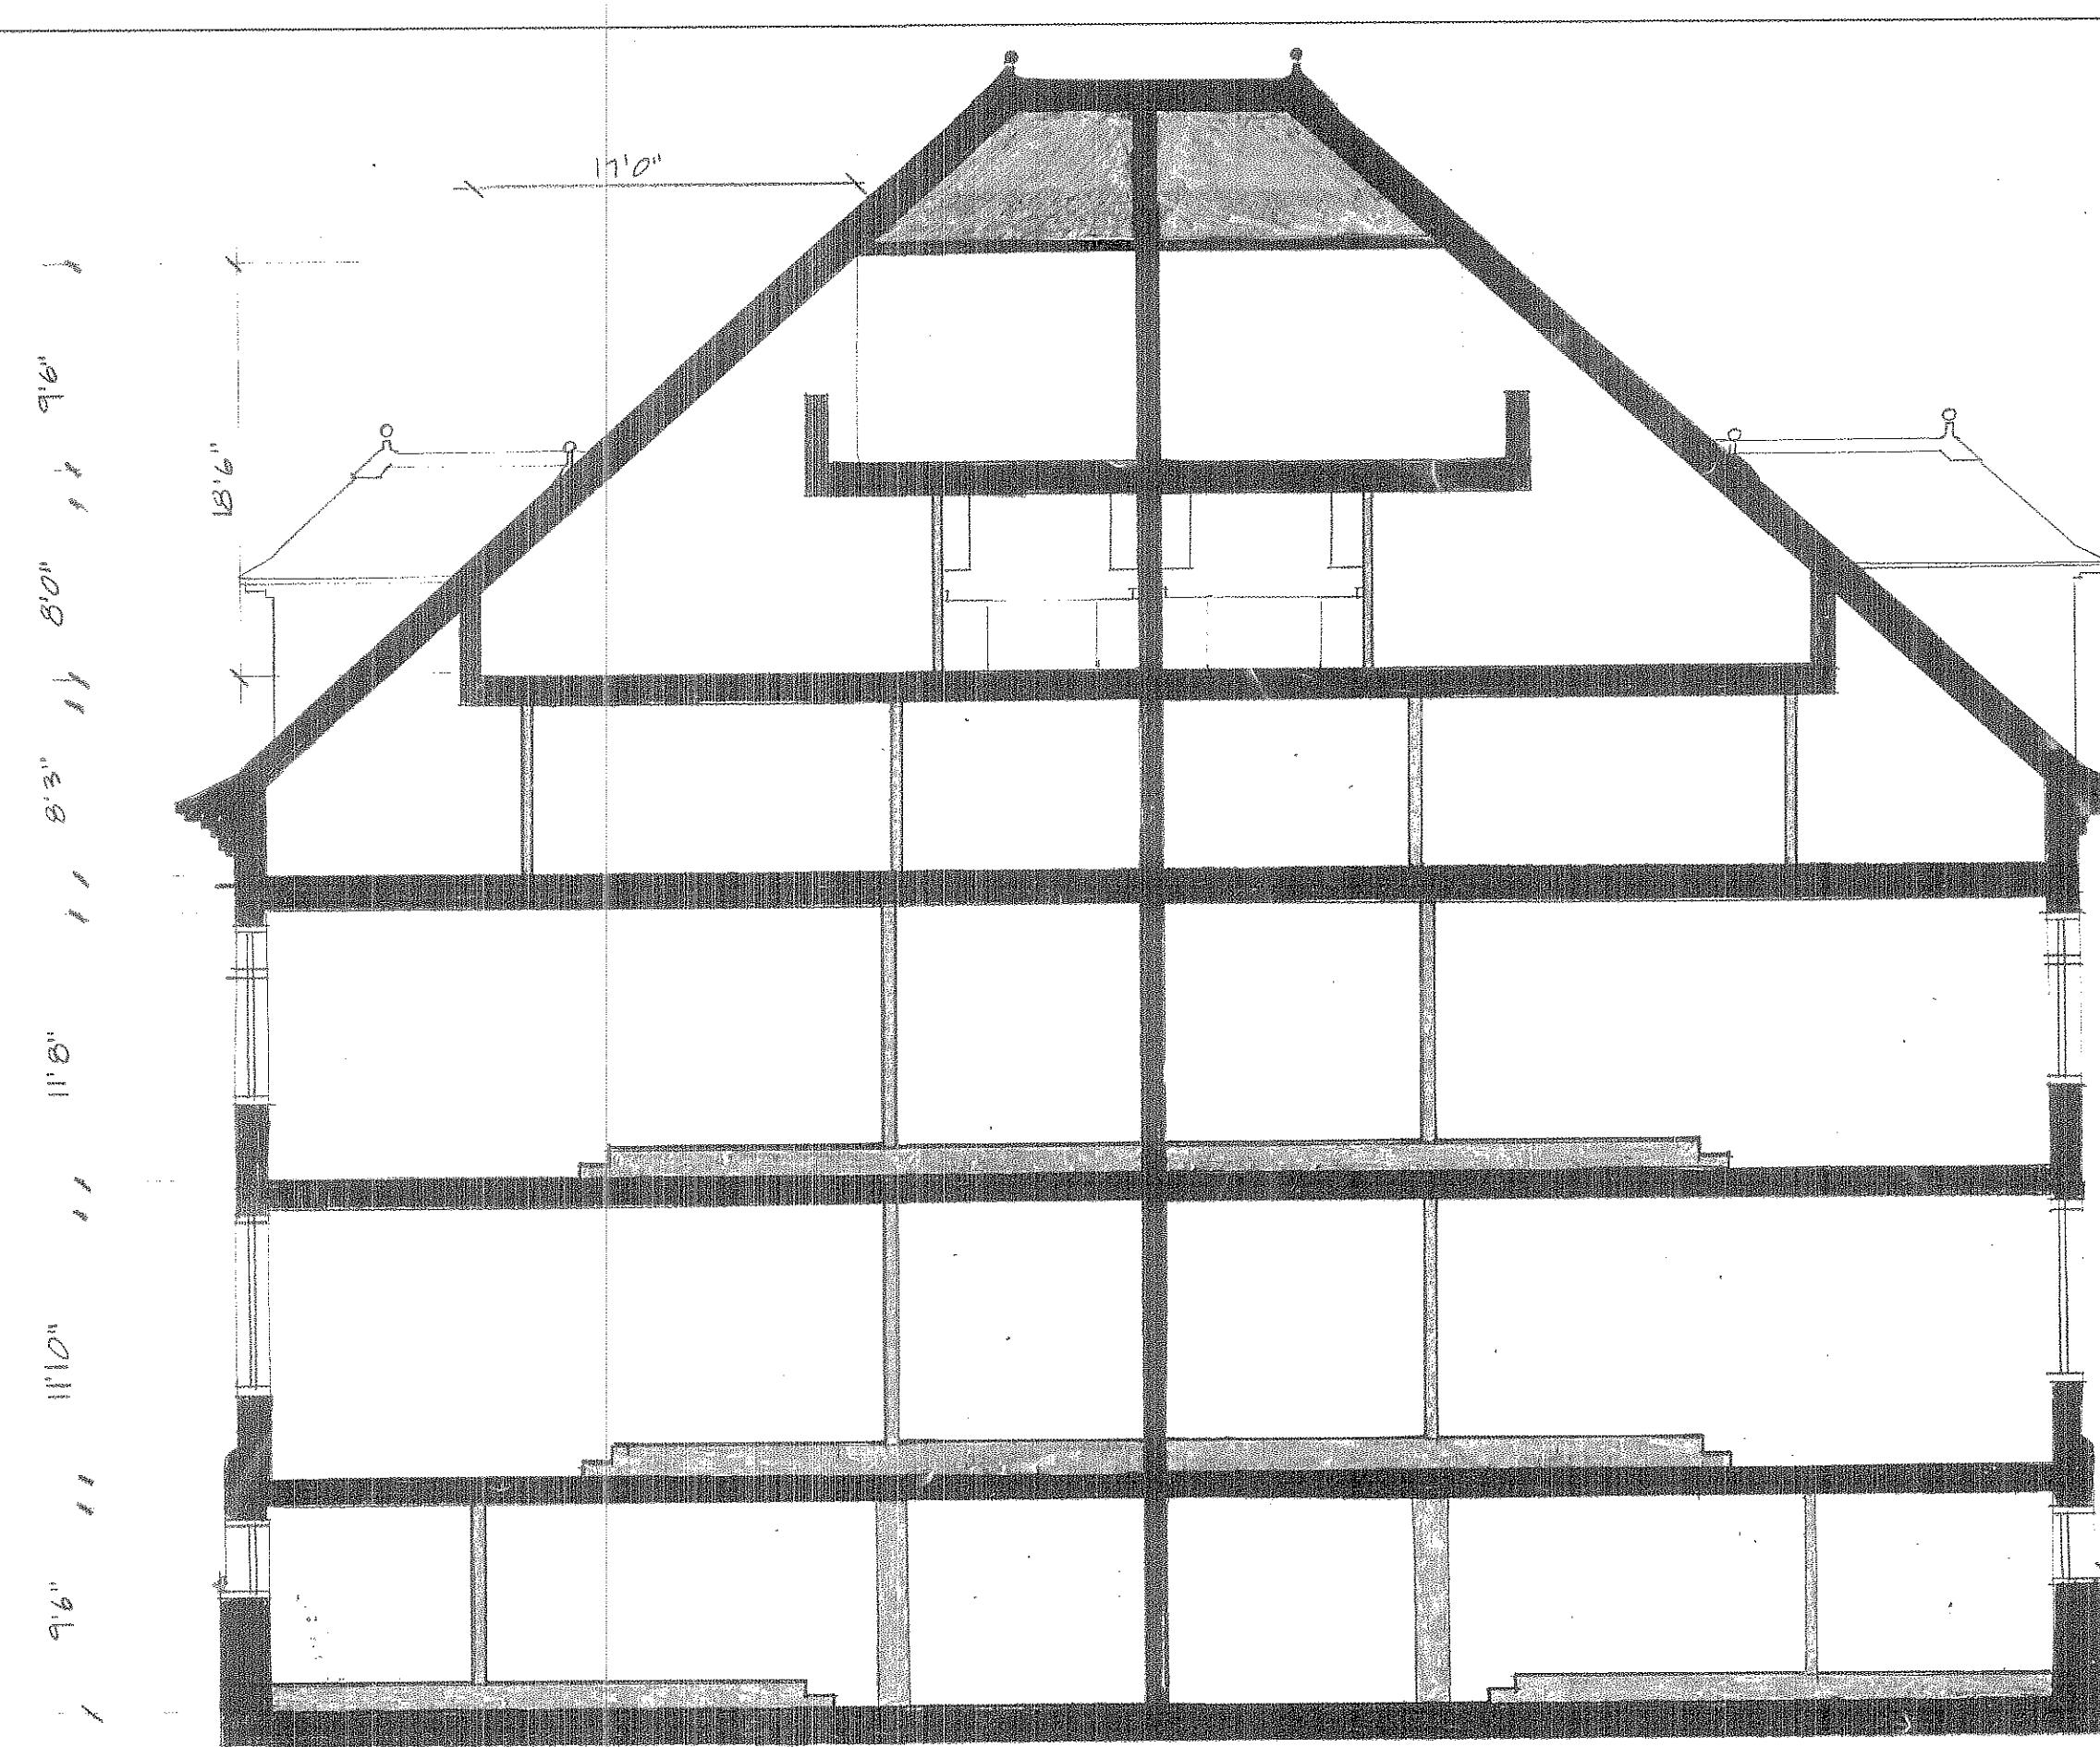

WEST TRANSVERSE SECTION

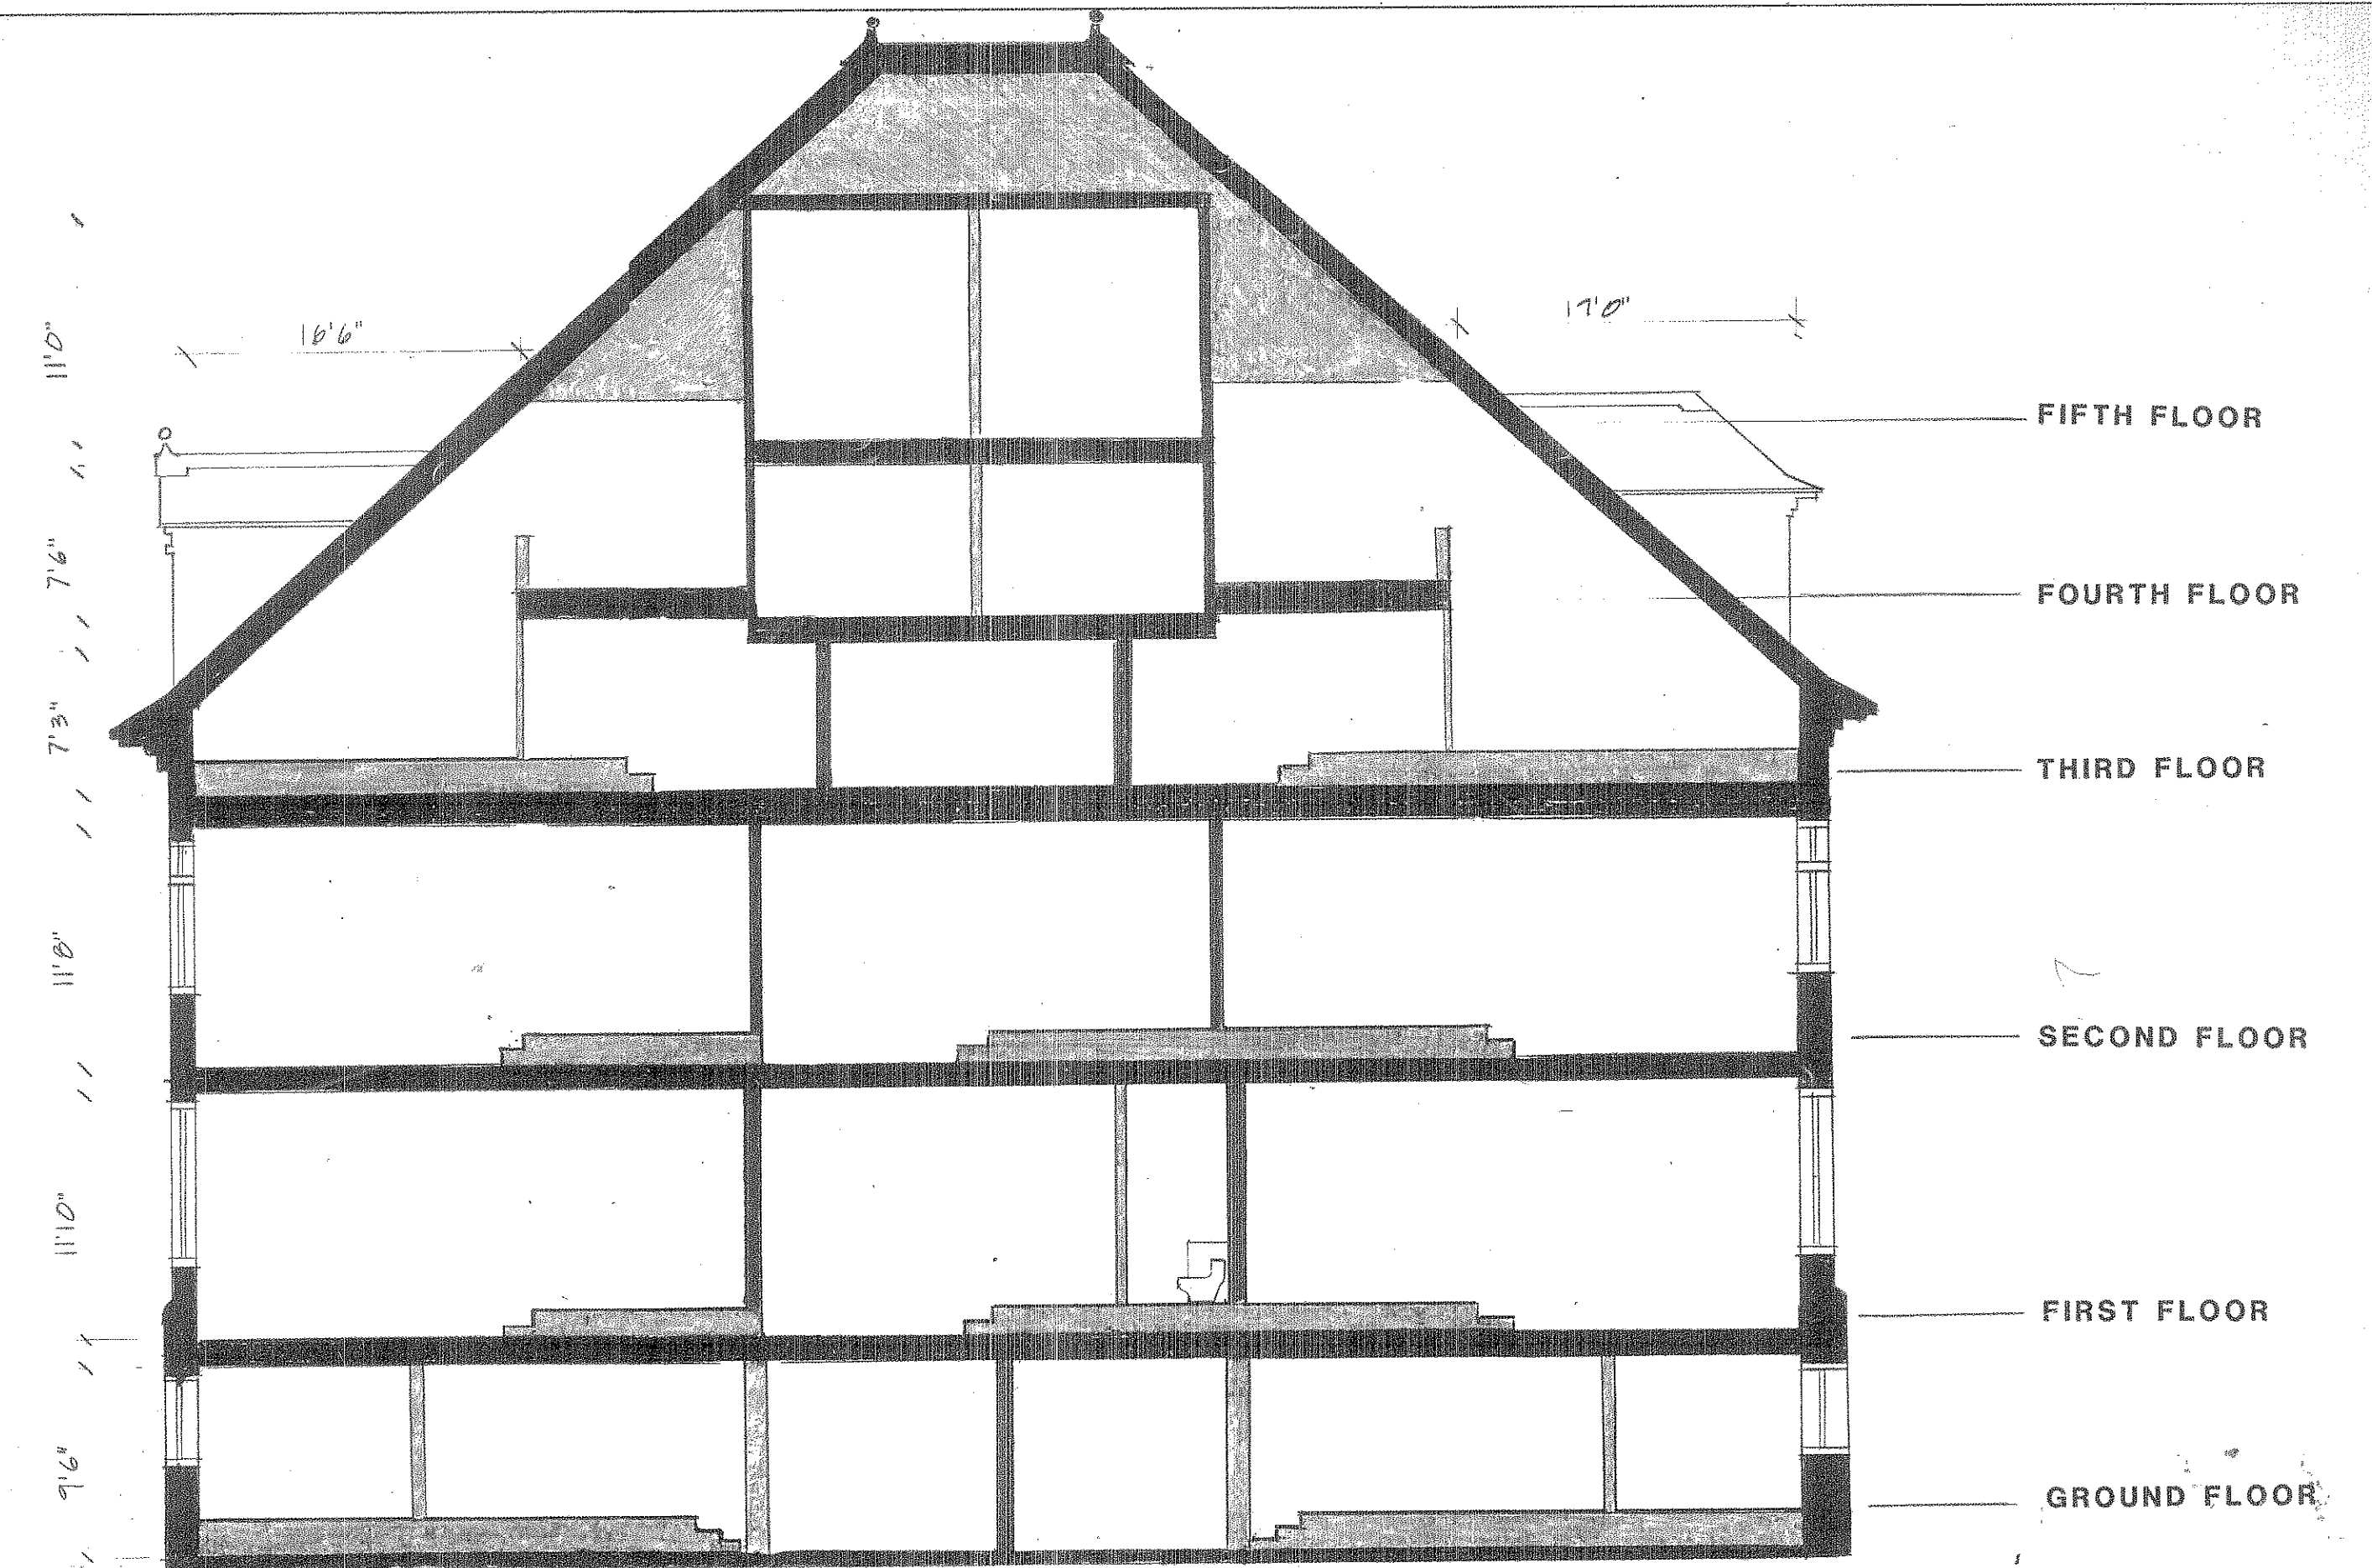

EAST TRANSVERSE SECTION

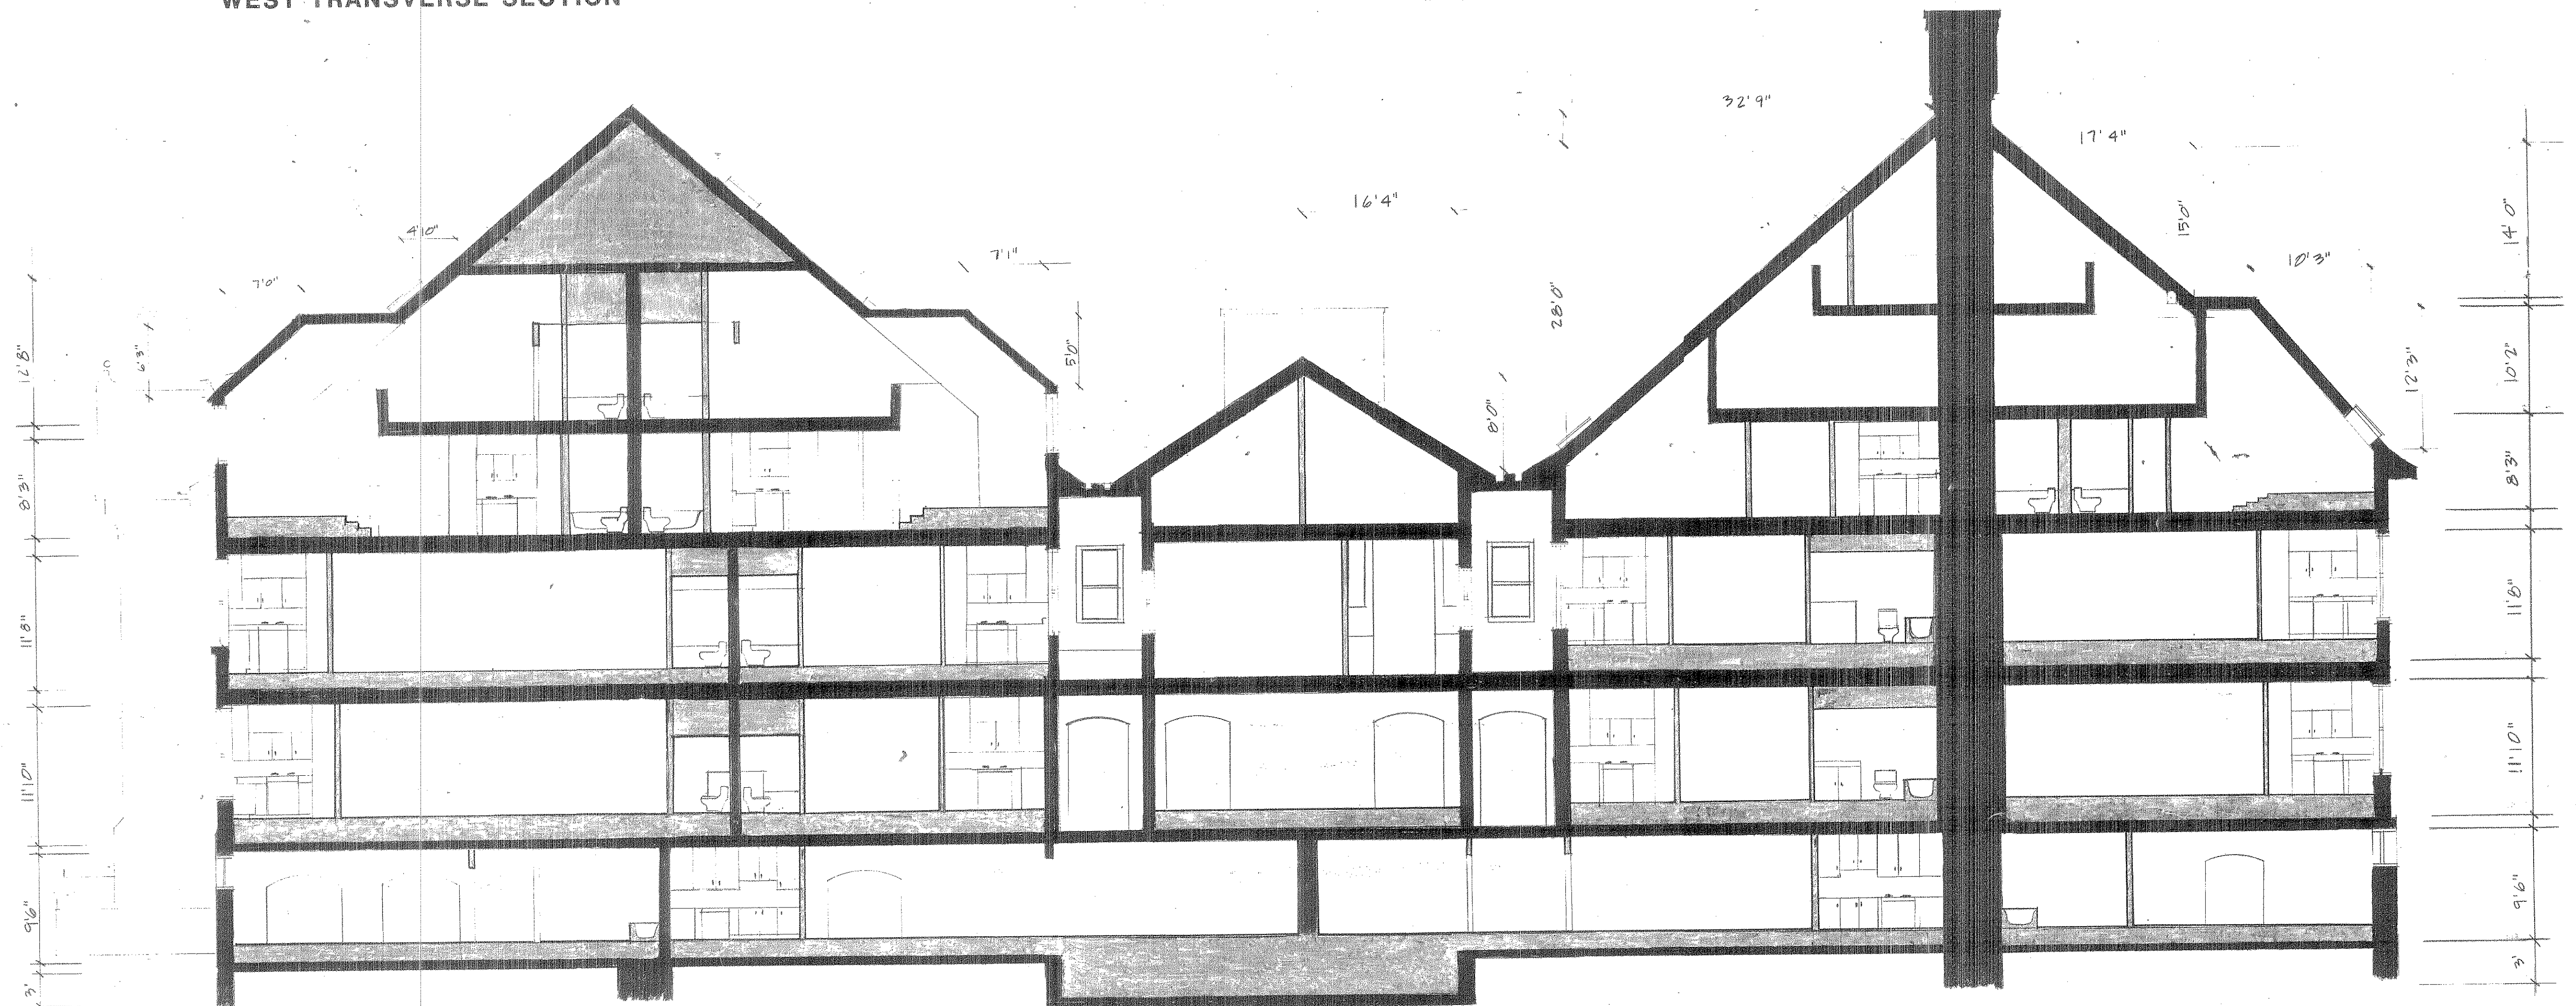

LONGITUDINAL SECTION

PLAN NUMBER 741(H.O.F.S.) 1984
RECORDED BOOK 15666 PAGE 566

I certify that this plan has been prepared in conformity with the rules and regulations of the Registry of Deeds of the Commonwealth of Massachusetts.

I certify that this plan fully and accurately depicts the layout, location, unit number and dimensions of each of the units in the Locke School Condominium shown herein, as built and in existence on the date hereof.

Maurice N. Finegold
Maurice N. Finegold
Date 1/13/84



ANDERSON NOTTER FINEGOLD INC.

SECTIONS
LOCKE SCHOOL CONDOMINIUM
FORMERLY THE LOCKE SCHOOL, ARLINGTON, MASSACHUSETTS

0 2 5 10 15 30 50

7

741-8