

831

MADISON COUNTY SEPTIC TANK AND SEWAGE PERMIT

Permit to Install, Extend or Repair, Septic Tanks and Sewage Systems, with inspection. In accordance covering the same. Passed by Madison County Board of Health. Effective October 15, 1991. This permit is issued to Dan Stroud


of Cameron for the following sewage disposal system on the Premises of (Owner) John Bachdahl Located at Lot # 92 V.C. Ranches in the County of Madison, Montana.

Issued on 15 day of Nov, 1996, being issued for a fee of 105⁰⁰ by the Health Officer as authorized representative for Madison County, Montana.

Ck. No. ~~70768~~ Note 1000 gal concrete tank

Cash _____ Signature Ralph Hamer ph No. 831 Sanitarian

831

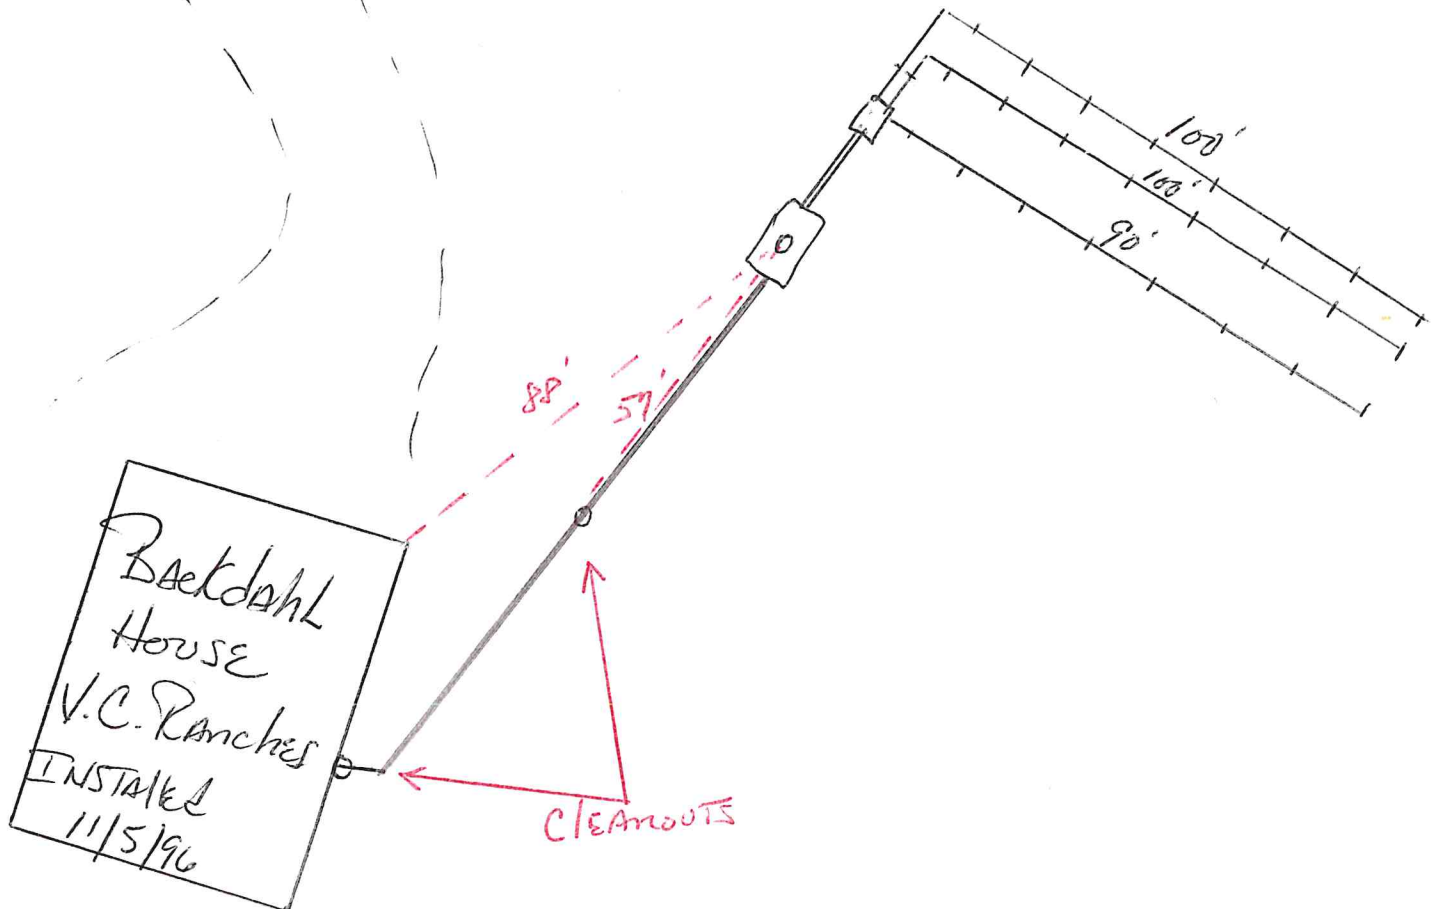

STROUD EXCAVATION
P.O. BOX 208
CAMERON, MT 59720

PERMIT NO. 831

APPLICATION FOR WASTEWATER TREATMENT SYSTEM PERMIT MADISON COUNTY

Complete and return this application to the Madison County Health Department. The Department shall respond within (10) working days for individual systems or within 30 days for other types of systems. Response from the Department shall be in the form of a valid permit for and approved application or a written denial for an unapproved applic.
PART A

*Backdahl, John
Enns - Virginia City Ranches, Lot 92*

1. Name of Property Owner John Backdahl -
Address c/o Ron Goelze
Box 904, Enns

2. If the person completing this application is not the owner, give
Name of Applicant Ron Goelze
Address _____
Phone # _____

3. Legal description and size of property: 1/4 1/4, Sec. _____, Township _____
Range _____, being _____ acres.

4. Authorized Road Address: Lot #92 V.C. Ranches
Please submit directions to locating property.

5. Name of Subdivision (if applicable): _____
Lot, Tract or Parcel: _____
Block: _____

6. Type of Structure(s) to be served:
 One single family dwelling
 Other (please describe) _____

7. Number of bedrooms in dwelling: 2
Estimated volume of wastewater produced: _____

8. Name of licensed installer: Dan Stroud

9. Does the property have Certificate of Subdivision Plat Approval:
 Yes and # _____ or No (See Part C)

B. Does the property have any exemptions noted on plat
 Yes _____ (Type of Exemption)
 No

10. Is the property presently being reviewed under the Sanitation in Subdivision Act:
 Yes or No