


SEPTIC SYSTEM DIMENSIONS		
#	A	B
1	130.6	31.9
2	173.6	52.4
3	225.1	102.9
4	225.8	107.9
5	229.0	115.3
6	177.3	62.9
7	177.9	70.1
8	180.4	78.8
9	128.6	42.9
10	130.8	52.3
11	131.3	60.5

ELEVATION	PROPOSED	AS-BUILT
INV. @ HOUSE		
SEPTIC TANK INLET INV.	104.0	105.1
SEPTIC TANK OUTLET INV.	101.0	101.7
		101.4
BOTTOMS		
ROW #1	100.0	100.0
ROW #2	99.4	99.7
ROW #3	98.8	99.2

RECEIVED
DEC 3 - 2007
WWHD

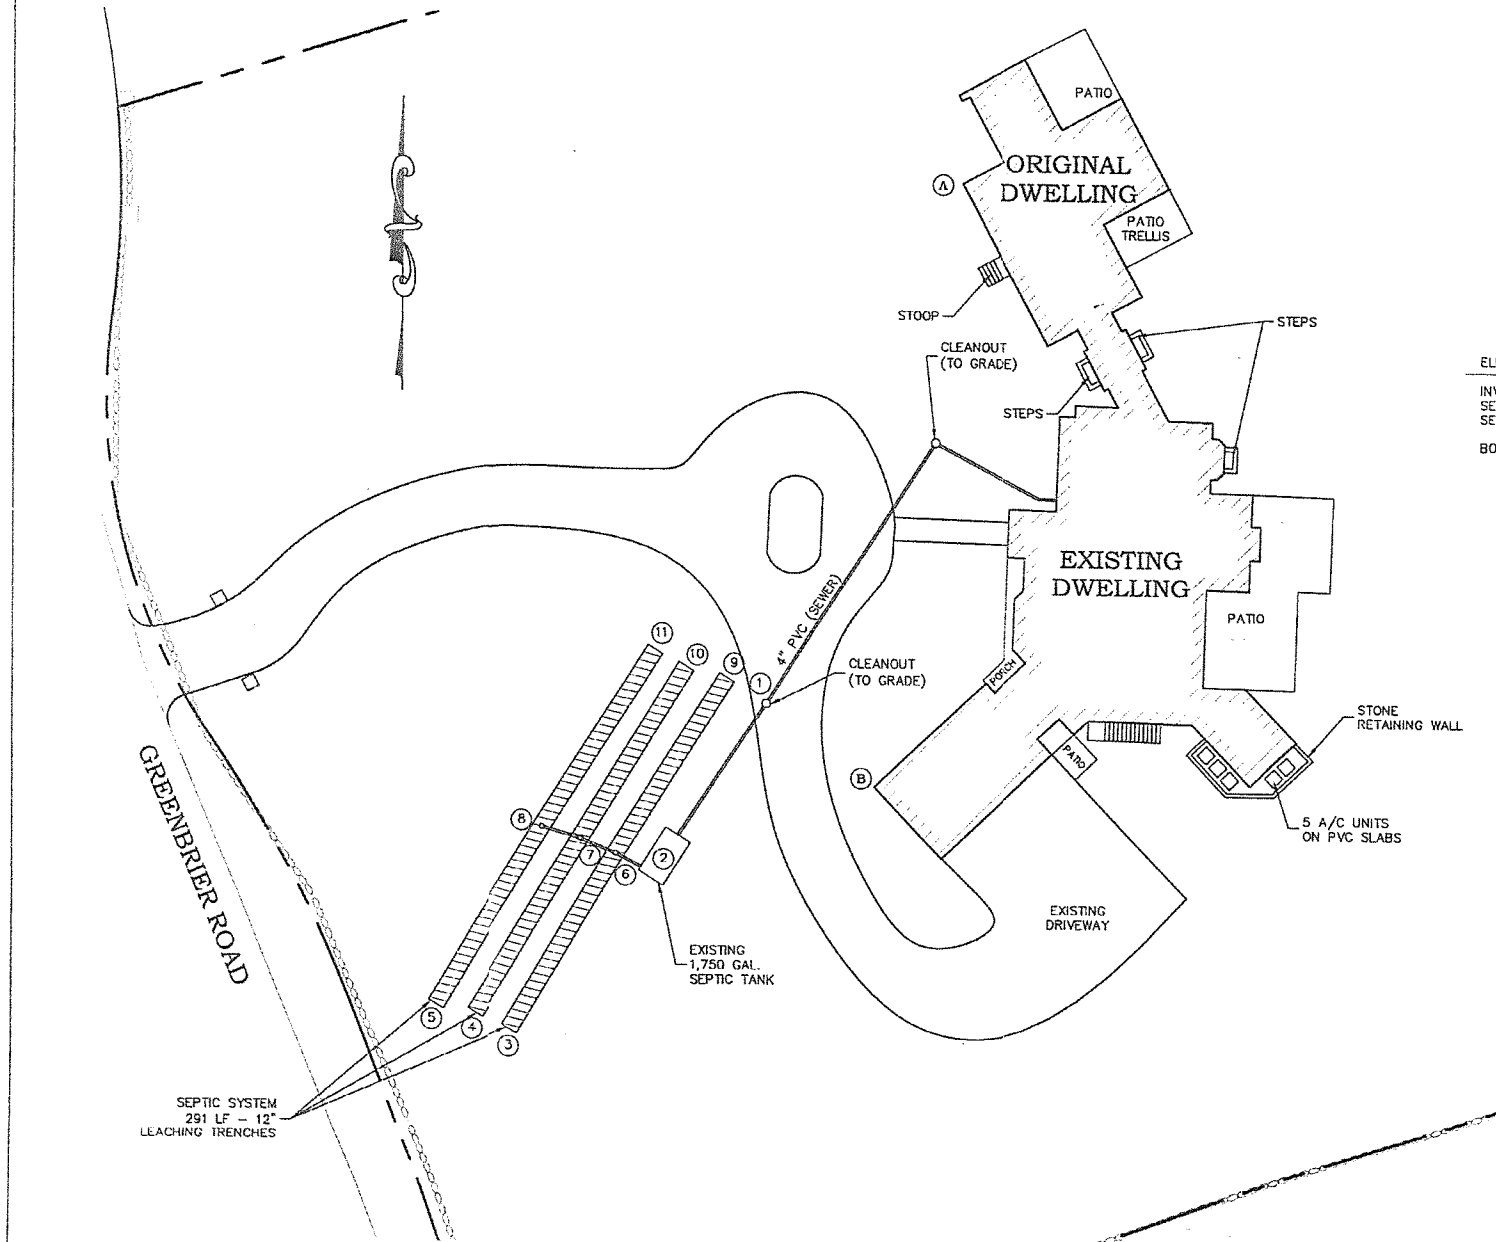

No.		Date	REVISION DESCRIPTION	THIS SURVEY AND MAP HAS BEEN PREPARED IN ACCORDANCE WITH SECTIONS 20-202B-4 TO 20-202B-5 OF THE REGULATIONS OF CONNECTICUT STATE AGROLOGISTS. IF IS A MAP BASED ON A DEPENDENT SURVEY CONFORMING TO HORIZONTAL ALIGNMENT CLASS A-1 TO THE BEST OF MY KNOWLEDGE AND BELIEF THIS MAP IS SUBSTANTIALLY CORRECT AS NOTED HEREON. <i>Fred D'Amico</i> FRED D'AMICO CORN. P.E., L.S. 10833	D'AMICO ASSOCIATES SURVEYING & ENGINEERING CONSULTANTS 9 FAIR ROAD WESTPORT, CONNECTICUT 06894 P: (203) 811-3181 F: (203) 811-0246 dmicomail@comcast.net	Job No. 2019 Scale 1"=20'	Dwn By AV Date 11/19/07	Project Name COASTAL CONSTRUCTION 9 GREENBRIER ROAD WESTPORT CONNECTICUT	Drawing Title AS-BUILT PLAN OF SEPTIC SYSTEM
-----	--	------	----------------------	--	---	------------------------------------	----------------------------------	--	--

P:\2019\2019\2019 Sep AB.dwg 11/25/2007 8:54:49 AM EST