


NOTES

- 1.) THIS MAP HAS BEEN PREPARED PURSUANT TO THE REGULATIONS OF CONNECTICUT STATE AGENCIES SECTIONS 20-300b-1 THRU 20-300b-20 AND "THE STANDARDS FOR SURVEYS AND MAPS IN THE STATE OF CONNECTICUT" AS ADOPTED BY THE CONNECTICUT ASSOCIATION OF LAND SURVEYORS, INC. ON SEPTEMBER 26, 1996. THE PERIMETER SURVEY IS BASED ON A "DEPENDENT RESURVEY" OF LOT No. 6 AS DEPICTED ON THE MAP REFERENCED IN NOTE 2. BELOW, CONFORMING TO HORIZONTAL CLASS "A-1".
- 2.) REFERENCE IS MADE TO THE FOLLOWING MAP ON FILE IN THE EASTON TOWN CLERK'S OFFICE:
R.M. 1393 - "EDEN HILL ESTATES"; SUBDIVISION MAP; PREPARED FOR RAFFIE ARYEH;
EASTON, CT., APRIL 9, 1997; REVISED TO MARCH 25, 1998;
SCALE: 1"=100'; PREPARED BY OCHMAN ASSOCIATES, INC.
- 3.) THE LOCATION OF UNDERGROUND UTILITIES, IF ANY, IS UNKNOWN.
- 4.) THE NORTH ARROW BEARING IS BASED ON THE MAP REFERENCED IN NOTE 2.
- 5.) ALL ELEVATIONS IN SEPTIC SYSTEM AREA ARE TO TOP OF PIPE UNLESS OTHERWISE NOTED.
- 6.) THE VERTICAL ACCURACY OF THE SURVEY CONTROL USED TO ESTABLISH THE ELEVATIONS DEPICTED HEREON IS CLASS "V-3" AS DEFINED IN SECTION 20-300b-11 OF THE MINIMUM STANDARDS FOR SURVEYS AND MAPS IN THE STATE OF CONNECTICUT.
- 7.) THE SOLE PURPOSE OF THIS "AS-BUILT" PLAN IS TO SHOW THE HORIZONTAL AND VERTICAL LOCATION OF THE SEPTIC SYSTEM AS OF THE DATE SHOWN. THE SURVEYOR MAKES NO CERTIFICATION AS TO THE CONFORMANCE TO ANY PROPOSED PLANS, LOCAL AND/OR STATE HEALTH CODES OR REGULATIONS.

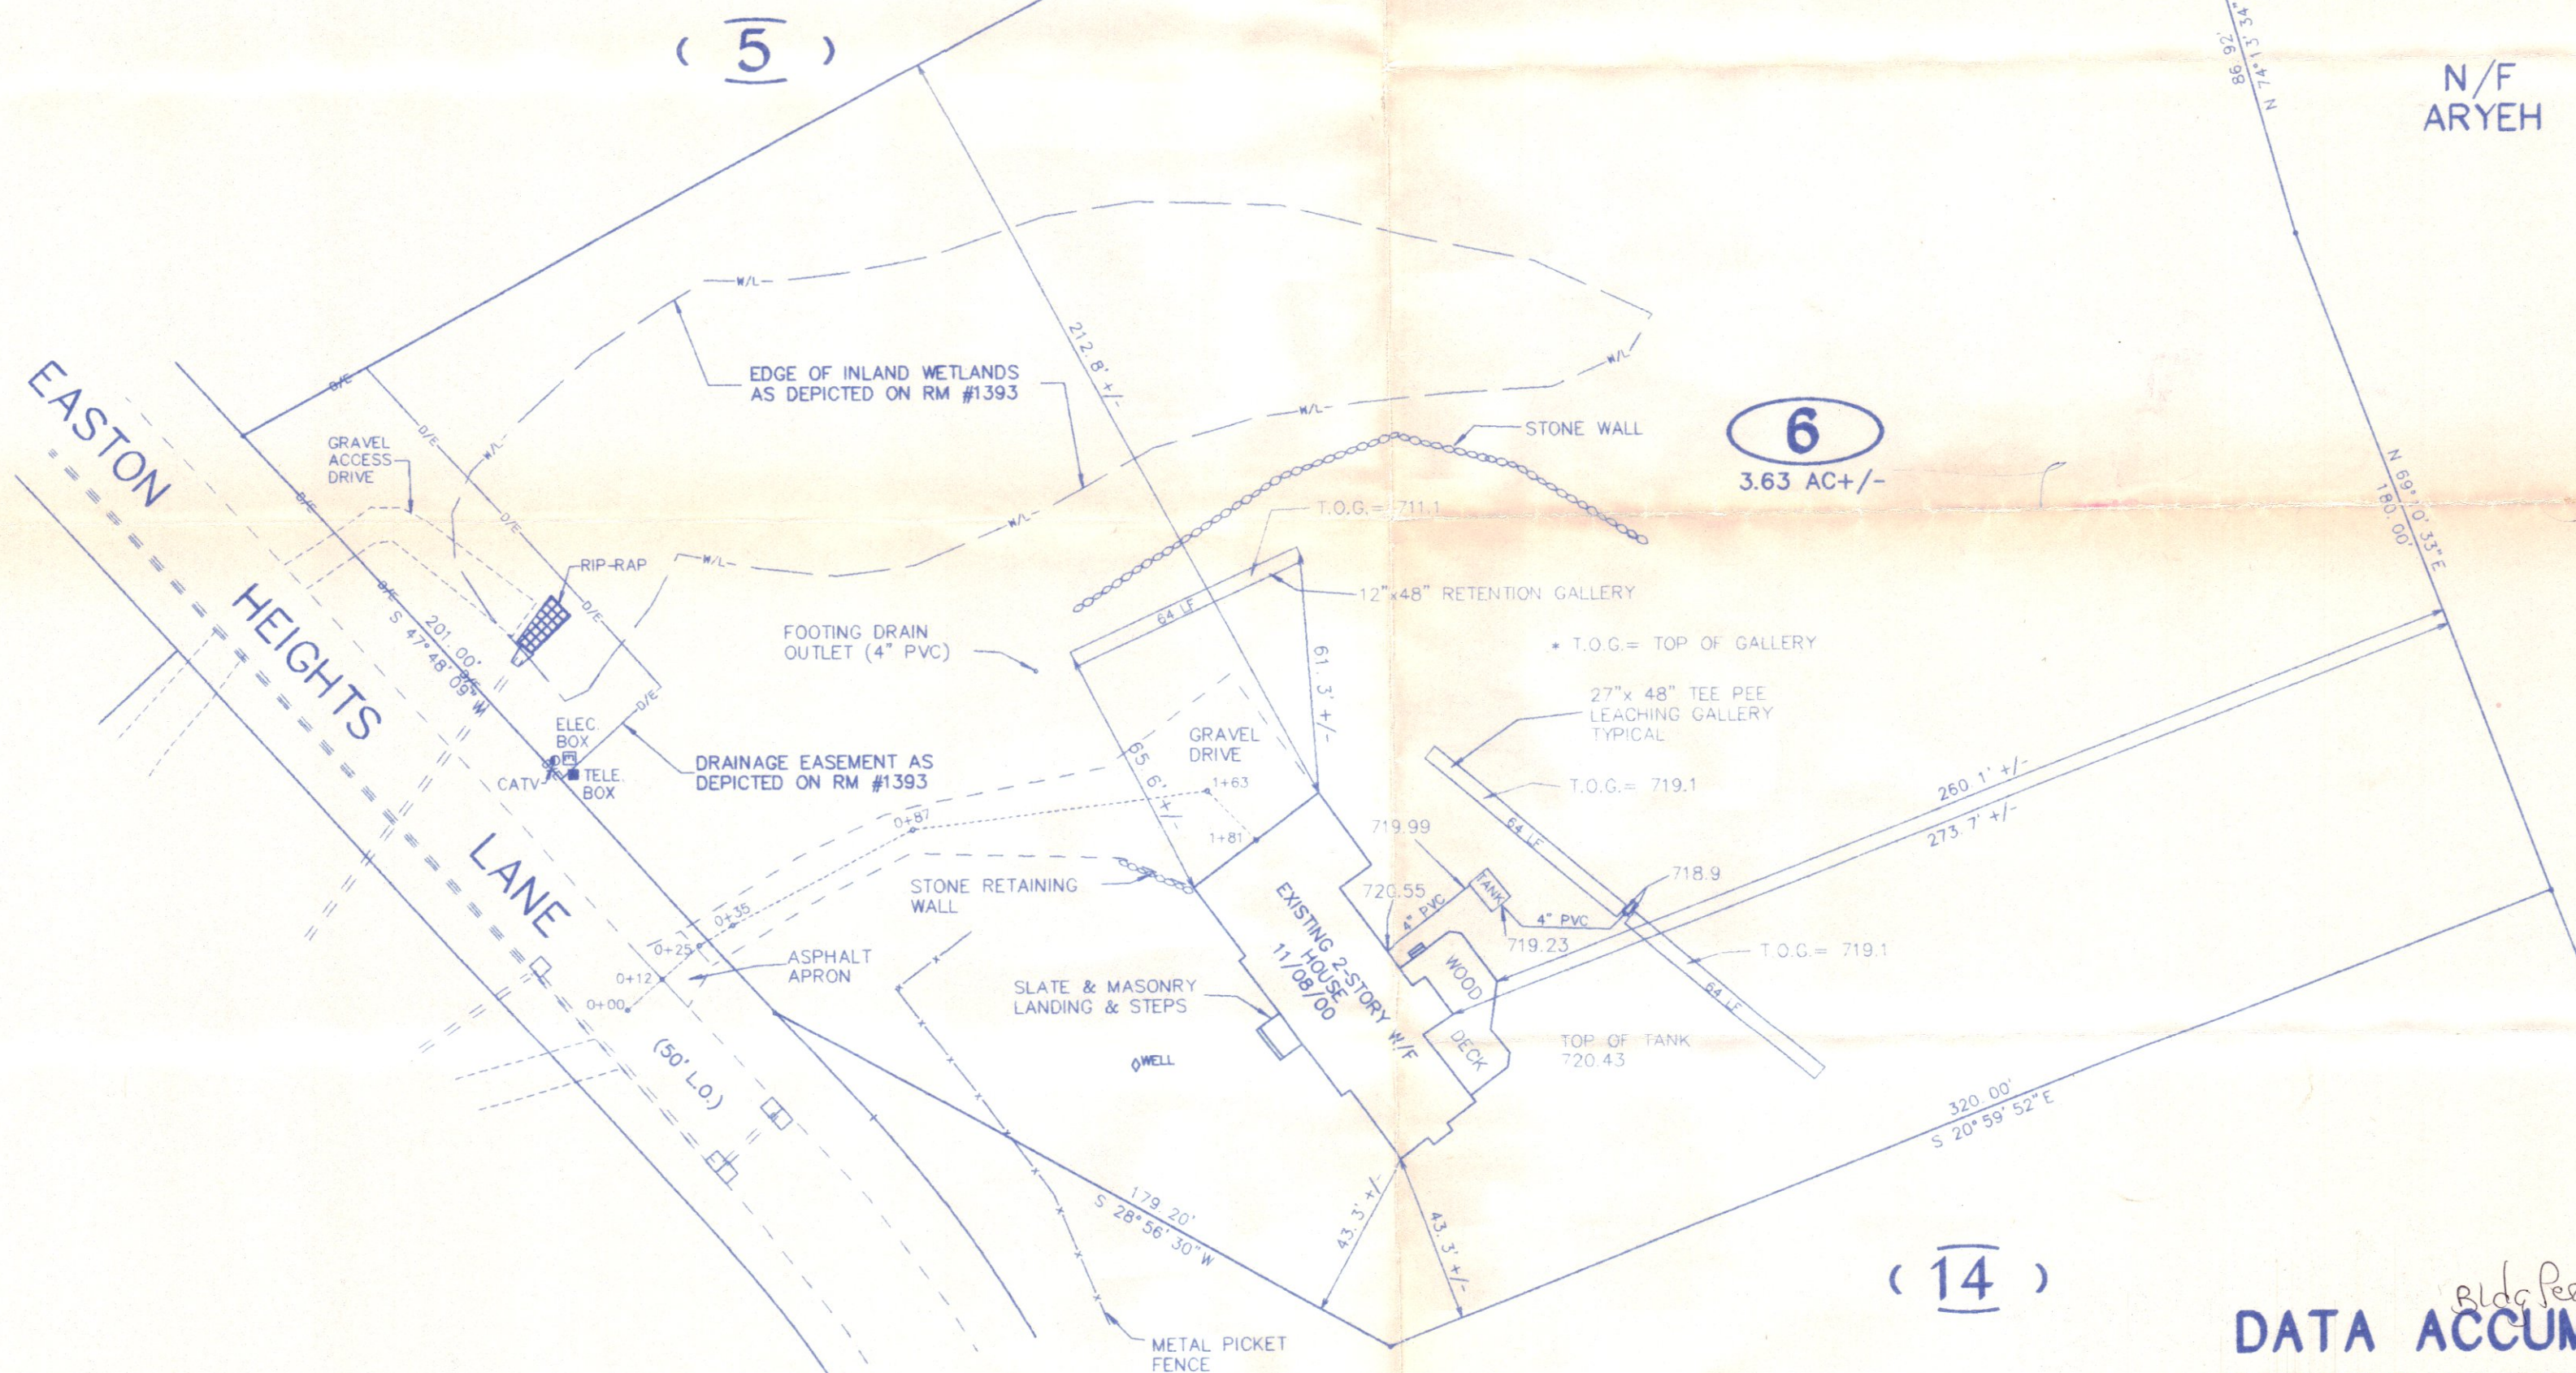

SIGHTLINE DISTANCE
NORTH/EAST = 280' +/-
SOUTH/WEST = 300' +/-

DRIVEWAY AS-BUILT	
SEGMENT	GRADE
0+00 - 0+12	3.6%
0+12 - 0+25	4.7%
0+25 - 0+35	9.0%
0+35 - 0+87	9.0%
0+87 - 1+63	0.3%
1+63 - 1+81	1.3%

THIS MAP IS NOT VALID UNLESS
EMBOSSSED WITH THE SEAL OR
AFFIXED WITH THE LIVE STAMP
OF THE SIGNATORY

TO MY KNOWLEDGE AND BELIEF, THIS MAP IS
SUBSTANTIALLY CORRECT AS NOTED HEREON.

Charles S. Spath Sr.
CHARLES S. SPATH SR. CT L.S. #8176

The system, as shown on the "As-Built" appears to conform in general to the proposed plan which was approved by the Easton Health Dept.

David S. Bjorklund Jr. CT P.E. #11361

PREPARED FOR:
SHERWOOD HOMES, L.L.C.

REVISED: 5/19/00

RECEIVED

DEC 0 3 2000

TOWN OF EASTON
☐ BUILDING ☐ HEALTH

Bldg Permit #8304
**DATA ACCUMULATION PLAN
SEPTIC & DRIVEWAY AS-BUILT
LOT No. 6
#35 EASTON HEIGHTS LANE
EASTON, CONNECTICUT**

NOVEMBER 9, 2000

SCALE: 1"=40'

40 30 20 10 0 40 80

SPATH-BJORKLUND ASSOCIATES, INC.
Consulting Engineers & Surveyors
MONROE, CONNECTICUT

SM 998A

Septic As-built Lot 6 - 4367 [0.19] PF: 8398 406 13-Nov-00 02:43 PM / EASTON-8398