




NOTES:

- This survey and map has been prepared in accordance with the Sections 20-300b-1 through 20-300b-20 of the Regulations of Connecticut State Agencies - "Minimum Standards for Survey and Maps in the State of Connecticut" as endorsed by the Connecticut Association of Land Surveyors, Inc. It is an Improvement Location Survey based upon a Dependent Resurvey and conforms to Horizontal Accuracy Class A-2.
- Reference is made to the following maps on file in the Fairfield Town Clerks Office:
 - RM #4632 - "Subdivision for Jacob H. & Joanna A. Witzke, Fairfield, Conn., May 12, 1976, Rev. Apr. 1977, Corrected Distance" Prepared by The Huntington Company.
- Reference is made to the following deeds:
 - Vol.365 Pg.82 - Drainage Easement
- The underground utilities shown, if any, have been located from visible field survey information. The surveyor makes no guarantees that the underground utilities shown comprise all such utilities in the area either in service or abandoned. The surveyor further does not warrant that the underground utilities shown are in the exact location indicated although the surveyor does hereby declare that they are located as accurately as possible from information available. The surveyor has not physically located the underground utilities.
- Property is located in FEMA Zone X & A. Per Flood Insurance Rate Map, Community Panel #090007 0001 G, Revised October 6, 1998, panel 1 of 11.
- Property to be served by public water and septic system.
- According to map J-4 & J-5 of the "Designated Inland Wetlands & Water Courses of the Town of Fairfield" this property does contain inland wetland "Regulated Area" as defined in Section 2.1.27 of the Inland Wetlands and Watercourses Regulations of the Town of Fairfield.
- Wetlands shown as flagged in the field by Environmental Planning Services, Michael S. Klein, Soil Scientist on 9-28-06.
- Contours shown per Field Topographic Survey.
- Reference is hereby made to Connecticut General Statute 8-13a, as amended, with regard to existing structures three or more years old.
- Total Lot Area = 781,642± sf = 17.94± Ac
 -50,848± sf = 1.17± Ac (Area in Easton)
 730,794± sf = 16.76± Ac Total Area in Fairfield (CL&P Easement)
 -170,752± sf = 3.92± Ac
 NET Lot Area = 623,042± sf = 14.30± Ac
- Total Area of Wetlands = 489,638± sf = 11.24± Ac
 Total Regulated Area = 171,254± sf = 3.93± Ac
 Total Area of Wetlands + Regulated Area = 660,892± sf = 15.17± Ac

RESIDENCE AAA DISTRICT		MINIMUM REQUIRED	EXISTING	PROPOSED	AS BUILT
		MAXIMUM ALLOWED	CONDITIONS	CONDITIONS	CONDITIONS
Minimum Lot Area		87,120	623,042±	-	-
Minimum Square On Lot		200	200±	-	-
Minimum Lot Frontage		20	581.87	-	-
MINIMUM SETBACK					
Setback From Street Line		60	32.9±	-	-
Setback From Side Property Lines - One Story		60	-	-	-
Setback From Side Property Lines - More Than One Story		60	263.2±	-	-
Setback From One Side Property Lines		30	15.6±	-	-
Setback From Rear Property Lines		50	912.4±	-	-
Setback From Street Line On A Corner Lot - One Story		-	-	-	-
Setback From Street Line On A Corner Lot - More Than One Story		-	-	-	-
MINIMUM FLOOR AREA					
Floor Area - One Story Building		1,200	-	-	-
Floor Area - Split Level Building		1,500	-	-	-
Floor Area - Two Or More Story Building Total Floor Area		1,500	2,801±	-	-
Floor Area - Two Or More Story Building Ground Floor Area		1,000	1,820±	-	-
Maximum Height For A Building Or Structure		40	<40	-	-
Maximum Number Of Stories Per Building		3	2	-	-
Maximum Building Lot Coverage As A Percentage Of Lot Area		10%	0.7% ±	-	-
Maximum Building Floor Area As A Percentage Of Lot Area		15%	0.8% ±	-	-
Minimum First Floor Elevation		-	-	-	-

* NET Lot Area (used in grid calculations)

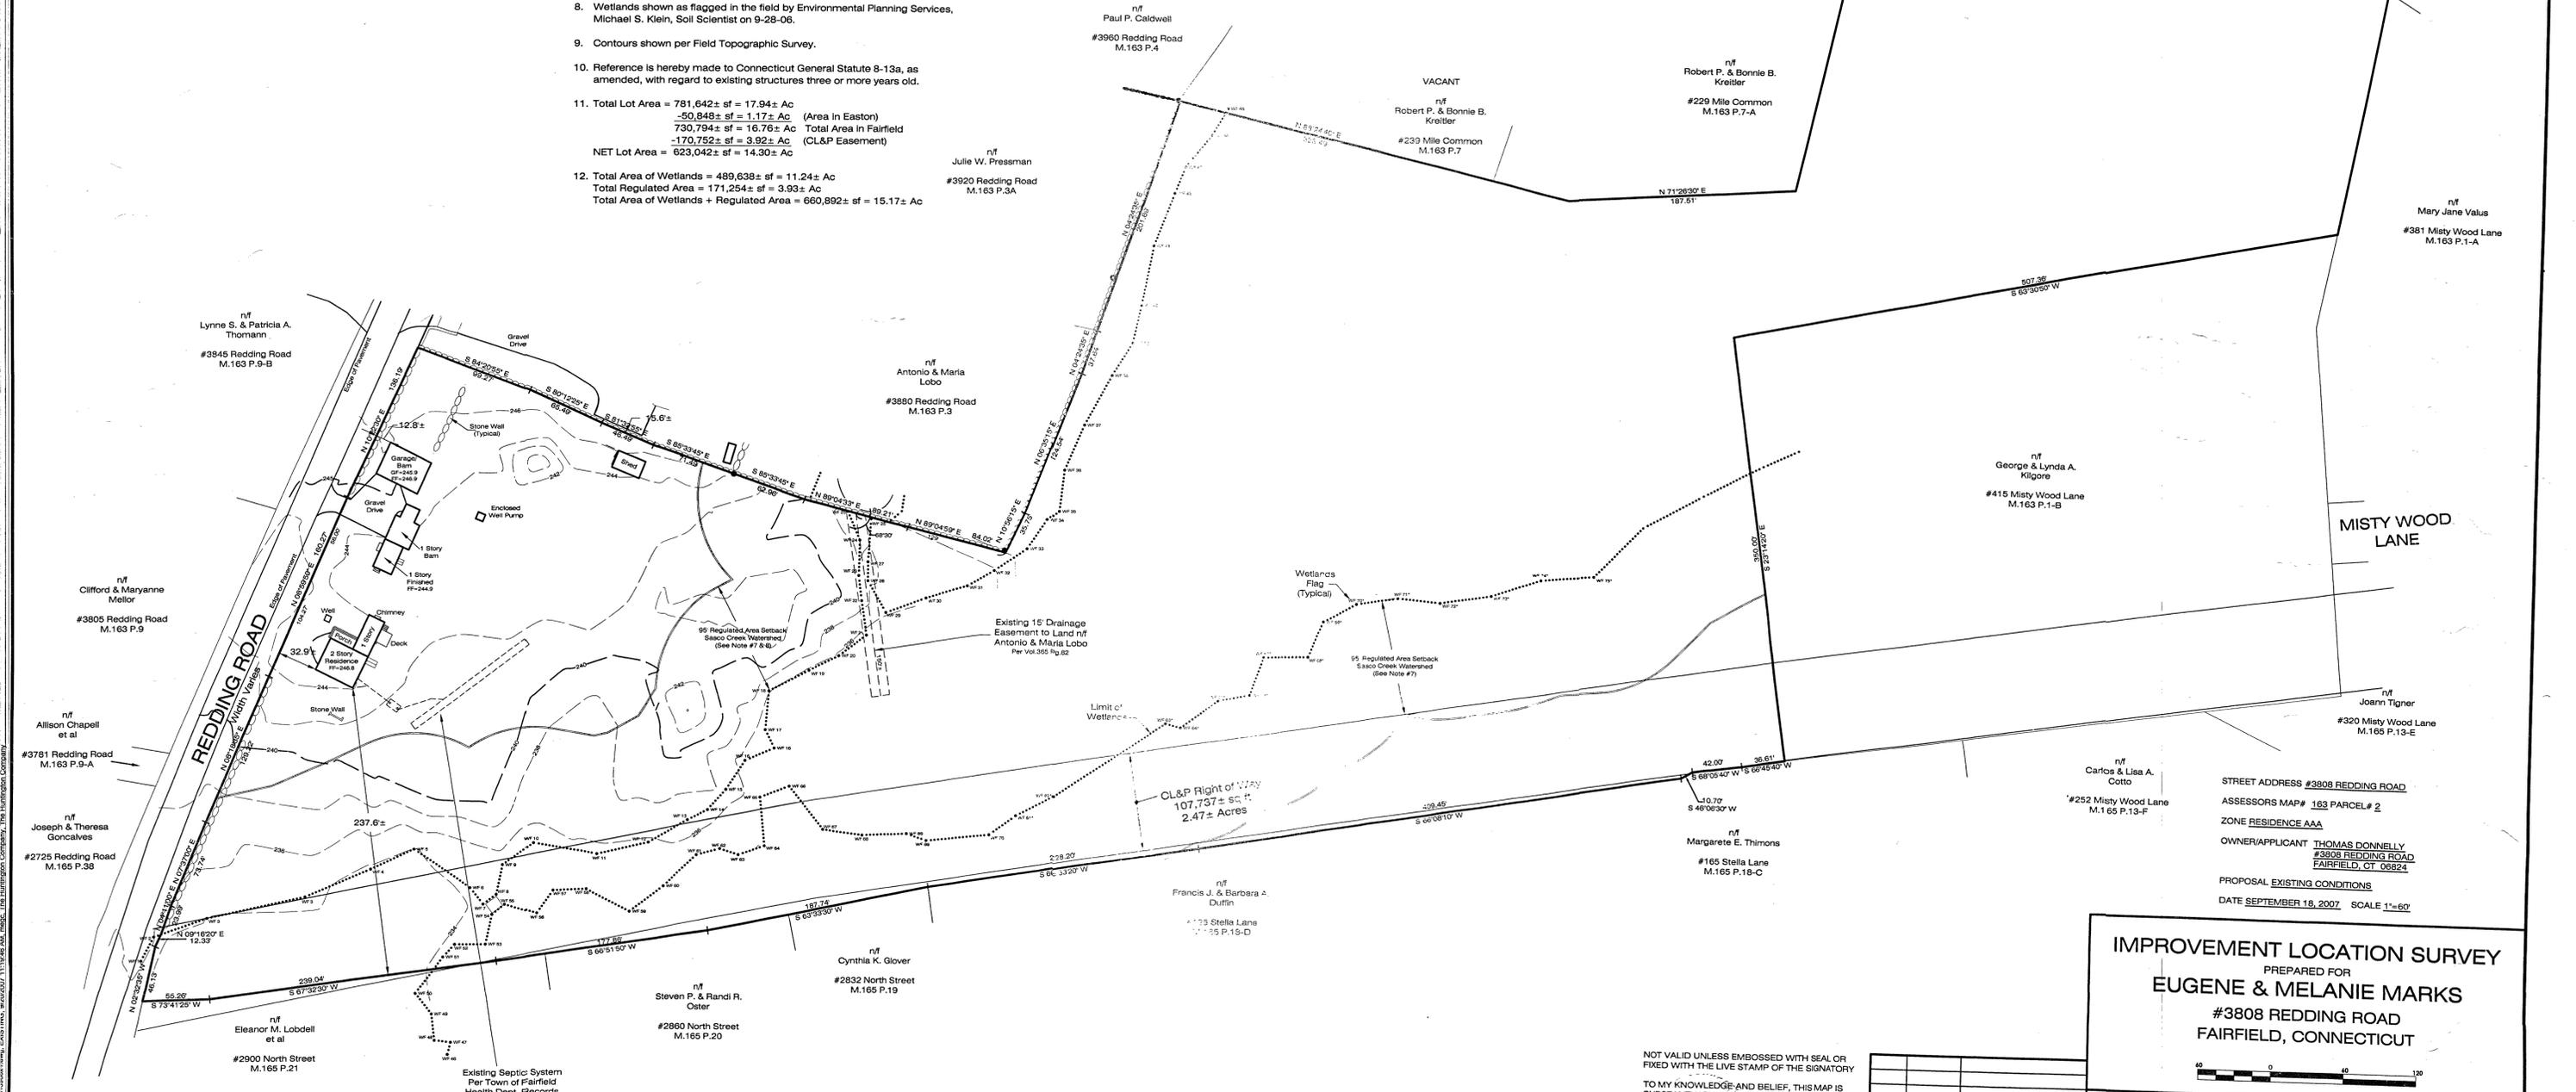

STREET ADDRESS #3808 REDDING ROAD
 ASSESSORS MAP # 163 PARCEL # 2
 ZONE RESIDENCE AAA
 OWNER/APPLICANT THOMAS DONNELLY
 #3808 REDDING ROAD
 FAIRFIELD, CT 06824
 PROPOSAL EXISTING CONDITIONS
 DATE SEPTEMBER 18, 2007 SCALE 1"=60'

IMPROVEMENT LOCATION SURVEY
 PREPARED FOR
EUGENE & MELANIE MARKS
 #3808 REDDING ROAD
 FAIRFIELD, CONNECTICUT

DATE: SEPTEMBER 18, 2007	SCALE: 1"=60'	DRAFTER: MSC	JOB NUMBER: 13906	PROJECT #: 13906
THE HUNTINGTON COMPANY, LLC Consulting Engineers & Surveyors 140 Sherman Street, Fairfield, CT 06424 203.259.1091				
NO. DATE DESCRIPTION				1/1
REVISIONS				

NOT VALID UNLESS EMBOSSED WITH SEAL OR FIXED WITH THE LIVE STAMP OF THE SIGNATORY
 TO MY KNOWLEDGE AND BELIEF, THIS MAP IS SUBSTANTIALLY CORRECT AS NOTED HEREON
 Charles S. Spath Sr., L.S. #8176




NOTES:

- This survey and map has been prepared in accordance with the Sections 20-300b-1 through 20-300b-20 of the Regulations of Connecticut State Agencies - "Minimum Standards for Survey and Maps in the State of Connecticut" as endorsed by the Connecticut Association of Land Surveyors, Inc. It is an Improvement Location Survey based upon a Dependent Resurvey and conforms to Horizontal Accuracy Class A-2.
- Reference is made to the following maps on file in the Fairfield Town Clerks Office:
 - A. RM #4632 - "Subdivision for Jacob H. & Joanna A. Witzke, Fairfield, Conn., May 12, 1976, Rev. Apr. 1977, Corrected Distance" Prepared by The Huntington Company.
- Reference is made to the following deeds:
 - A. Vol.365 Pg.82 - Drainage Easement
- The underground utilities shown, if any, have been located from visible field survey information. The surveyor makes no guarantees that the underground utilities shown comprise all such utilities in the area either in service or abandoned. The surveyor further does not warrant that the underground utilities shown are in the exact location indicated although the surveyor does hereby declare that they are located as accurately as possible from information available. The surveyor has not physically located the underground utilities.
- Property is located in FEMA Zone X & A. Per Flood Insurance Rate Map, Community Panel #090007 0001 G, Revised October 6, 1998, panel 1 of 11.
- Property to be served by public water and septic system.
- According to map J-4 & J-5 of the "Designated Inland Wetlands & Water Courses of the Town of Fairfield" this property does contain inland wetland "Regulated Area" as defined in Section 2.1.27 of the Inland Wetlands and Watercourses Regulations of the Town of Fairfield.
- Wetlands shown as flagged in the field by Environmental Planning Services, Michael S. Klein, Soil Scientist on 9-28-06.
- Contours shown per Field Topographic Survey.
- Reference is hereby made to Connecticut General Statute 8-13a, as amended, with regard to existing structures three or more years old.
- Total Lot Area = 781,642± sf = 17.94± Ac
 -50,848± sf = 1.17± Ac (Area in Easton)
 730,794± sf = 16.76± Ac Total Area in Fairfield (CL&P Easement)
 -170,752± sf = 3.92± Ac
 NET Lot Area = 623,042± sf = 14.30± Ac
- Total Area of Wetlands = 489,638± sf = 11.24± Ac
 Total Regulated Area = 171,254± sf = 3.93± Ac
 Total Area of Wetlands + Regulated Area = 660,892± sf = 15.17± Ac

RESIDENCE AAA DISTRICT	MINIMUM REQUIRED	EXISTING	PROPOSED	AS BUILT
	MAXIMUM ALLOWED	CONDITIONS	CONDITIONS	CONDITIONS
Minimum Lot Area	87,120	623,042±	-	-
Minimum Square On Lot	200	200±	-	-
Minimum Lot Frontage	20	581.87	-	-
MINIMUM SETBACK				
Setback From Street Line	60	32.9±	-	-
Setback From Side Property Lines - One Story	60	-	-	-
Setback From Side Property Lines - More Than One Story	60	263.2±	-	-
Setback From One Side Property Lines	30	15.6±	-	-
Setback From Rear Property Lines	50	912.4±	-	-
Setback From Street Line On A Corner Lot - One Story	-	-	-	-
Setback From Street Line On A Corner Lot - More Than One Story	-	-	-	-
MINIMUM FLOOR AREA				
Floor Area - One Story Building	1,200	-	-	-
Floor Area - Split Level Building	1,500	-	-	-
Floor Area - Two Or More Story Building Total Floor Area	1,500	2,801±	-	-
Floor Area - Two Or More Story Building Ground Floor Area	1,000	1,820±	-	-
Maximum Height For A Building Or Structure	40	<40	-	-
Maximum Number Of Stories Per Building	3	2	-	-
Maximum Building Lot Coverage As A Percentage Of Lot Area	10%	0.7% ±	-	-
Maximum Building Floor Area As A Percentage Of Lot Area	15%	0.8% ±	-	-
Minimum First Floor Elevation	-	-	-	-

* NET Lot Area (used in grid calculations)

This area can likely be developed - we'll need to see an updated wetland delineation and survey showing all proposed activities. Once we see the plan we would determine what type of wetlands permit is needed.

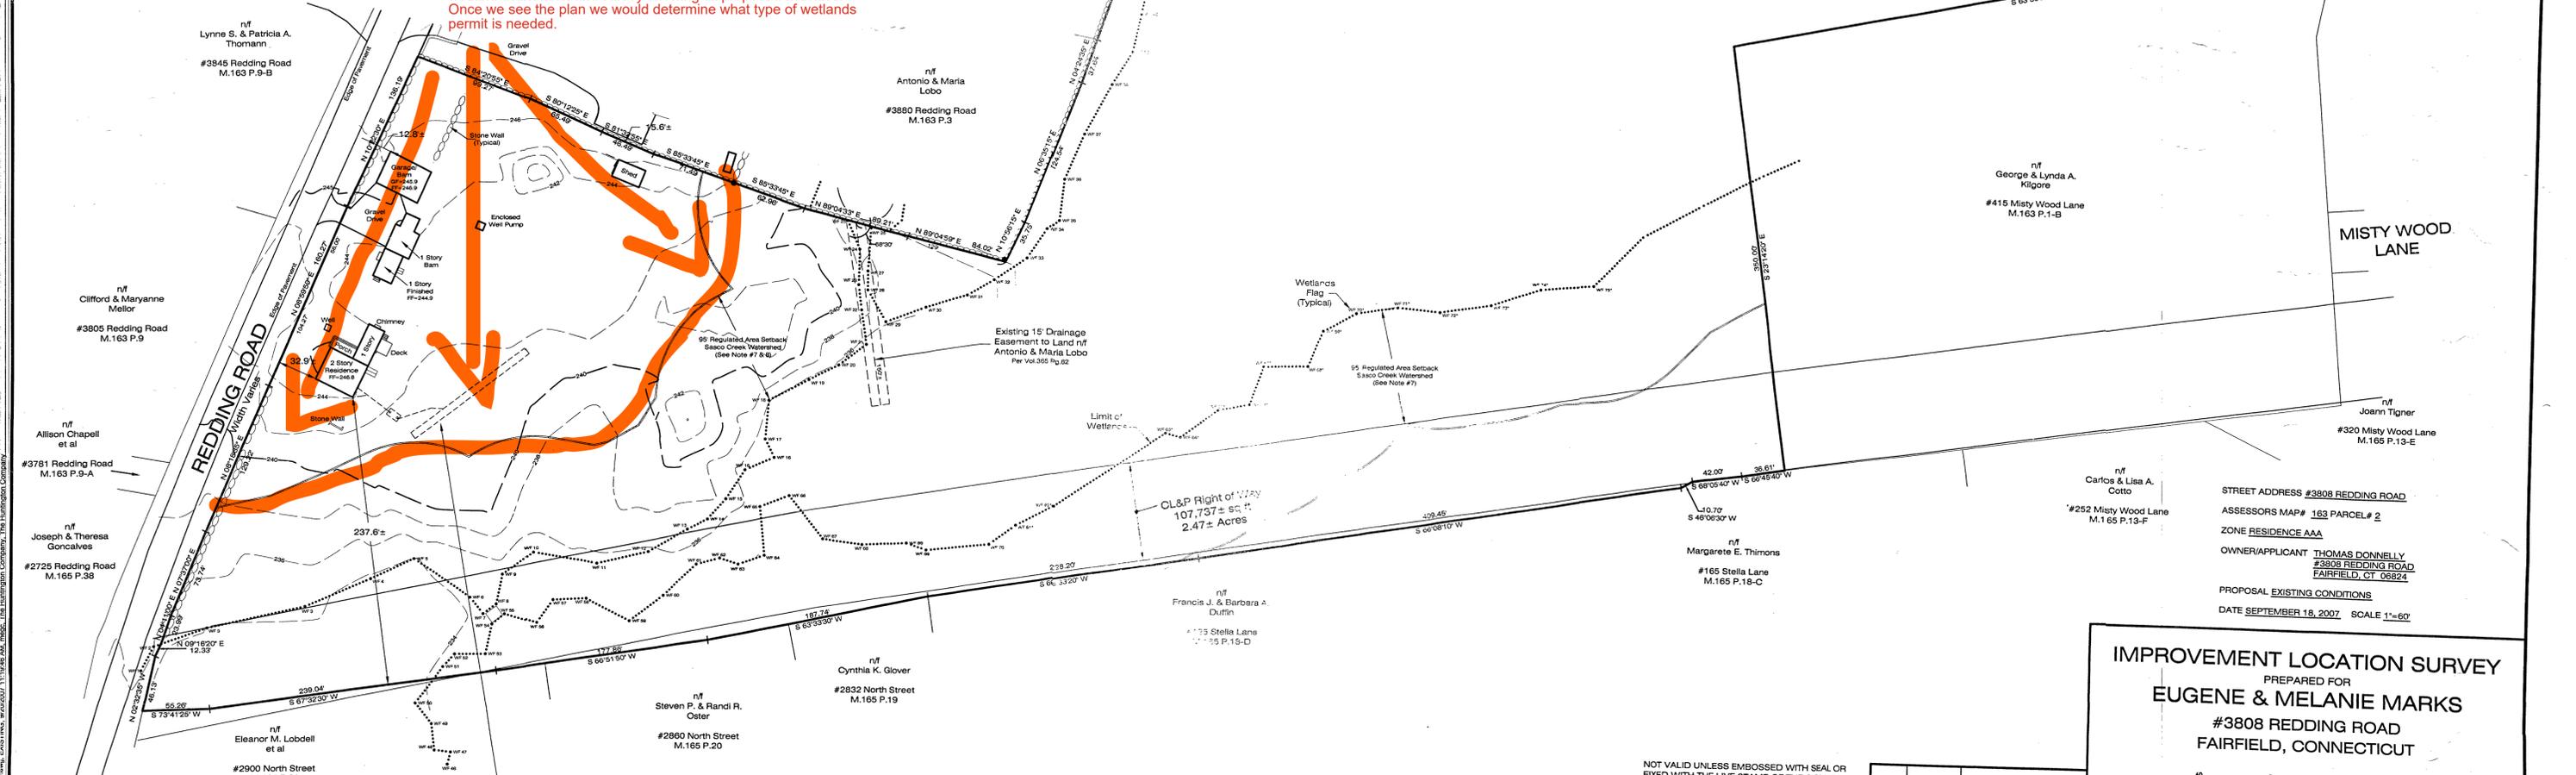

STREET ADDRESS #3808 REDDING ROAD
 ASSESSORS MAP # 163 PARCEL # 2
 ZONE RESIDENCE AAA
 OWNER/APPLICANT THOMAS DONNELLY
 #3808 REDDING ROAD
 FAIRFIELD, CT 06824
 PROPOSAL EXISTING CONDITIONS
 DATE SEPTEMBER 18, 2007 SCALE 1"=60'

IMPROVEMENT LOCATION SURVEY
 PREPARED FOR
EUGENE & MELANIE MARKS
 #3808 REDDING ROAD
 FAIRFIELD, CONNECTICUT

DATE: SEPTEMBER 18, 2007 SCALE: 1"=60' DRAFTER: MSC JOB NUMBER: 13906 PROJECT #: 13906

THE HUNTINGTON COMPANY, LLC
 Consulting Engineers & Surveyors
 140 Sherman Street, Fairfield, CT 06424
 203.259.1091



NO. DATE DESCRIPTION REVISIONS

NOT VALID UNLESS EMBOSSED WITH SEAL OR FIXED WITH THE LIVE STAMP OF THE SIGNATORY
 TO MY KNOWLEDGE AND BELIEF, THIS MAP IS SUBSTANTIALLY CORRECT AS NOTED HEREON
 Charles S. Spath Sr., L.S. #8176


Septic system to be installed in accordance with State of Connecticut Public Health Code sections 19-13-8103a - 8103f by a licensed installer. System size is based on 225 sq. ft. of leaching area per bedroom for a 4 bedroom house. Location and elevation of septic system to be verified in field, by the installer, prior to installation. Refer to "Instructions to Installers" for methods and procedures for site preparation and system installation.

Any proposed fill for septic area should be top grade Bank Run gravel or coarse sharp sand and is to be approved by the Health Dept. and engineer prior to its use. Any proposed fill may require testing and/or sieve analysis, and any substitution of material must be approved by the Health Dept. and the engineer prior to its use.

Area of septic system is to be stripped of all vegetation and the topsoil removed. The exposed subsoil is to be thoroughly scarified using a hand rake or York rake. If any problems are encountered at this time notify the engineer and Town Sanitarian at once. Fill material should be dumped on one side of the system area, and spread by dozing from the outside inwards, taking care that the machine rides only over the new fill.

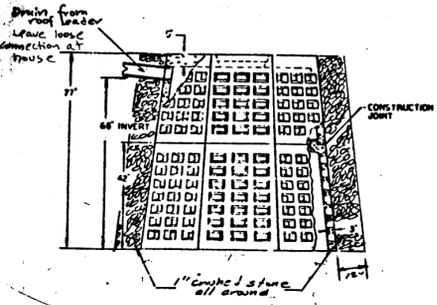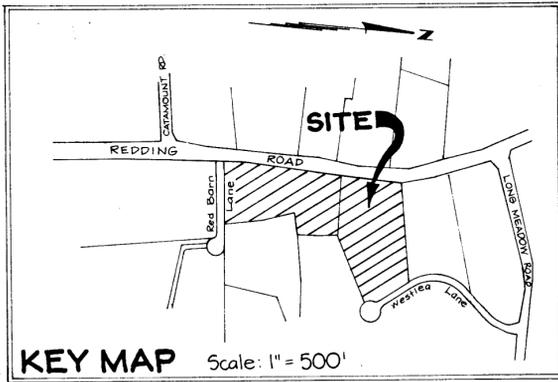


ROOF LEADER DRY WELL DETAIL

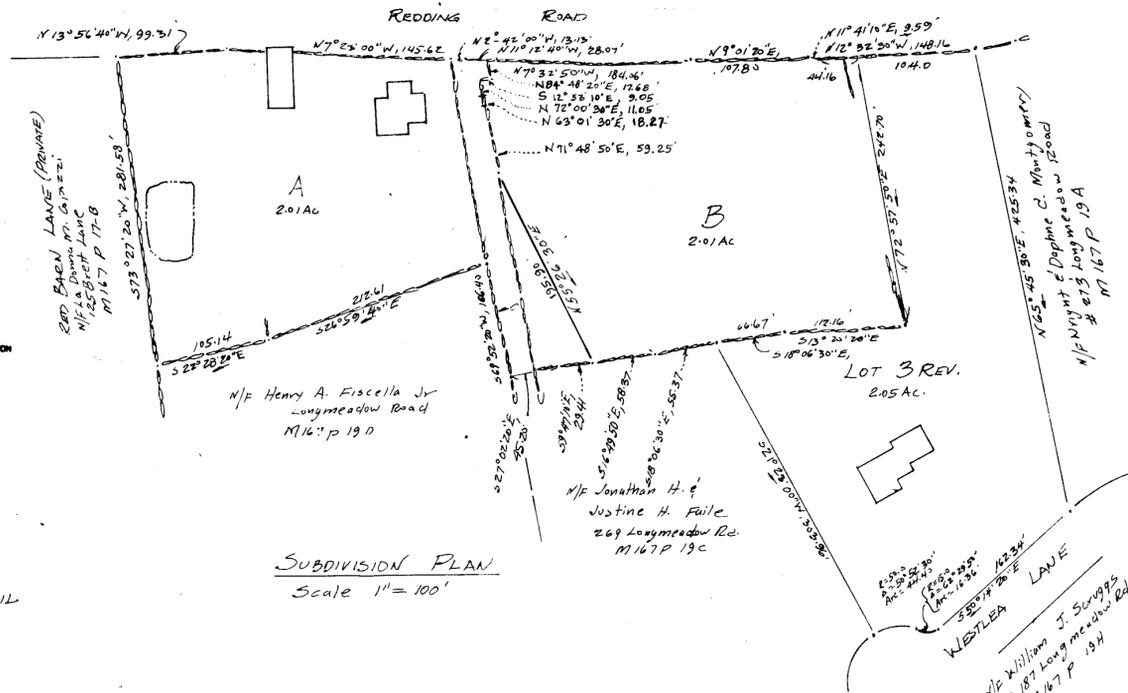


SUBDIVISION PLAN Scale 1" = 100'

- EXISTING CONTOURS - NGVD of 1929
- Proposed Contours
- Primary 3' leaching trench - 12' O.C.
- Reserve 3' leaching trench - 12' O.C.
- 1250 gallon Septic tank
- Deep Test Hole VNC S 5 3988
- Silt fence
- Anti-tracking apron w/ fabric base
- Intend wetland boundary as flagged & surveyed
- B3 Sasco Creek Tributary setback
- Proposed New Conservation Easement
- 8x8 Roof Load Dry Well
- Foundation Envelope
- Site Disturbance Line

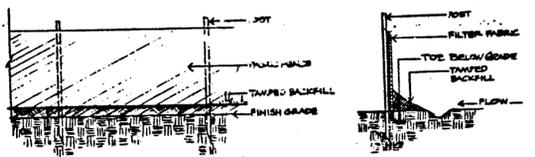

1. SEDIMENT FABRIC FENCE TO BE INSTALLED PRIOR TO START OF CONSTRUCTION AS DIRECTED.
2. REMOVE OR REPLACE AS NECESSARY THROUGHOUT CONSTRUCTION.
3. LEAVE IN PLACE UNTIL ALL DISTURBED AREAS HAVE BEEN LEAVED, MULCHED AND SEEDED AND SITE HAS STABILIZED.
4. HOLES TO BE SPACED AS CLOSE AS NECESSARY TO PROVIDE PROPER SUPPORT FOR FENCE.

SILT FENCE DETAIL NO SCALE

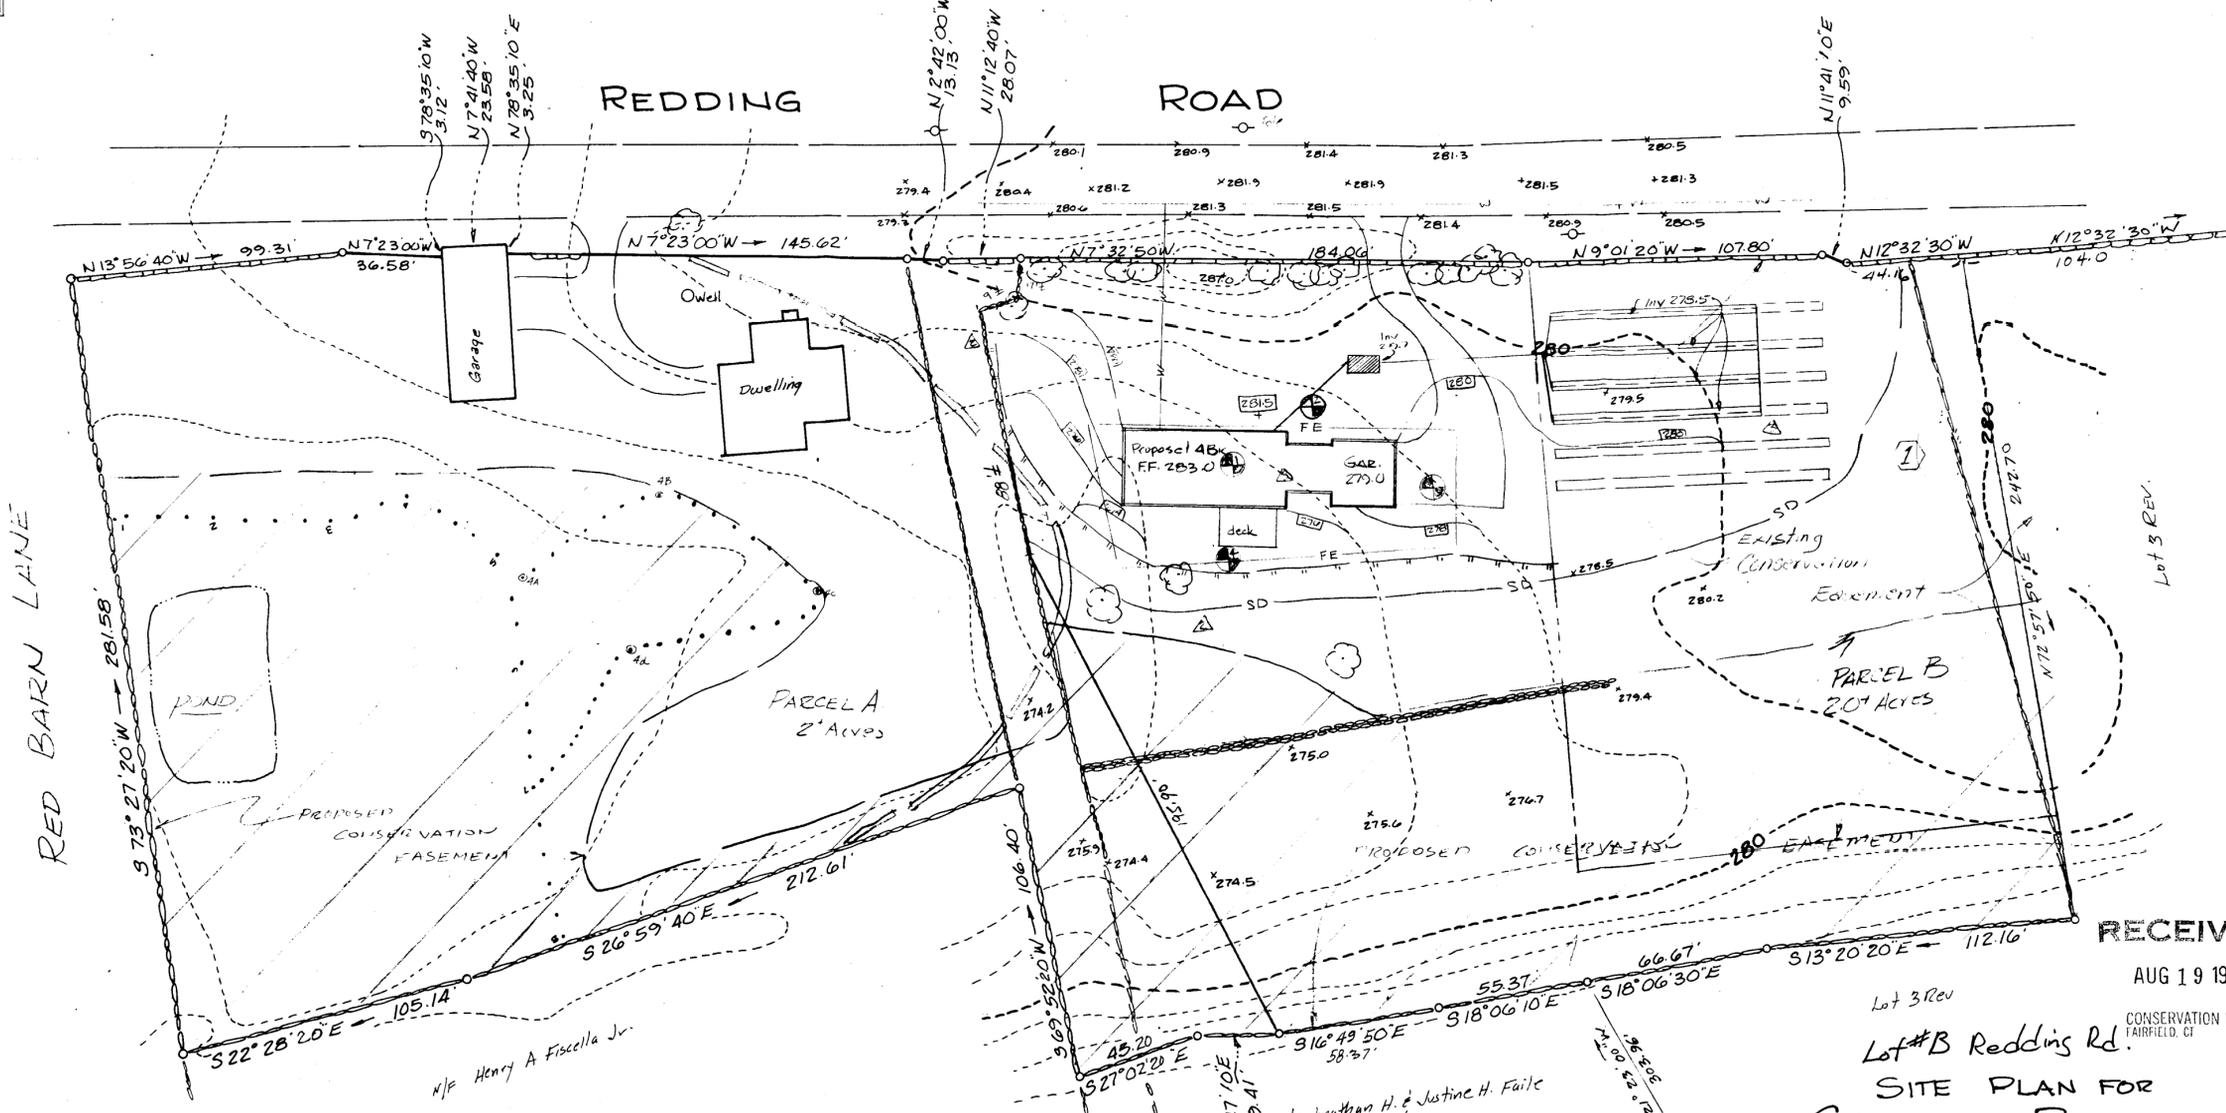

REGULATED ACTIVITIES

- 1 Construction Within Existing Conservation Easement

6. BOND ESTIMATE

250 LF Silt Fence @ \$250/LF	=	\$62,500
Anti-tracking Apron @ 600	=	600
2000	=	2000
Roof Leader Dry Well @ 2000	=	2000
Total	=	\$67,100

NOTES:

1. Owners: Constance C. Busch
3060 Redding Rd., Fairfield, Conn. 06430
Nicholas J. Bagannam
271 Longmeadow Rd., Fairfield, Conn. 06430
2. Applicant: Carlo Palmieri
37 Ermine St., Fairfield, Conn. 06430
3. HUD Flood Zone "C"
4. Ecological Area 2.2 Acres
Wetland Soil Area 0.2 Acres


No.	DATE	REVISION
3	6/17/88	
2	5/25/88	PCE-APPN REPTS - LOT LINE CORRECTION
1	3/4/88	CONCEPT REVIEW REPTS

Scale 1" = 40'
NGVD Datum 1929.


RECEIVED
AUG 19 1988
CONSERVATION DEPT.
FAIRFIELD, CT
Lot #B Redding Rd.
SITE PLAN FOR
CARLO PALMIERI,
FAIRFIELD, CONN., NOV. 3, 1987.

The Huntington Company
Engineers & Surveyors
Fairfield, Conn.



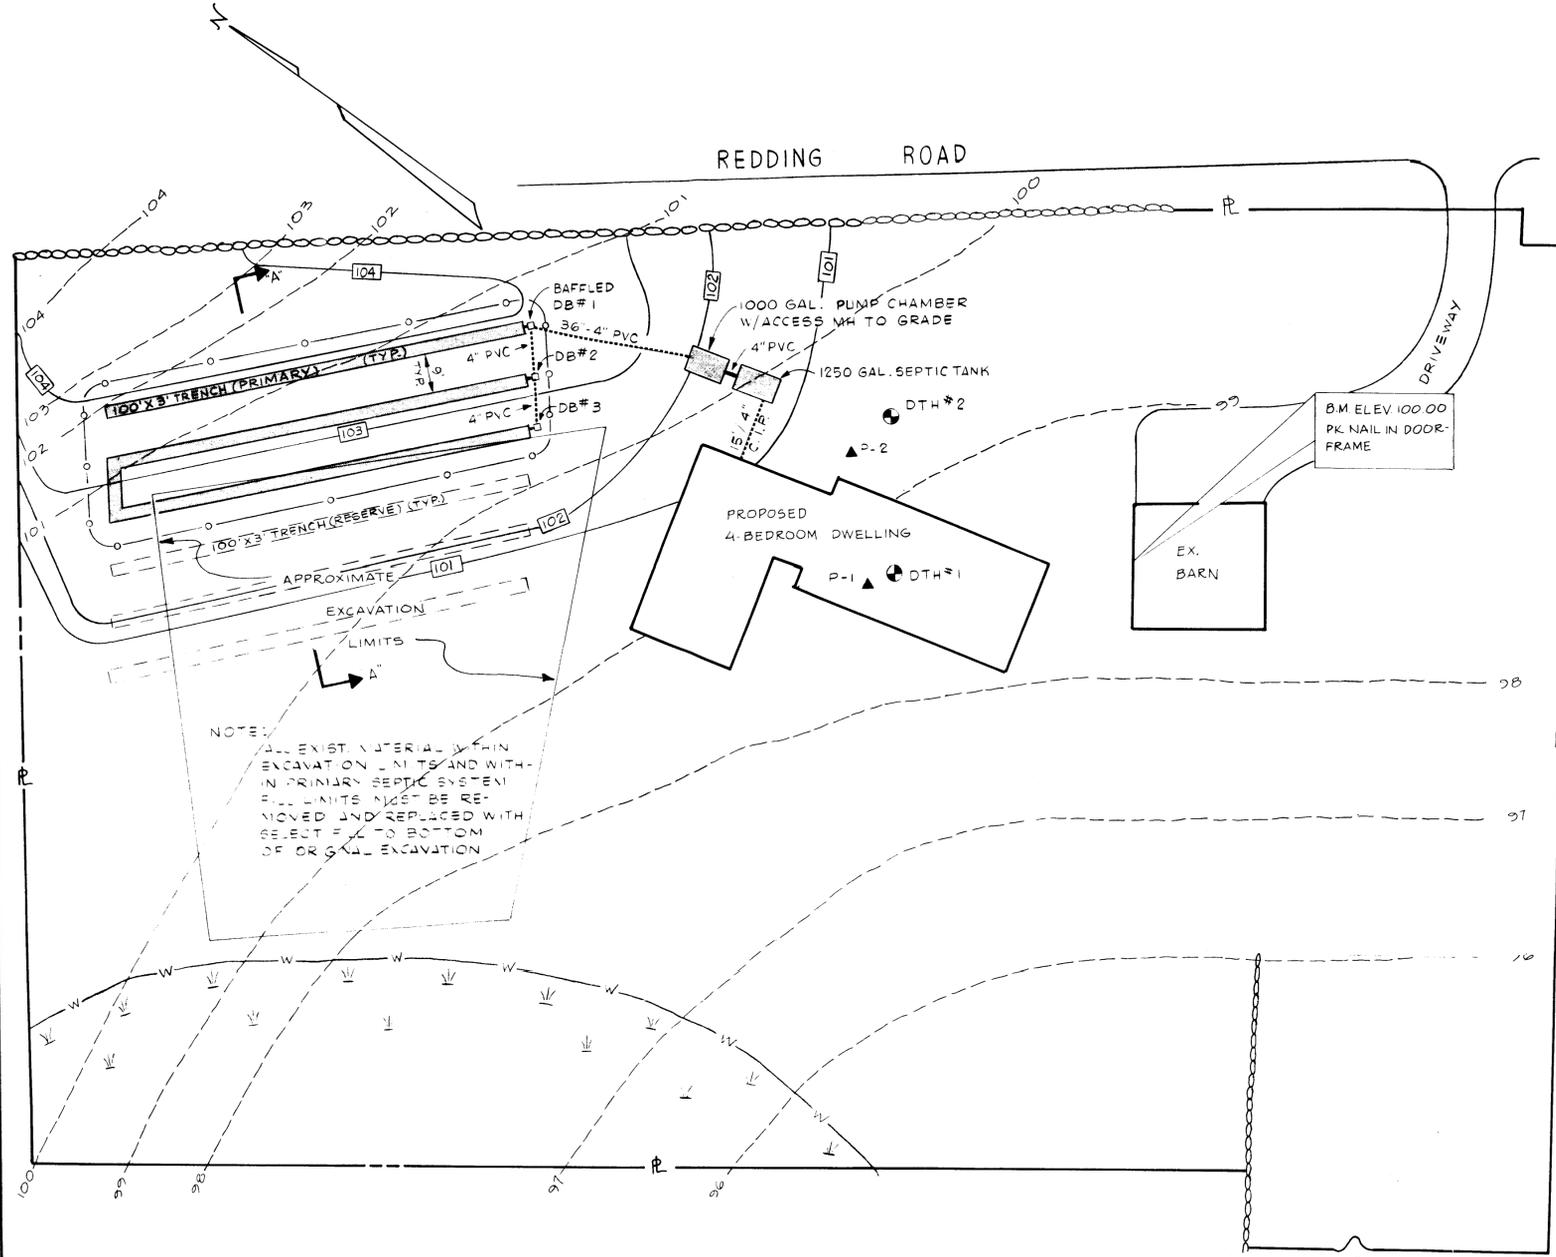


NOTE: ALL EXIST. MATERIAL WITHIN EXCAVATION LIMITS AND WITHIN PRIMARY SEPTIC SYSTEM FULL LIMITS MUST BE REMOVED AND REPLACED WITH SELECT FILL TO BOTTOM OF OR GAL. EXCAVATION

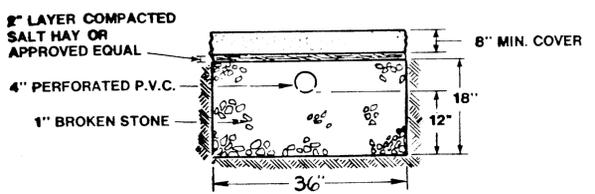

TYPICAL LEACHING TRENCH DETAIL N.T.S.

SITE PLAN SCALE 1" = 20'

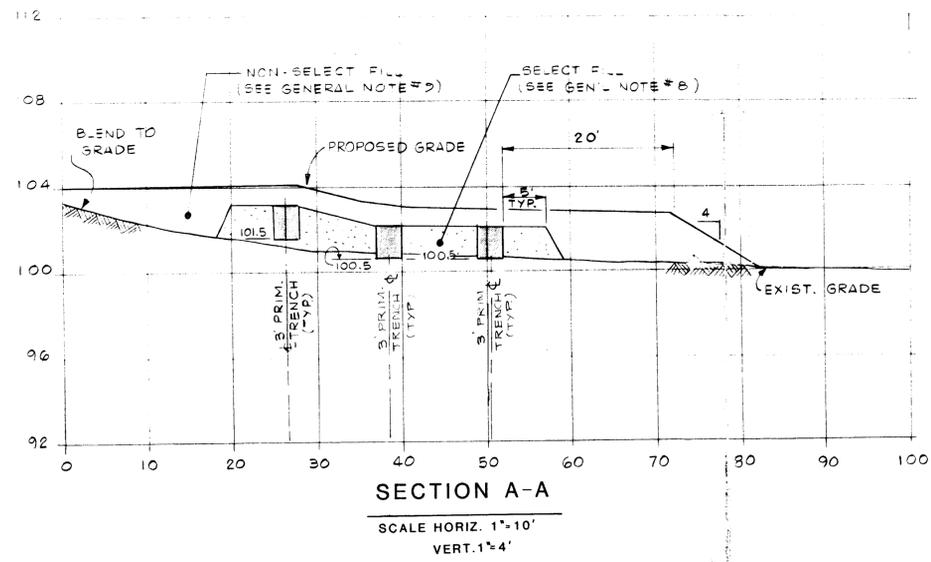

SECTION A-A SCALE HORIZ. 1" = 10' VERT. 1" = 4'

SOILS DATA

(CONDUCTED 10/11/84, Deep Test Hole #1) (Deep Test Hole #2)

0 - 10" TS	0 - 10" TS
10 - 23" RBFSL	10 - 23" RBFSL
23 - 29" Mod. comp. sandy till	23 - 29" Mod. comp. sandy till
29 - 84" Mottled hardpan	29 - 72" Mottled hardpan

No ledge or g.w. Mottling at 23" Roots to 28"

No g.w. or ledge Mottling at 23" Roots to 23"

Percolation Test # 1				Percolation Test # 2			
Depth: 26"	Moist. 6"	Preconk: 9:40	Moist: 12"	Depth: 48"	Moist. 6"	Preconk: 9:45	Moist: 12"
Time	Moist.	Drop	Rate/ft	Time	Moist.	Drop	Rate/ft
10:53	14 1/4"	-	-	10:52	6"	-	-
11:03	16 7/8"	2 5/8"	-	11:02	7"	1"	1 1/2"/hr
11:13	18 1/4"	1 5/8"	-	11:12	7 5/8"	5/8"	-
11:23	19 1/4"	1"	-	11:22	8 3/8"	3/4"	-
11:33	20 1/4"	3/4"	-	11:32	8 7/8"	1/2"	-
11:43	21"	3/4"	-	11:42	9 1/4"	3/8"	-
11:53	21 5/8"	5/8"	1 1/16"	11:52	9 3/4"	1/2"	1 1/20"

INVERT ELEVATIONS

House Sewer Foundation	100.0 ±
Septic Tank Inlet	99.6
Septic Tank Outlet	99.3
Pump Discharge	95.0 ±
Baffled DB #1 Inlet	102.7
Baffled DB #1 Lateral	102.5
Baffled DB #1 Outlet to DB #2	102.5
High Overflow DB #2 Inlet	101.5
High Overflow DB #2 Lateral	101.5
High Overflow DB #2 Outlet to DB #3	101.5
DB #3 Inlet	101.5
DB #3 Lateral	101.5
Bottoms Trench #1	101.5
Bottoms Trench #2	100.5
Bottoms Trench #3	100.5

GENERAL NOTES

- Lot lines have been taken from plan of property prepared by David Bruce Ballinger, dated 8/2/84.
- Topographic data as per field survey on 10/11/84 and 5/13/85 by Land-Tech Consultants, Inc. Assumed Datum. Topographic data established for septic system design purposes only.
- Based on an observed percolation rate of 1 1/2" (10.1-20.9 min.) and a 4 BR dwelling, a 1250 gallon septic tank and 900 sq.ft. of effective leaching area must be provided as per the State of Connecticut Health Code. Install 300 linear feet of 3 ft. wide leaching trench providing 900 sq.ft. of effective leaching area.
- Strip topsoil and scarify ground surface with bucket teeth or harrow to a depth of 6" (minimum). Protect the prepared surface from machine or vehicular traffic.
- Provide a 1000 gallon pump chamber as manufactured by DiTullio or equal. A manhole shall extend to finished grade. Grout all joints.
- The pump shall be a Gould Model #3885; WE0311L; single phase or equal. Mercury level control float switches are to be provided and set so that the pump discharges 250 gallons per cycle. Control panel to be Howard "A" or equal with on/off/manual switch. A clearly audible, high liquid level alarm is to be set inside the house. Electrical hook-up to the pump to be placed in a minimum 4" x 4" weathertight box set a minimum 12" above finished grade in a protected location. A service disconnect is to be in view of the pump chamber.
- The 2" PVC force main shall be laid 42" below grade wherever possible. Where not possible, its pitch shall be such that during pump shutdown, the effluent flows back into the pump chamber.
- Select fill shall be a clean, sandy gravel with no more than 5% fines passing a number 200 Sieve. Gravel Gradation to be as follows:
Sieve Size: 6" #4 #40 #100 #200
% Passing: 100 30-80 5-25 0-10 0-5
- Non-select fill shall be a clean loam or better free of organic matter.
- Gravel fill to be dumped at the edge of prepared leaching area and pushed onto harrowed surface with track machine in 12" (max) lifts. Gravel to be compacted to 90-95% proctor density - modified optimum density ASTM 1557 Method "C". The engineer of record and the health department must approve the select gravel fill prior to its placement.
- It is the responsibility of the installer to keep both the engineer of record and the local health department informed of construction progress.
- House sewer to be constructed of 4" extra-heavy ductile iron pipe with leaded joints or equal. Minimum pitch on house sewer from house to septic tank to be one-quarter inch per foot and sewer from septic tank to leaching system to be one-eighth-inch per foot. All effluent pipes dispersing flows to distribution boxes to be 4" solid PVC with solvent sealed joints or equal. Changes in direction to be made with the appropriate commercially manufactured fittings. All pipes to be properly grouted into septic tank, pump chamber and distribution boxes.
- The installation of the septic system shall be under the supervision of a professional engineer.
- Prior to construction activities the leaching system area shall be roped off or otherwise delineated so as to keep construction traffic off the septic area.
- This design conforms to applicable codes and accepted practice. No other warranty is expressed or implied.
- Land-Tech Consultants, Inc. assumes no responsibility for septic system site preparation, location or invert elevations in compliance with the approved plan, unless it supervises each phase of system installation.

Land-Tech Consultants, Inc. <small>ENGINEERS • PLANNERS • ENVIRONMENTAL SCIENTISTS</small>	PREPARED FOR: STEPHEN COLHOUN	PROJECT LOCATION: LOT 4 REDDING ROAD FAIRFIELD, CT.
	TITLE: PROPOSED SEPTIC SYSTEM SITE PLAN	
199 ETHAN ALLEN HIGHWAY RIDGEFIELD, CONNECTICUT 06877 (203) 431-6765	DATE: 5/16/85 SCALE: AS NOTED	DWN. BY: MJ CKD. BY: RBO
	DWG. NO. 132 84 SHEET OF 	

David B. O'Leary