

YELLOWSTONE CITY-COUNTY HEALTH DEPARTMENT
SUBSURFACE SEWAGE TREATMENT SYSTEM

PERMIT

Repair

DATE OF PERMIT 2-17-87

BUILDING PERMIT A B _____ #
CLASS 1 2
Y.C. PERMIT NO. 7399

SITE LOCATION 3748 Blue Creek Road

LEGAL DESCRIPTION _____ Lot _____ Blk _____ Tract _____

Installer Palm Tree

Installed for Patrick Garrison

Type of Dwelling SFR 3+ Constructed/designed for _____ bdrms

Water Supply: Well ☒ Cistern _____ Public _____

Distance to septic tank ~120 Distance to drainfield ~120'

MINIMUM DRAINFIELD REQUIREMENTS: _____ Sq. ft./bdrm

Percolation Rate _____ min/in. Depth of groundwater _____ ft.

LAYOUT DETAILS:

Tank Size 1,000; 1500; 2000 gal.

Material: Concrete ☒ Other _____

Tank to Foundation: <5 ft.

Trench to property line ~10 ft.

TRENCH DIMENSIONS:

Gravel above pipe 2'-4" in.

Gravel below pipe 12 in.

Depth to Perf. pipe 24 in.

Depth to bottom trench 36-40 in.

Trench width Bed 12x13'


System type Trench & Bed

Total Area Installed: _____

216 sq. ft.

DIAGRAM

CALCULATIONS

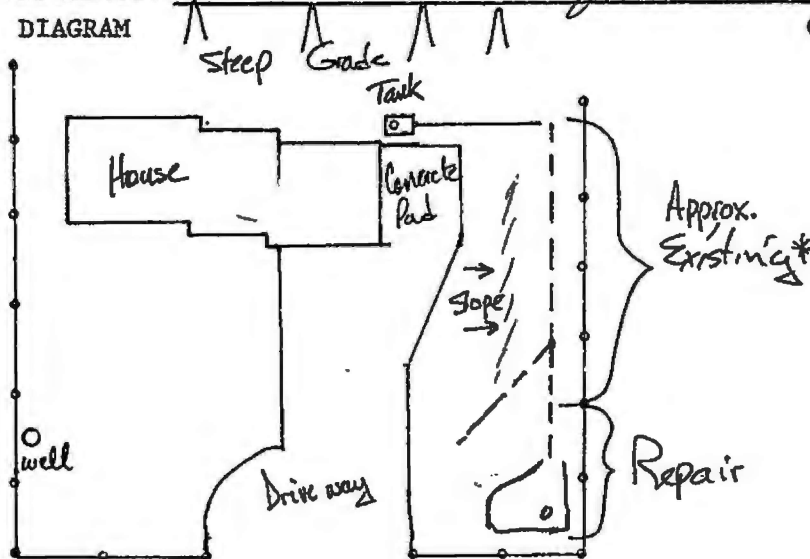

Bed
 $\sim 12' \times 13' = 156 \text{ sq. ft.}$
Trench - 30 L.F.
 $\times 2$
 $\underline{60 \text{ sq. ft.}}$
 156
 $\underline{60}$
 216 sq. ft. Tot.

APPROVED: ☒ DENIAL _____ REASON: Blue Creek Rd

INSTALLER Dan B. Turcotte SANITARIAN Dan B. Turcotte

NOTE: Inspection denotes compliance to plans submitted and to Yellowstone County Rules and Regulations. It does not guarantee performance or longevity of system.

YCCHD-EHD/nh 92083

* Excess Slope apparent on existing drainfield line.

Bill