

YELLOWSTONE CITY-COUNTY HEALTH DEPARTMENT  
SUBSURFACE SEWAGE TREATMENT SYSTEM

PERMIT

DATE OF PERMIT 7-7-93

BUILDING PERMIT A B 79-93 #  
CLASS 1 2  
Y.C. PERMIT NO. 8617

SITE LOCATION 1340 CLOVERLEAF

LEGAL DESCRIPTION CLOVERLEAF MEADOW Lot 4 Blk 2 Tract 1st  
Installer CAS CONSTRUCTION  
Installed for KENMARK CONSTRUCTION  
Type of Dwelling S.F.R. Constructed/designed for 3 bdrms


Water Supply: Well  Cistern  Public   
Distance to septic tank 60 Distance to drainfield 100'

MINIMUM DRAINFIELD REQUIREMENTS: 140 Sq. ft/bdrm  
Percolation Rate \_\_\_\_\_ min/in. Depth of groundwater \_\_\_\_\_ ft.

LAYOUT DETAILS:  
Tank Size: 1,000; 1500; 2000 gal. Material: Concrete  Other RISER  
Tank to Foundation: 28 ft. Trench to property line 24 ft.

TRENCH DIMENSIONS:  
Gravel above pipe 2 in. Gravel below pipe 6-8 in. WEST SIDE  
Depth to Perf. pipe 12-14 in. Depth to bottom trench 22-24 in.  
Trench width 24 in. System type STANDARD

Total Area Installed: 442 SQ. FT.

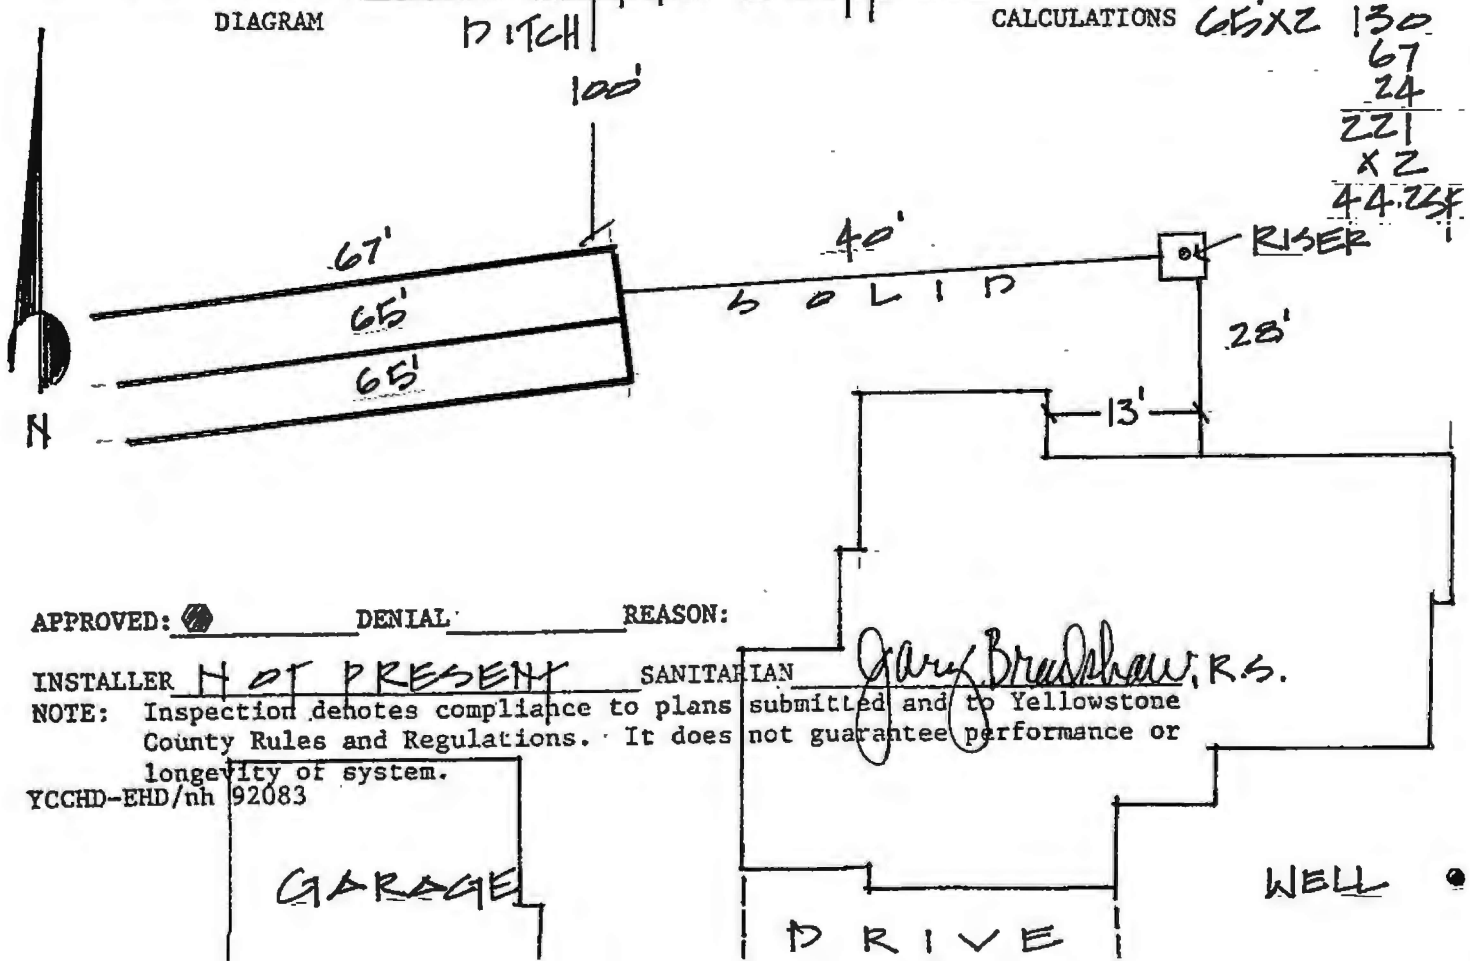

APPROVED:  DENIAL  REASON: \_\_\_\_\_

INSTALLER NOT PRESENT SANITARIAN Gary Bradshaw, R.S.

NOTE: Inspection denotes compliance to plans submitted and to Yellowstone County Rules and Regulations. It does not guarantee performance or longevity of system.

YCCHD-EHD/nh 92083