

KENDALL COUNTY



DEPARTMENT OF
DEVELOPMENT MANAGEMENT
211 East San Antonio Street, Suite 6
Boerne, Texas 78006
Telephone: (512) 249-9343 Ext. 41

FILE NO. S - 1857

SEPTIC FORM

PRIVATE SEWAGE FACILITY PERMIT (LICENSE) IN KENDALL COUNTY, TEXAS

APPLICANT INFORMATION:

PROPERTY OWNER(LICENSEE) James A Edwards CONTRACTOR EASTMAN (E&MCO)

SUBDIVISION OR LOCATION Lux Ranch Estates 20A LOT BOCK

TOTAL AREA SQ. FT. _____ OR _____ ACRES

NO. OF BEDROOMS 2 OR SQ. FT. IN HOUSE _____ OR GAL./DAY _____

PERC. RATE 5.225 CLASS NO. _____ TRENCH REQ. 750 ft² OR BED REQ. 450 ft²

GAL. CAPACITY REQ. FOR CONCRETE SEPTIC TANK 750 (1) $A = \frac{300(1+B)}{R_c}$

INSTALLED: LENGTH 134

3

X WIDTH _____

402


SQUARE FEET

BED

TRENCH

REMARKS:

SKETCH (APPROXIMATE DISTANCES, NOT TO SCALE):

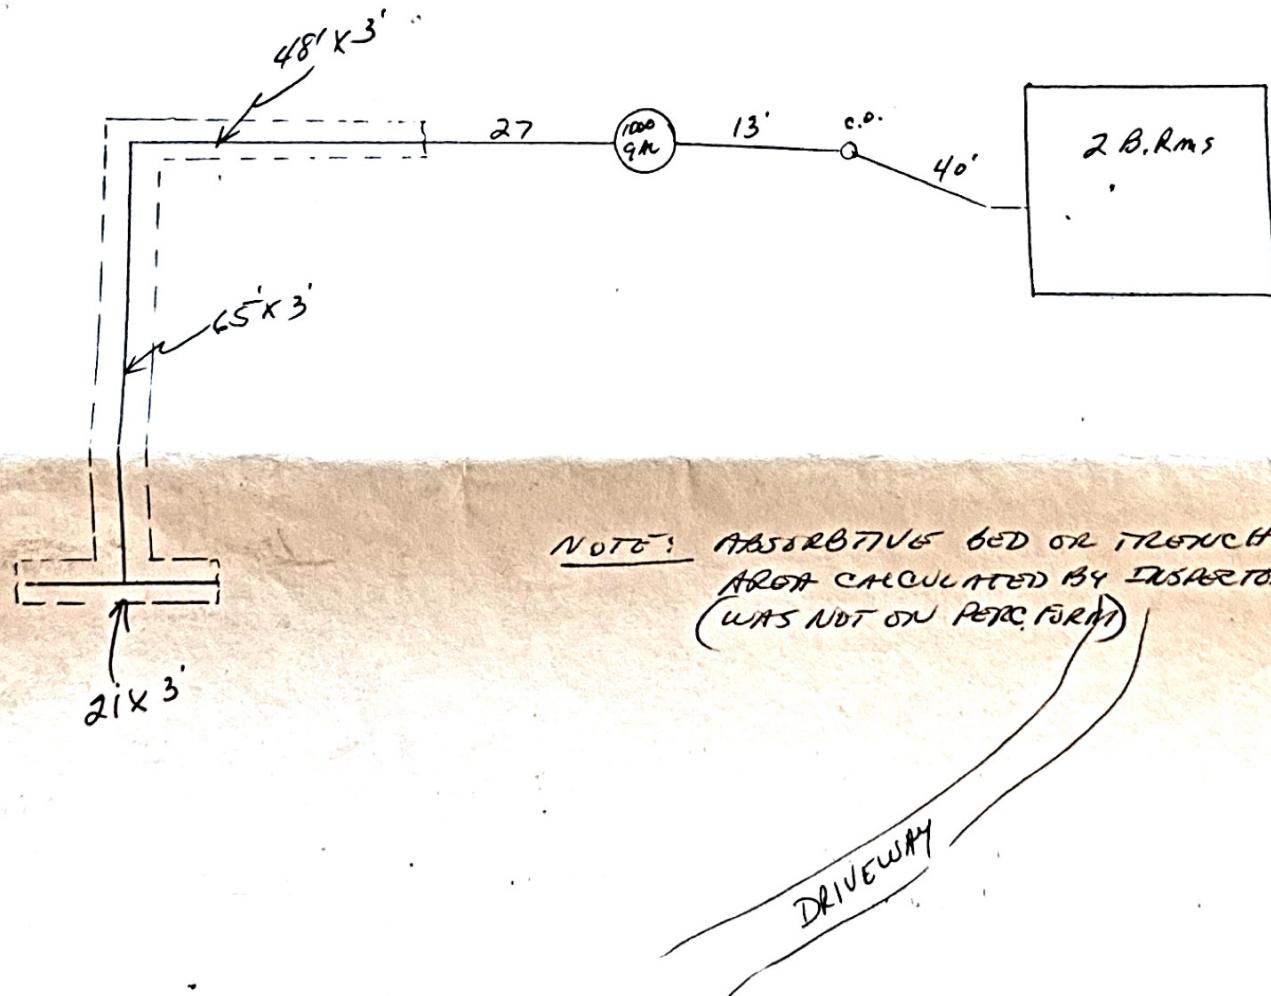

THE COUNTY OF KENDALL, THE TEXAS DEPARTMENT OF HEALTH, OR THEIR AGENTS OR DESIGNEES, MAKE NO REPRESENTATION THAT FACILITIES HEREIN LICENSED WILL PROVIDE SATISFACTORY SERVICE TO THE PREMISES SERVED. IT WILL BE THE LICENSEE'S RESPONSIBILITY TO MAKE ANY CHANGES OR MODIFICATIONS WHICH OPERATING EXPERIENCE MAY SHOW TO BE NECESSARY IN ORDER FOR THESE FACILITIES TO PROVIDE SATISFACTORY SERVICE. SEPTIC DISTANCES MEET MINIMUM TEXAS DEPARTMENT OF HEALTH SEPARATION DISTANCES IN MOST INSTANCES. SOME RENOVATIONS MAY BE LESS IF REPAIRED OR REPLACED IN THE SAME GENERAL AREA AS THE PRE-EXISTING SYSTEM BEING RENOVATED.

PERMIT (LICENSE) GRANTED

AND APPROVED THIS DATE:

1 Jan 87

John B. Burch
DIRECTOR OF DEPT. OF DEV. MANAGEMENT