

KENDALL COUNTY

DEPARTMENT OF
DEVELOPMENT MANAGEMENT
311 East San Antonio Street, Suite 8
Boerne, Texas 78006
Telephone: (A) 249-9343 Ext. 23

FILE NO. S- 4690

SEPTIC FORM

PRIVATE SEWAGE FACILITY (LICENSED) IN KENDALL COUNTY, TEXAS

APPLICANT INFORMATION:

PROPERTY OWNER (LICENSEE) JAMES EDWARDS CONTRACTOR B. MONTGOMERY

SUBDIVISION OR LOCATION LUX RANCH, U-2, L-20
236 RANCH CIRCLE DR.

TOTAL AREA SQ. FT. _____ OR ACRES 8.079

NO. BEDROOMS 3 OR SQ. FT. OF HOUSE 2,200 OR GAL/DAY 240

PERC RATE .70 CLASS NO. IV TRENCH REQ. SQ. FT. 199 x 4 = 796 OR BED REQ. SQ. FT. _____


GALLON CAPACITY REQ. FOR CONCRETE SEPTIC TANK 1000 GAL.

INSTALLED:

LENGTH 203 WIDTH 4

SQ. FT. 812 BED _____ TRENCH -

REMARKS: The installer will backfill with sand which is on site.
(SKETCH OF APPROXIMATE DISTANCES, NOT TO SCALE.)

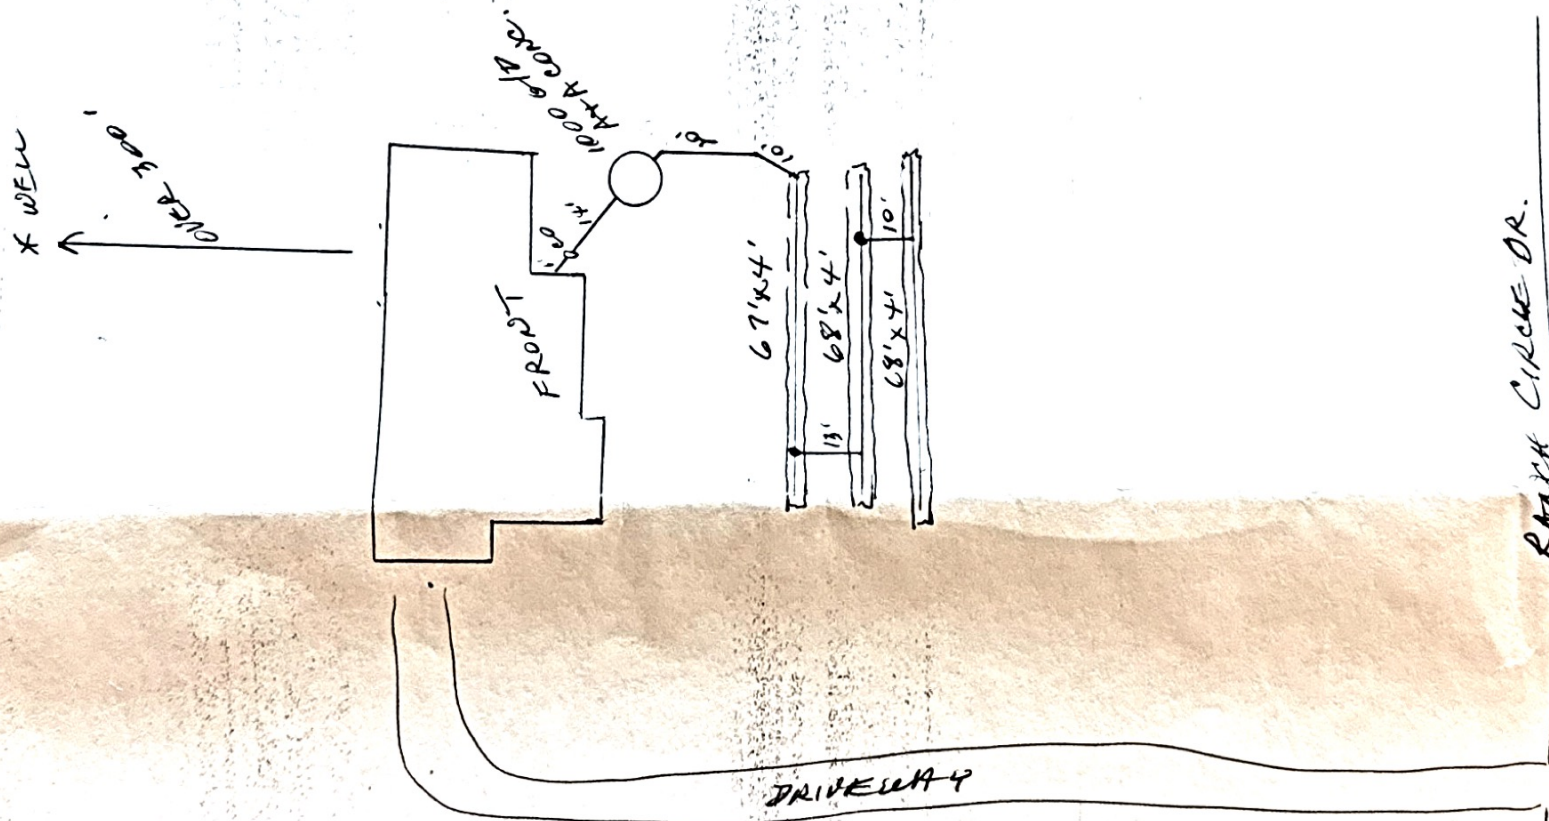

THE COUNTY OF KENDALL, THE TEXAS DEPARTMENT OF HEALTH, OR THEIR AGENTS OR DESIGNEES, MAKE NO REPRESENTATION THAT FACILITIES HEREIN LICENSED WILL PROVIDE SATISFACTORY SERVICE TO THE PREMISES SERVED. IT WILL BE THE LICENSEE'S RESPONSIBILITY TO MAKE ANY CHANGES OR MODIFICATIONS WHICH OPERATING EXPERIENCE MAY SHOW TO BE NECESSARY IN ORDER FOR THESE FACILITIES TO PROVIDE SATISFACTORY SERVICE. SEPTIC DISTANCES MEET MINIMUM TEXAS DEPARTMENT OF HEALTH SEPARATION DISTANCES IN MOST INSTANCES, SOME RENOVATIONS MAY BE LESS IF REPAIRED OR REPLACED IN THE SAME GENERAL AREA AS THE PRE-EXISTING SYSTEM BEING RENOVATED.

PERMIT (LICENSE) GRANTED AND APPROVED THIS DATE: 1 June 98

JOHN B. DUNKIN, DIRECTOR OR LEON BRIMHALL, ASSISTANT
DEPARTMENT OF DEVELOPMENT MGT