
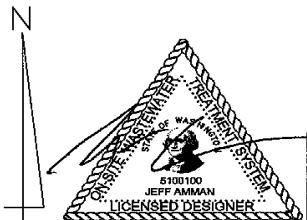


PTANumber: 27051400100800

Note: Diagrams may not be drawn to scale

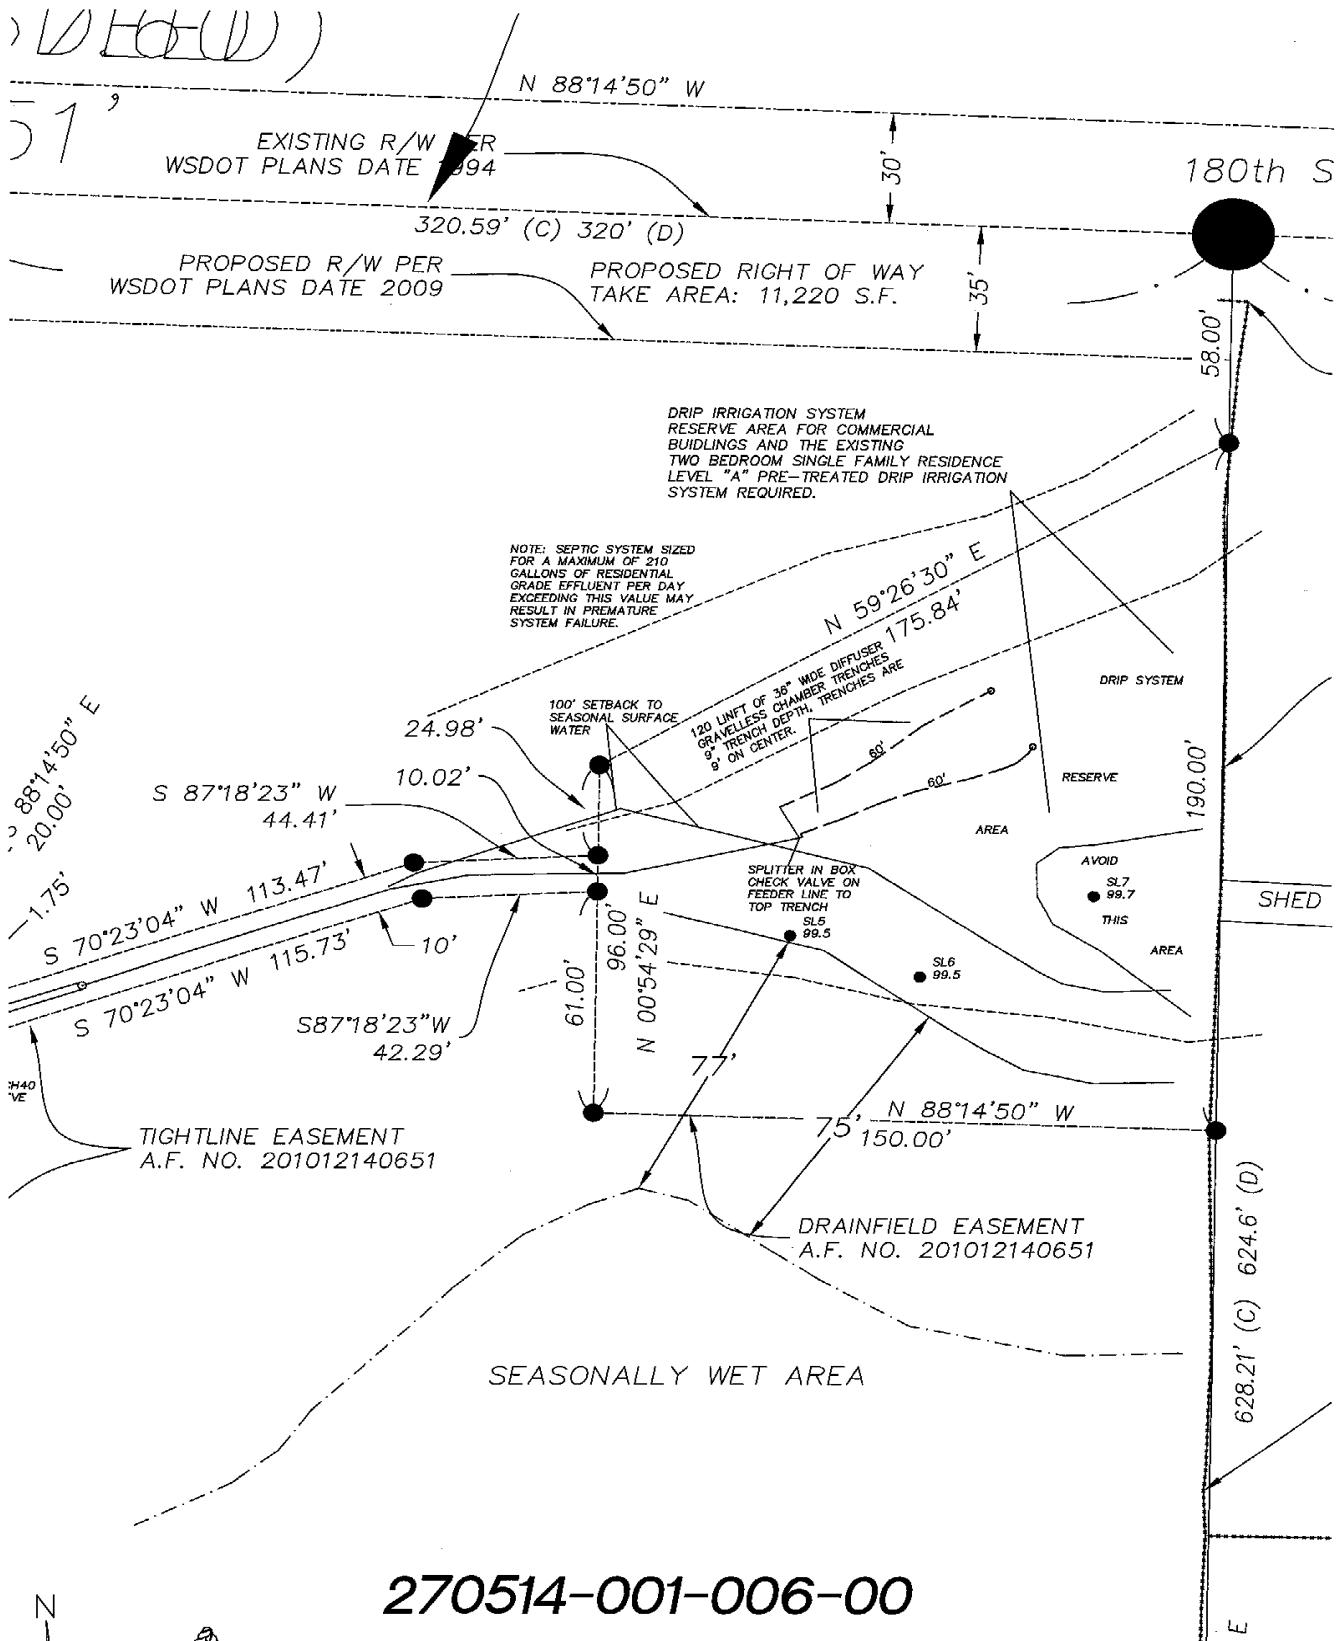

Amman Septic Designs, Inc.

14525 246th Dr. SE
Monroe, WA 98272

AS-RIITI T WWW.GNTPERK.COM

SCALE 1"=30'
Tax Parcel
270514-001-008-00
(360) 794-7809 Office
(425) 501-5195 Cell
(360) 794-5408 Fax