
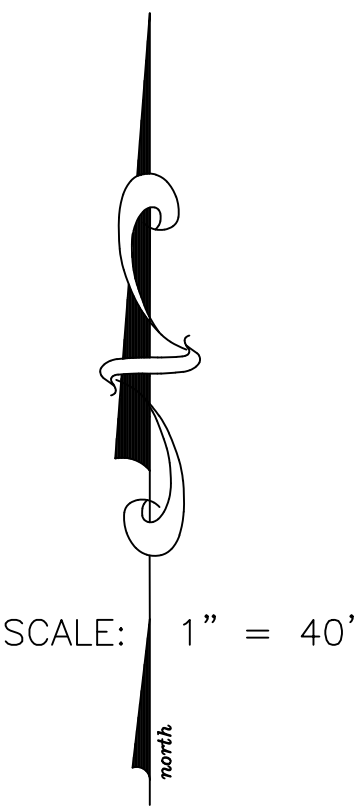
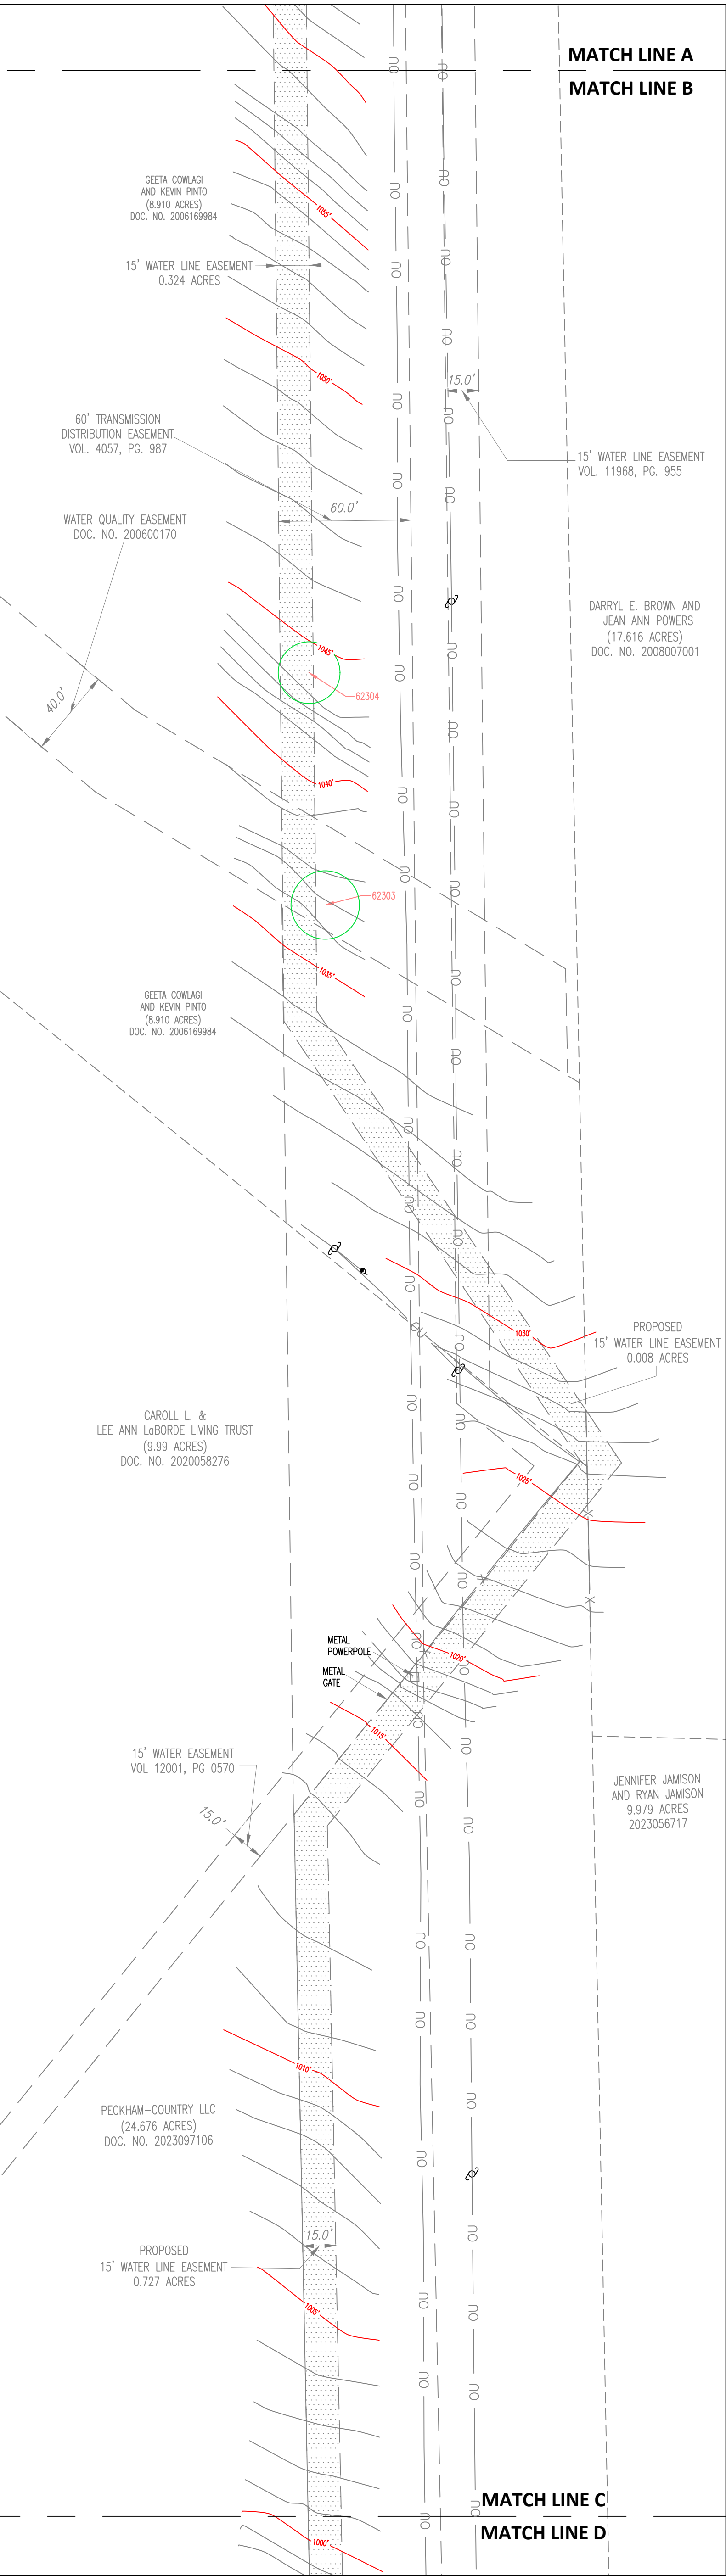


LOS ROBLES – AS BUILT, TREE, & TOPOGRAPHIC SURVEY

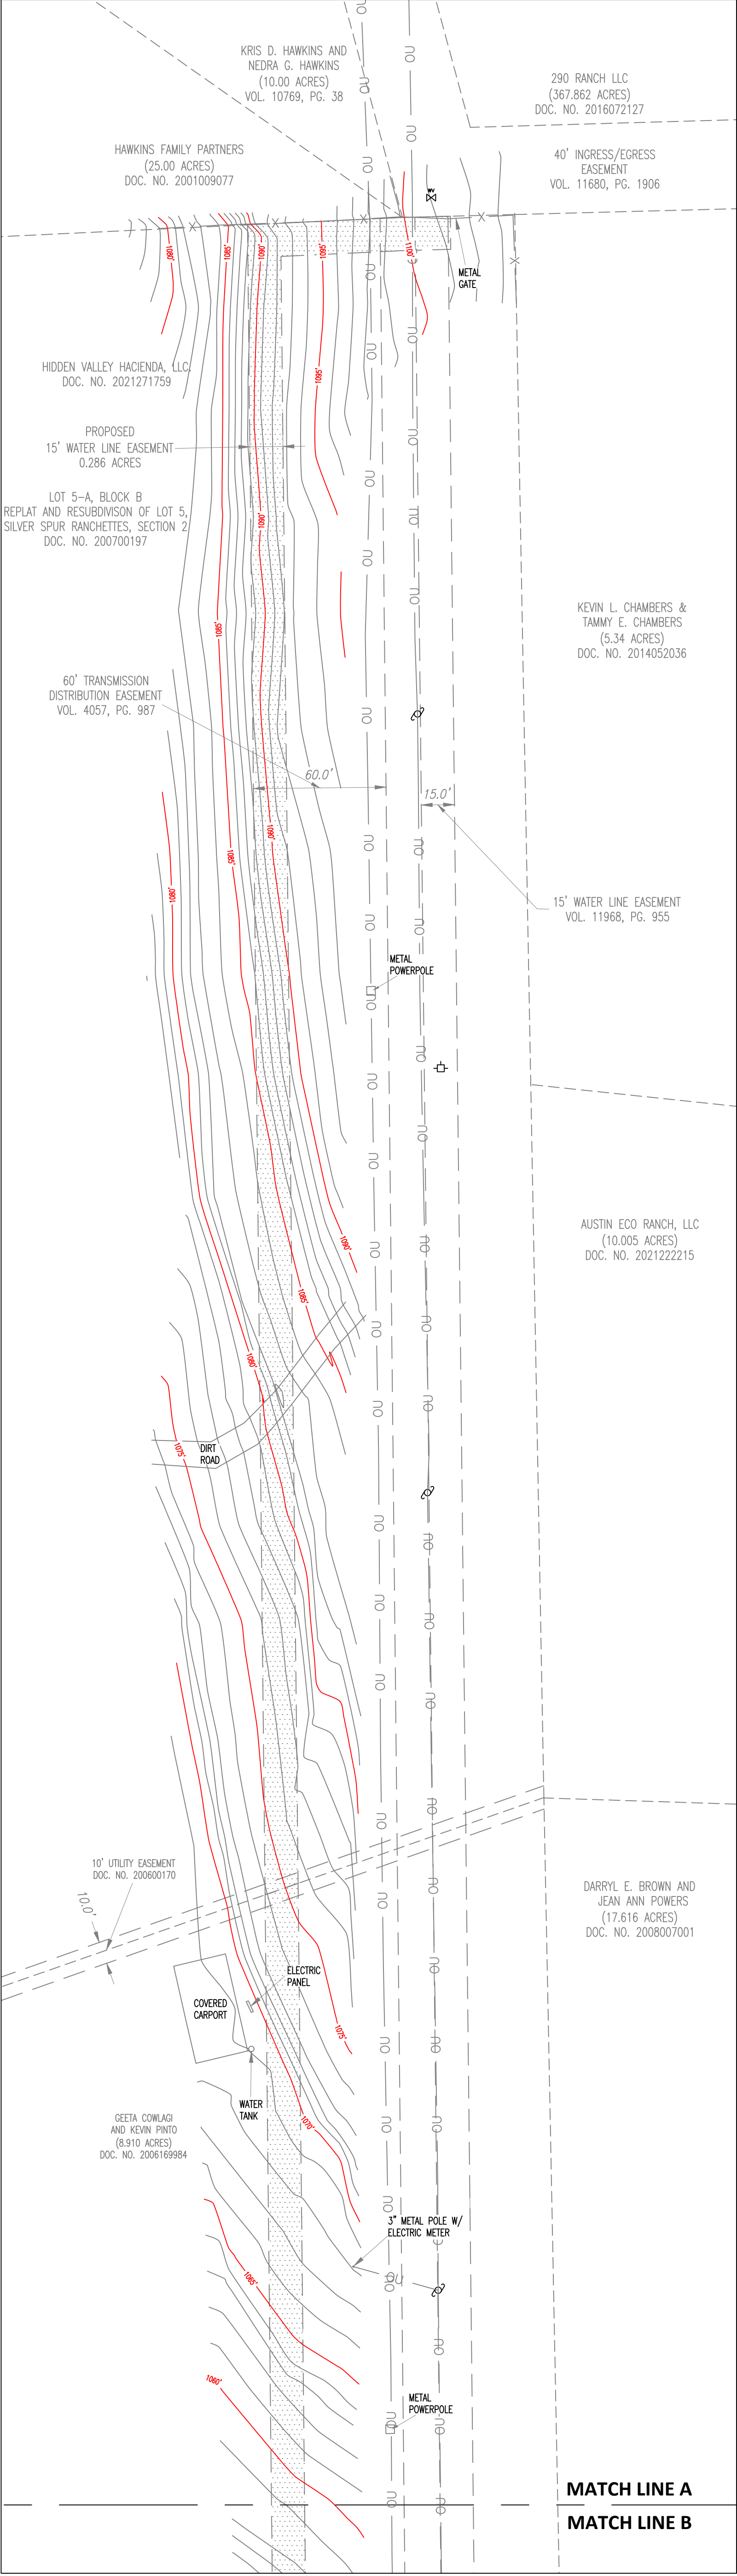

LEGEND	
	DOWN GUY
	POWER POLE
	WATER VALVE
	WATER METER
	OVERHEAD ELECTRIC LINE
	WIRE FENCE
	MAJOR CONTOUR LINE
	MINOR CONTOUR LINE
	EASEMENT LINE
	BOUNDARY LINE
	F.L. FLOWLINE ELEVATION




Bearing Basis: Texas Coordinate System, Central Zone (NAD83).

Tree Table	
Point #	Tree Description
62289	SPANISH OAK MULTI 11.5" 9.5" 8"
62290	LIVE OAK MULTI 14.5" 13.5"
62291	SPANISH OAK MULTI 11" 11"
62292	SPANISH OAK MULTI 16.5" 11"
62293	SPANISH OAK 21.5"
62294	CEDAR ELM 24"
62295	PECAN MULTI 19" 9.5"
62296	PECAN MULTI 27" 17.5"
62297	PECAN MULTI 18" 16.5"
62303	LIVE OAK MULTI 11.5" 8"
62304	LIVE OAK MULTI 9.5" 9"



Carlson, Brigrance & Doering, Inc.
FIRM ID #F3791 REG. # 10024900
Civil Engineering Surveying
5501 West William Cannon Austin, Texas 78749
Phone No. (512) 280-5160 Fax No. (512) 280-5165

LOS ROBLES - AS BUILT, TREE, & TOPOGRAPHIC SURVEY

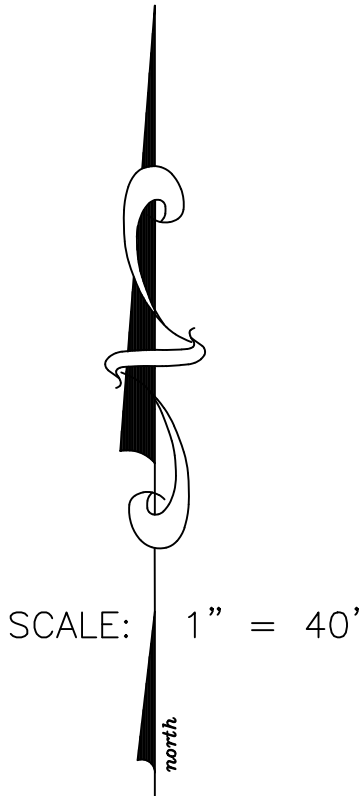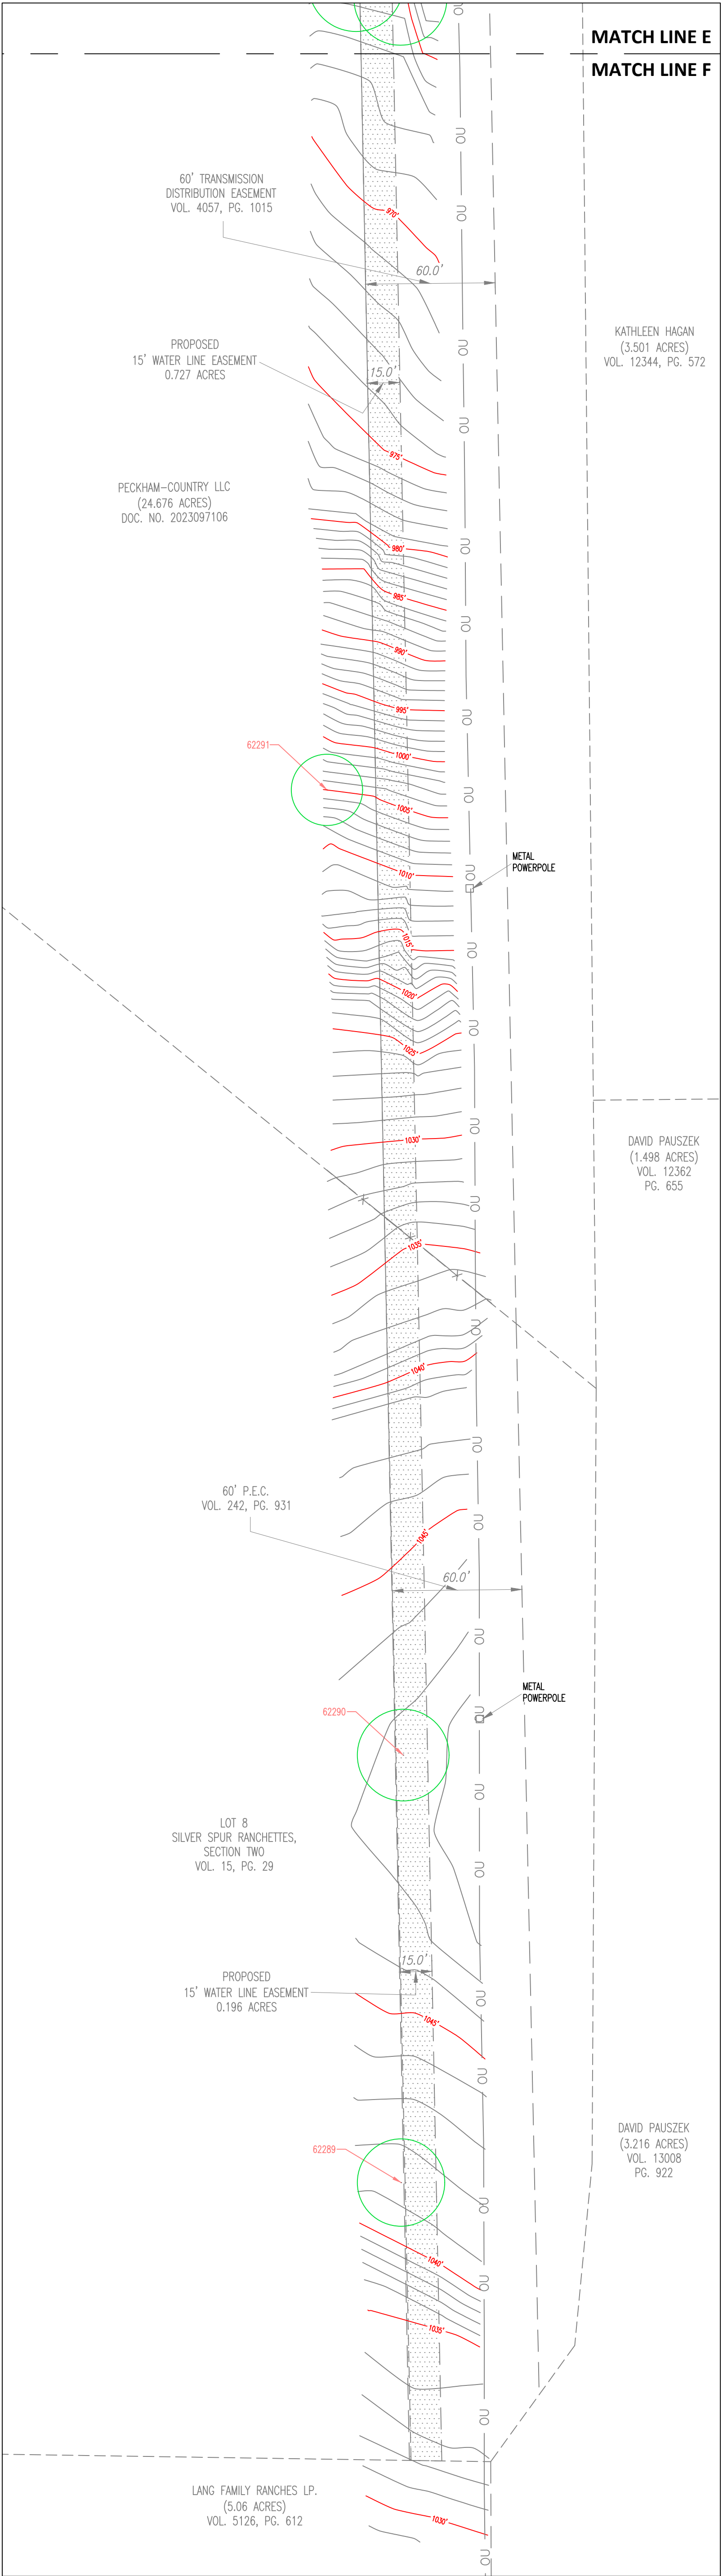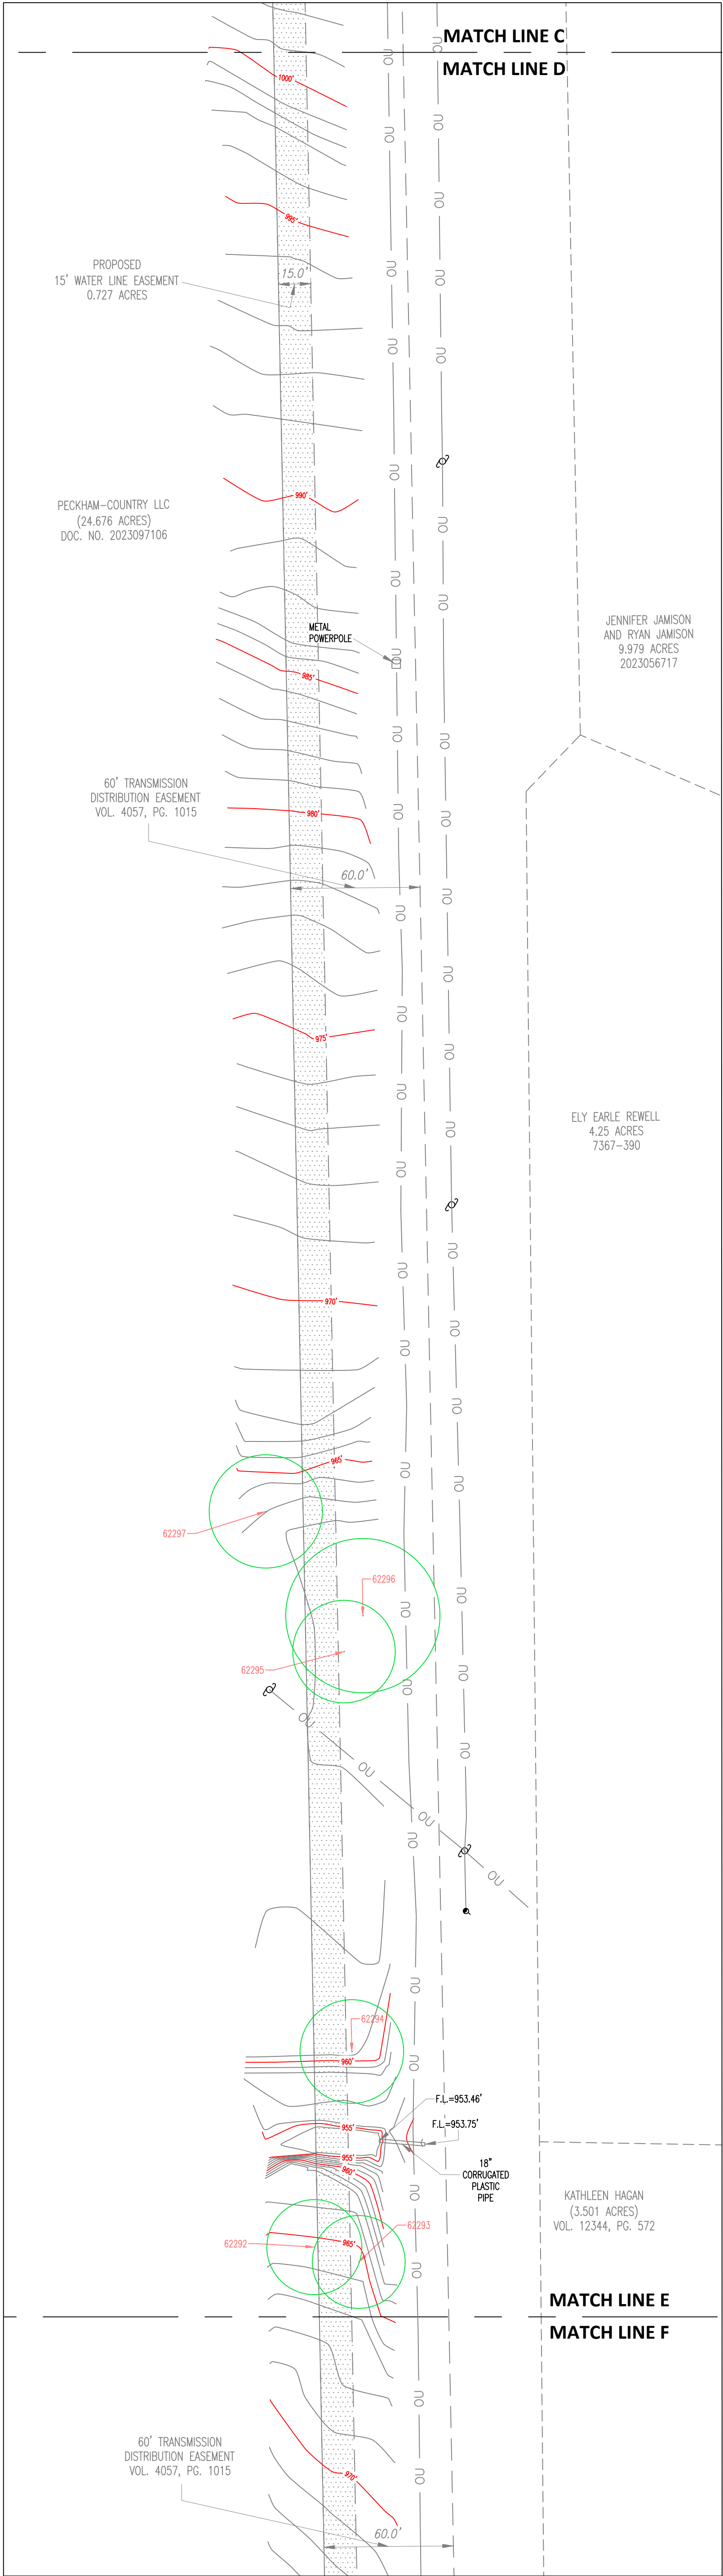

CBD

Carlson, Brigrance & Doering, Inc.

FIRM ID #F3791 REG. # 10024900

Civil Engineering
5501 West William Cannon
Phone No. (512) 280-5160

Surveying
Austin, Texas 78749
Fax No. (512) 280-5165