# MACON COUNTY PUBLIC HEALTH CENTER
Franklin, North Carolina 28734

## SUBSURFACE SEWAGE SYSTEM OPERATIONS PERMIT - TYPES II-IV

☒ New Installation ☐ Partial Repair ☐ 100% Repair


Property Owner David S. McCurdy
Location Wide Horizon Drive
Township Franklin Map Number 6593.03-04-2085 Parcel ID Number 01-28593
Type of System Gravel System Classification II Design Flow 240 GPD LTAR .55
Future Repair Required: ☒ Yes ☐ No Type of System for Future Repair Gravel
Septic Tank Size 1000 gal. B-B Pump Tank Size NA Trench Bottom Depth 24" lower side
Drinking Water Source: ☐ City ☐ Community ☒ Individual Well/Spring ☐ Shared Well/Spring
Date Improvements Permit Issued 5-18-96 Permit Number NA
Date Authorization to Construct Issued 5-18-96 Authorization Number NA
Installer Chuck Bates Design Engineer NA Project Number NA
Inspection Frequency: Health Department NA Management Entity NA
Management Entity Reporting Frequency NA

**The Following checked items are on file and are part of this Operations Permit:**

☒ Copy of Application ☒ Copy of Improvement Permit ☒ Survey/Plat Map
☐ Soil Data Sheet ☒ Copy of Authorization To Construct ☐ Zoning Permit
☐ Engineer's Drawing ☐ Other

**DIAGRAM (Not to Scale)**

Ok For Final power
4-1-97 cw

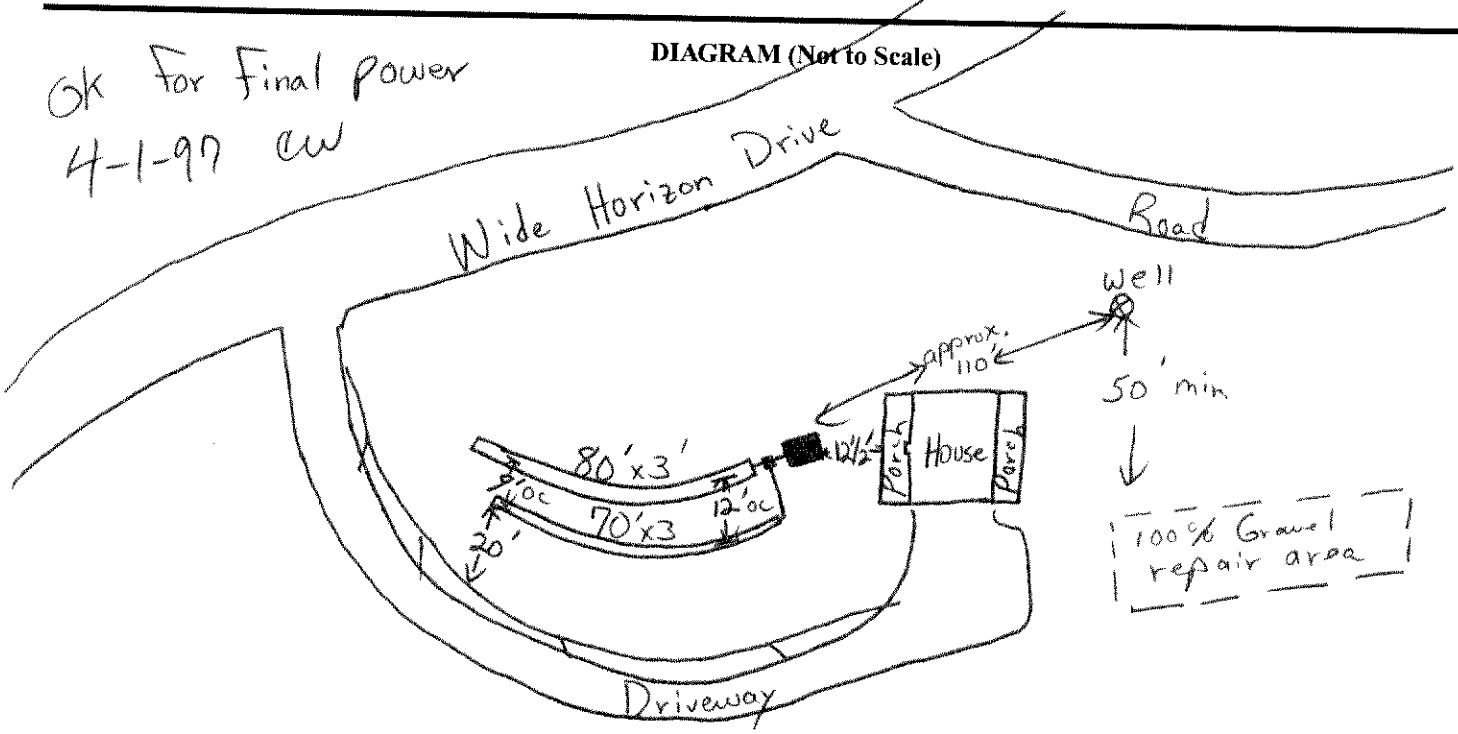


A representative of the Macon County Public Health Center has inspected this sewage disposal system and finds that it conforms to state guidelines. This permit is issued subject to all the provisions of the North Carolina Laws and Rules for Sewage Treatment and Disposal. **No person is permitted to make alterations to this system without the approval of an authorized Environmental Health Specialist.** This approval indicates that this system has been installed in compliance with the standards as set forth in the above regulations, but shall in no way be taken as a guarantee that the system will function satisfactorily for any given period of time. **The area designated as "repair area" is required for future use and can not be disturbed in any way.**

4-1-97
Date Inspected

Charles Womack RS
Environmental Health Specialist

White-Owners's Copy Yellow-Health Dept. Copy Pink-Building Inspection Dept. Copy