Macon County
Public Health

1830 Lakeside Dr
Franklin, NC 28734
(828) 349 – 2490
envirovm@maconnc.org

OPERATIONS PERMIT

Owner	Your Land For Sale Super Store LLC			**SEP**	030425-1	**WEL**	030125-1
Location	TBD Foxwood Dr (Cedar Springs Lot 25)			**PID**	7516455012	**ACREAGE**	0.88
Directions	Rabbit Creek Rd, L onto Corbin Rd, when road turns to gravel stay L, R onto Foxwood Dr, second lot on the L						
Design	360 Gallons Per Day – DSE	**Facility**	3 Bdrm – Residential – Max 6 People			**Install Type**	New Construction
Foundation	Crawlspace	**Water**	Proposed Single-Family Well / On Site			**Expiration**	Valid without Expiration

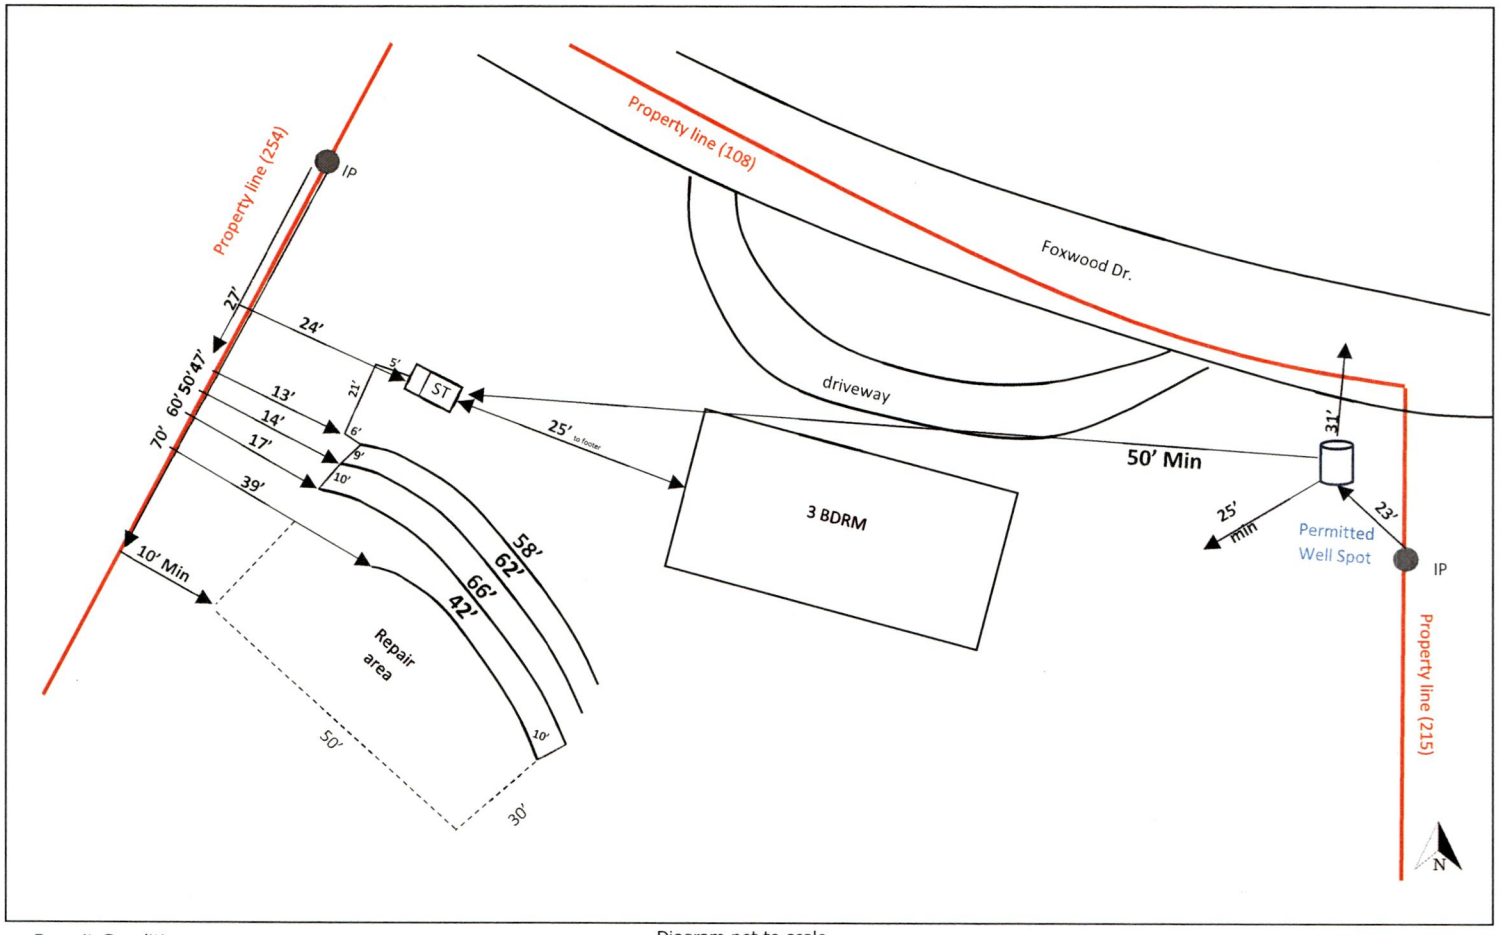


Diagram not to scale

Permit Conditions

1) System shall be operated and maintained per 15A NCAC 18E .1303

INITIAL	Infiltrator Quick 4 Plus (IQ4PS) - Gravity			**REPAIR**	Panel Block (PPBPS) - Horiz. - Gravity		
Type: II B	Avg. Depth: 20"	LTAR: 0.4	Saprolite: No	Type: III E	Area: 1500 ft²	LTAR: 0.4	Saprolite: No
S. TANK	ID: INF – STB – 2152 – 1071 gallons	Filter: Polylok		**P. TANK**	ID: – STB – – gallons	Dose: enter" at enter gal/in	
Length: 228'	# Lines: 4	Distribution: Serial - SCH40	Trench Width: 3'		Well Setback: 50' Minimum	BPJ Used: No	
On Center Spacing - 9 '	Supply Line Material - PVC - SCH40				Step Down Material - PVC - SCH40		
Installer: Ivan Boychenko	Cert: 11857	**MONITORING**	GCPH: N/A		Mgt. Entity: N/A	Report Freq.: N/A	

The issuance of this permit by MCPH in no way guarantees the issuance of other permits. The property owner is responsible for checking with appropriate governing bodies in meeting their requirements. This permit is subject to revocation if the site plan, plat, site, or intended use changes. All rules in 15A NCAC 18E Wastewater Treatment and Dispersal Systems are incorporated by reference into this document, including any subsequent amendments to those rules, and shall be adhered to.

enter a date.
Issue Date

Select an Agent...