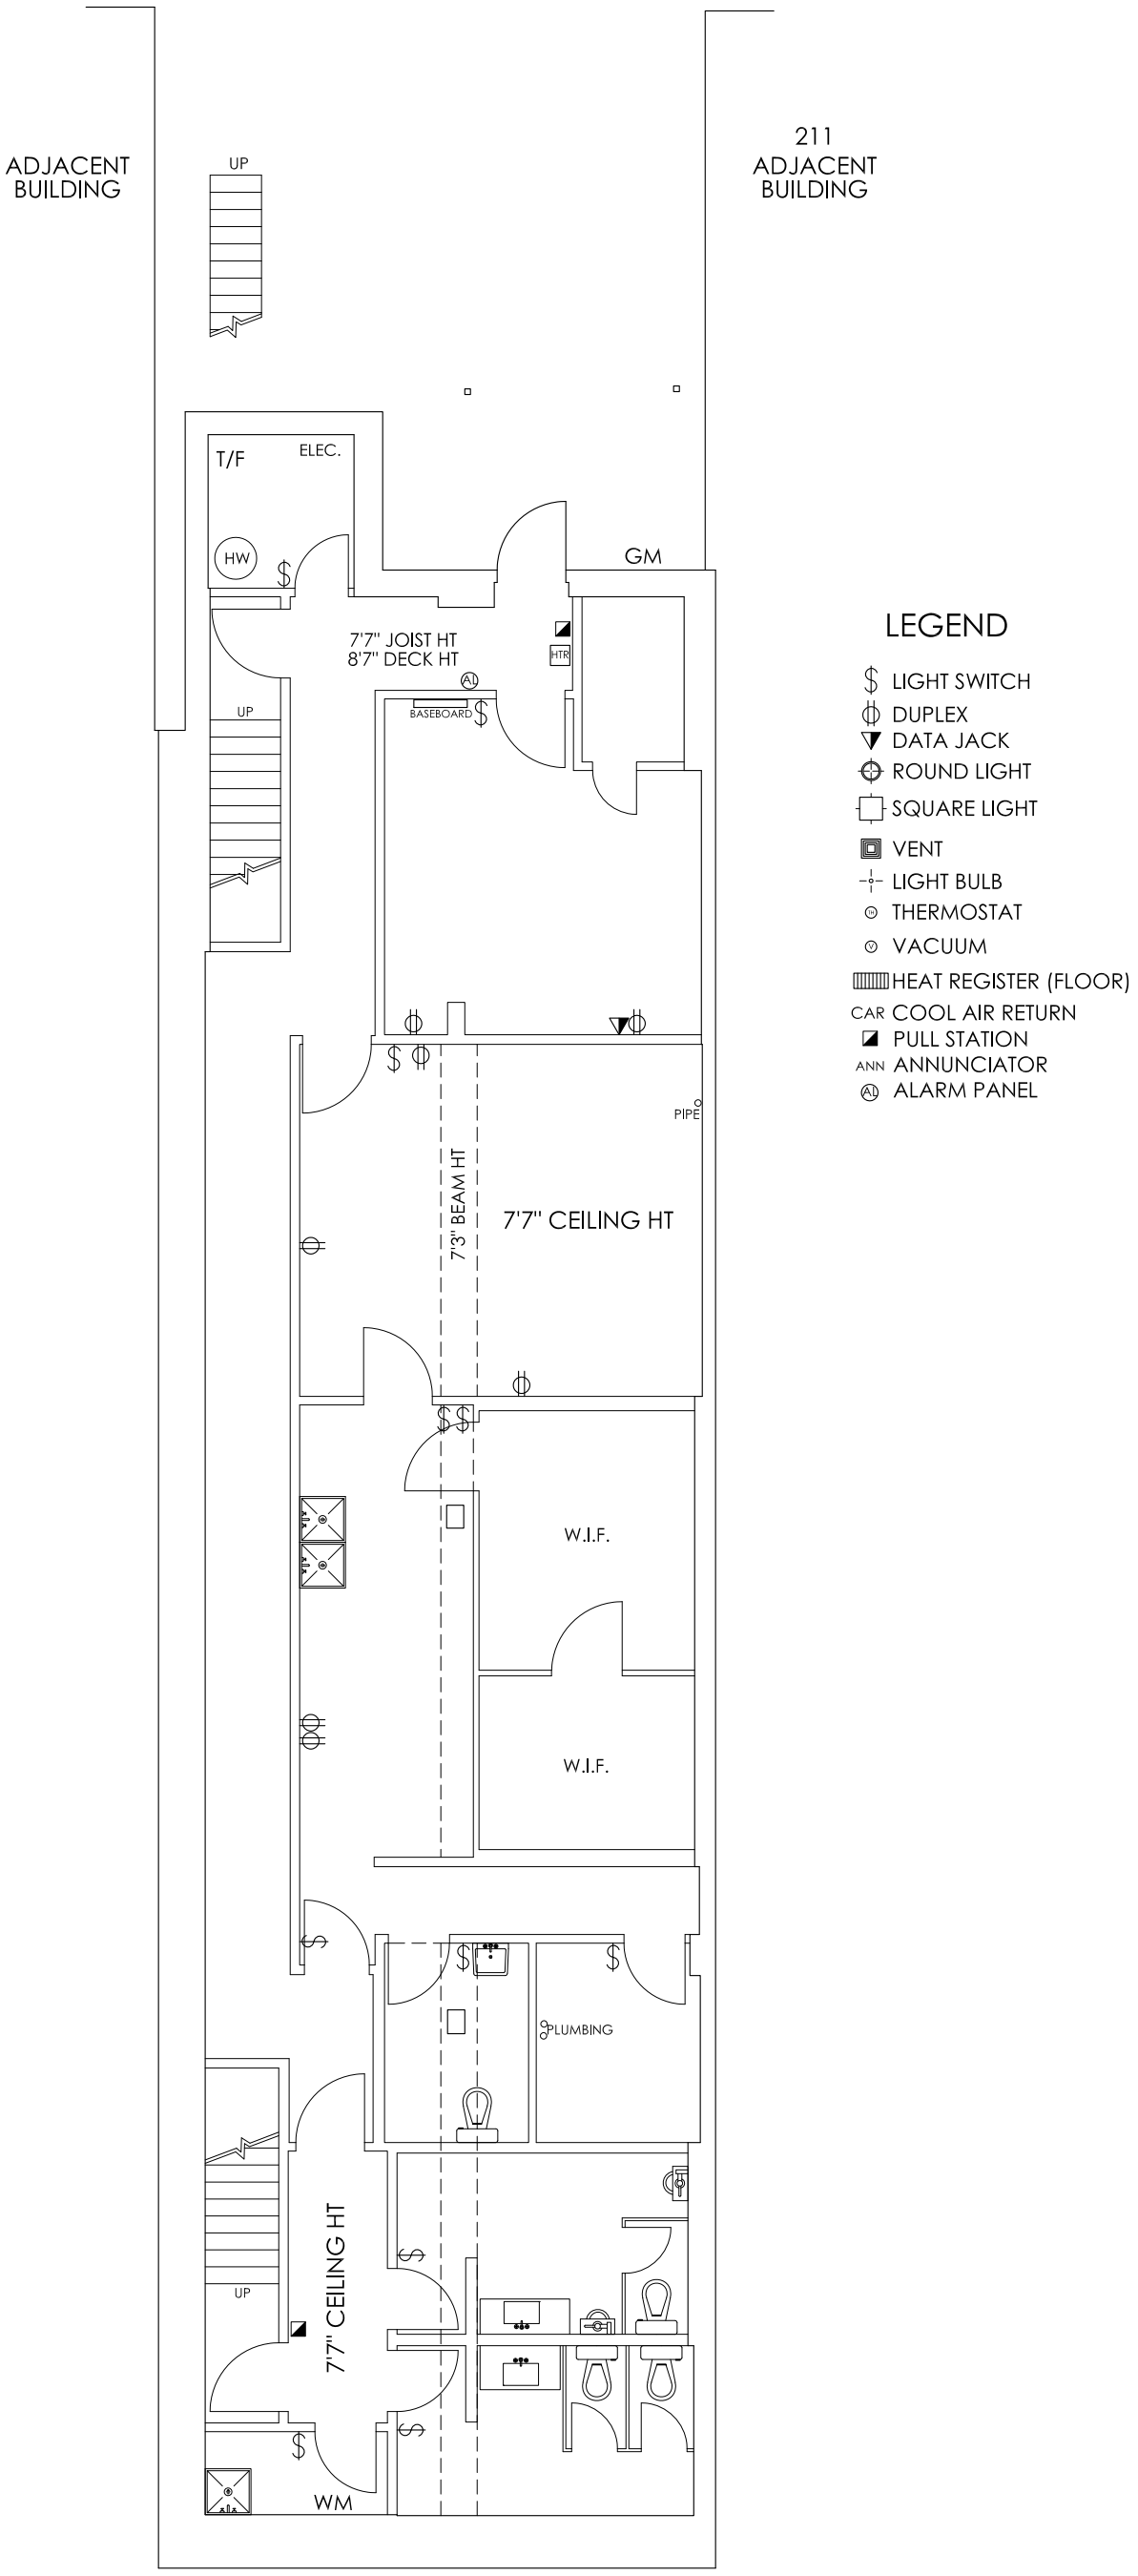


LEGEND

- LIGHT SWITCH
- DUPLEX
- DATA JACK
- ROUND LIGHT
- SQUARE LIGHT
- VENT
- LIGHT BULB
- THERMOSTAT
- VACUUM
- HEAT REGISTER (FLOOR)
- CAR COOL AIR RETURN
- PULL STATION
- ANN ANNUNCIATOR
- AL ALARM PANEL

NO.	DATE	REVISION
1.	19.06.02	CLIENT REVIEW

CSPACE
ARCHITECTURE

5B-8851 GEORGE BOLTON PKWY
BOLTON, ONT. L7E 2X8
647.588.1784
info@cspace.ca

DATE: 19.06.02

SCALE: 1/8" = 1'-0"

DRAWN BY: C.C.P.


PROJECT TITLE:
RESIDENTIAL RENOVATION
209 MAIN STREET SOUTH
NEWMARKET, ONTARIO.

DRAWING TITLE:
GROUND FLOOR PLAN - AS BUILT

DRAWING NUMBER: A2.1

FILE: 19.048

N

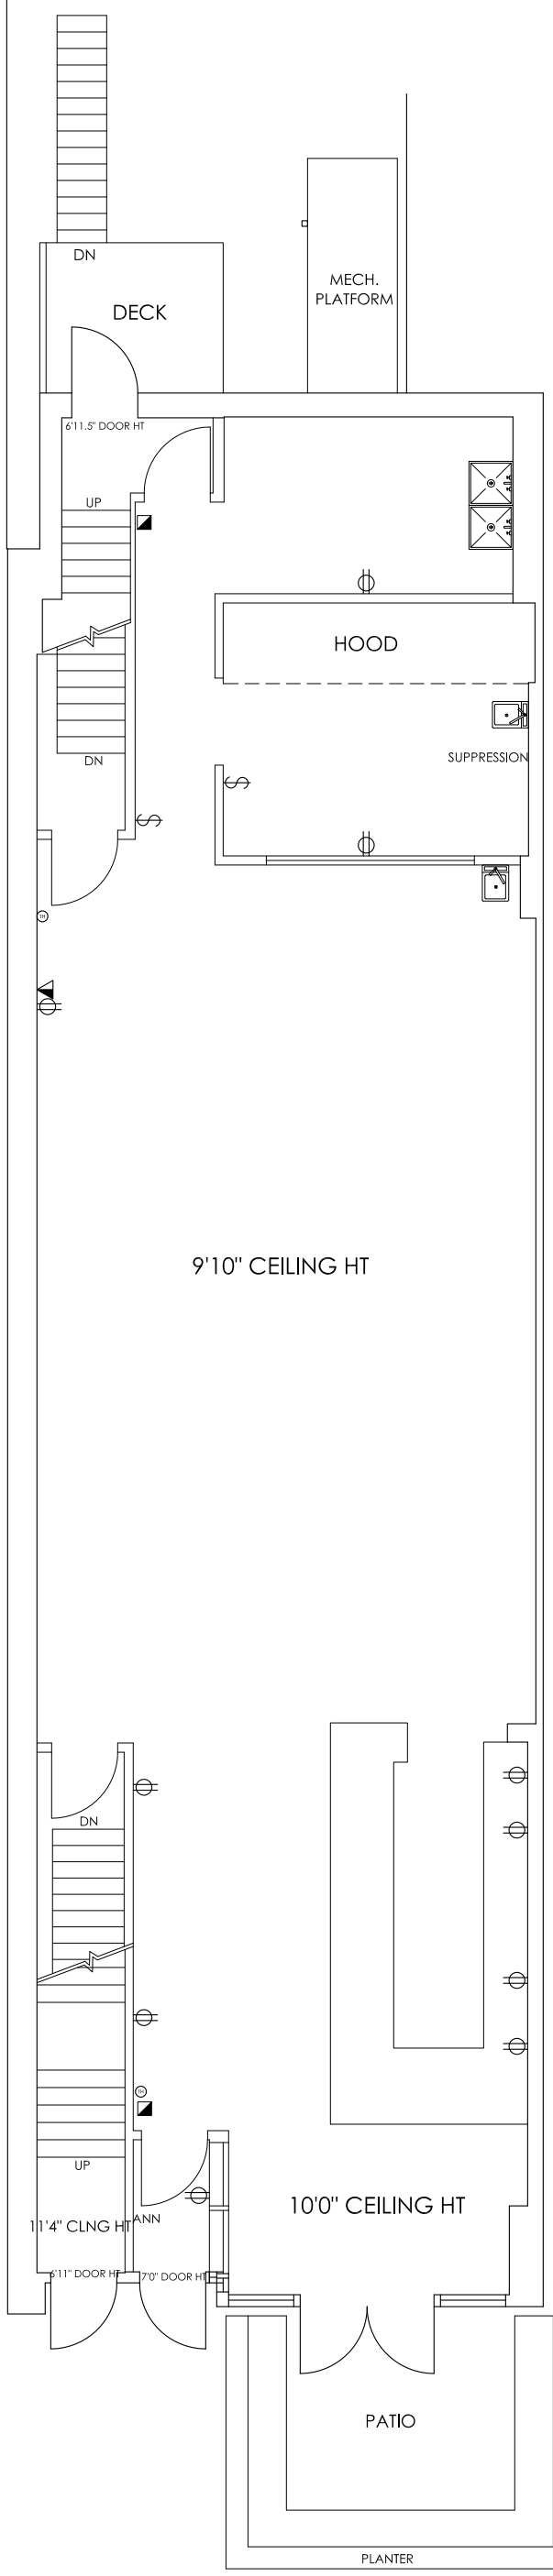

LEGEND

- LIGHT SWITCH
- DUPLEX
- DATA JACK
- ROUND LIGHT
- SQUARE LIGHT
- VENT
- LIGHT BULB
- THERMOSTAT
- VACUUM
- HEAT REGISTER (FLOOR)
- CAR COOL AIR RETURN
- PULL STATION
- ANN ANNUNCIATOR
- (AL) ALARM PANEL

NO.	DATE	REVISION
1.	19.06.02	CLIENT REVIEW

CSPACE
ARCHITECTURE

5B-8851 GEORGE BOLTON PKWY
BOLTON, ONT. L7E 2X8
647.588.1784
info@cspace.ca

DATE: 19.06.02

SCALE: 1/8" = 1'-0"

DRAWN BY: C.C.P.


PROJECT TITLE:
RESIDENTIAL RENOVATION
209 MAIN STREET SOUTH
NEWMARKET, ONTARIO.

DRAWING TITLE:
MAIN FLOOR PLAN - AS BUILT

DRAWING NUMBER: A2.2

FILE: 19.048

N

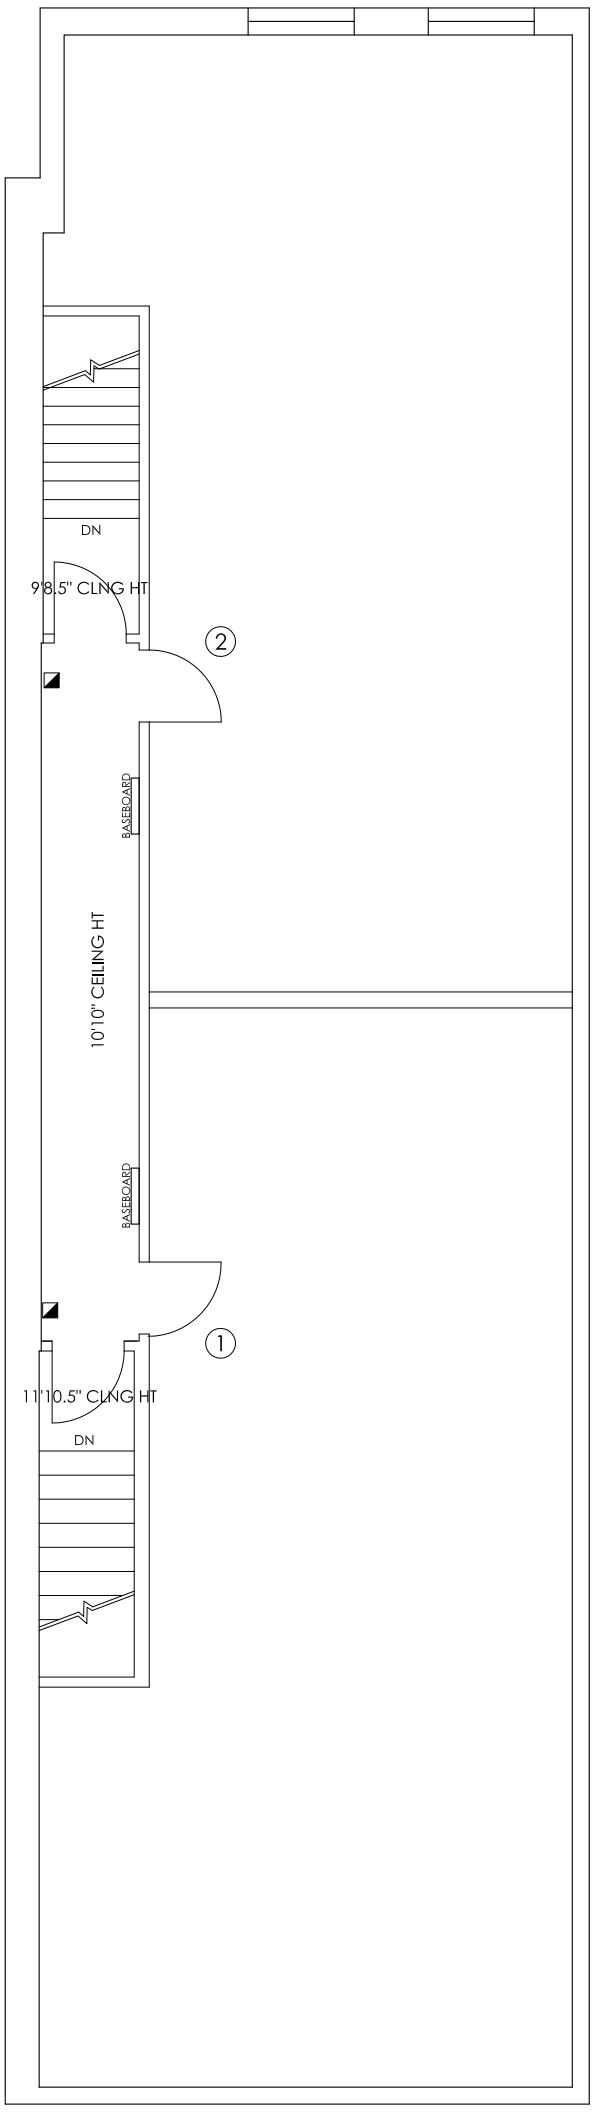

LEGEND

- LIGHT SWITCH
- DUPLEX
- DATA JACK
- ROUND LIGHT
- SQUARE LIGHT
- VENT
- LIGHT BULB
- THERMOSTAT
- VACUUM
- HEAT REGISTER (FLOOR)
- CAR COOL AIR RETURN
- PULL STATION
- ANN ANNUNCIATOR
- AL ALARM PANEL

NO.	DATE	REVISION
1.	19.06.02	CLIENT REVIEW

CSPACE
ARCHITECTURE

5B-8851 GEORGE BOLTON PKWY
BOLTON, ONT. L7E 2X8
647.588.1784
info@cspace.ca

DATE: 19.06.02

SCALE: 1/8" = 1'-0"

DRAWN BY: C.C.P.


PROJECT TITLE:
RESIDENTIAL RENOVATION
209 MAIN STREET SOUTH
NEWMARKET, ONTARIO.

DRAWING TITLE:
SECOND FLOOR PLAN - AS BUILT


DRAWING NUMBER: A2.3

FILE: 19.048

N

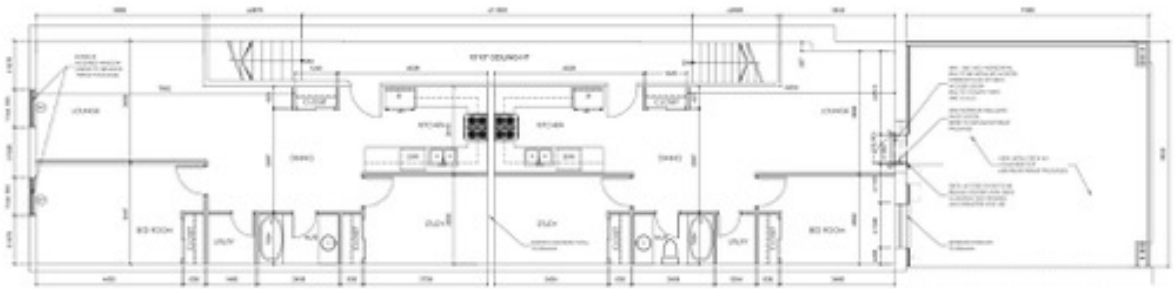

1 / A204 2nd FLOOR PLAN
SCALE: 1:50

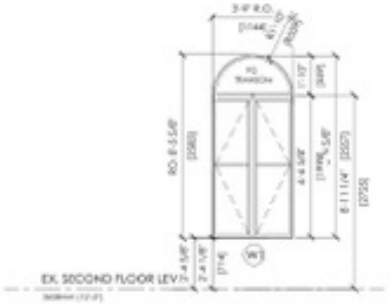

W1

NEW WINDOW ASSEMBLY

- SIMULCO WOOD OR FIBERGLASS OR APPROVED EQUIVALENT, JURY-RIG TO FIT INTO EXISTING OPENING.
- CONTRACTOR TO CONFIRM DIMENSIONS OF ROUGH OPENING PRIOR TO MANUFACTURE OF ASSEMBLY.
- CONTRACTOR TO PROVIDE SHOP DRAWINGS FOR CONSULTANT REVIEW PRIOR TO MANUFACTURE.
- CAULK AT PERIMETERS AS REQUIRED (COLOUR TO MATCH THAT OF FRAMES/SASH).

SCHEDULE NOTES:
- FRAMES/SASH: THERMALLY BROKEN WOOD OR FIBERGLASS. COLOUR OF FRAMES/SASH DARK BROWN

- GLASS: TEMPERED, SEALED DOUBLE GLASS UNITS. COLOUR OF GLAZING: CLEAR

GLAZING - GENERAL NOTES

1. ALL WINDOWS SHALL TO MEET MINIMUM STANDARDS FOR AIR LEAKAGE, WATER LEAKAGE, WIND LOAD RESISTANCE AND RESISTANCE TO FORCED ENTRY AS PER CAN/CSA-A440NI.
2. PRODUCT TO BE THERMALLY BROKEN FRAME WINDOW UNITS. COLOURS AS SELECTED BY LEAD CONSULTANT.
3. ALL GLAZING TO BE SEALED DOUBLE GLASS UNITS CONFIRM WITH CLIENT.
4. WINDOW SUPPLIER SHALL CONFIRM WINDOW SIZES AND ROUGH OPENINGS WITH CONTRACTOR PRIOR TO FRAMING OPENINGS. SHOP DWGS. REQUIRED.
5. MAINTAIN CLEARANCES FOR CONCRETE/MASONRY SHRINK.

2 / A204 2nd FLOOR w/DEMO WINDOW SCHEDULE
SCALE: N.T.S.

CLIENT
JMGGATE INC.

CSPACE
ARCHITECTURE

PROJECT

DRAWING TITLE
2ND FLOOR EXISTING PLAN & W/DEMO WINDOW SCH.

DRAWING NO.
A204